

DRAWING REVISIONS			
REV	DESCRIPTION	DATE	BY
00	INITIAL DRAWINGS	05/19/2025	SK
01	ALARM HORN	06/19/2025	SN
A	AS-BUILT	11/13/2025	LB


autStand
Automation Standard

CONFIDENTIAL: THE INFORMATION CONTAINED HEREIN IS PROPRIETARY INFORMATION OF AUTOMATION STANDARD LLC AND CONSTITUTES TRADE SECRETS PURSUANT TO THE UNIFORM TRADE SECRETS ACT. THIS INFORMATION SHALL ONLY BE USED IN THE PERFORMANCE OF CONTRACT WITH AUTOSTAND. THIS INFORMATION SHALL NOT BE USED, REPRODUCED OR EMPLOYED IN WHOLE PART, EXCEPT WITH AUTOSTAND'S PRIOR WRITTEN APPROVAL.

25K Amazon Cross-Belt Sort Center (ACBSC)
NCP1_1_VFD1/NCP1_1_FIO1/
NCP1_2_VFD1/NCP1_2_FIO1 IO DRAWINGS

AMAZON MTN6
SPARROWS POINT, MD

FILENAME	
2429-AMZ-MTN6-MCM03-600	
D-SIZE SCALE	JOB NUMBER
NTS	2429
REVISION	SHEET
A	46

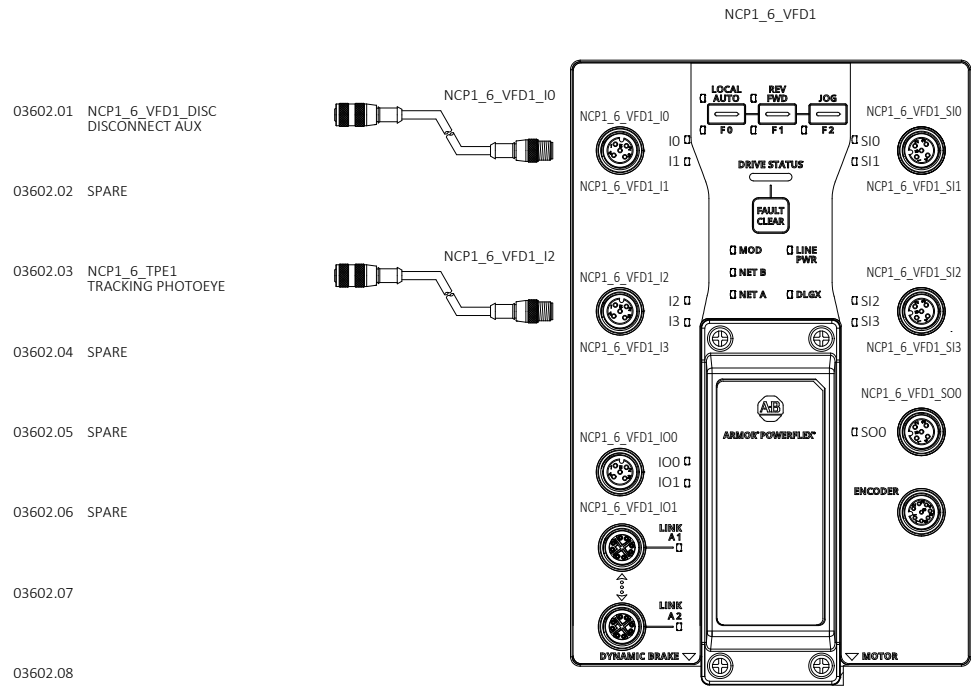

- 03602.01 NCP1_6_VFD1_DISC DISCONNECT AUX
- 03602.02 SPARE
- 03602.03 NCP1_6_TPE1 TRACKING PHOTOEYE
- 03602.04 SPARE
- 03602.05 SPARE
- 03602.06 SPARE

03602.07

03602.08


03602.36

03602.37

03602.38

03602.39

03602.40

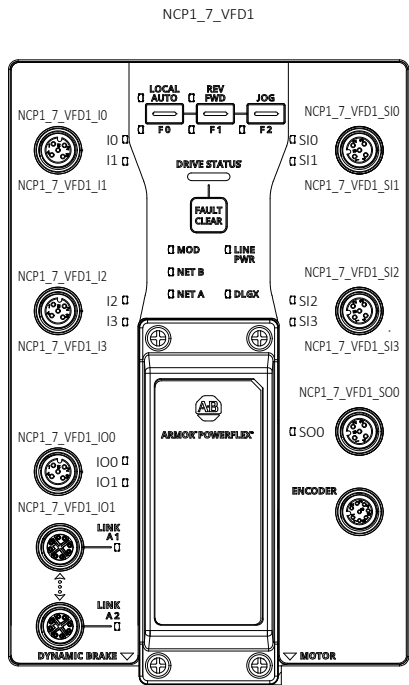

- NCP1_7_VFD1_I0
- NCP1_7_VFD1_I2

- SPARE
- SPARE
03602.27

03602.28

03602.29

03602.30

03602.31

03602.32

03602.33

03602.34

03602.35


03602.36

03602.37

03602.38

03602.39

03602.40

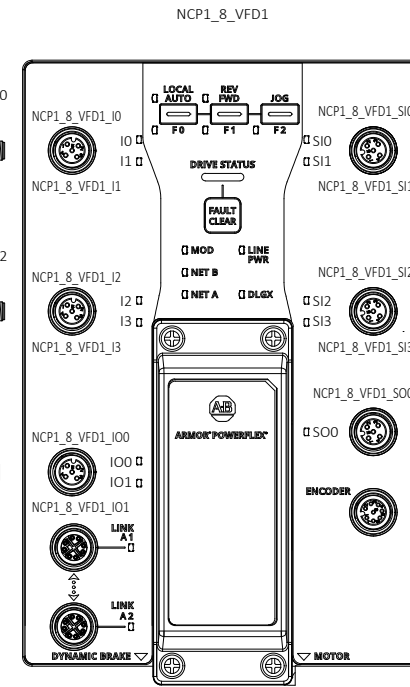

- NCP1_8_VFD1_I0
- NCP1_8_VFD1_I2
- NCP1_8_VFD1_I00

- SPARE
- SPARE
03602.27

03602.28

03602.29

03602.30

03602.31

03602.32

03602.33

03602.34

03602.35


03602.36

03602.37

03602.38

03602.39

03602.40

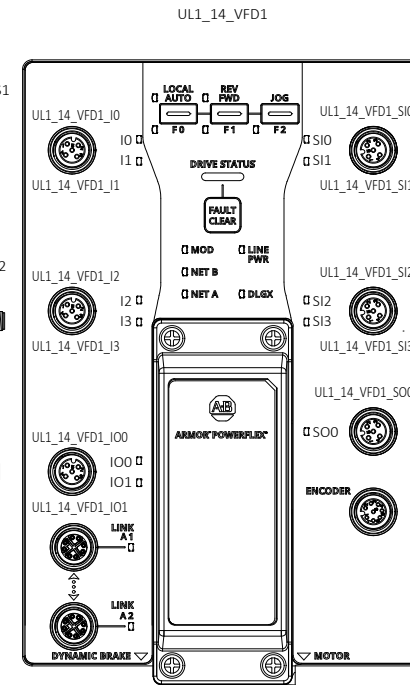

- UL1_14_VFD1_I0
- UL1_14_VFD1_I1
- UL1_14_VFD1_I2
- UL1_14_VFD1_I00

03602.31

03602.32

03602.33

03602.34

03602.35

03602.36

03602.37

03602.38

03602.39

03602.40

- NCP1_8_VFD1_SIO
- NCP1_8_VFD1_SI2
- NCP1_8_VFD1_SI0
- NCP1_8_VFD1_SI2

- NCP1_8_EPC1 E-STOP PULLCORD
- NCP1_8_EPC2 E-STOP PULLCORD
- NCP1_8_EPC2 E-STOP PULLCORD
- NCP1_8_EPC2 E-STOP PULLCORD

SPARE

03602.26

03602.27

03602.28

DRAWING REVISIONS			
REV	DESCRIPTION	DATE	BY
00	INITIAL DRAWINGS	05/19/2025	SK
01	ALARM HORN	06/19/2025	SN
A	AS-BUILT	11/13/2025	LB



CONFIDENTIAL: THE INFORMATION CONTAINED HEREIN IS PROPRIETARY INFORMATION OF AUTOMATION STANDARD LLC AND CONSTITUTES TRADE SECRETS PURSUANT TO THE UNIFORM TRADE SECRETS ACT. THIS INFORMATION SHALL ONLY BE USED IN THE PERFORMANCE OF CONTRACT WITH AUTOSTAND. THIS INFORMATION SHALL NOT BE USED, REPRODUCED OR EMPLOYED IN WHOLE PART, EXCEPT WITH AUTOSTAND'S PRIOR WRITTEN APPROVAL.

25K Amazon Cross-Belt Sort Center (ACBSC)
 NCP1_6_VFD1/NCP1_7_VFD1/
 NCP1_8_VFD1/UL1_14_VFD1 IO DRAWINGS
 AMAZON MTN6
 SPARROWS POINT, MD

FILENAME 2429-AMZ-MTN6-MCM03-602	
D-SIZE SCALE NTS	JOB NUMBER 2429
REVISION A	SHEET 48

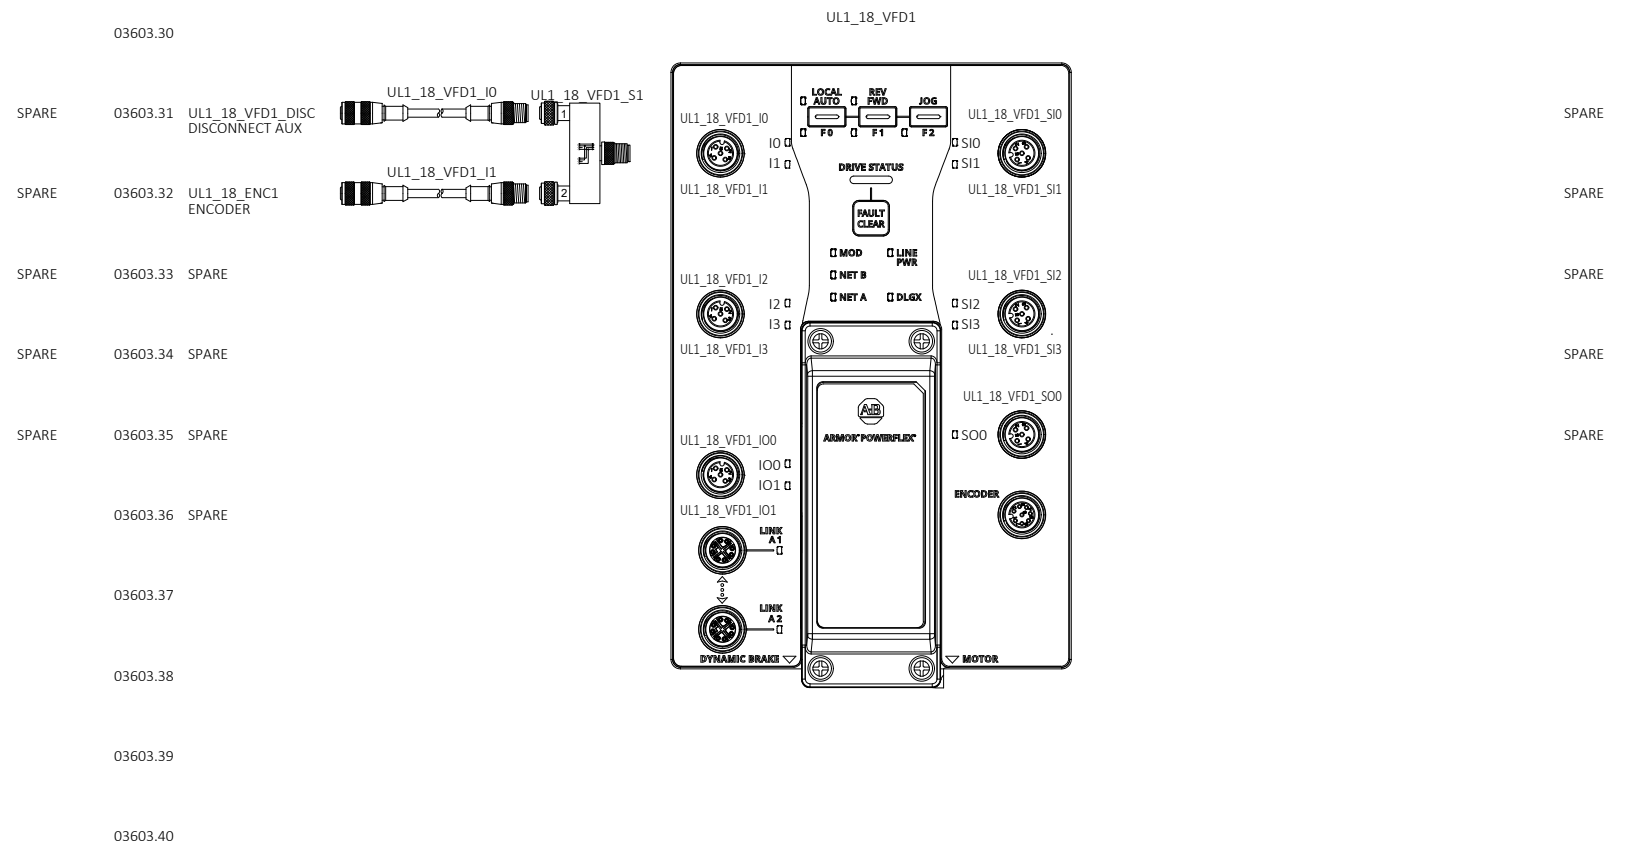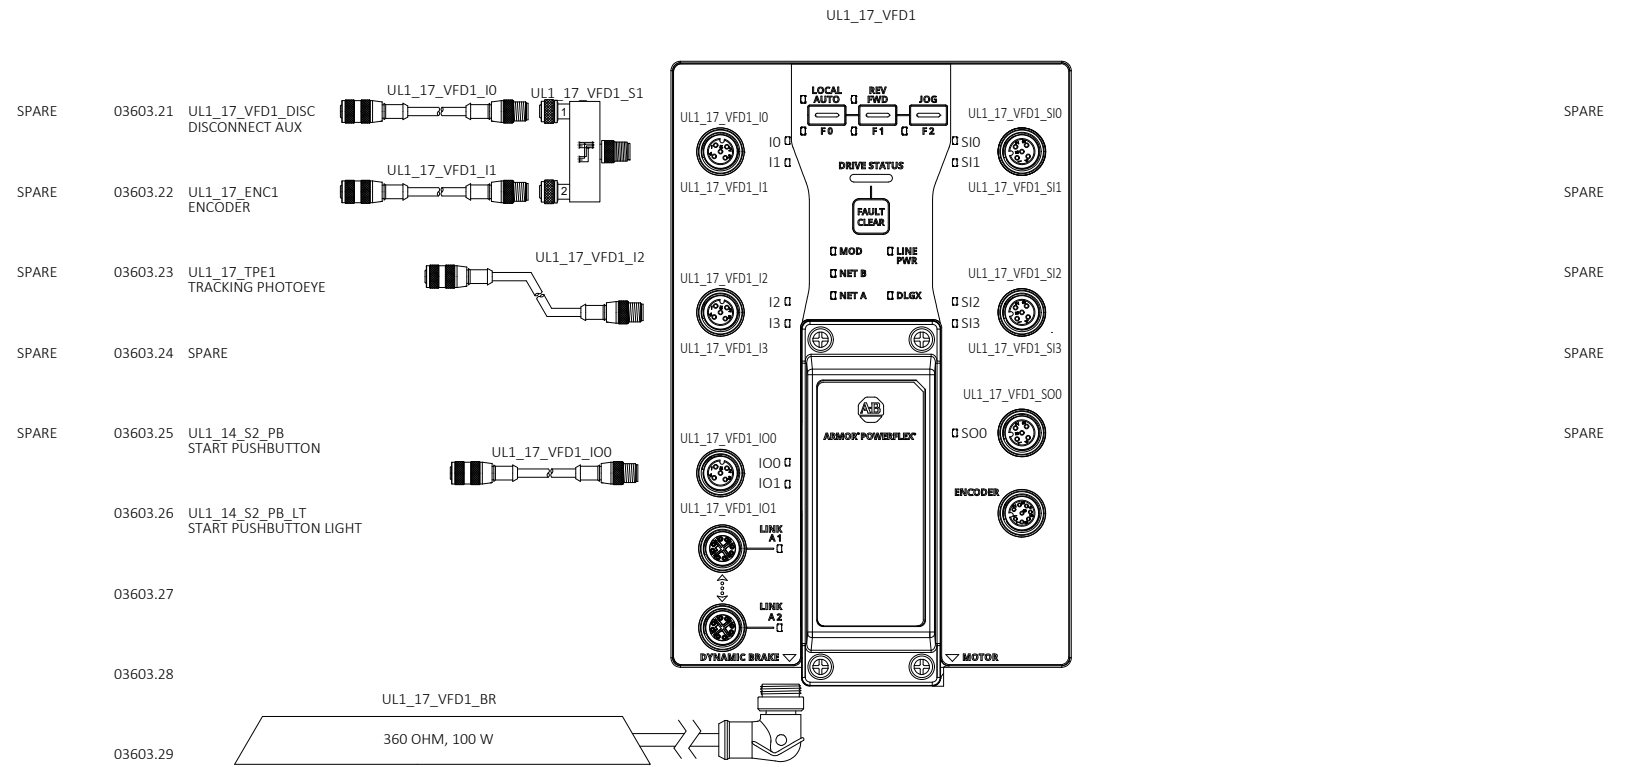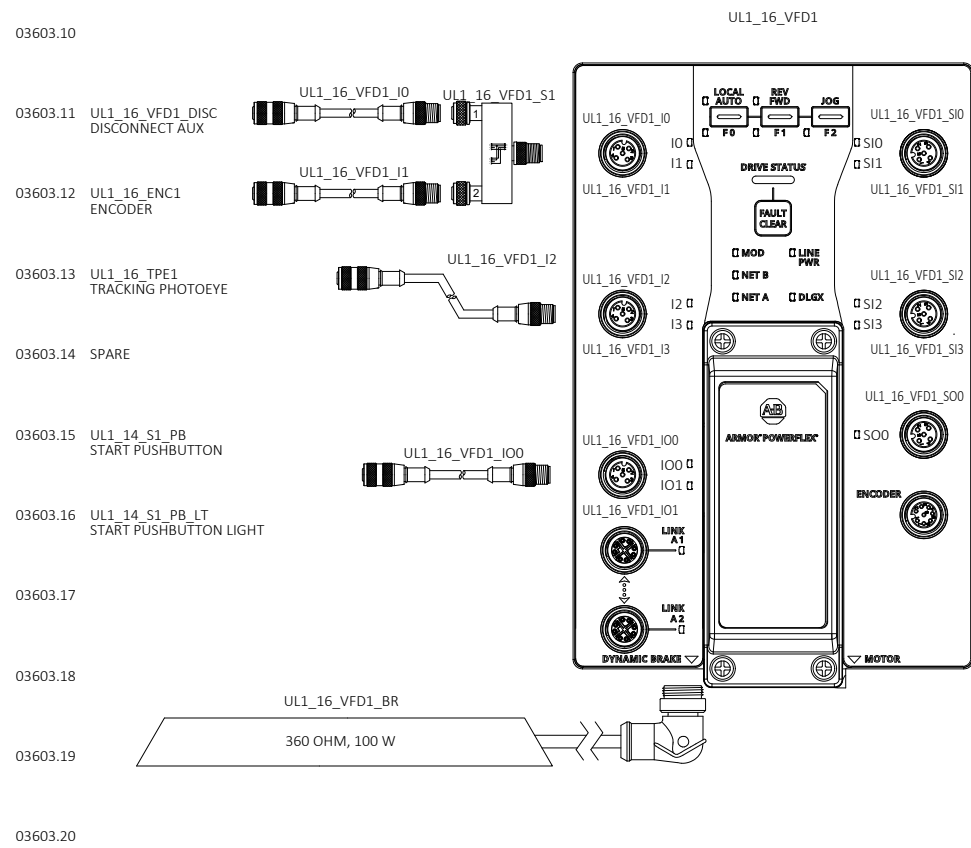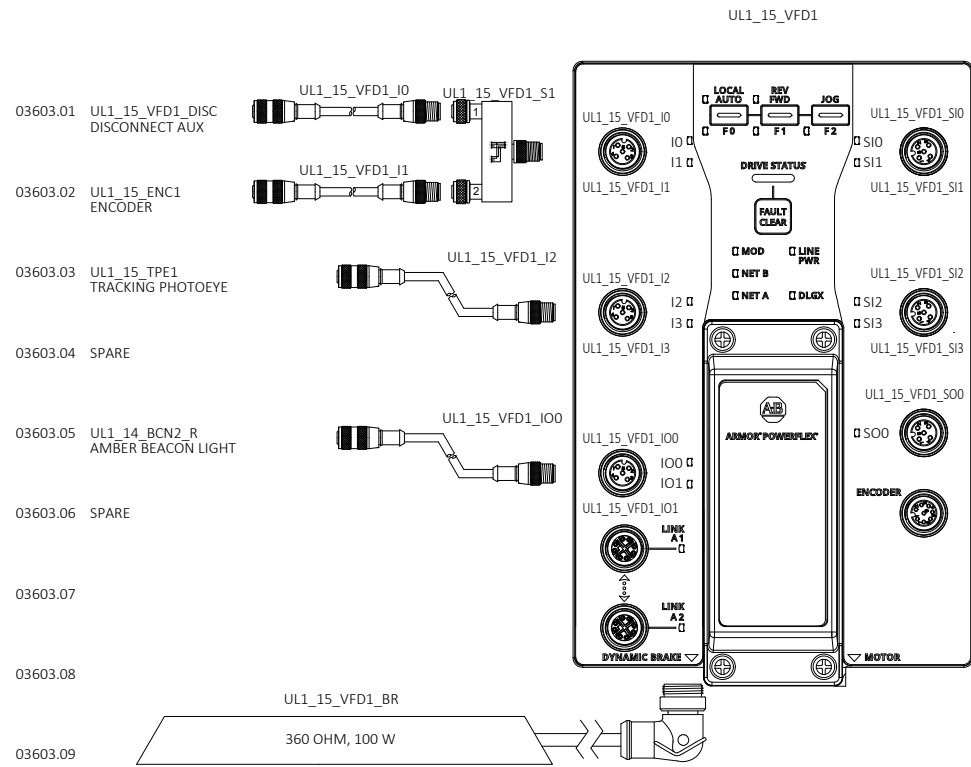

DRAWING REVISIONS			
REV	DESCRIPTION	DATE	BY
00	INITIAL DRAWINGS	05/19/2025	SK
01	ALARM HORN	06/19/2025	SN
A	AS-BUILT	11/13/2025	LB



CONFIDENTIAL: THE INFORMATION CONTAINED HEREIN IS PROPRIETARY INFORMATION OF AUTOMATION STANDARD LLC AND CONSTITUTES TRADE SECRETS PURSUANT TO THE UNIFORM TRADE SECRETS ACT. THIS INFORMATION SHALL ONLY BE USED IN THE PERFORMANCE OF CONTRACT WITH AUTOSTAND. THIS INFORMATION SHALL NOT BE USED, REPRODUCED OR EMPLOYED IN WHOLE PART, EXCEPT WITH AUTOSTAND'S PRIOR WRITTEN APPROVAL.


25K Amazon Cross-Belt Sort Center (ACBSC)
 ULI_15_VFD1/ULI_16_VFD1/
 ULI_17_VFD1/ULI_18_VFD1 IO DRAWINGS

AMAZON MTN6
 SPARROWS POINT, MD

FILENAME	
2429-AMZ-MTN6-MCM03-603	
D-SIZE SCALE	JOB NUMBER
NTS	2429
REVISION	SHEET
A	49

Plotted: 11/21/2025 6:07 PM



- 03604.01 UL1_19_VFD1_DISC DISCONNECT AUX
- 03604.02 UL1_19_ENC1 ENCODER
- 03604.03 UL1_19_TPE1 TRACKING PHOTOEYE
- 03604.04 UL1_19_TPE2 TRACKING PHOTOEYE

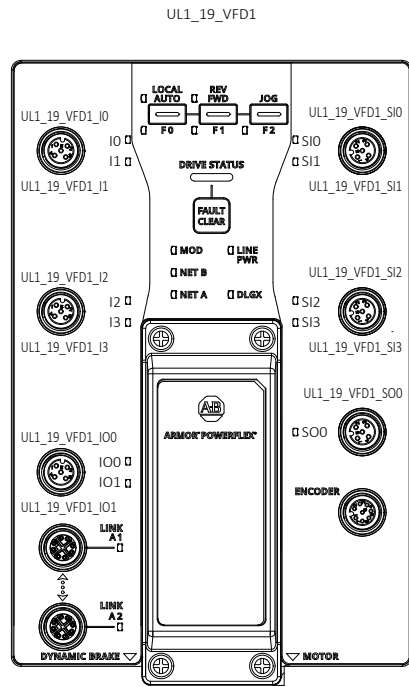

- 03604.05 SPARE
- 03604.06 SPARE
- 03604.07
- 03604.08


- 03604.09
- 03604.10

- 03604.11 UL1_20_VFD1_DISC DISCONNECT AUX
- 03604.12 SPARE
- 03604.13 SPARE
- 03604.14 SPARE
- 03604.15 SPARE
- 03604.16 SPARE
- 03604.17
- 03604.18
- 03604.19
- 03604.20

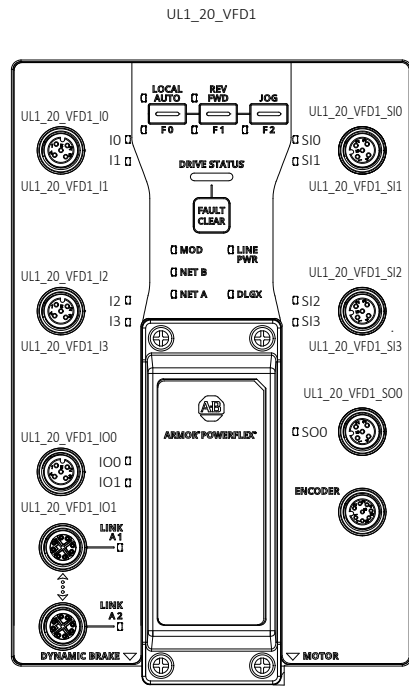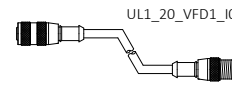


UL11_14_VFD1

- SPARE 03604.21 UL11_14_VFD1_DISC DISCONNECT AUX
- SPARE 03604.22 UL11_14_ENC1 ENCODER
- SPARE 03604.23 UL11_14_TPE1 TRACKING PHOTOEYE
- SPARE 03604.24 SPARE
- SPARE 03604.25 UL11_14_BCN1_A AMBER BEACON LIGHT
- 03604.26 UL11_14_BCN1_R RED BEACON LIGHT

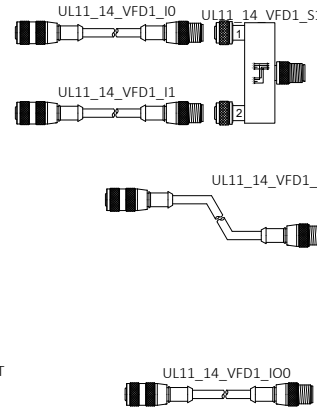


- 03604.27
- 03604.28
- 03604.29
- 03604.30


- SPARE 03604.31 UL11_15_VFD1_DISC DISCONNECT AUX
- SPARE 03604.32 UL11_15_ENC1 ENCODER
- SPARE 03604.33 UL11_15_TPE1 TRACKING PHOTOEYE
- SPARE 03604.34 SPARE
- SPARE 03604.35 UL11_14_BCN2_R RED BEACON LIGHT
- 03604.36 SPARE

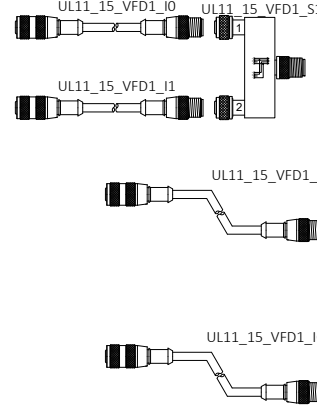

- 03604.37
- 03604.38
- 03604.39
- 03604.40

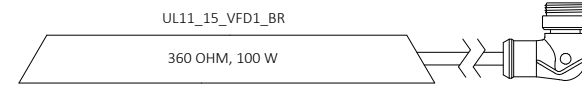

UL11_15_VFD1

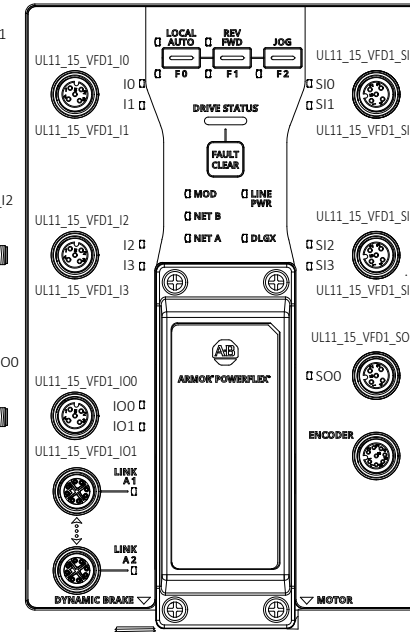

- UL11_14_EPC1 E-STOP PULLCORD
- UL11_14_EPC1_2 E-STOP PULLCORD
- UL11_14_EPC2 E-STOP PULLCORD
- UL11_14_EPC2_2 E-STOP PULLCORD
- SPARE





DRAWING REVISIONS			
REV	DESCRIPTION	DATE	BY
00	INITIAL DRAWINGS	05/19/2025	SK
01	ALARM HORN	06/19/2025	SN
A	AS-BUILT	11/13/2025	LB



CONFIDENTIAL: THE INFORMATION CONTAINED HEREIN IS PROPRIETARY INFORMATION OF AUTOMATION STANDARD LLC AND CONSTITUTES TRADE SECRETS PURSUANT TO THE UNIFORM TRADE SECRETS ACT. THIS INFORMATION SHALL ONLY BE USED IN THE PERFORMANCE OF CONTRACT WITH AUTOSTAND. THIS INFORMATION SHALL NOT BE USED, REPRODUCED OR EMPLOYED IN WHOLE PART, EXCEPT WITH AUTOSTAND'S PRIOR WRITTEN APPROVAL.

25K Amazon Cross-Belt Sort Center (ACBSC)
 UL1_19_VFD1/UL1_20_VFD1/
 UL11_14_VFD1/UL11_15_VFD1 IO DRAWINGS
 AMAZON MTN6
 SPARROWS POINT, MD

FILENAME	
2429-AMZ-MTN6-MCM03-604	
D-SIZE SCALE	JOB NUMBER
NTS	2429
REVISION	SHEET
A	50

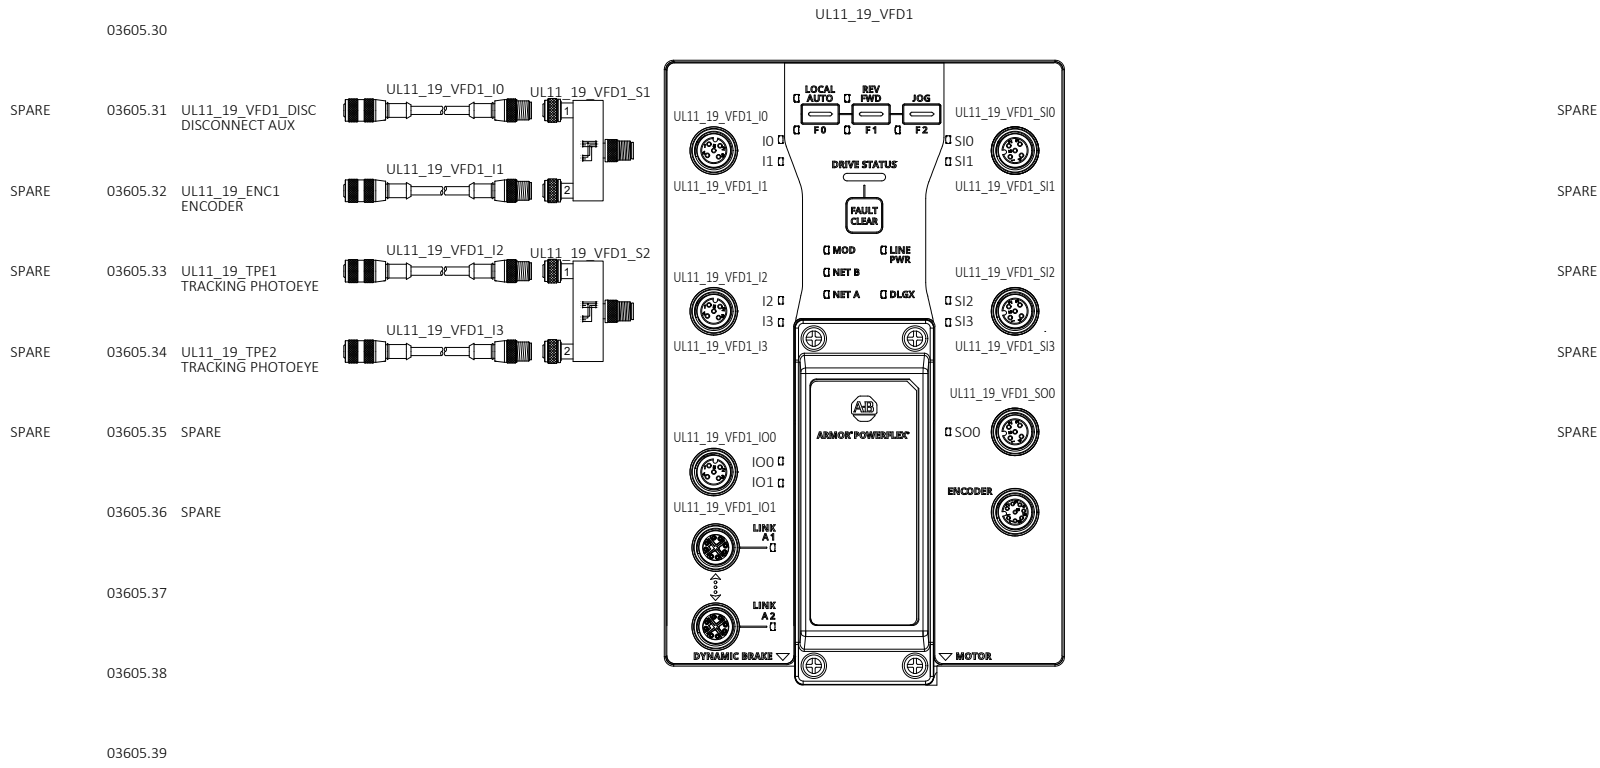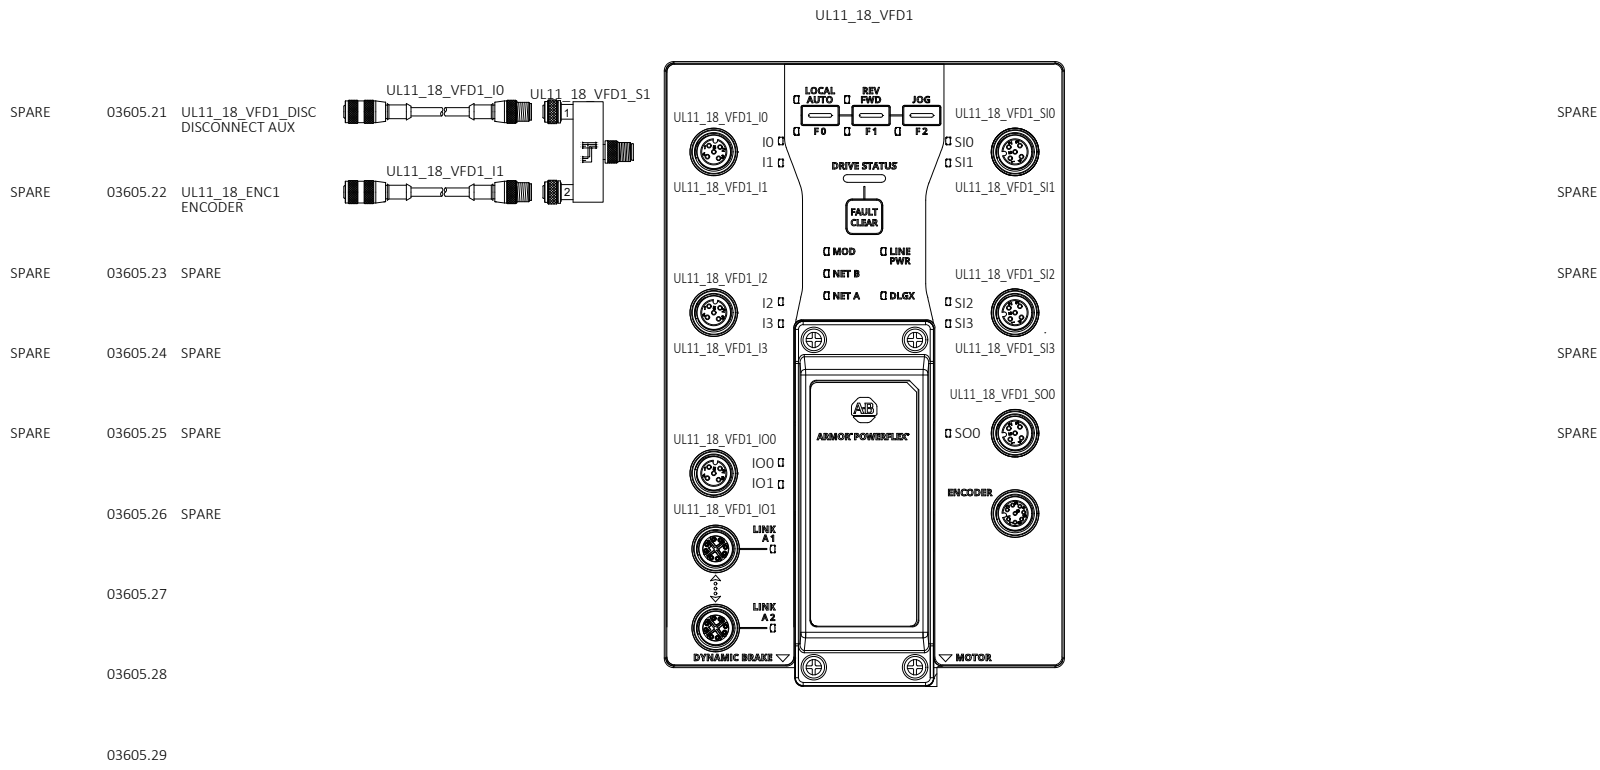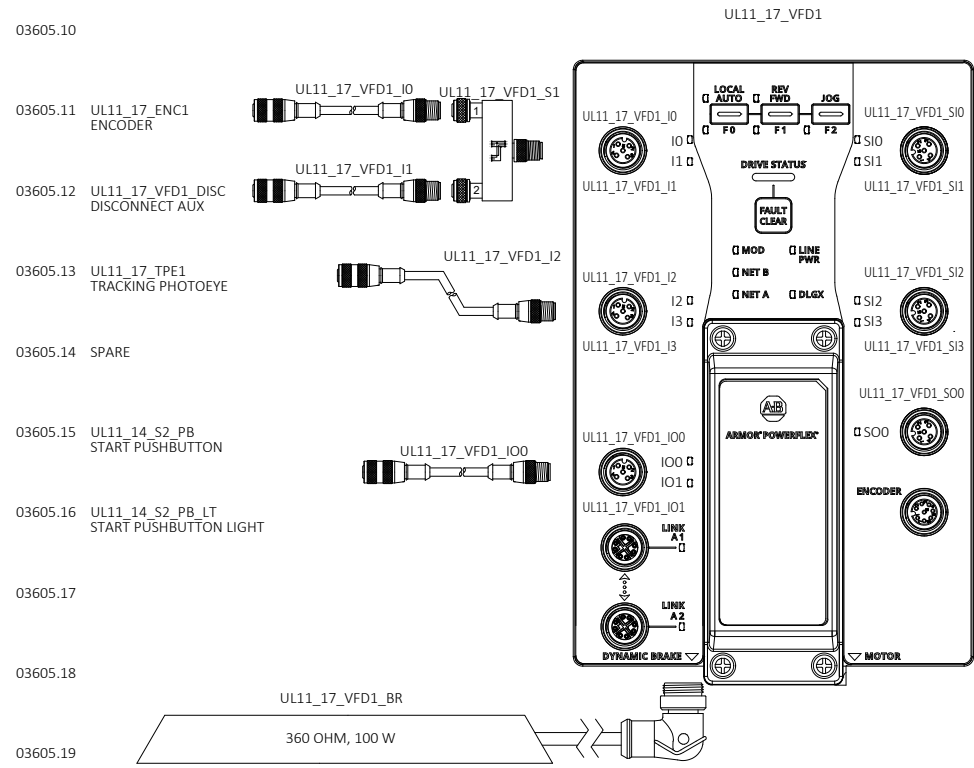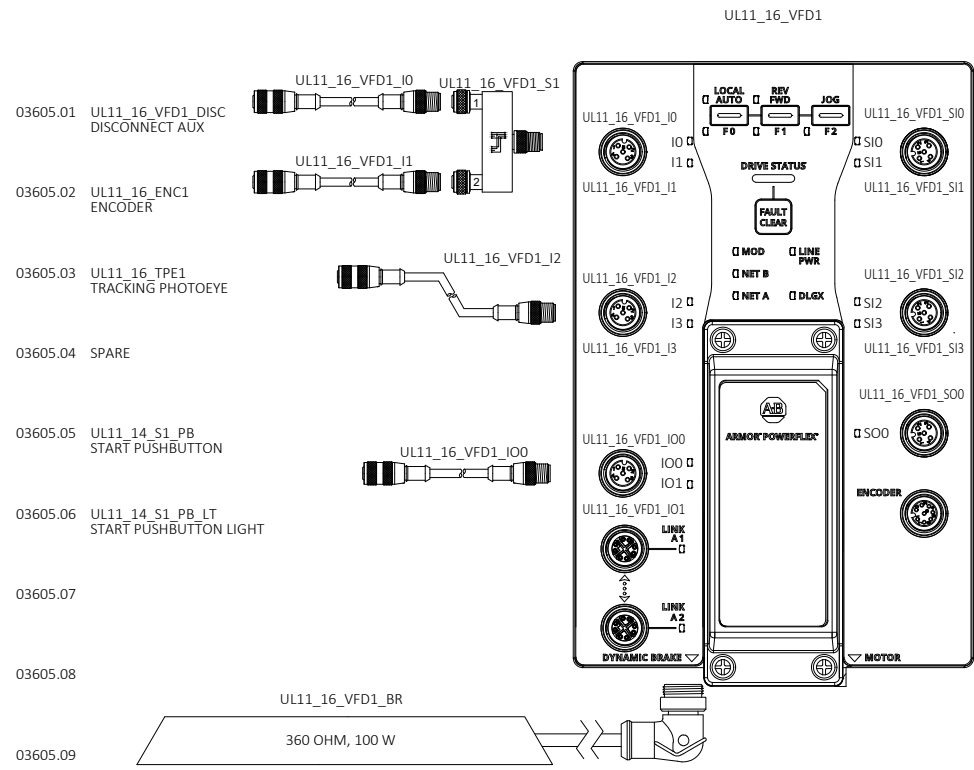

REV	DESCRIPTION	DATE	BY
00	INITIAL DRAWINGS	05/19/2025	SK
01	ALARM HORN	06/19/2025	SN
A	AS-BUILT	11/13/2025	LB


autStand
Automation Standard

CONFIDENTIAL: THE INFORMATION CONTAINED HEREIN IS PROPRIETARY INFORMATION OF AUTOMATION STANDARD LLC AND CONSTITUTES TRADE SECRETS PURSUANT TO THE UNIFORM TRADE SECRETS ACT. THIS INFORMATION SHALL ONLY BE USED IN THE PERFORMANCE OF CONTRACT WITH AUTOSTAND. THIS INFORMATION SHALL NOT BE USED, REPRODUCED OR EMPLOYED IN WHOLE PART, EXCEPT WITH AUTOSTAND'S PRIOR WRITTEN APPROVAL.

25K Amazon Cross-Belt Sort Center (ACBSC)
UL11_16_VFD1/UL11_17_VFD1/
UL11_18_VFD1/UL11_19_VFD1 IO DRAWINGS

AMAZON MTN6
SPARROWS POINT, MD

FILENAME	D-SIZE SCALE	JOB NUMBER
2429-AMZ-MTN6-MCM03-605	NTS	2429
REVISION	SHEET	
A	51	

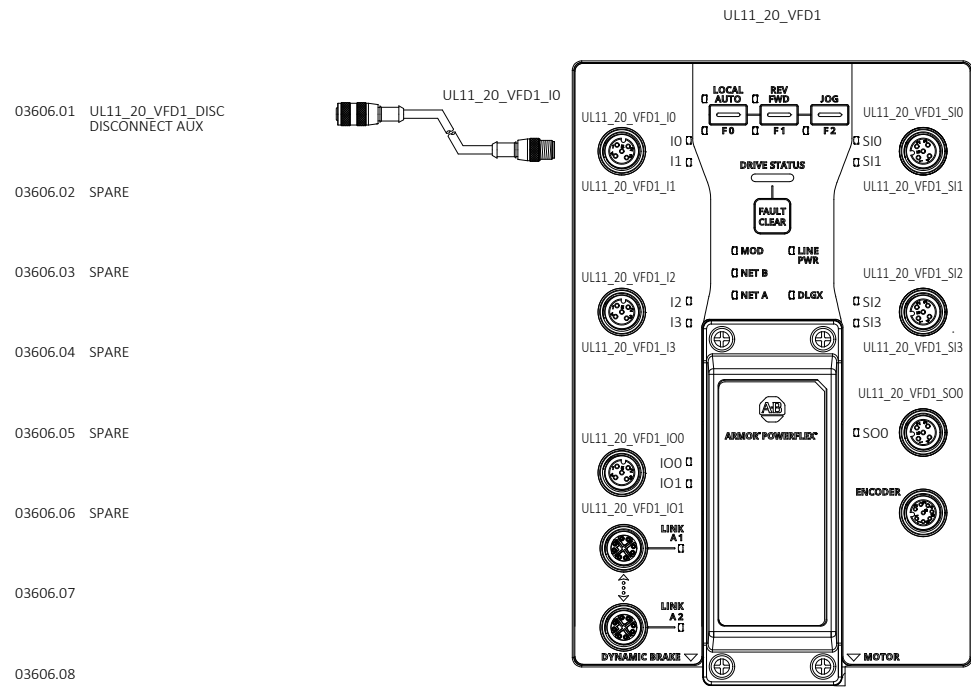

03606.01 UL11_20_VFD1_DISC DISCONNECT AUX

03606.02 SPARE

03606.03 SPARE

03606.04 SPARE

03606.05 SPARE

03606.06 SPARE

03606.07

03606.08

03606.09

03606.10

03606.11 UL13_13_VFD1_DISC DISCONNECT AUX

03606.12 UL13_13_ENC1 ENCODER

03606.13 UL13_13_TPE1 TRACKING PHOTOEYE

03606.14 SPARE

03606.15 UL13_13_BCN1_A AMBER BEACON LIGHT

03606.16 UL13_13_BCN1_R RED BEACON LIGHT



03606.17

03606.18

03606.19

03606.20

DRAWING REVISIONS			
REV	DESCRIPTION	DATE	BY
00	INITIAL DRAWINGS	05/19/2025	SK
01	ALARM HORN	06/19/2025	SN
A	AS-BUILT	11/13/2025	LB

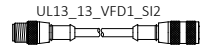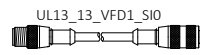

SPARE

SPARE

03606.26 SPARE

03606.27

03606.28

03606.29

03606.30

SPARE

SPARE

03606.36 UL13_13_S1_PB_LT START PUSHBUTTON LIGHT

03606.37

03606.38

03606.39

03606.40

UL13_13_EPC1 E-STOP PULLCORD

UL13_13_EPC1_2 E-STOP PULLCORD

UL13_13_EPC2 E-STOP PULLCORD

UL13_13_EPC2_2 E-STOP PULLCORD

SPARE


03606.36 UL13_13_S1_PB_LT START PUSHBUTTON LIGHT

03606.37

03606.38

03606.39

03606.40

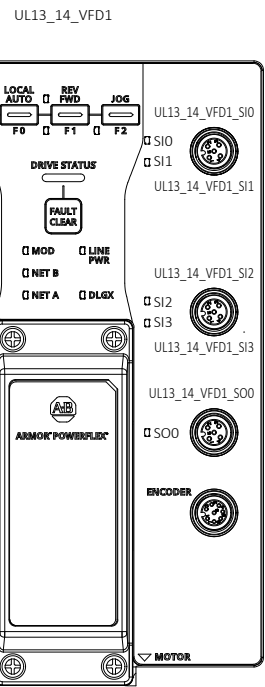

03606.21 UL13_14_VFD1_DISC DISCONNECT AUX

03606.22 UL13_14_ENC1 ENCODER

03606.23 UL13_14_TPE1 TRACKING PHOTOEYE

03606.24 SPARE

03606.25 UL13_13_BCN2_R RED BEACON LIGHT

03606.26 SPARE

03606.27

03606.28

03606.29

03606.30

03606.31 UL13_15_VFD1_DISC DISCONNECT AUX

03606.32 UL13_15_ENC1 ENCODER

03606.33 UL13_15_TPE1 TRACKING PHOTOEYE

03606.34 SPARE

03606.35 UL13_13_S1_PB START PUSHBUTTON



03606.36 UL13_13_S1_PB_LT START PUSHBUTTON LIGHT

03606.37

03606.38

03606.39

03606.40



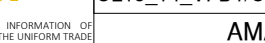
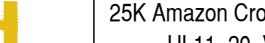


CONFIDENTIAL: THE INFORMATION CONTAINED HEREIN IS PROPRIETARY INFORMATION OF AUTOMATION STANDARD LLC AND CONSTITUTES TRADE SECRETS PURSUANT TO THE UNIFORM TRADE SECRETS ACT. THIS INFORMATION SHALL ONLY BE USED IN THE PERFORMANCE OF CONTRACT WITH AUTOSTAND. THIS INFORMATION SHALL NOT BE USED, REPRODUCED OR EMPLOYED IN WHOLE PART, EXCEPT WITH AUTOSTAND'S PRIOR WRITTEN APPROVAL.

25K Amazon Cross-Belt Sort Center (ACBSC)
 UL11_20_VFD1/UL13_13_VFD1/
 UL13_14_VFD1/UL13_15_VFD1 IO DRAWINGS
 AMAZON MTN6
 SPARROWS POINT, MD

FILENAME	2429-AMZ-MTN6-MCM03-606
D-SIZE SCALE	JOB NUMBER
NTS	2429
REVISION	SHEET
A	52

Plotted: 11/21/2025 6:08 PM

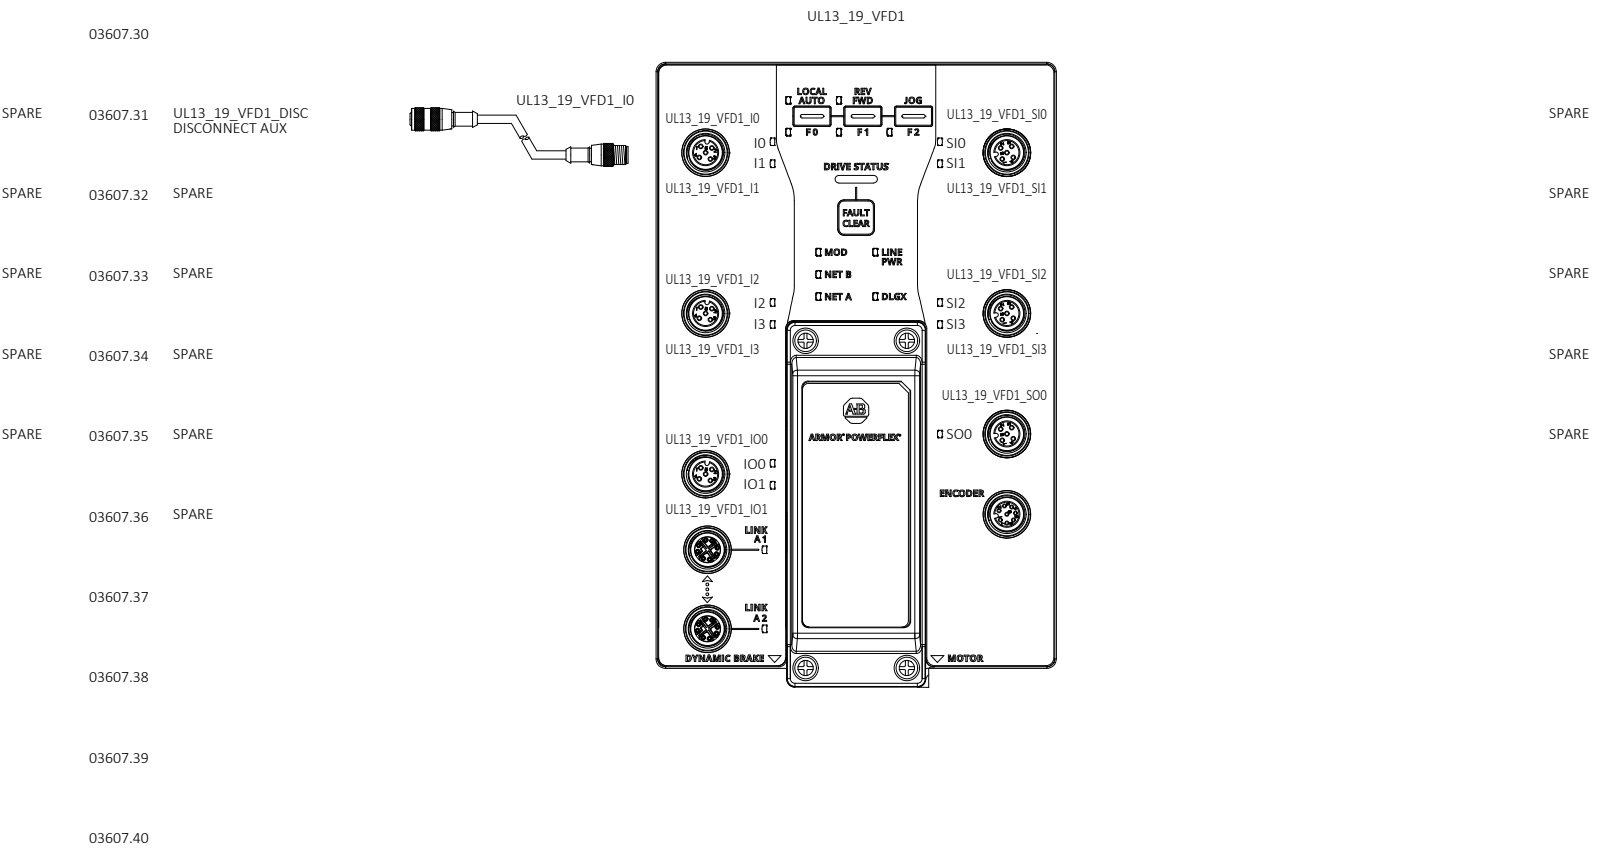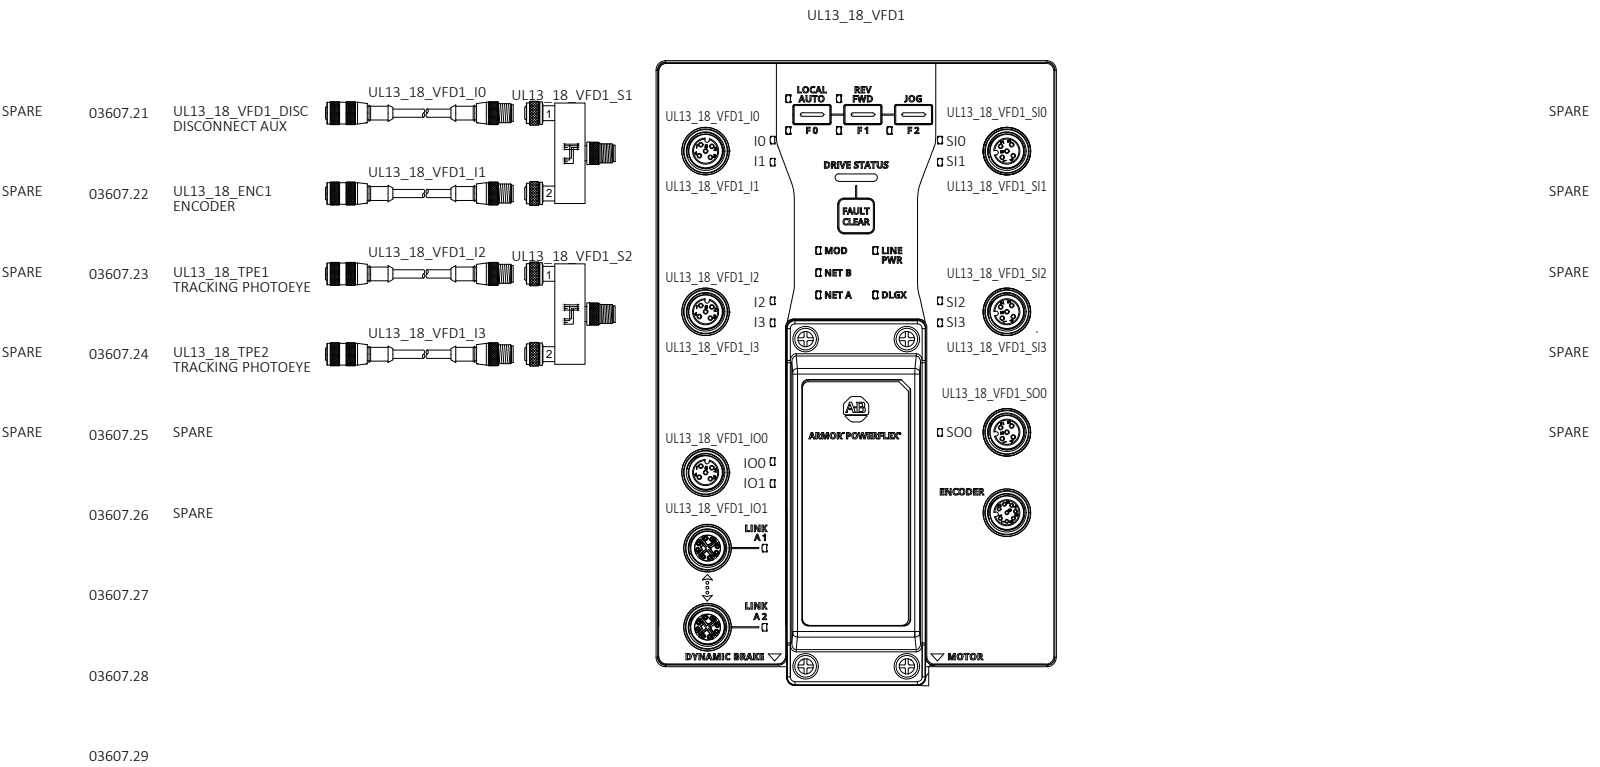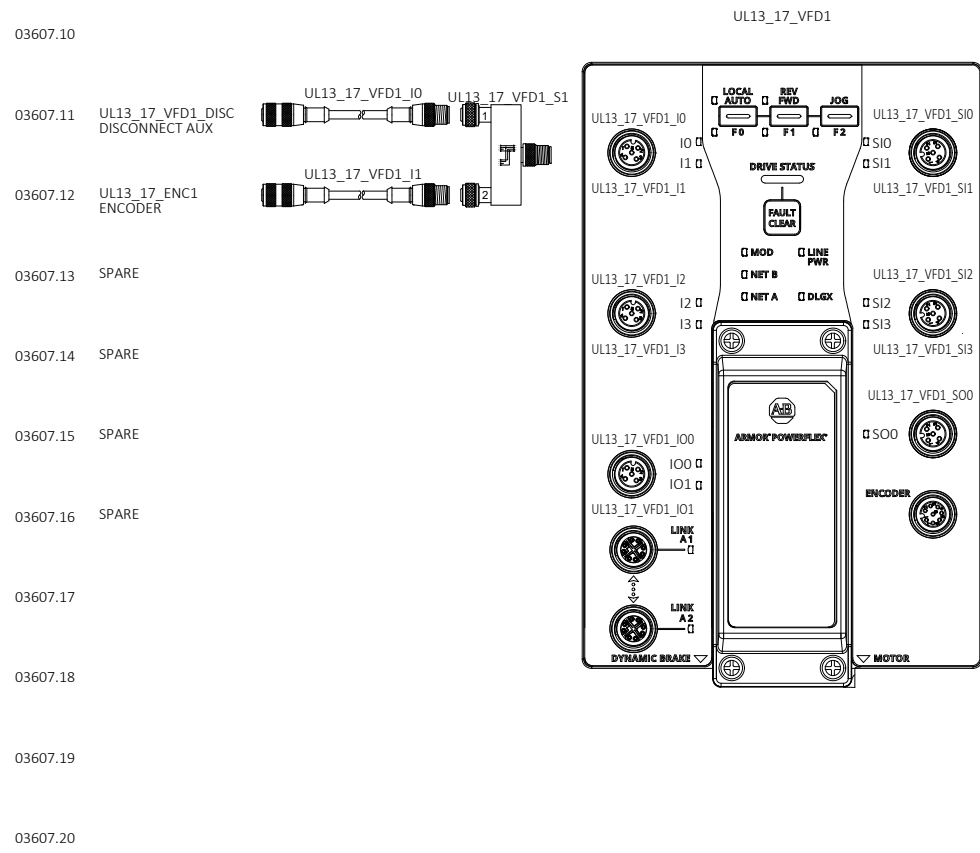
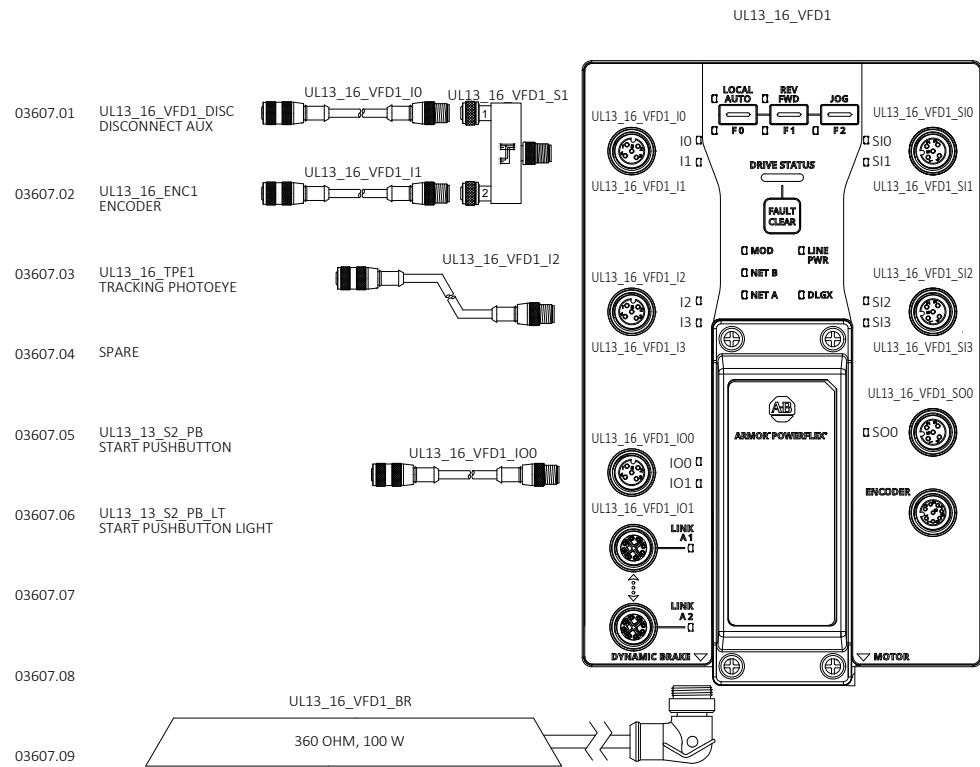


DRAWING REVISIONS			
REV	DESCRIPTION	DATE	BY
00	INITIAL DRAWINGS	05/19/2025	SK
01	ALARM HORN	06/19/2025	SN
A	AS-BUILT	11/13/2025	LB



CONFIDENTIAL: THE INFORMATION CONTAINED HEREIN IS PROPRIETARY INFORMATION OF AUTOMATION STANDARD LLC AND CONSTITUTES TRADE SECRETS PURSUANT TO THE UNIFORM TRADE SECRETS ACT. THIS INFORMATION SHALL ONLY BE USED IN THE PERFORMANCE OF CONTRACT WITH AUTOSTAND. THIS INFORMATION SHALL NOT BE USED, REPRODUCED OR EMPLOYED IN WHOLE PART, EXCEPT WITH AUTOSTAND'S PRIOR WRITTEN APPROVAL.

25K Amazon Cross-Belt Sort Center (ACBSC)
 UL13_16_VFD1/UL13_17_VFD1/
 UL13_18_VFD1/UL13_19_VFD1 IO DRAWINGS
 AMAZON MTN6
 SPARROWS POINT, MD

FILENAME	
2429-AMZ-MTN6-MCM03-607	
D-SIZE SCALE	JOB NUMBER
NTS	2429
REVISION	SHEET
A	53

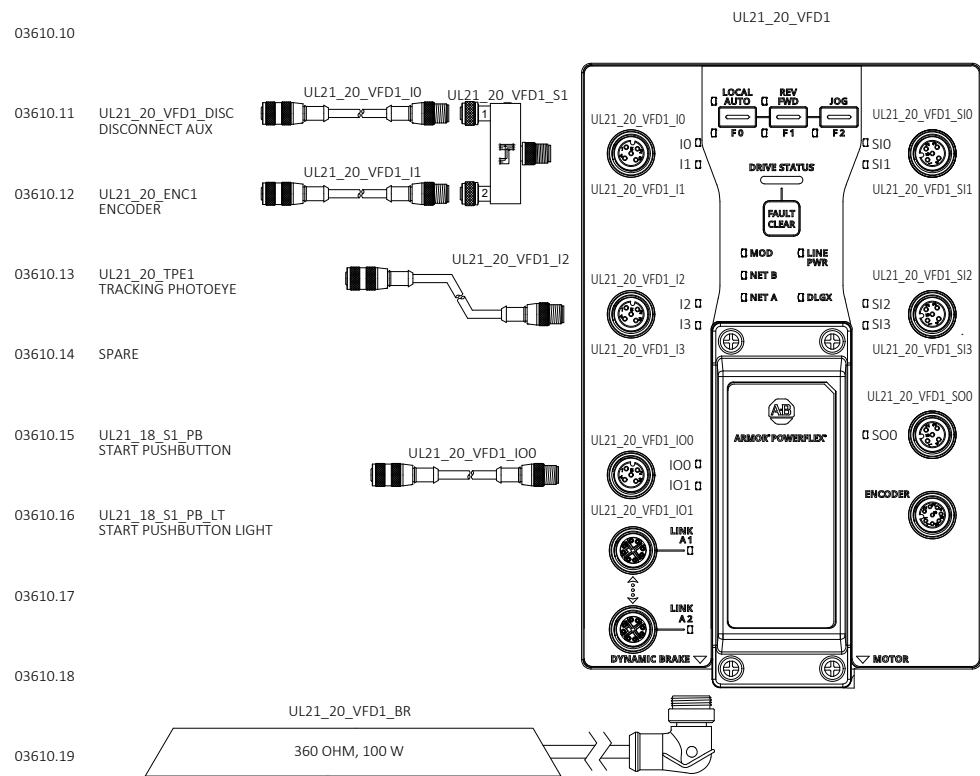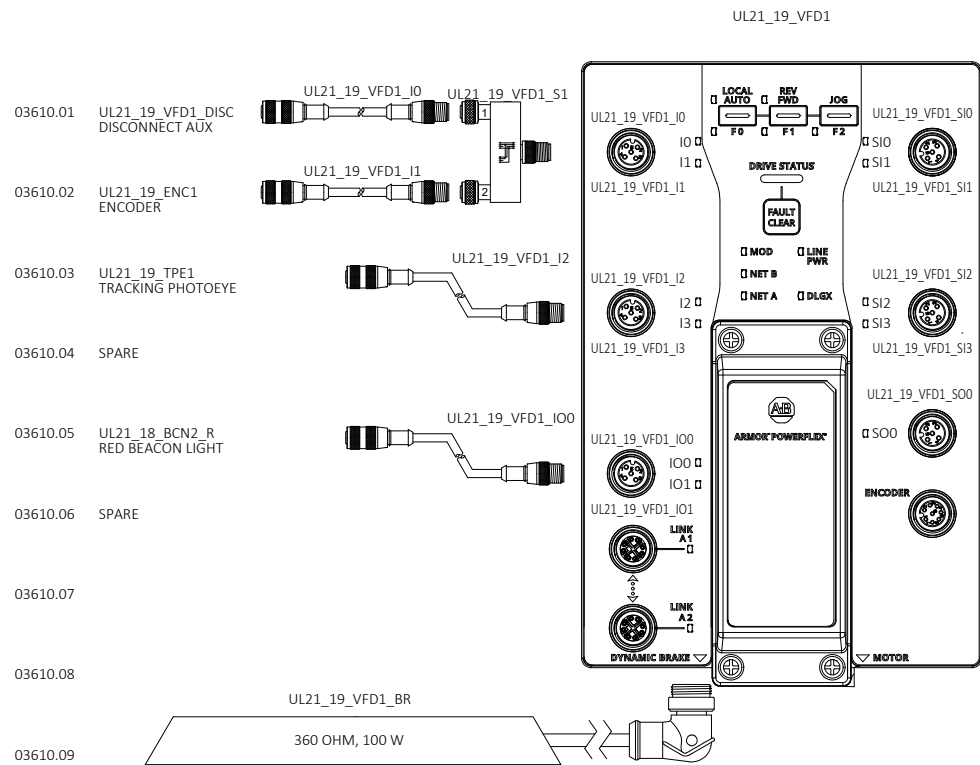

03610.20

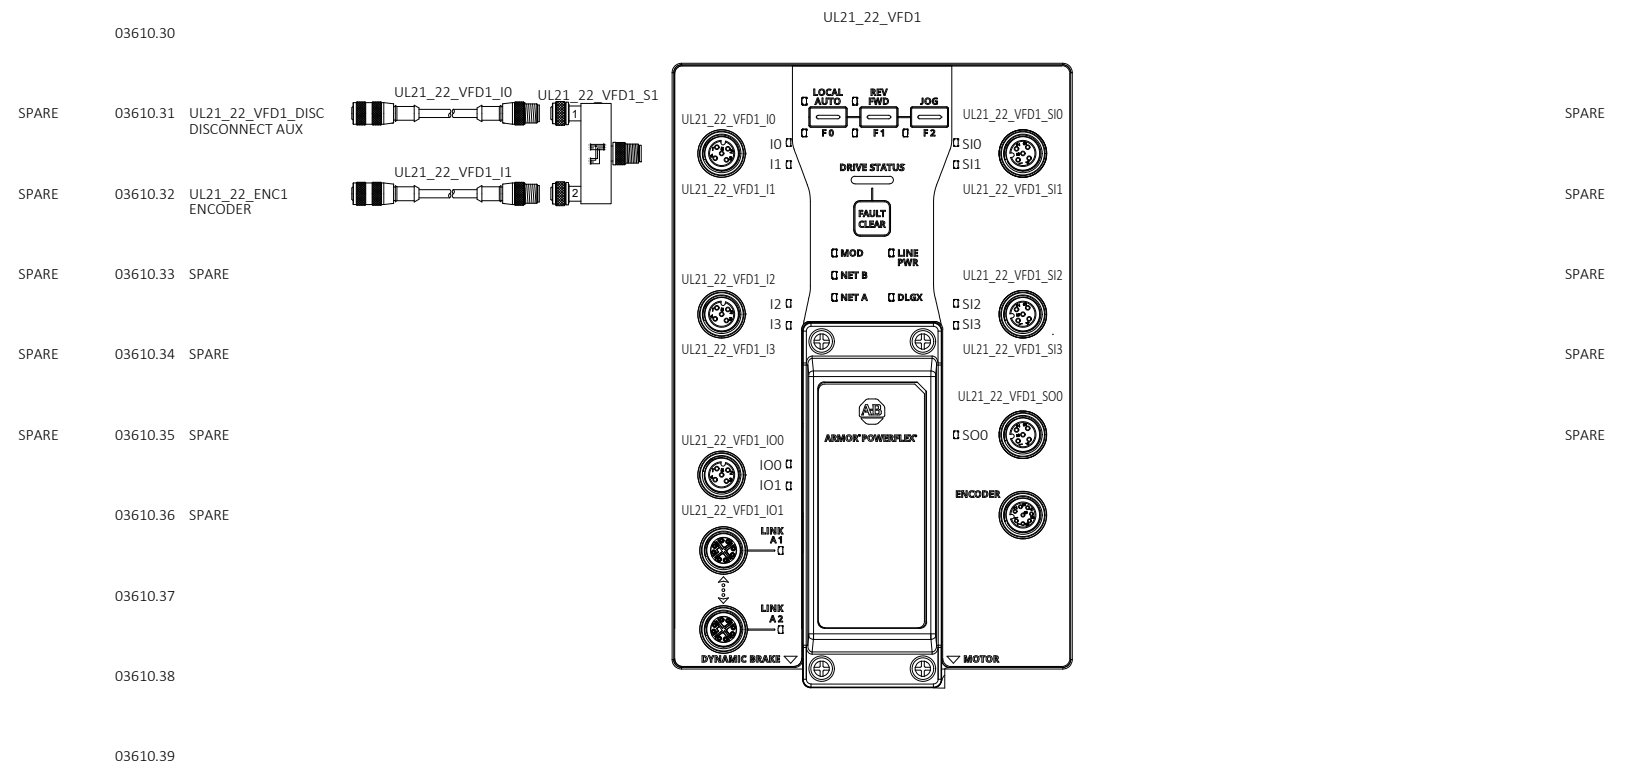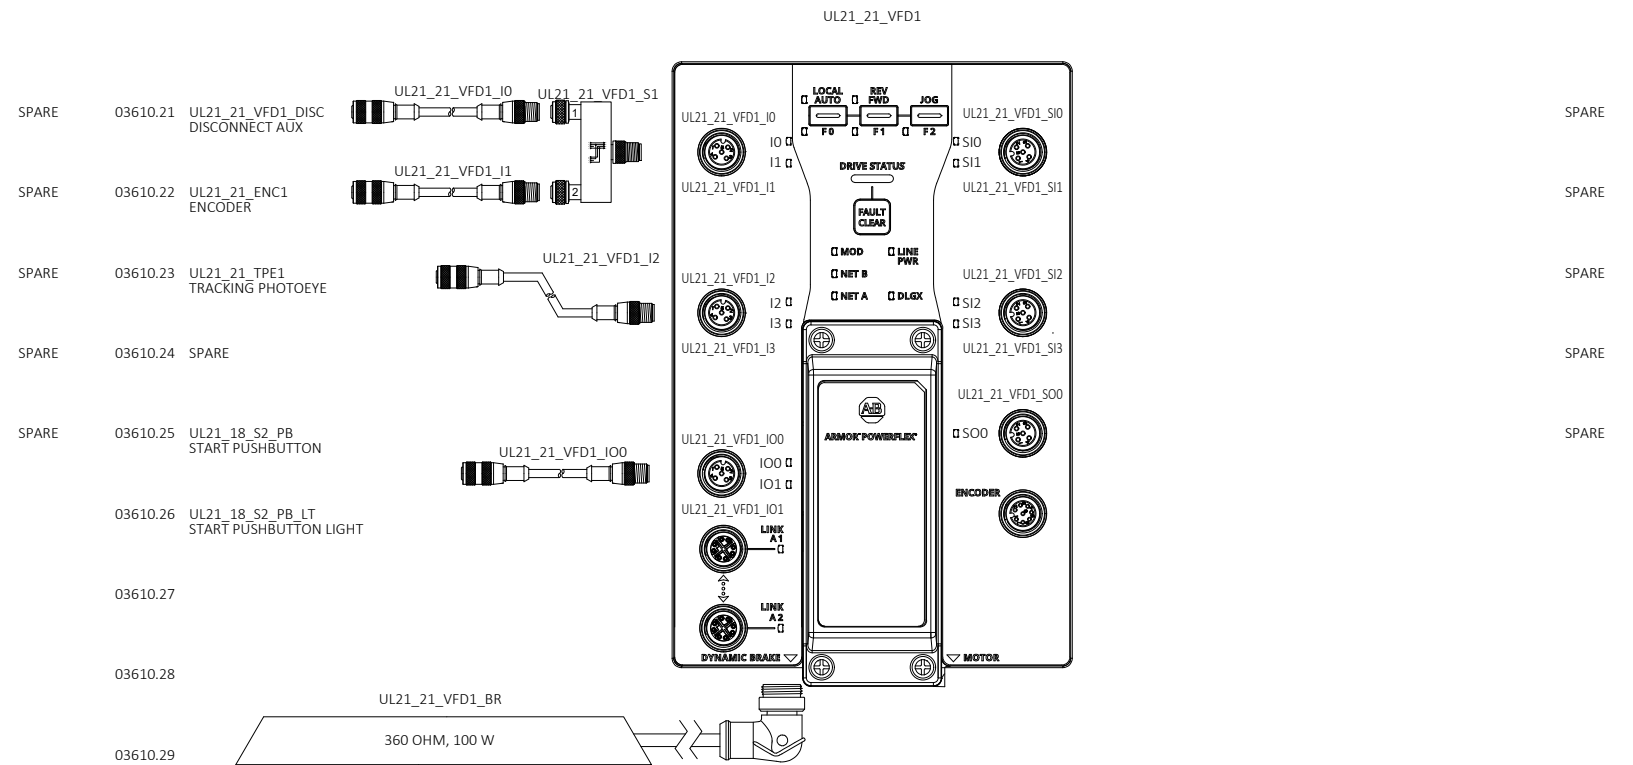

03610.40

DRAWING REVISIONS			
REV	DESCRIPTION	DATE	BY
00	INITIAL DRAWINGS	05/19/2025	SK
01	ALARM HORN	06/19/2025	SN
A	AS-BUILT	11/13/2025	LB





autStand
Automation Standard

CONFIDENTIAL: THE INFORMATION CONTAINED HEREIN IS PROPRIETARY INFORMATION OF AUTOMATION STANDARD LLC AND CONSTITUTES TRADE SECRETS PURSUANT TO THE UNIFORM TRADE SECRETS ACT. THIS INFORMATION SHALL ONLY BE USED IN THE PERFORMANCE OF CONTRACT WITH AUTOSTAND. THIS INFORMATION SHALL NOT BE USED, REPRODUCED OR EMPLOYED IN WHOLE PART, EXCEPT WITH AUTOSTAND'S PRIOR WRITTEN APPROVAL.

25K Amazon Cross-Belt Sort Center (ACBSC)
UL21_19_VFD1/UL21_20_VFD1/
UL21_21_VFD1/UL21_22_VFD1 IO DRAWINGS

AMAZON MTN6
SPARROWS POINT, MD

FILENAME	
2429-AMZ-MTN6-MCM03-610	
D-SIZE SCALE	JOB NUMBER
NTS	2429
REVISION	SHEET
A	56

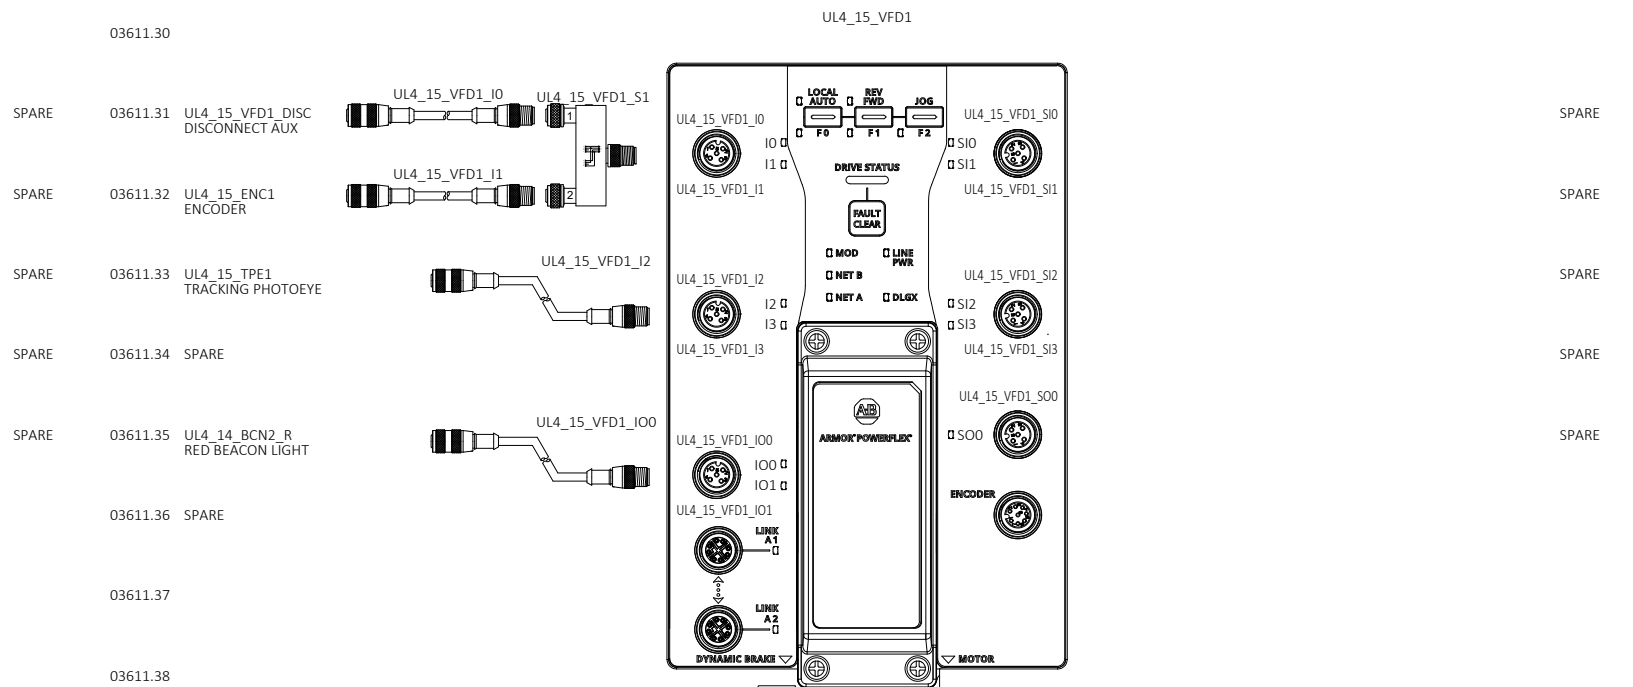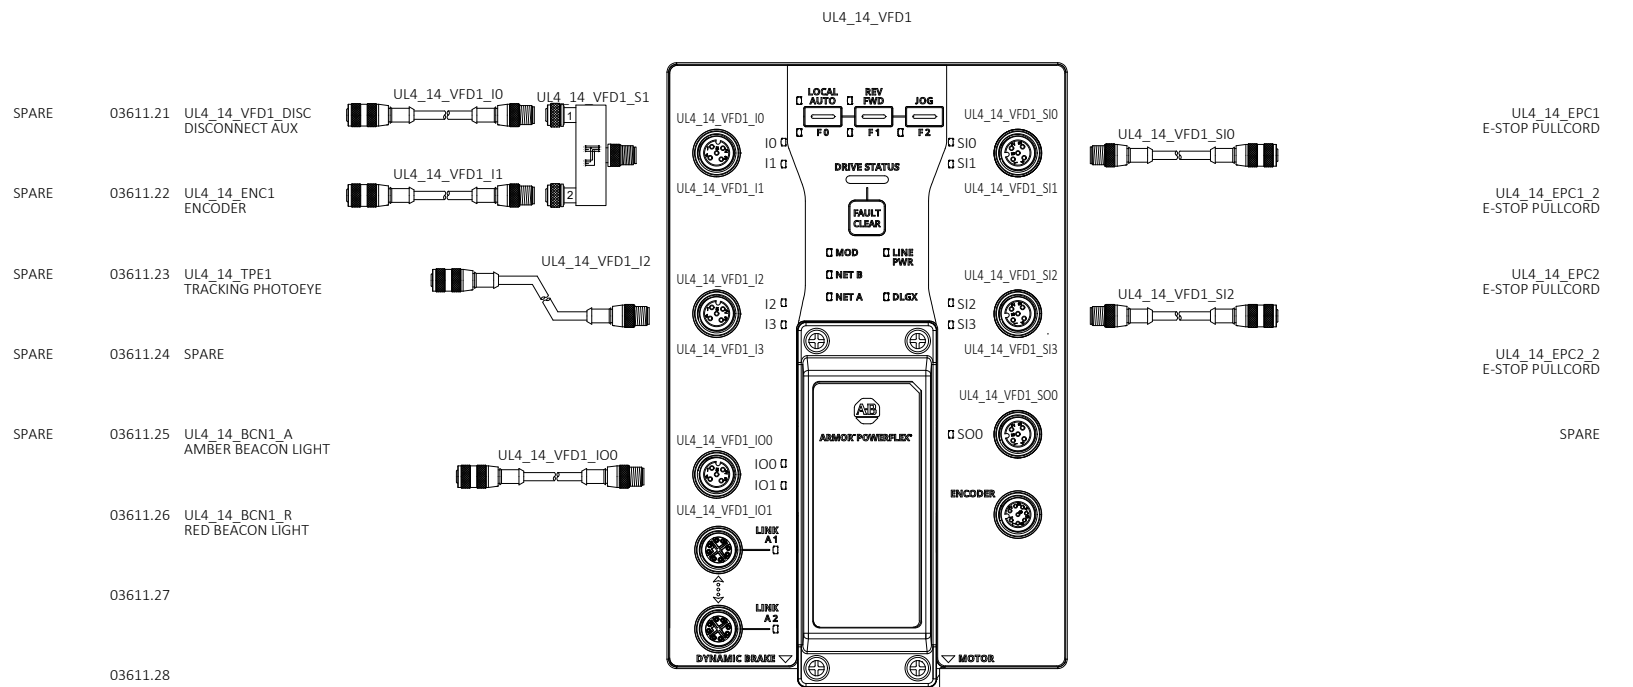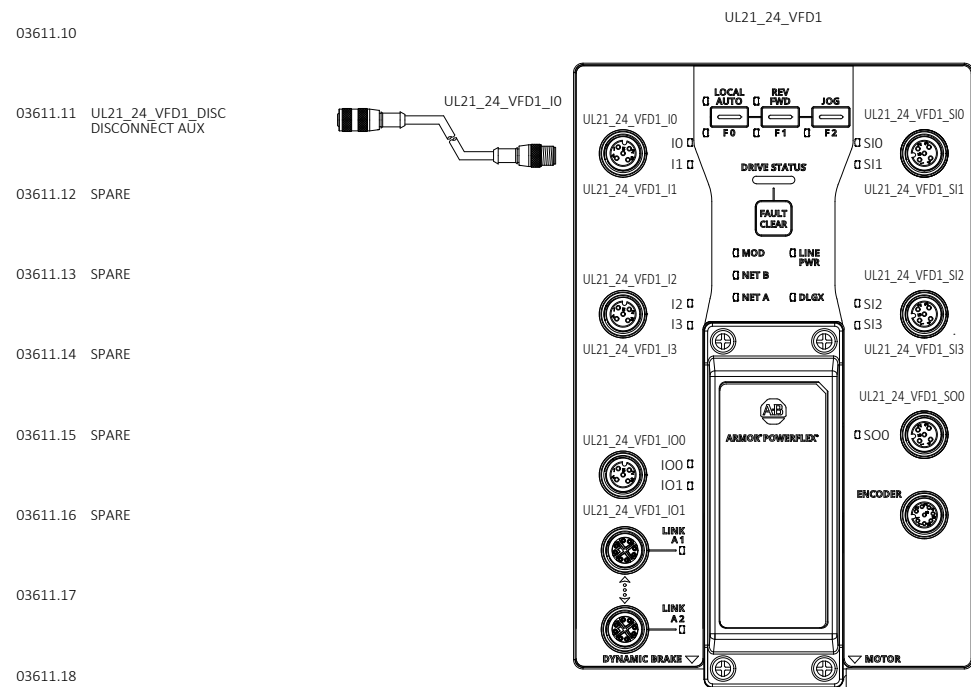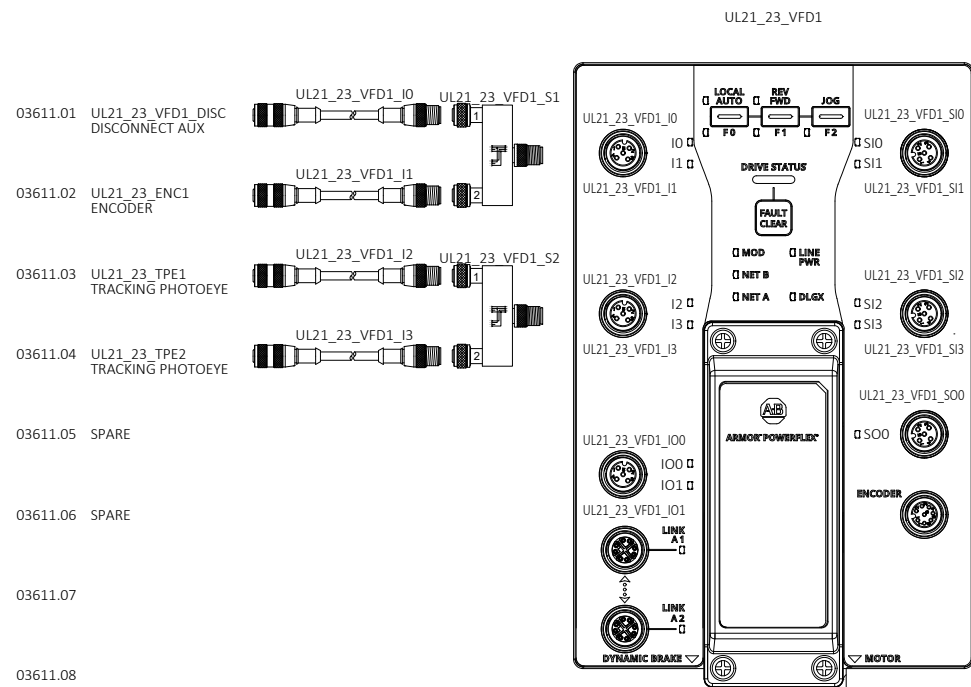

DRAWING REVISIONS			
REV	DESCRIPTION	DATE	BY
00	INITIAL DRAWINGS	05/19/2025	SK
01	ALARM HORN	06/19/2025	SN
A	AS-BUILT	11/13/2025	LB




CONFIDENTIAL: THE INFORMATION CONTAINED HEREIN IS PROPRIETARY INFORMATION OF AUTOMATION STANDARD LLC AND CONSTITUTES TRADE SECRETS PURSUANT TO THE UNIFORM TRADE SECRETS ACT. THIS INFORMATION SHALL ONLY BE USED IN THE PERFORMANCE OF CONTRACT WITH AUTOSTAND. THIS INFORMATION SHALL NOT BE USED, REPRODUCED OR EMPLOYED IN WHOLE PART, EXCEPT WITH AUTOSTAND'S PRIOR WRITTEN APPROVAL.

25K Amazon Cross-Belt Sort Center (ACBSC)
 UL21_23_VFD1/UL21_24_VFD1/
 UL4_14_VFD1/UL4_15_VFD1 IO DRAWINGS

AMAZON MTN6
 SPARROWS POINT, MD

FILENAME	
2429-AMZ-MTN6-MCM03-611	
D-SIZE SCALE	JOB NUMBER
NTS	2429
REVISION	SHEET
A	57

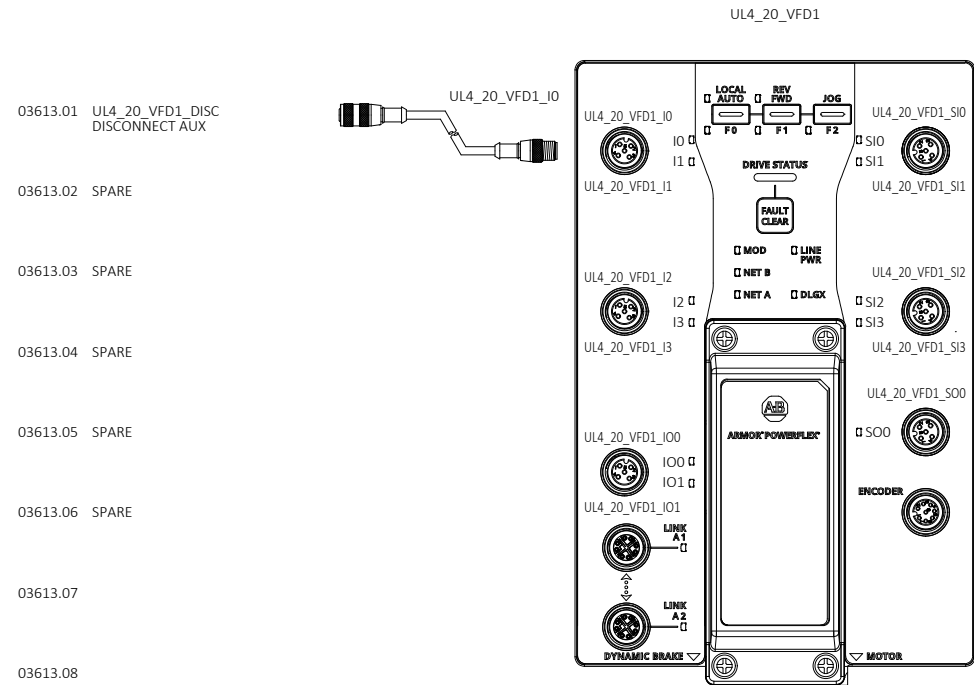

03613.01 UL4_20_VFD1_DISC
DISCONNECT AUX

03613.02 SPARE

03613.03 SPARE

03613.04 SPARE

03613.05 SPARE

03613.06 SPARE

03613.07

03613.08

03613.09

03613.10

03613.11

03613.12 UL7_14_VFD1_DISC
DISCONNECT AUX

03613.13 UL7_14_ENC1
ENCODER

03613.14 UL7_14_TPE1
TRACKING PHOTOEYE

03613.15 SPARE

03613.16 UL7_14_BC1_A
AMBER BEACON LIGHT


03613.17 UL7_14_BC1_R
RED BEACON LIGHT

03613.18

03613.19

03613.20

DRAWING REVISIONS			
REV	DESCRIPTION	DATE	BY
00	INITIAL DRAWINGS	05/19/2025	SK
01	ALARM HORN	06/19/2025	SN
A	AS-BUILT	11/13/2025	LB

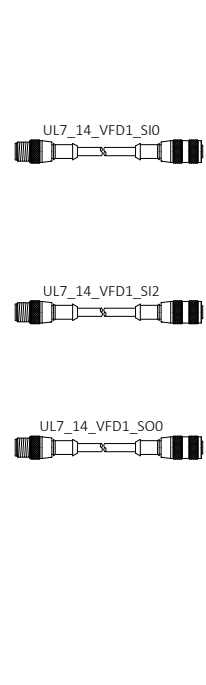

UL7_14_VFD1_SIO

UL7_14_VFD1_S12

UL7_14_VFD1_S00

DRAWING REVISIONS			
REV	DESCRIPTION	DATE	BY
00	INITIAL DRAWINGS	05/19/2025	SK
01	ALARM HORN	06/19/2025	SN
A	AS-BUILT	11/13/2025	LB

SPARE

SPARE

03613.26

03613.27

03613.28

03613.29

03613.30

03613.31

UL7_14_EPC1
E-STOP PULLCORD

UL7_14_EPC2
E-STOP PULLCORD

UL7_14_EPC2
E-STOP PULLCORD

UL7_14_EPC2
E-STOP PULLCORD


UL7_14_BC2_R
RED BEACON LIGHT

03613.37

03613.38

03613.39

03613.40

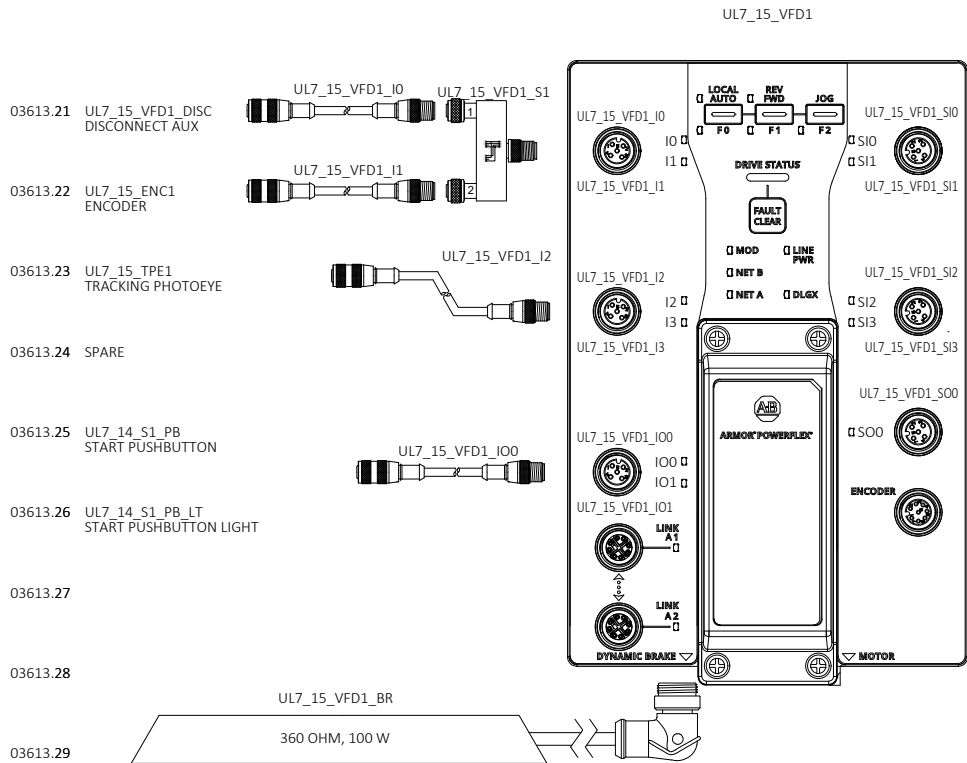

03613.21 UL7_15_VFD1_DISC
DISCONNECT AUX

03613.22 UL7_15_ENC1
ENCODER

03613.23 UL7_15_TPE1
TRACKING PHOTOEYE

03613.24 SPARE

03613.25 UL7_14_S1_PB
START PUSHBUTTON

03613.26 UL7_14_S1_PB_LT
START PUSHBUTTON LIGHT

03613.27

03613.28

03613.29

03613.30

03613.31

03613.32 UL7_16_VFD1_DISC
DISCONNECT AUX

03613.33 UL7_16_ENC1
ENCODER

03613.34 UL7_16_TPE1
TRACKING PHOTOEYE

03613.35 SPARE

03613.36 UL7_14_S2_PB
START PUSHBUTTON


03613.37 UL7_14_S2_PB_LT
START PUSHBUTTON LIGHT

03613.38

03613.39

03613.40

DRAWING REVISIONS			
REV	DESCRIPTION	DATE	BY
00	INITIAL DRAWINGS	05/19/2025	SK
01	ALARM HORN	06/19/2025	SN
A	AS-BUILT	11/13/2025	LB

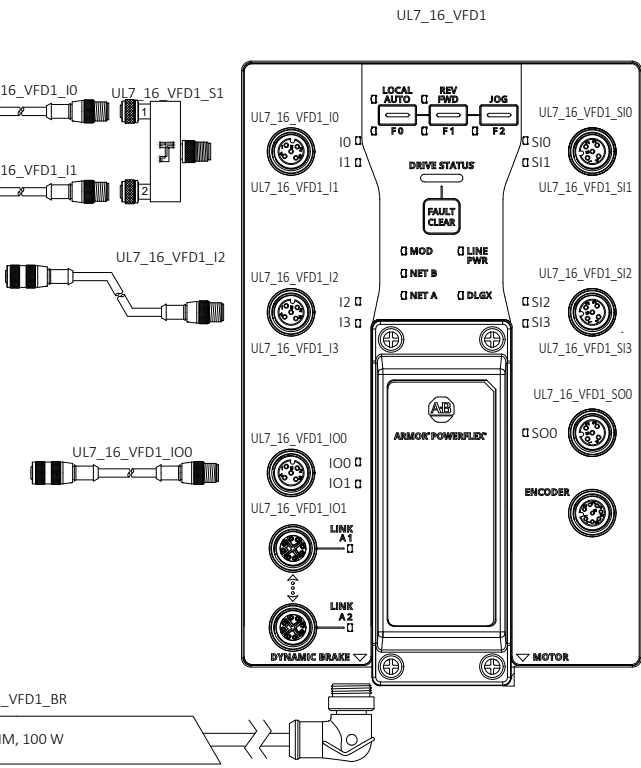

UL7_16_VFD1_SIO

UL7_16_VFD1_S12

UL7_16_VFD1_S00

DRAWING REVISIONS			
REV	DESCRIPTION	DATE	BY
00	INITIAL DRAWINGS	05/19/2025	SK
01	ALARM HORN	06/19/2025	SN
A	AS-BUILT	11/13/2025	LB

SPARE

SPARE

03613.26

03613.27

03613.28

DRAWING REVISIONS			
REV	DESCRIPTION	DATE	BY
00	INITIAL DRAWINGS	05/19/2025	SK
01	ALARM HORN	06/19/2025	SN
A	AS-BUILT	11/13/2025	LB

SPARE

SPARE

03613.26

03613.27

03613.28

DRAWING REVISIONS			
REV	DESCRIPTION	DATE	BY
00	INITIAL DRAWINGS	05/19/2025	SK
01	ALARM HORN	06/19/2025	SN
A	AS-BUILT	11/13/2025	LB

Plotted: 11/21/2025 6:08 PM

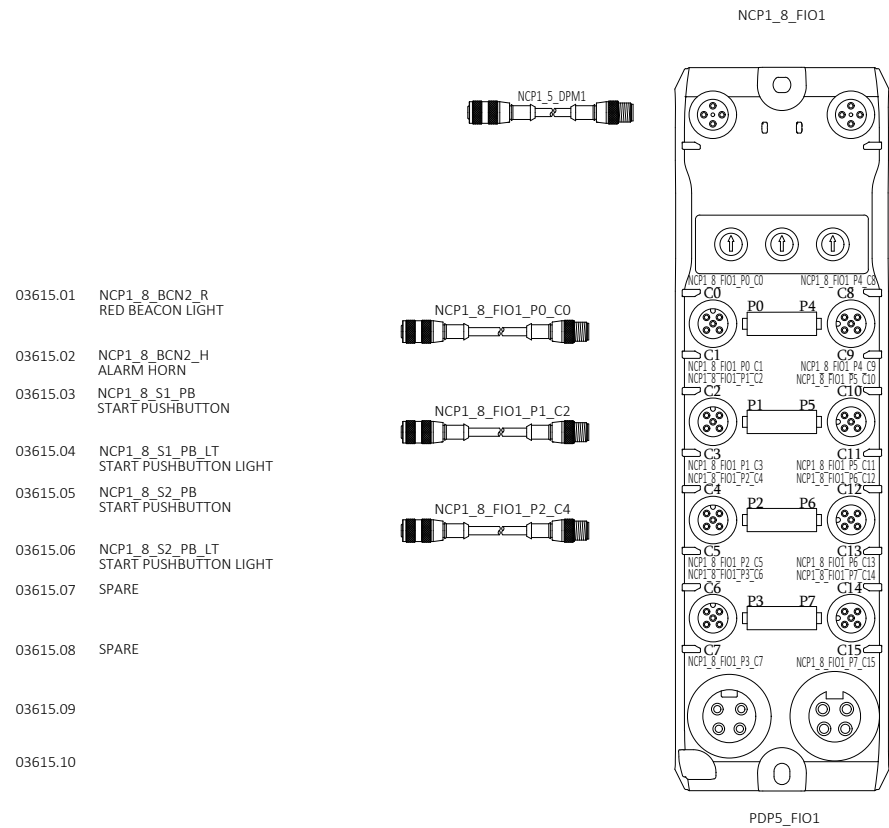


- 03615.01 NCP1_8_BCN2_R RED BEACON LIGHT
- 03615.02 NCP1_8_BCN2_H ALARM HORN
- 03615.03 NCP1_8_S1_PB START PUSHBUTTON
- 03615.04 NCP1_8_S1_PB_LT START PUSHBUTTON LIGHT
- 03615.05 NCP1_8_S2_PB START PUSHBUTTON
- 03615.06 NCP1_8_S2_PB_LT START PUSHBUTTON LIGHT
- 03615.07 SPARE
- 03615.08 SPARE
- 03615.09
- 03615.10

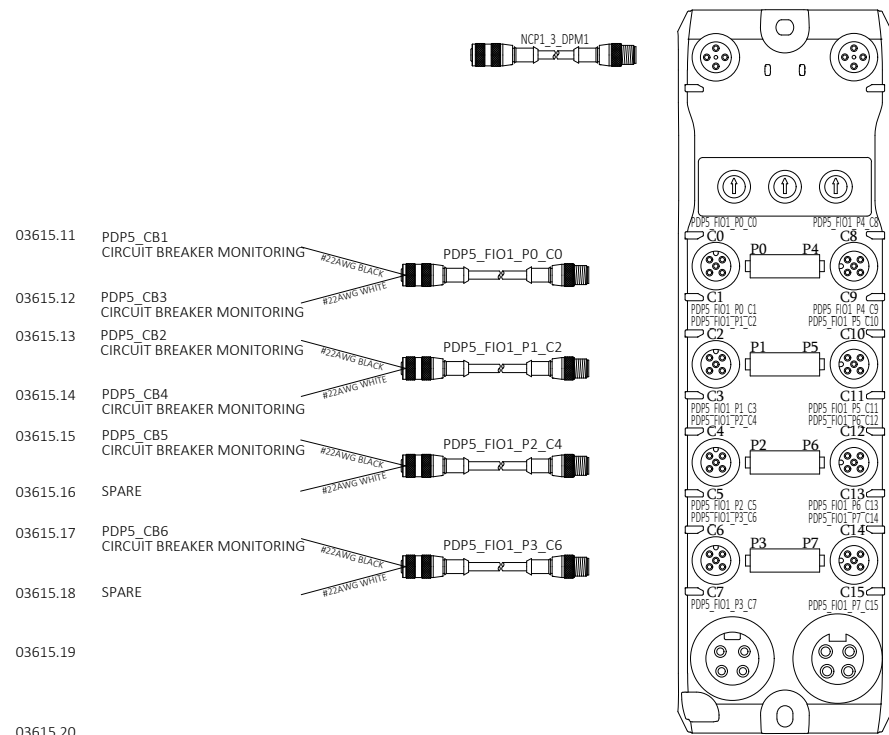


- 03615.11 PDP5_CB1 CIRCUIT BREAKER MONITORING
- 03615.12 PDP5_CB3 CIRCUIT BREAKER MONITORING
- 03615.13 PDP5_CB2 CIRCUIT BREAKER MONITORING
- 03615.14 PDP5_CB4 CIRCUIT BREAKER MONITORING
- 03615.15 PDP5_CB5 CIRCUIT BREAKER MONITORING
- 03615.16 SPARE
- 03615.17 PDP5_CB6 CIRCUIT BREAKER MONITORING
- 03615.18 SPARE
- 03615.19
- 03615.20

- SPARE 03615.21 PDP5_CB11 CIRCUIT BREAKER MONITORING
- SPARE 03615.22 PDP5_CB13 CIRCUIT BREAKER MONITORING
- SPARE 03615.23 PDP5_CB12 CIRCUIT BREAKER MONITORING
- SPARE 03615.24 PDP5_CB14 CIRCUIT BREAKER MONITORING
- SPARE 03615.25 PDP5_CB15 CIRCUIT BREAKER MONITORING
- SPARE 03615.26 PDP5_CB17 CIRCUIT BREAKER MONITORING
- 03615.27 PDP5_CB16 CIRCUIT BREAKER MONITORING
- 03615.28 PDP5_CB18 CIRCUIT BREAKER MONITORING

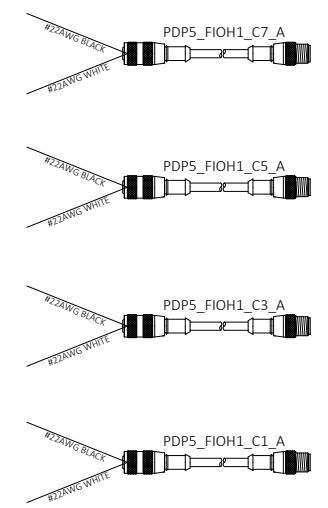

- 03615.29
- 03615.30
- 03615.31 PDP5_CB7 CIRCUIT BREAKER MONITORING
- 03615.32 PDP5_CB9 CIRCUIT BREAKER MONITORING
- 03615.33 PDP5_CB8 CIRCUIT BREAKER MONITORING
- 03615.34 PDP5_CB10 CIRCUIT BREAKER MONITORING
- 03615.35 PDP5_PWM1 PHASE MONITOR
- 03615.36 SPARE
- 03615.37 PDP5_FIOH1 FIO HUB
- 03615.38
- 03615.39

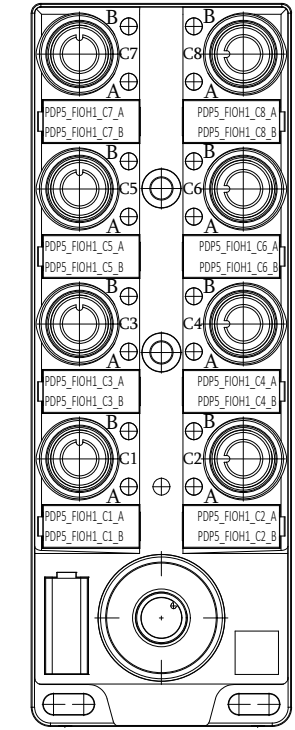

- PDP5_FIOH1_C8_A CIRCUIT BREAKER MONITORING
- PDP5_FIOH1_C7_A CIRCUIT BREAKER MONITORING
- PDP5_FIOH1_C6_A CIRCUIT BREAKER MONITORING
- PDP5_FIOH1_C5_A CIRCUIT BREAKER MONITORING
- PDP5_FIOH1_C4_A CIRCUIT BREAKER MONITORING
- PDP5_FIOH1_C3_A CIRCUIT BREAKER MONITORING
- PDP5_FIOH1_C2_A CIRCUIT BREAKER MONITORING
- PDP5_FIOH1_C1_A CIRCUIT BREAKER MONITORING

DRAWING REVISIONS			
REV	DESCRIPTION	DATE	BY
00	INITIAL DRAWINGS	05/19/2025	SK
01	ALARM HORN	06/19/2025	SN
A	AS-BUILT	11/13/2025	LB

CONFIDENTIAL: THE INFORMATION CONTAINED HEREIN IS PROPRIETARY INFORMATION OF AUTOMATION STANDARD LLC AND CONSTITUTES TRADE SECRETS PURSUANT TO THE UNIFORM TRADE SECRETS ACT. THIS INFORMATION SHALL ONLY BE USED IN THE PERFORMANCE OF CONTRACT WITH AUTOSTAND. THIS INFORMATION SHALL NOT BE USED, REPRODUCED OR EMPLOYED IN WHOLE PART, EXCEPT WITH AUTOSTAND'S PRIOR WRITTEN APPROVAL.

25K Amazon Cross-Belt Sort Center (ACBSC)
 FIELD IO DEVICES
 NCP1_8_FIO1/PDP5_FIO1/PDP5_FIOH1
 AMAZON MTN6
 SPARROWS POINT, MD

FILENAME	
2429-AMZ-MTN6-MCM03-615	
D-SIZE SCALE	JOB NUMBER
NTS	2429
REVISION	SHEET
A	61