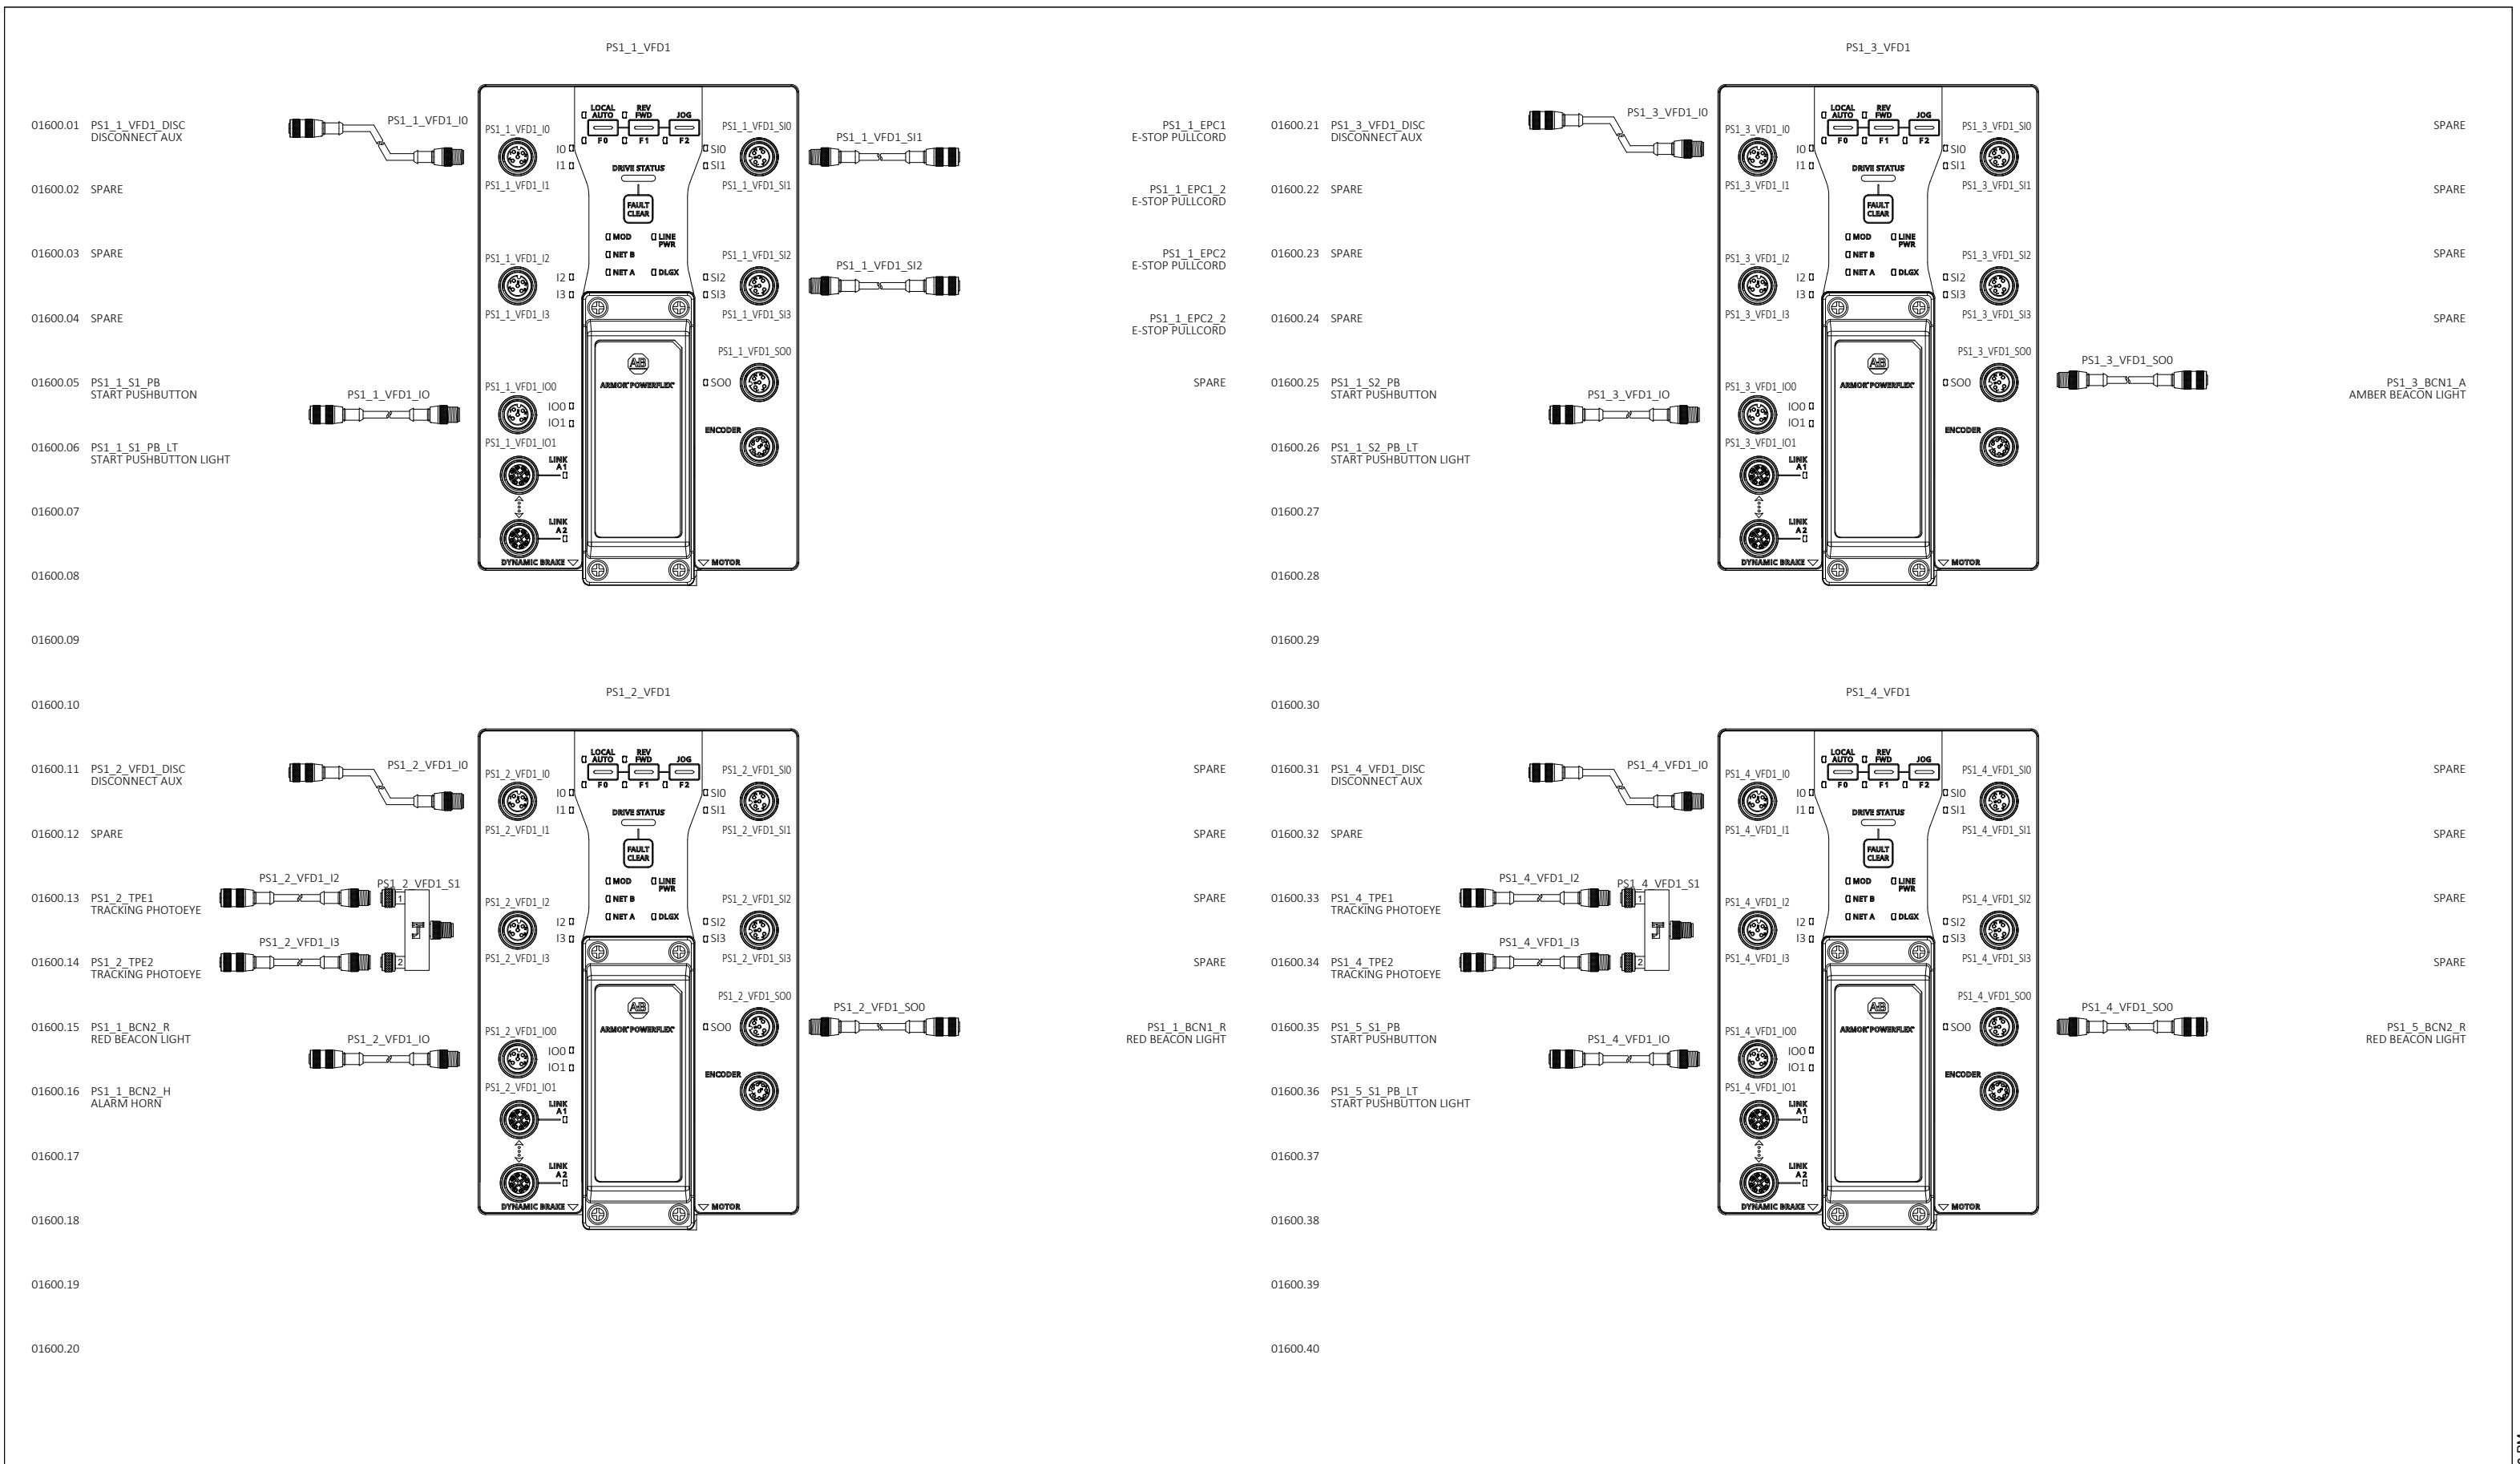
 




DRAWING REVISIONS			
REV	DESCRIPTION	DATE	BY
00	INITIAL DRAWINGS	05/09/2025	SK
01	ALARM HORNS	06/18/2025	SN
A	AS-BUILT	11/13/2025	LB




CONFIDENTIAL: THE INFORMATION CONTAINED HEREIN IS PROPRIETARY INFORMATION OF AUTOMATION STANDARD LLC AND CONSTITUTES TRADE SECRETS PURSUANT TO THE UNIFORM TRADE SECRETS ACT. THIS INFORMATION SHALL ONLY BE USED IN THE PERFORMANCE OF CONTRACT WITH AUTOSTAND. THIS INFORMATION SHALL NOT BE USED, REPRODUCED OR EMPLOYED IN WHOLE PART, EXCEPT WITH AUTOSTAND'S PRIOR WRITTEN APPROVAL.

25K Amazon Cross-Belt Sort Center (ACBSC)
PS1_01_VFD1/PS1_02_VFD1/
PS1_03_VFD1/PS1_04_VFD1 IO DRAWINGS

AMAZON MTN6
SPARROWS POINT, MD

FILENAME	
2429-AMZ-MTN6-MCM01-600	
D-SIZE SCALE	JOB NUMBER:
NTS	2429
REVISION	SHEET
A	60

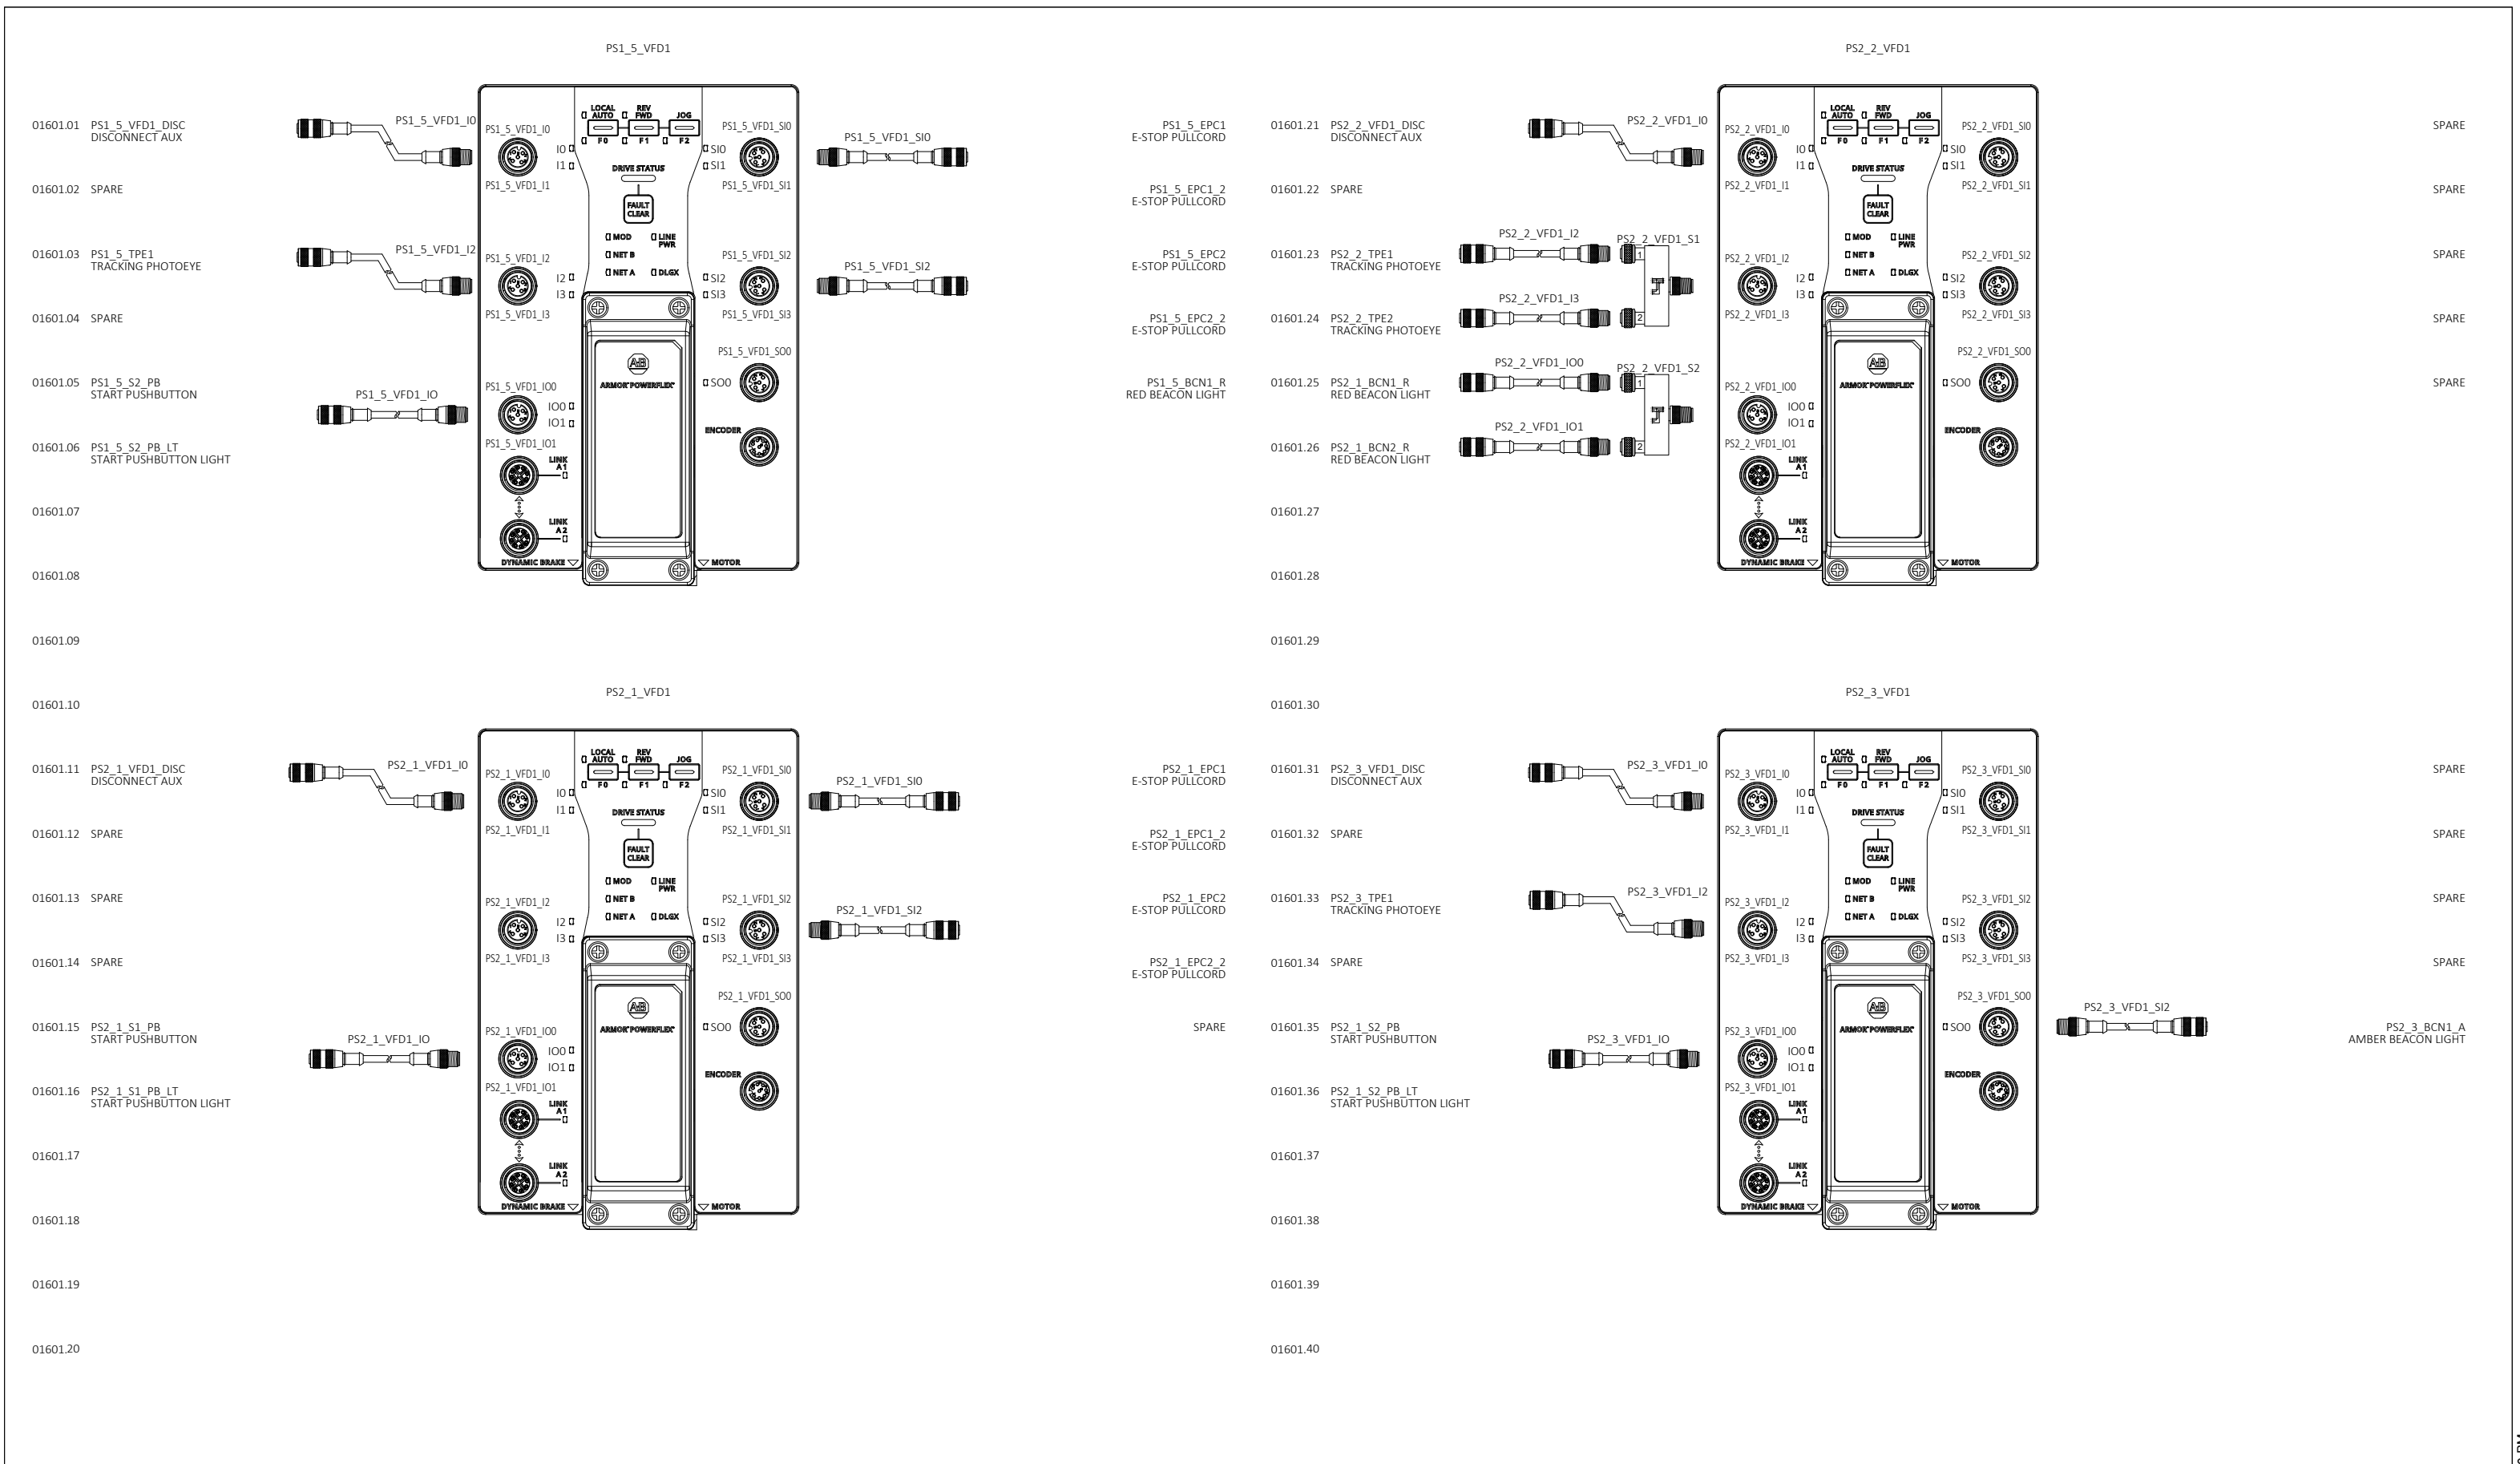

DRAWING REVISIONS			
REV	DESCRIPTION	DATE	BY
00	INITIAL DRAWINGS	05/09/2025	SK
01	ALARM HORNS	06/18/2025	SN
A	AS-BUILT	11/13/2025	LB




CONFIDENTIAL: THE INFORMATION CONTAINED HEREIN IS PROPRIETARY INFORMATION OF AUTOMATION STANDARD LLC AND CONSTITUTES TRADE SECRETS PURSUANT TO THE UNIFORM TRADE SECRETS ACT. THIS INFORMATION SHALL ONLY BE USED IN THE PERFORMANCE OF CONTRACT WITH AUTOSTAND. THIS INFORMATION SHALL NOT BE USED, REPRODUCED OR EMPLOYED IN WHOLE PART, EXCEPT WITH AUTOSTAND'S PRIOR WRITTEN APPROVAL.


25K Amazon Cross-Belt Sort Center (ACBSC)
PS1_05_VFD1/PS2_01_VFD1/
PS2_02_VFD1/PS2_03_VFD1 IO DRAWINGS













AMAZON MTN6
SPARROWS POINT, MD

FILENAME	
2429-AMZ-MTN6-MCM01-601	
D-SIZE SCALE	JOB NUMBER:
NTS	2429
REVISION	SHEET
A	61

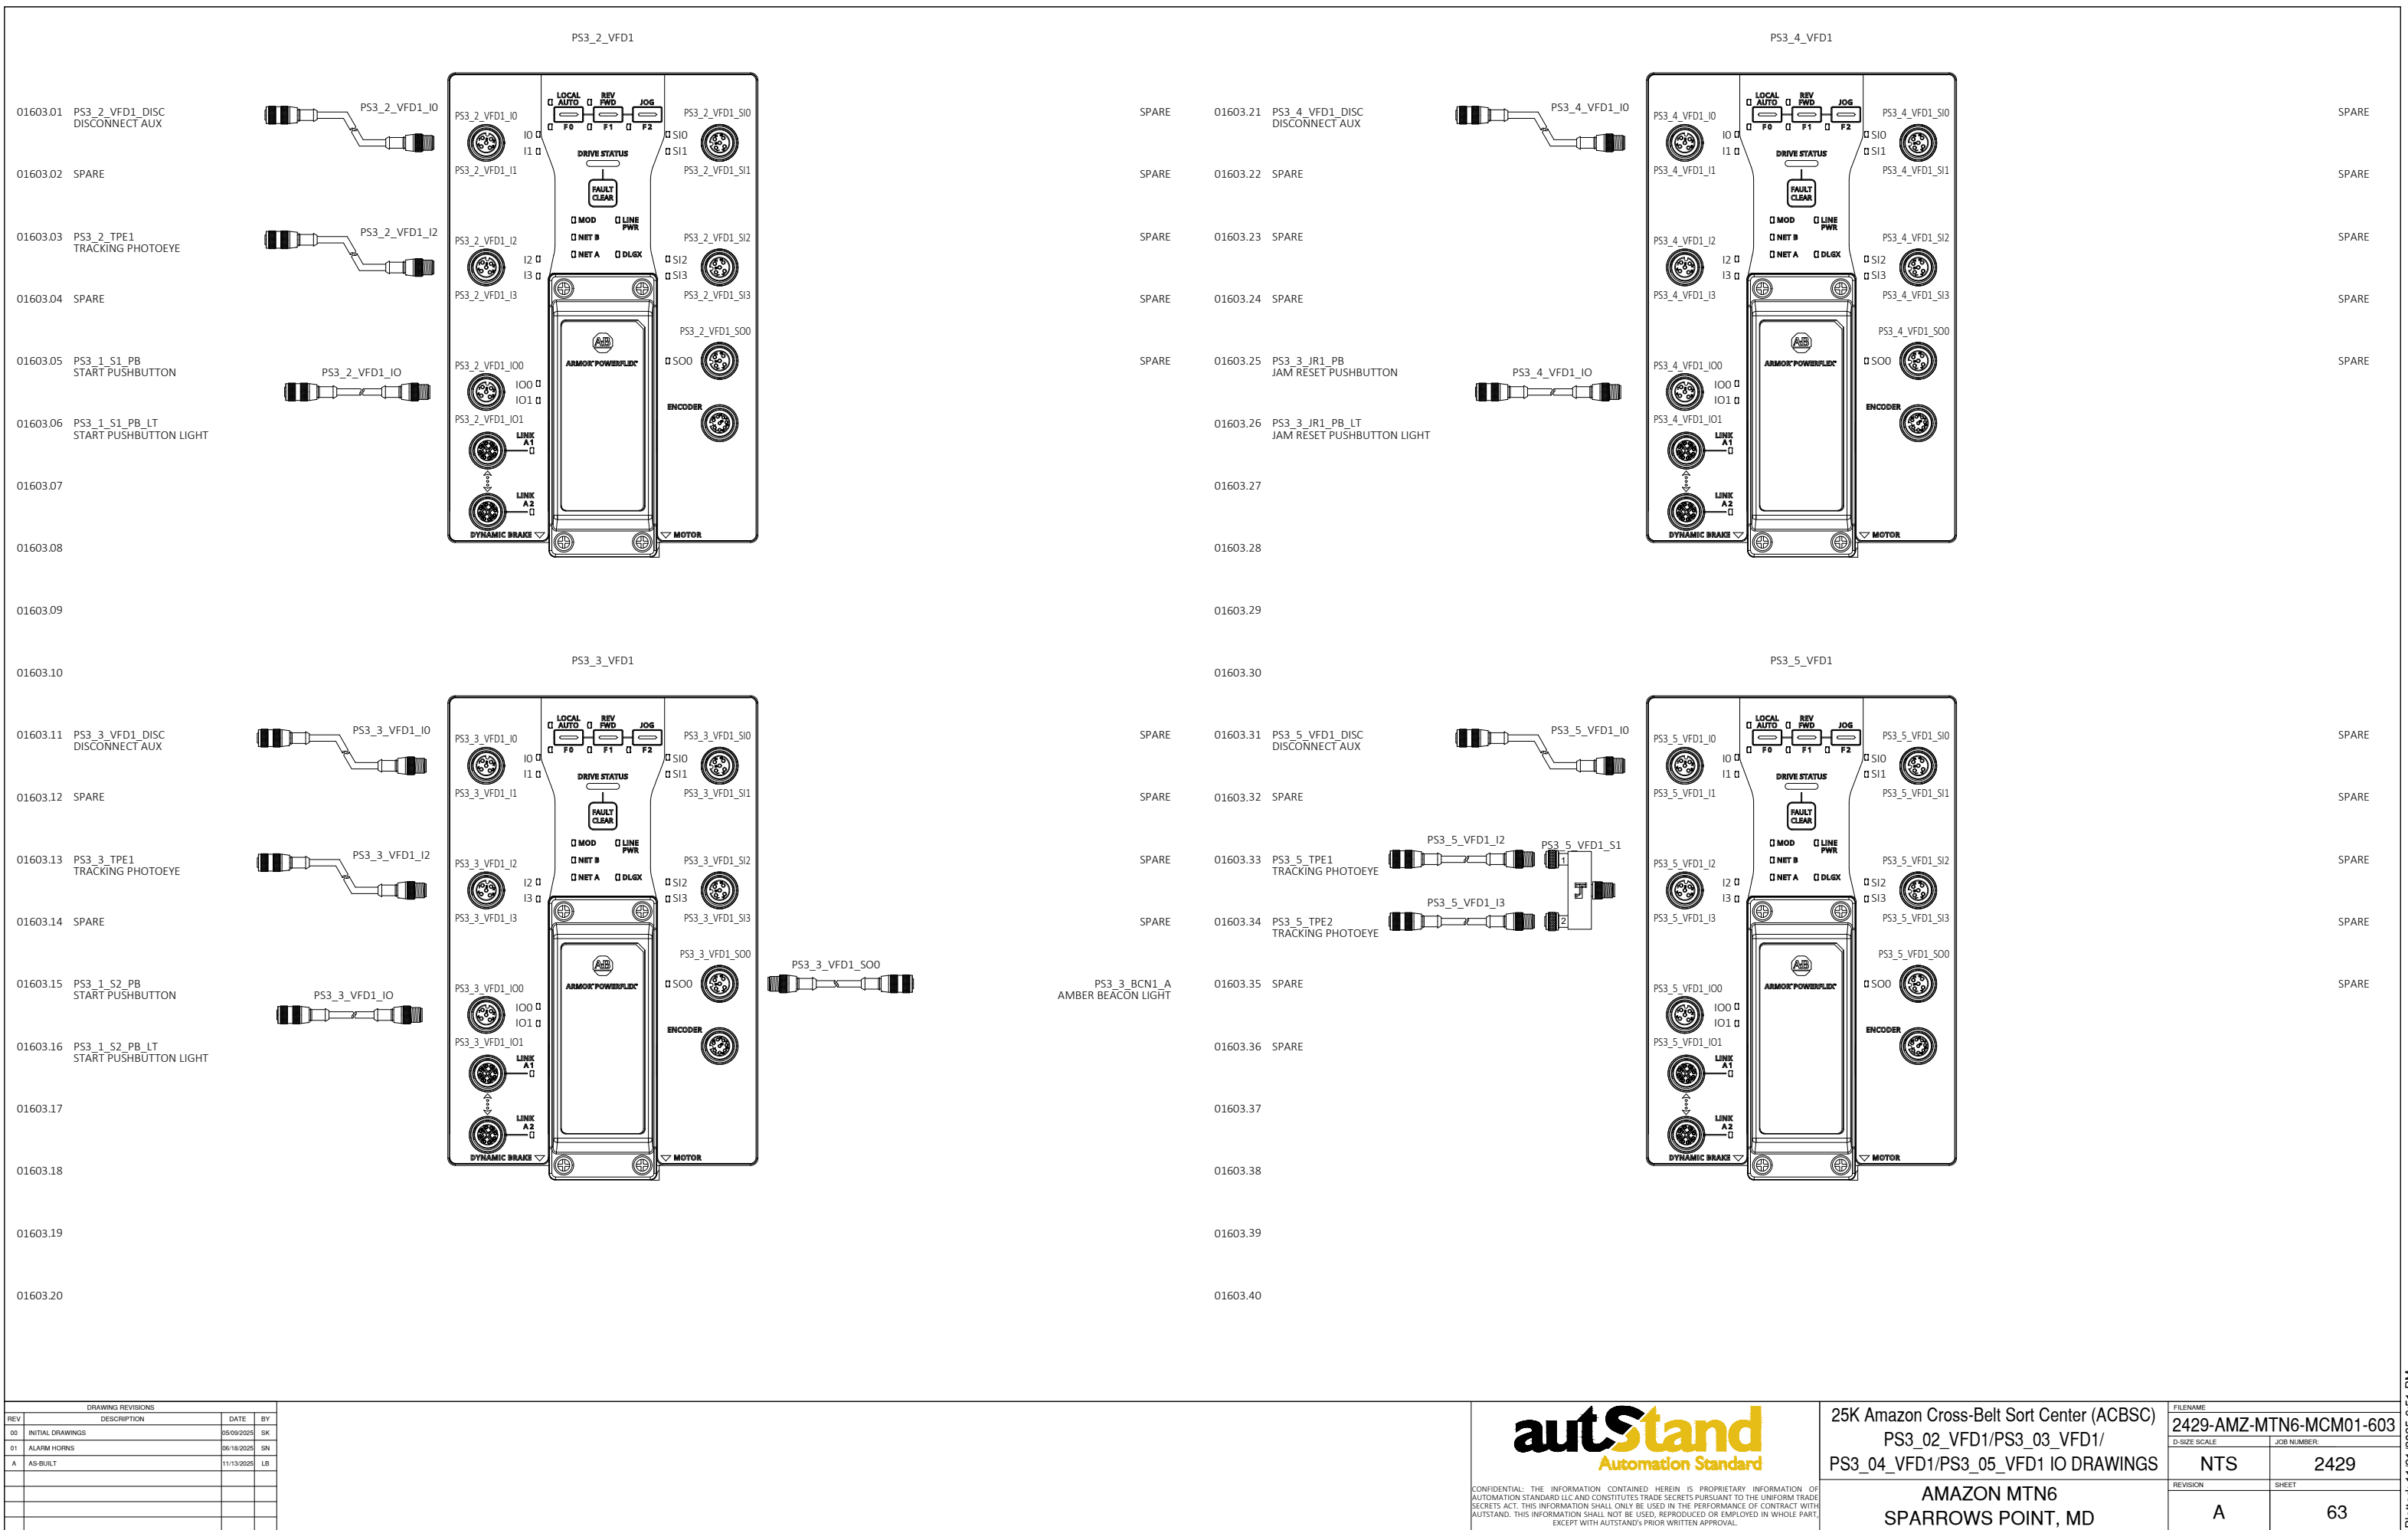


DRAWING REVISIONS				DATE				BY				FILENAME			
REV				DESCRIPTION								2429-AMZ-MTN6-MCM01-604			
00				INITIAL DRAWINGS				05/09/2025				SK			
01				ALARM HORNS				06/18/2025				SN			
A				AS-BUILT				11/13/2025				LB			


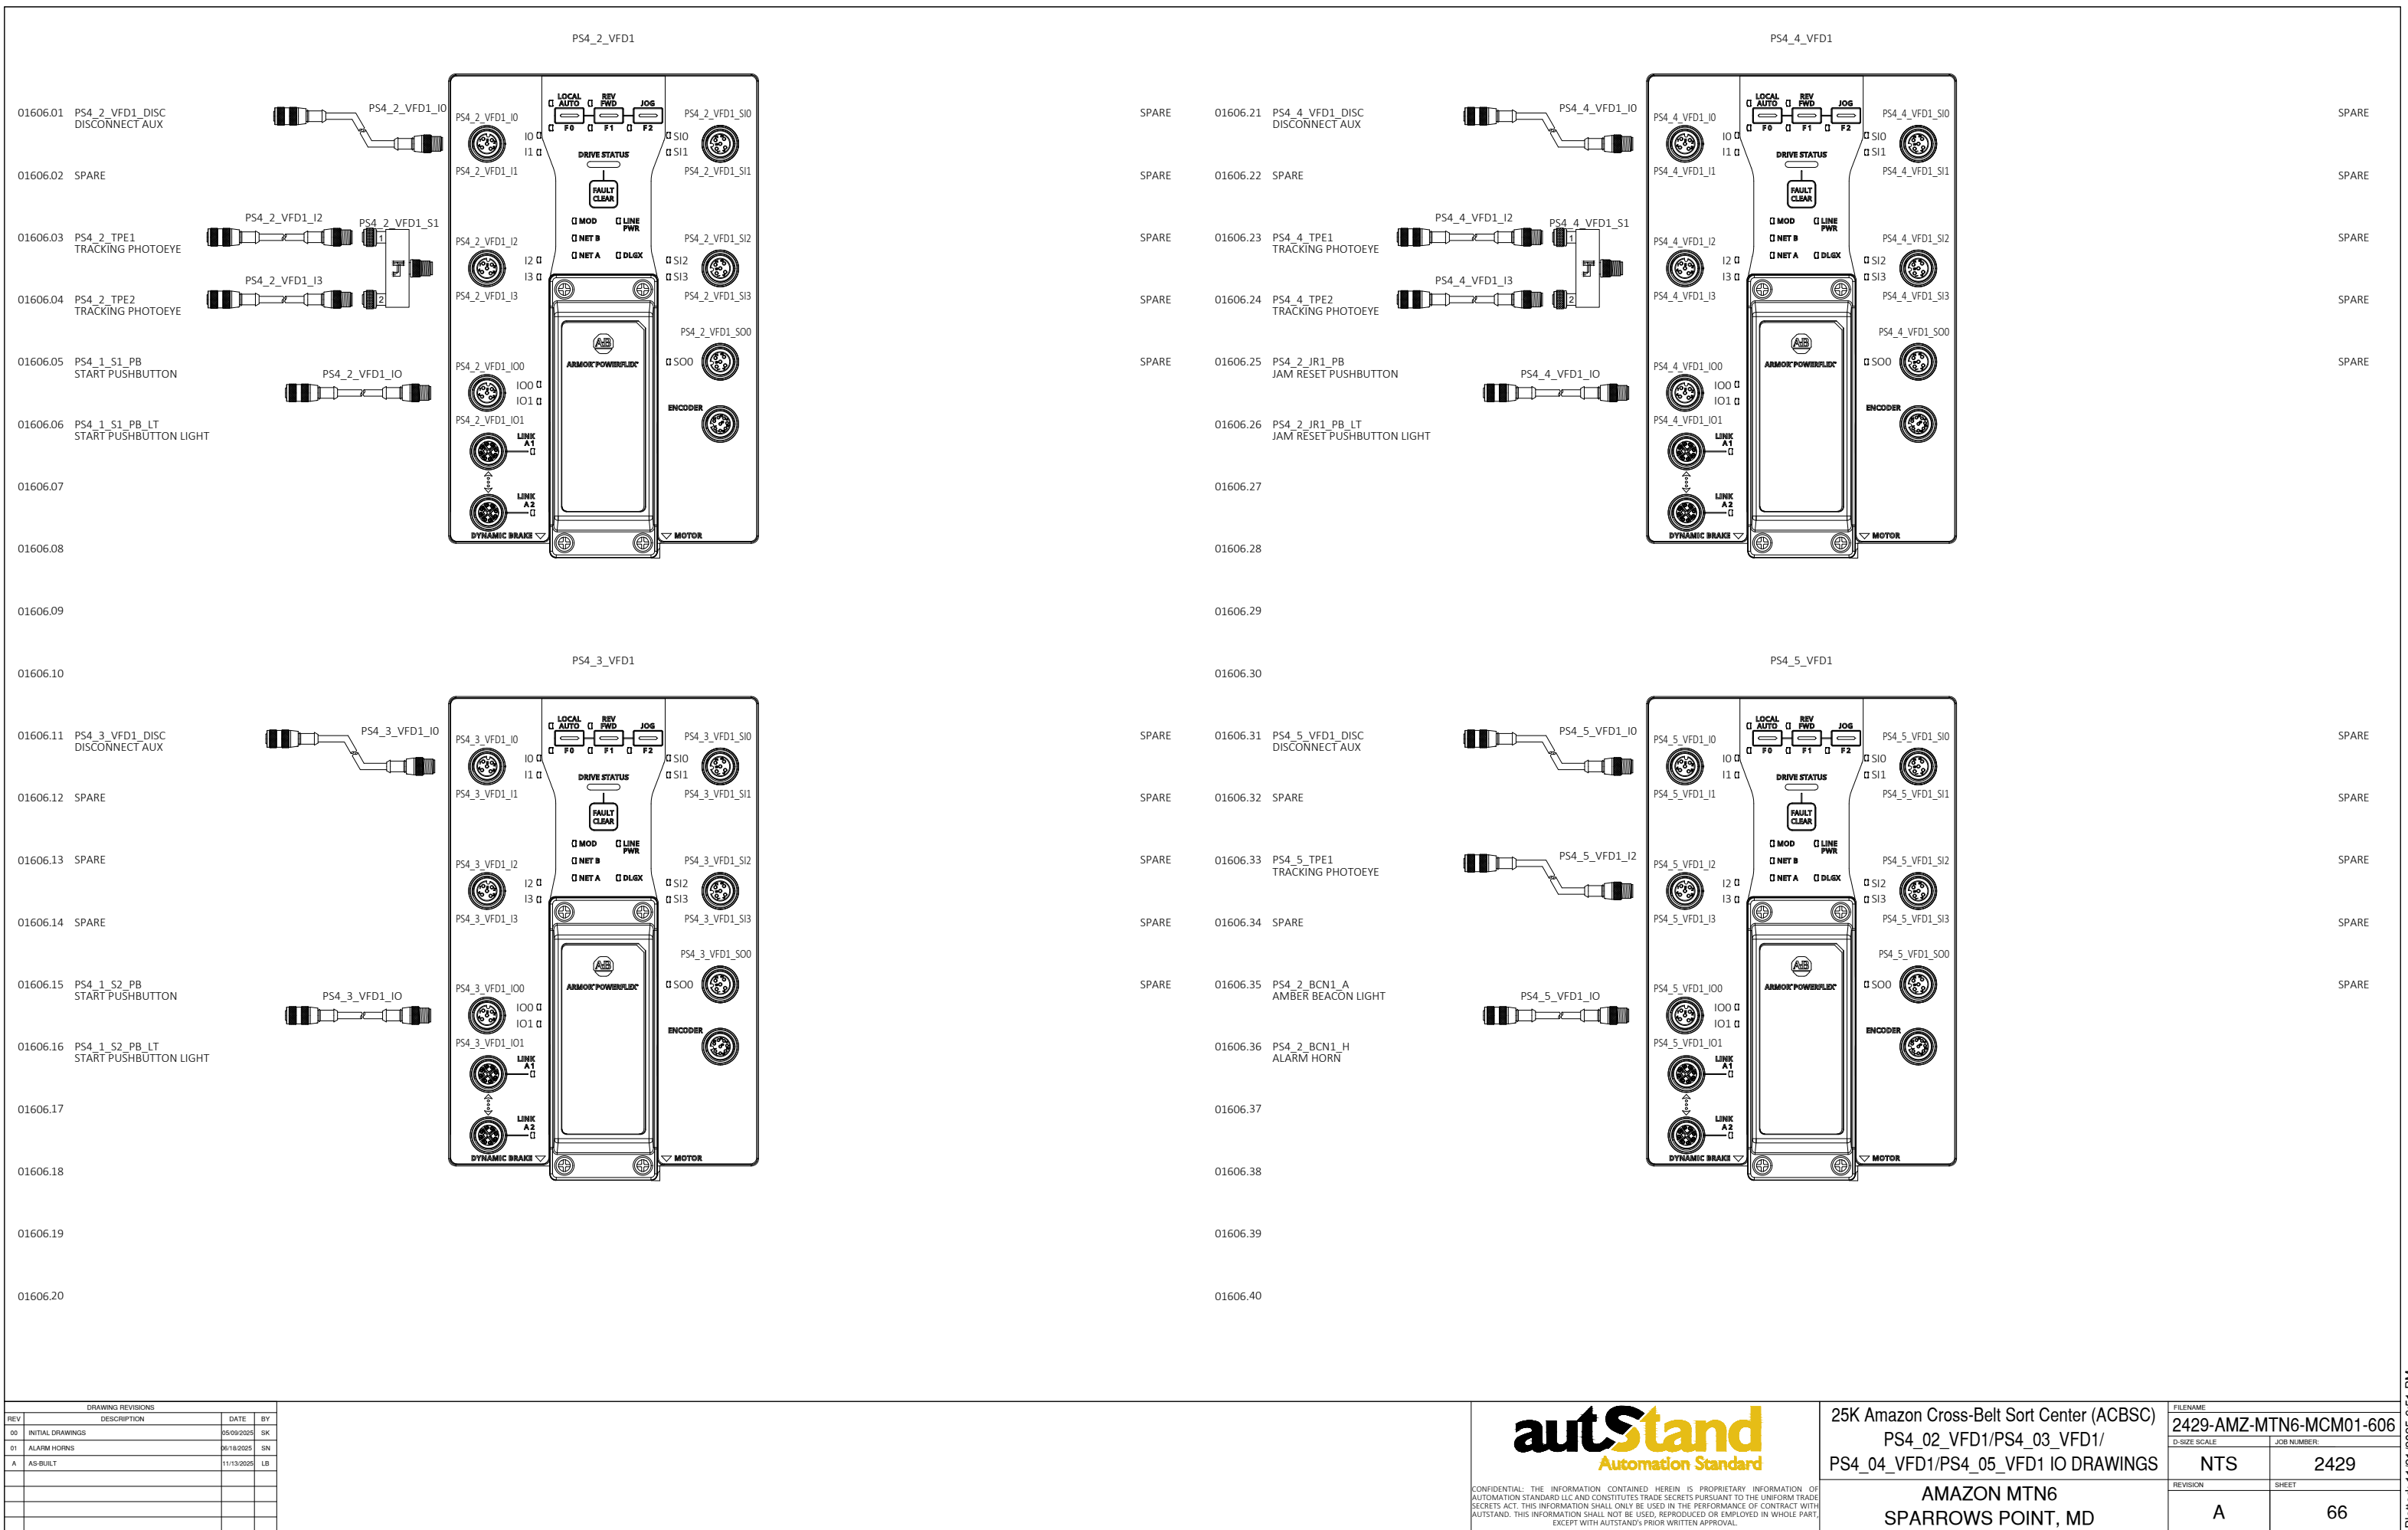


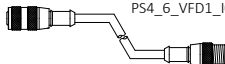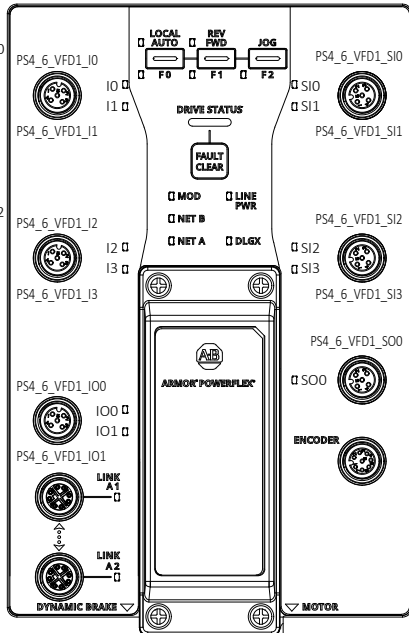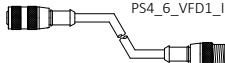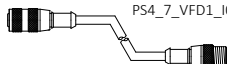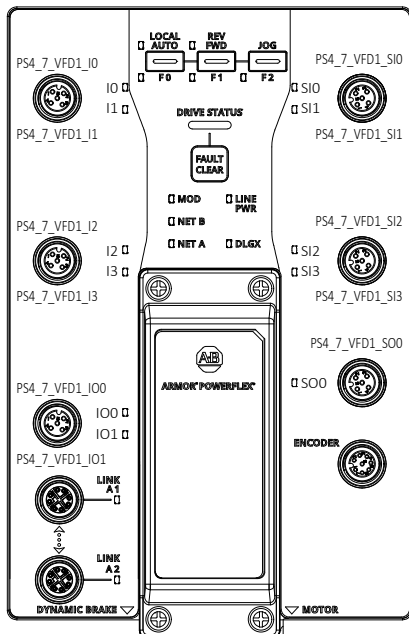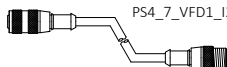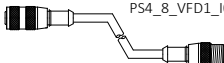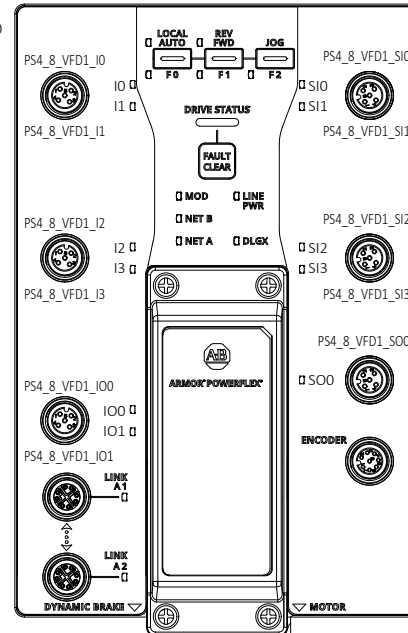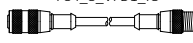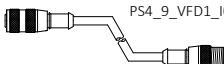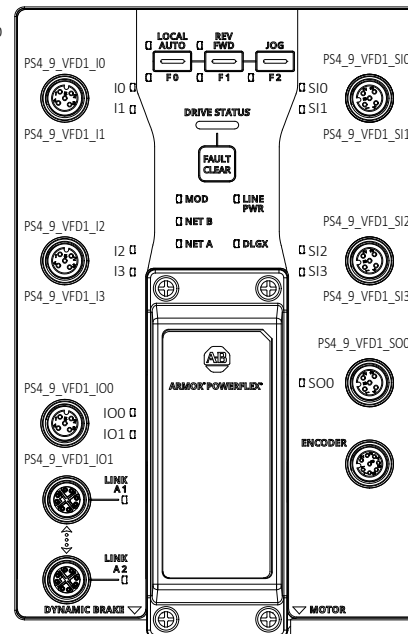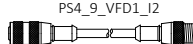01607.01		PS4_6_VFD1_DISC DISCONNECT AUX																		
01607.02		SPARE																		
01607.03		PS4_6_TPE1 TRACKING PHOTOEYE																		
01607.04		SPARE																		
01607.05		SPARE																		
01607.06		SPARE																		
01607.07																				
01607.08																				
01607.09																				
01607.10																				
01607.11		PS4_7_VFD1_DISC DISCONNECT AUX																		
01607.12		SPARE																		
01607.13		PS4_7_TPE1 TRACKING PHOTOEYE																		
01607.14		SPARE																		
01607.15		SPARE																		
01607.16		SPARE																		
01607.17																				
01607.18																				
01607.19																				
01607.20																				
01607.21		PS4_8_VFD1_DISC DISCONNECT AUX																		
01607.22		SPARE																		
01607.23		SPARE																		
01607.24		SPARE																		
01607.25		PS4_8_JR1_PB JAM RESET PUSHBUTTON																		
01607.26		PS4_8_JR1_PB_LT JAM RESET PUSHBUTTON LIGHT																		
01607.27																				
01607.28																				
01607.29																				
01607.30																				
01607.31		PS4_9_VFD1_DISC DISCONNECT AUX																		
01607.32		SPARE																		
01607.33		PS4_10_TPE1 TRACKING PHOTOEYE																		
01607.34		PS4_8_TPE1 TRACKING PHOTOEYE																		
01607.35		SPARE																		
01607.36		SPARE																		
01607.37																				
01607.38																				
01607.39																				
01607.40																				


DRAWING REVISIONS				DATE				BY			
00 INITIAL DRAWINGS				05/09/2025				SK			
01 ALARM HORNS				06/18/2025				SN			
A AS-BUILT				11/13/2025				LB			


				UL1_9_VFD1								UL1_10B_VFD1							
01611.01	UL1_9_VFD1_DISC DISCONNECT AUX		UL1_9_VFD1_I0		UL1_9_VFD1_S1													SPARE	
01611.02	UL1_9_ENC1 ENCODER		UL1_9_VFD1_I1		UL1_9_VFD1_S1													SPARE	
01611.03	UL1_9_TPE1 TRACKING PHOTOEYE		UL1_9_VFD1_I2		UL1_9_VFD1_S1													SPARE	
01611.04	UL1_9_TPE2 TRACKING PHOTOEYE		UL1_9_VFD1_I3		UL1_9_VFD1_S1													SPARE	
01611.05	UL1_9_BCN1_A AMBER BEACON LIGHT		UL1_9_VFD1_I0		UL1_9_VFD1_S00													SPARE	
01611.06	UL1_9_BCN1_R RED BEACON LIGHT																		
01611.07																			
01611.08																			
01611.09																			
01611.10																			
				UL1_10A_VFD1								UL1_11_VFD1							
01611.11	UL1_10A_VFD1_DISC DISCONNECT AUX		UL1_10A_VFD1_I0		UL1_10A_VFD1_S1													SPARE	
01611.12	UL1_9_TPE3 TRACKING PHOTOEYE		UL1_10A_VFD1_I1		UL1_10A_VFD1_S1													SPARE	
01611.13	UL1_9_TPE4 TRACKING PHOTOEYE		UL1_10A_VFD1_I2		UL1_10A_VFD1_S1													SPARE	
01611.14	UL1_9_TPE5 TRACKING PHOTOEYE		UL1_10A_VFD1_I3		UL1_10A_VFD1_S1													SPARE	
01611.15	UL1_9_S2_PB START PUSHBUTTON		UL1_10A_VFD1_I0		UL1_10A_VFD1_S00													SPARE	
01611.16	UL1_9_S2_PB_LT START PUSHBUTTON LIGHT																		
01611.17																			
01611.18																			
01611.19																			
01611.20																			
				UL1_10A_VFD1								UL1_11_VFD1							
01611.21	UL1_9_EPC1 E-STOP PULLCORD		UL1_11_VFD1_I0		UL1_11_VFD1_S1													SPARE	
01611.22	UL1_9_EPC1_2 E-STOP PULLCORD		UL1_11_VFD1_I1		UL1_11_VFD1_S1													SPARE	
01611.23	UL1_9_EPC2 E-STOP PULLCORD		UL1_11_VFD1_I2		UL1_11_VFD1_S1													SPARE	
01611.24	UL1_9_EPC2_2 E-STOP PULLCORD		UL1_11_VFD1_I3		UL1_11_VFD1_S1													SPARE	
01611.25	UL1_9_BCN2_R RED BEACON LIGHT																		
01611.26																			
01611.27																			
01611.28																			
01611.29																			
01611.30																			
01611.31	UL1_11_VFD1_DISC DISCONNECT AUX		UL1_11_VFD1_I0		UL1_11_VFD1_S1													SPARE	
01611.32	UL1_11_ENC1 ENCODER		UL1_11_VFD1_I1		UL1_11_VFD1_S1													SPARE	
01611.33	UL1_11_TPE1 TRACKING PHOTOEYE		UL1_11_VFD1_I2		UL1_11_VFD1_S1													SPARE	
01611.34	UL1_11_TPE2 TRACKING PHOTOEYE		UL1_11_VFD1_I3		UL1_11_VFD1_S1													SPARE	
01611.35																		SPARE	
01611.36																			
01611.37																			
01611.38																			
01611.39																			
01611.40																			

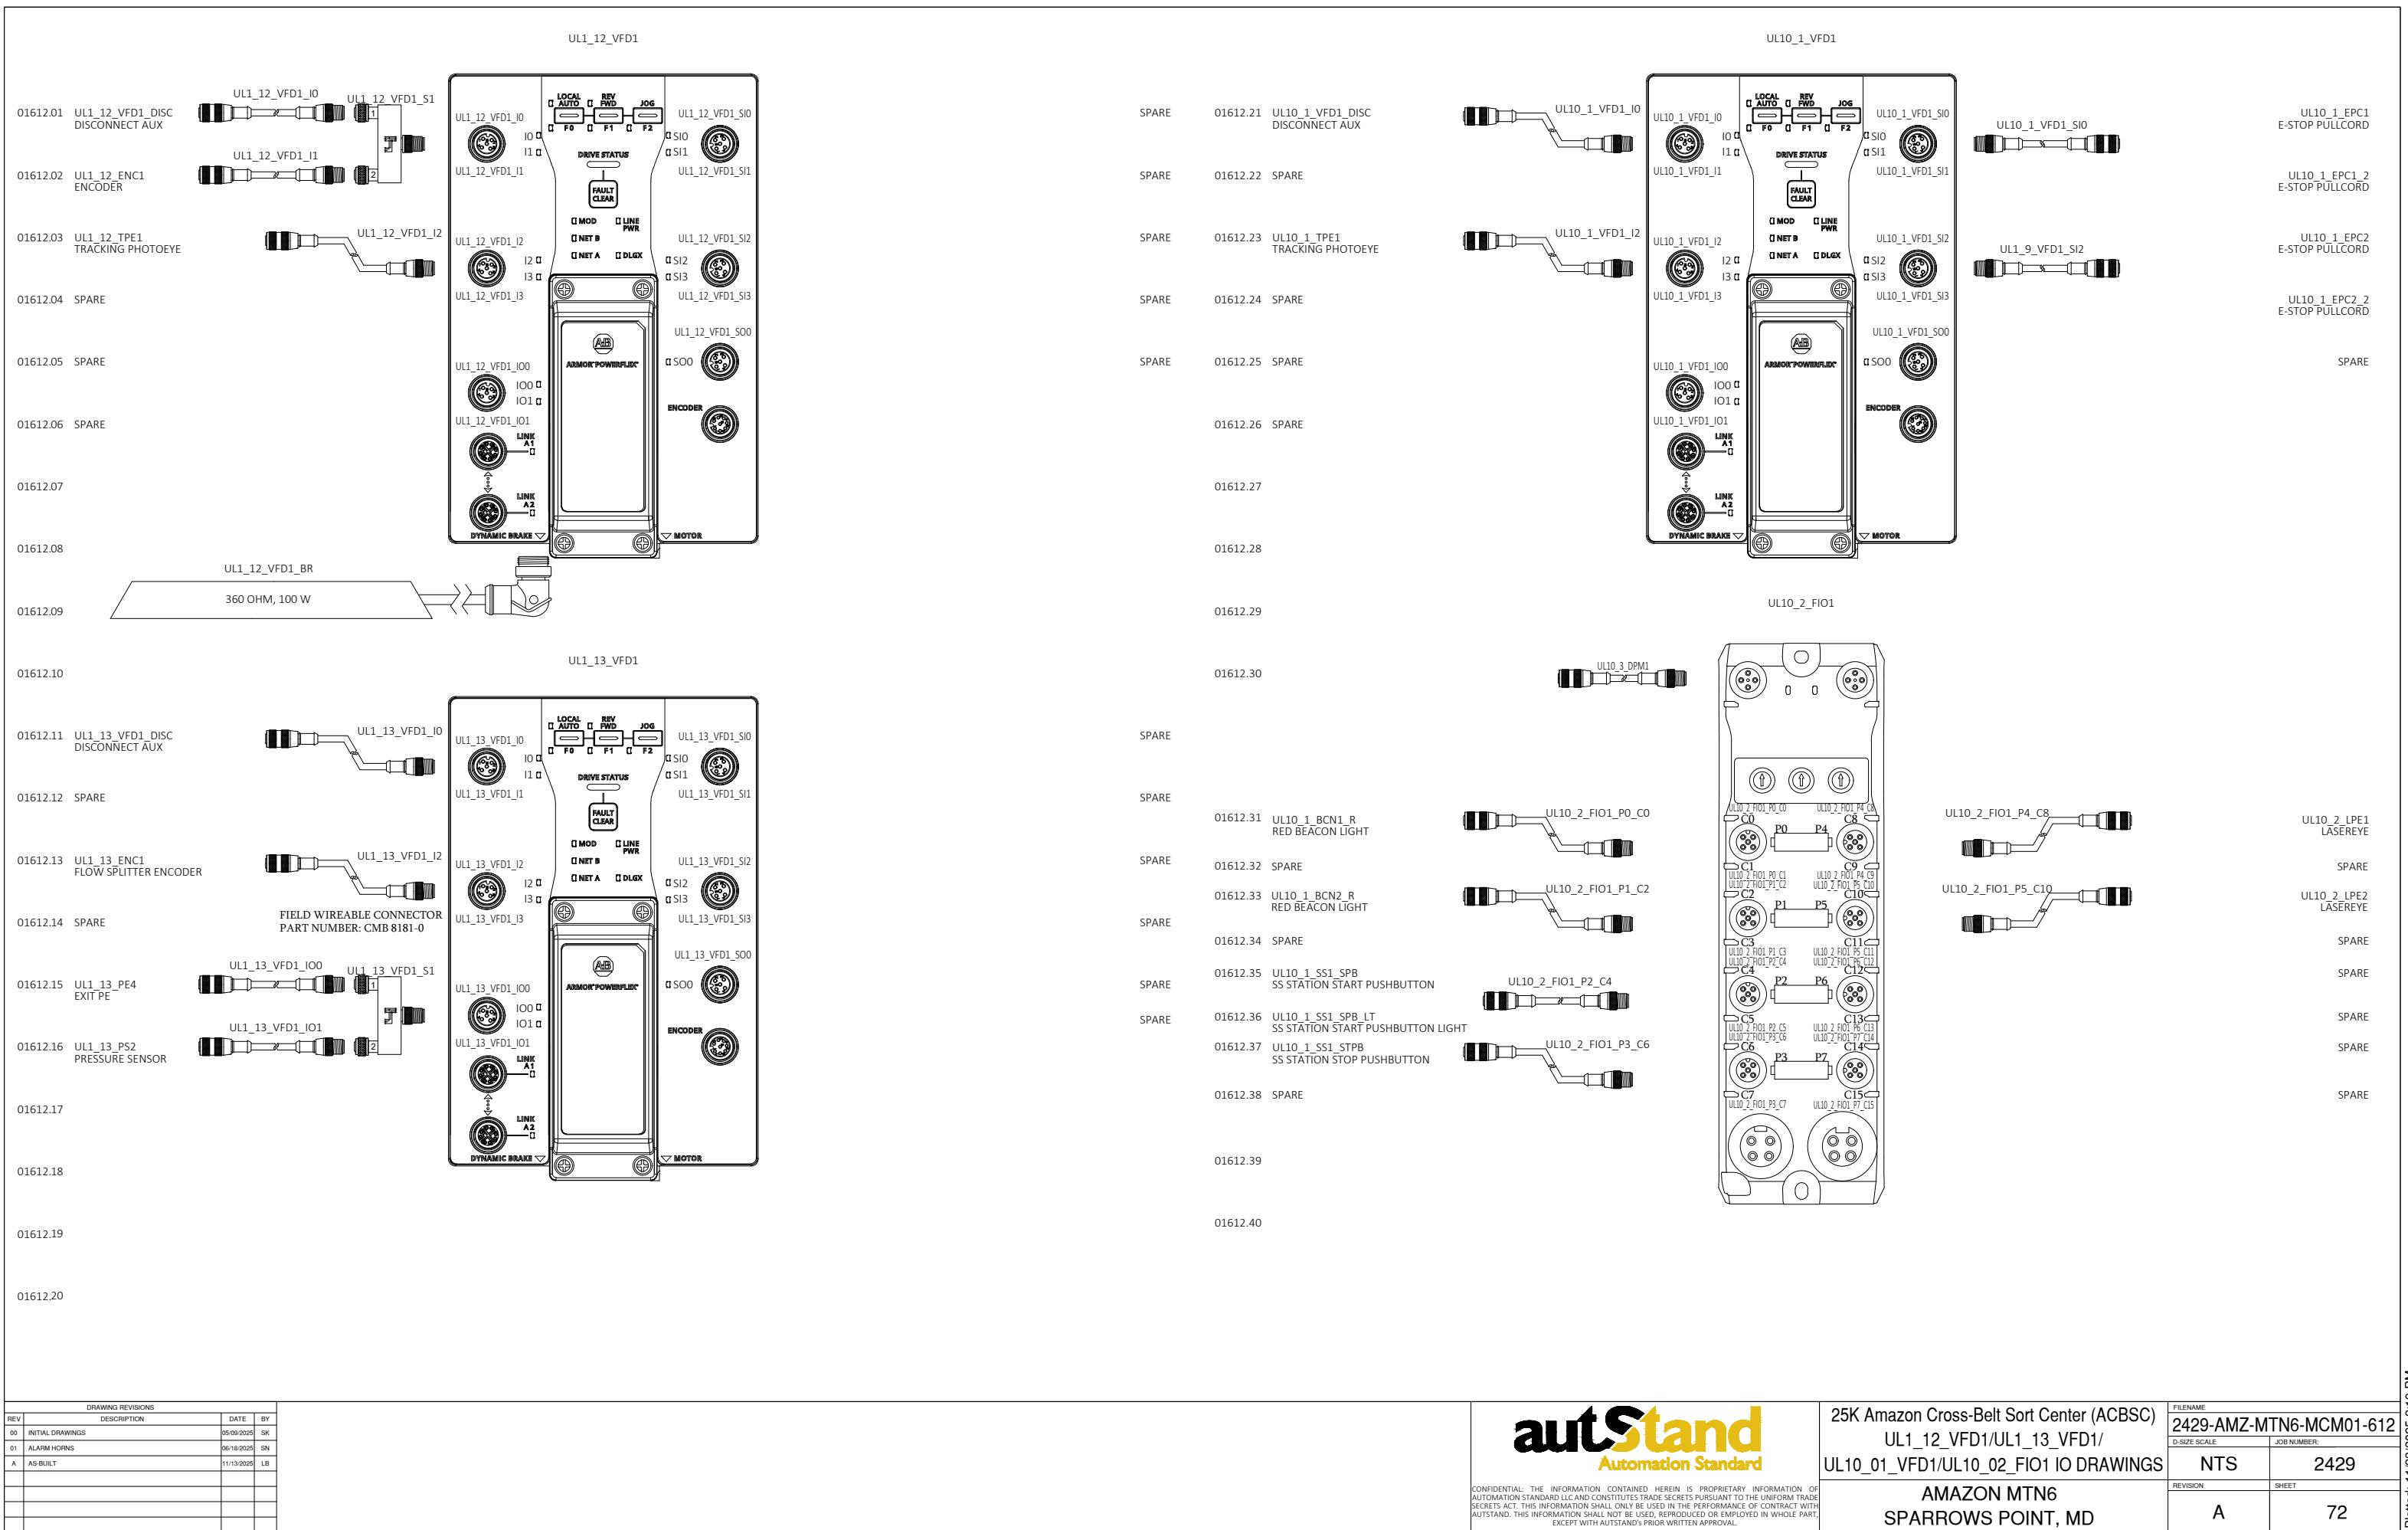

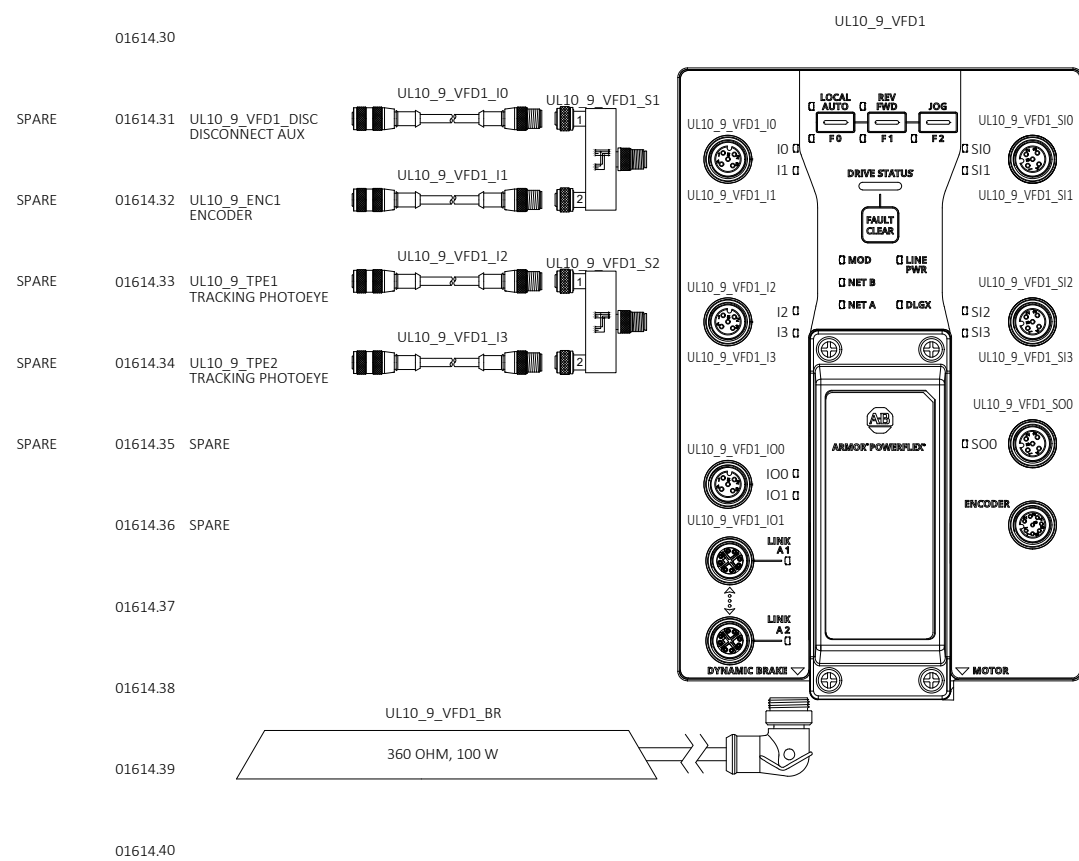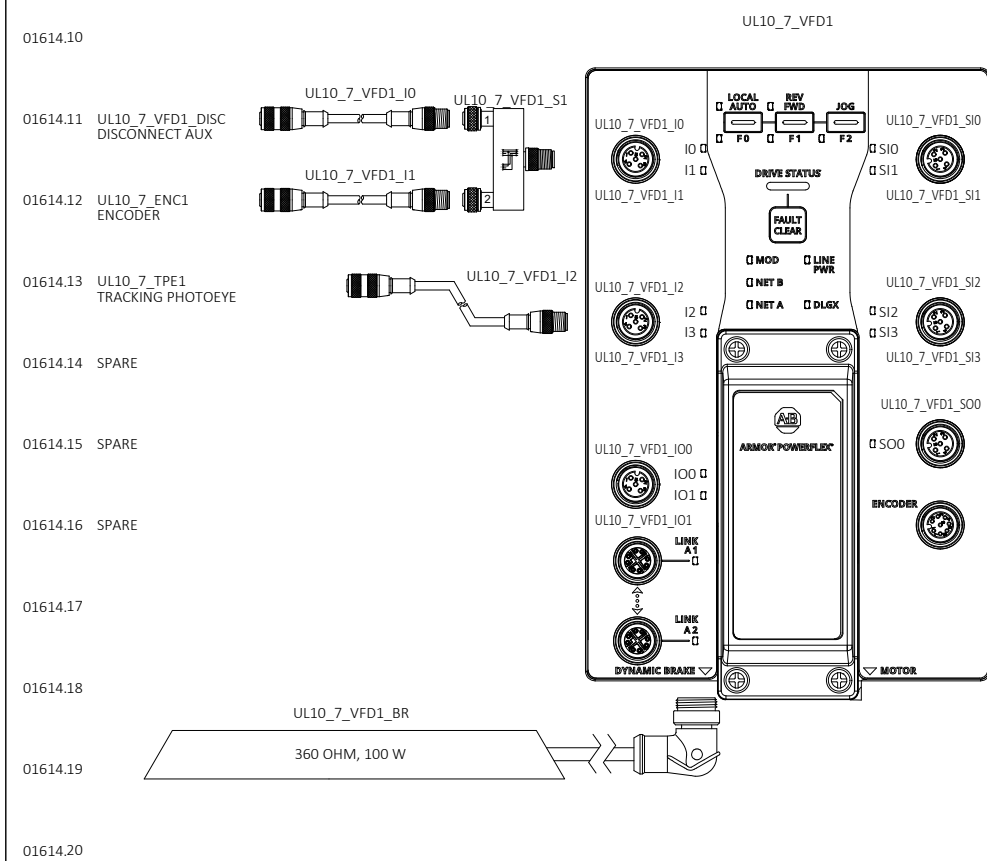

 CONFIDENTIAL: THE INFORMATION CONTAINED HEREIN IS PROPRIETARY INFORMATION OF AUTOMATION STANDARD LLC AND CONSTITUTES TRADE SECRETS PURSUANT TO THE UNIFORM TRADE SECRETS ACT. THIS INFORMATION SHALL ONLY BE USED IN THE PERFORMANCE OF CONTRACT WITH AUTOSTAND. THIS INFORMATION SHALL NOT BE USED, REPRODUCED OR EMPLOYED IN WHOLE PART, EXCEPT WITH AUTOSTAND'S PRIOR WRITTEN APPROVAL.	25K Amazon Cross-Belt Sort Center (ACBSC) UL10_06_VFD1/UL10_07_VFD1/ UL10_08_VFD1/UL10_09_VFD1 IO DRAWINGS		FILENAME 2429-AMZ-MTN6-MCM01-614	
			D-SIZE SCALE NTS	JOB NUMBER 2429
			REVISION A	SHEET 74
	AMAZON MTN6 SPARROWS POINT, MD			

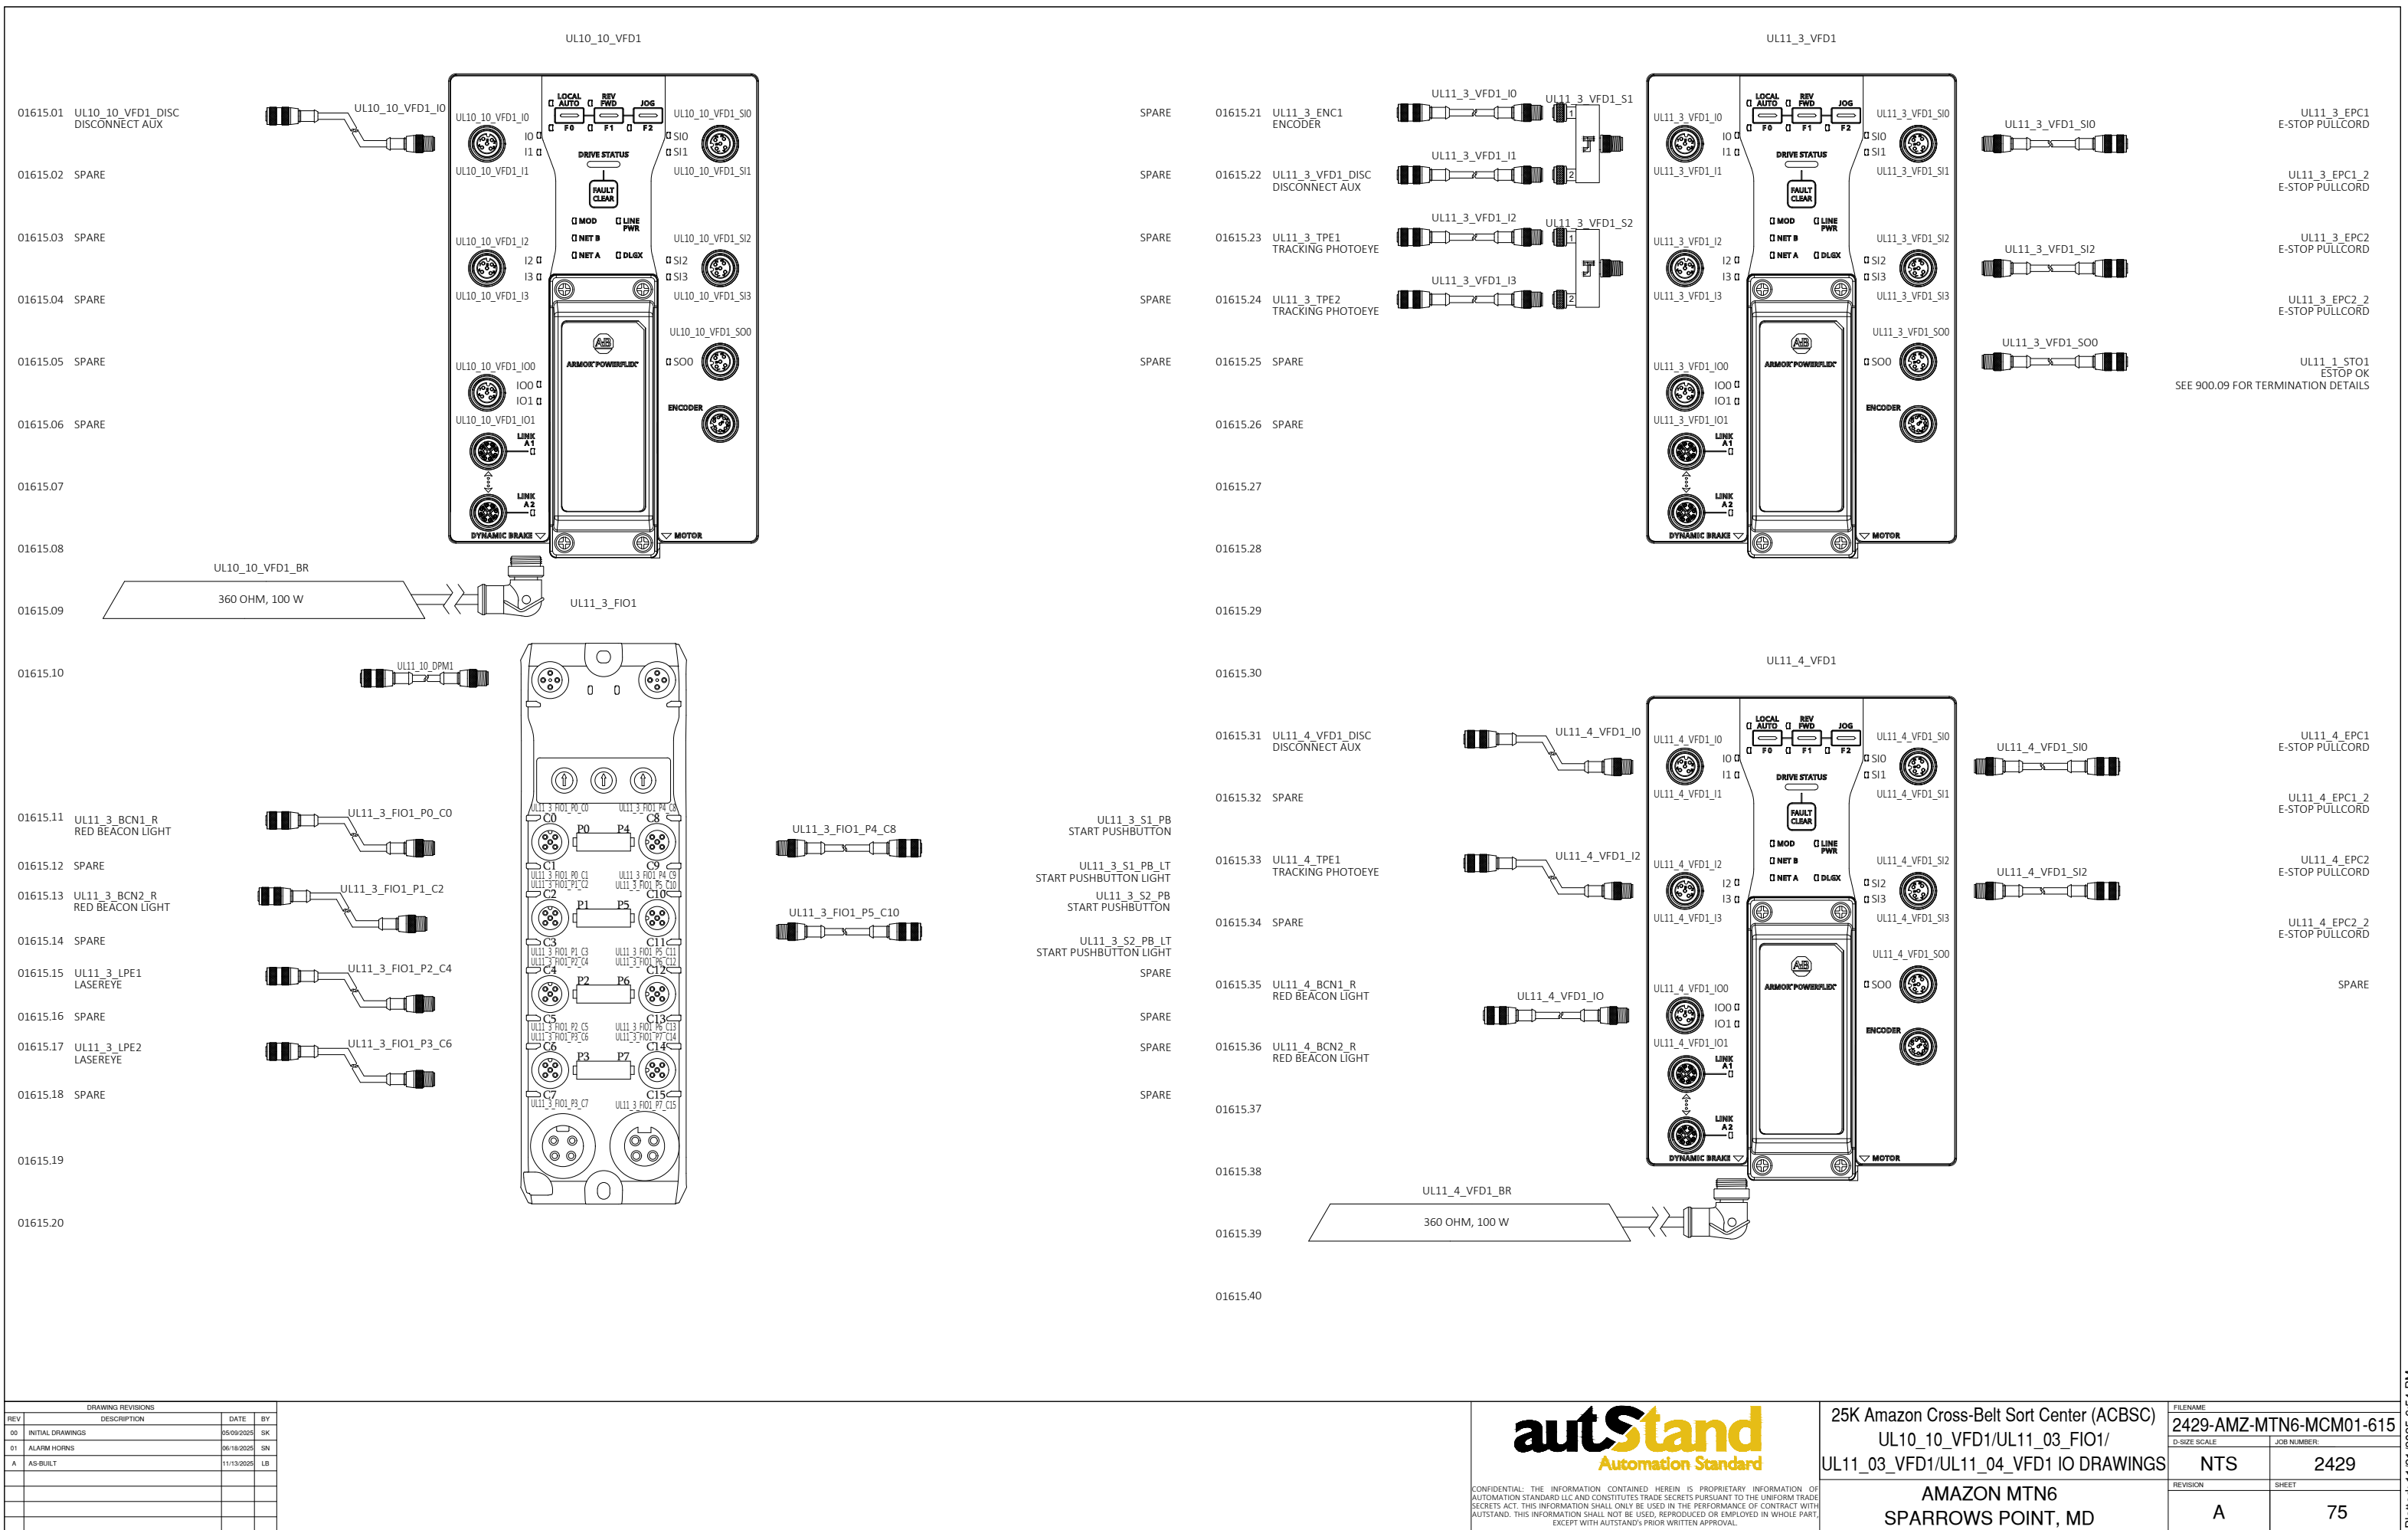

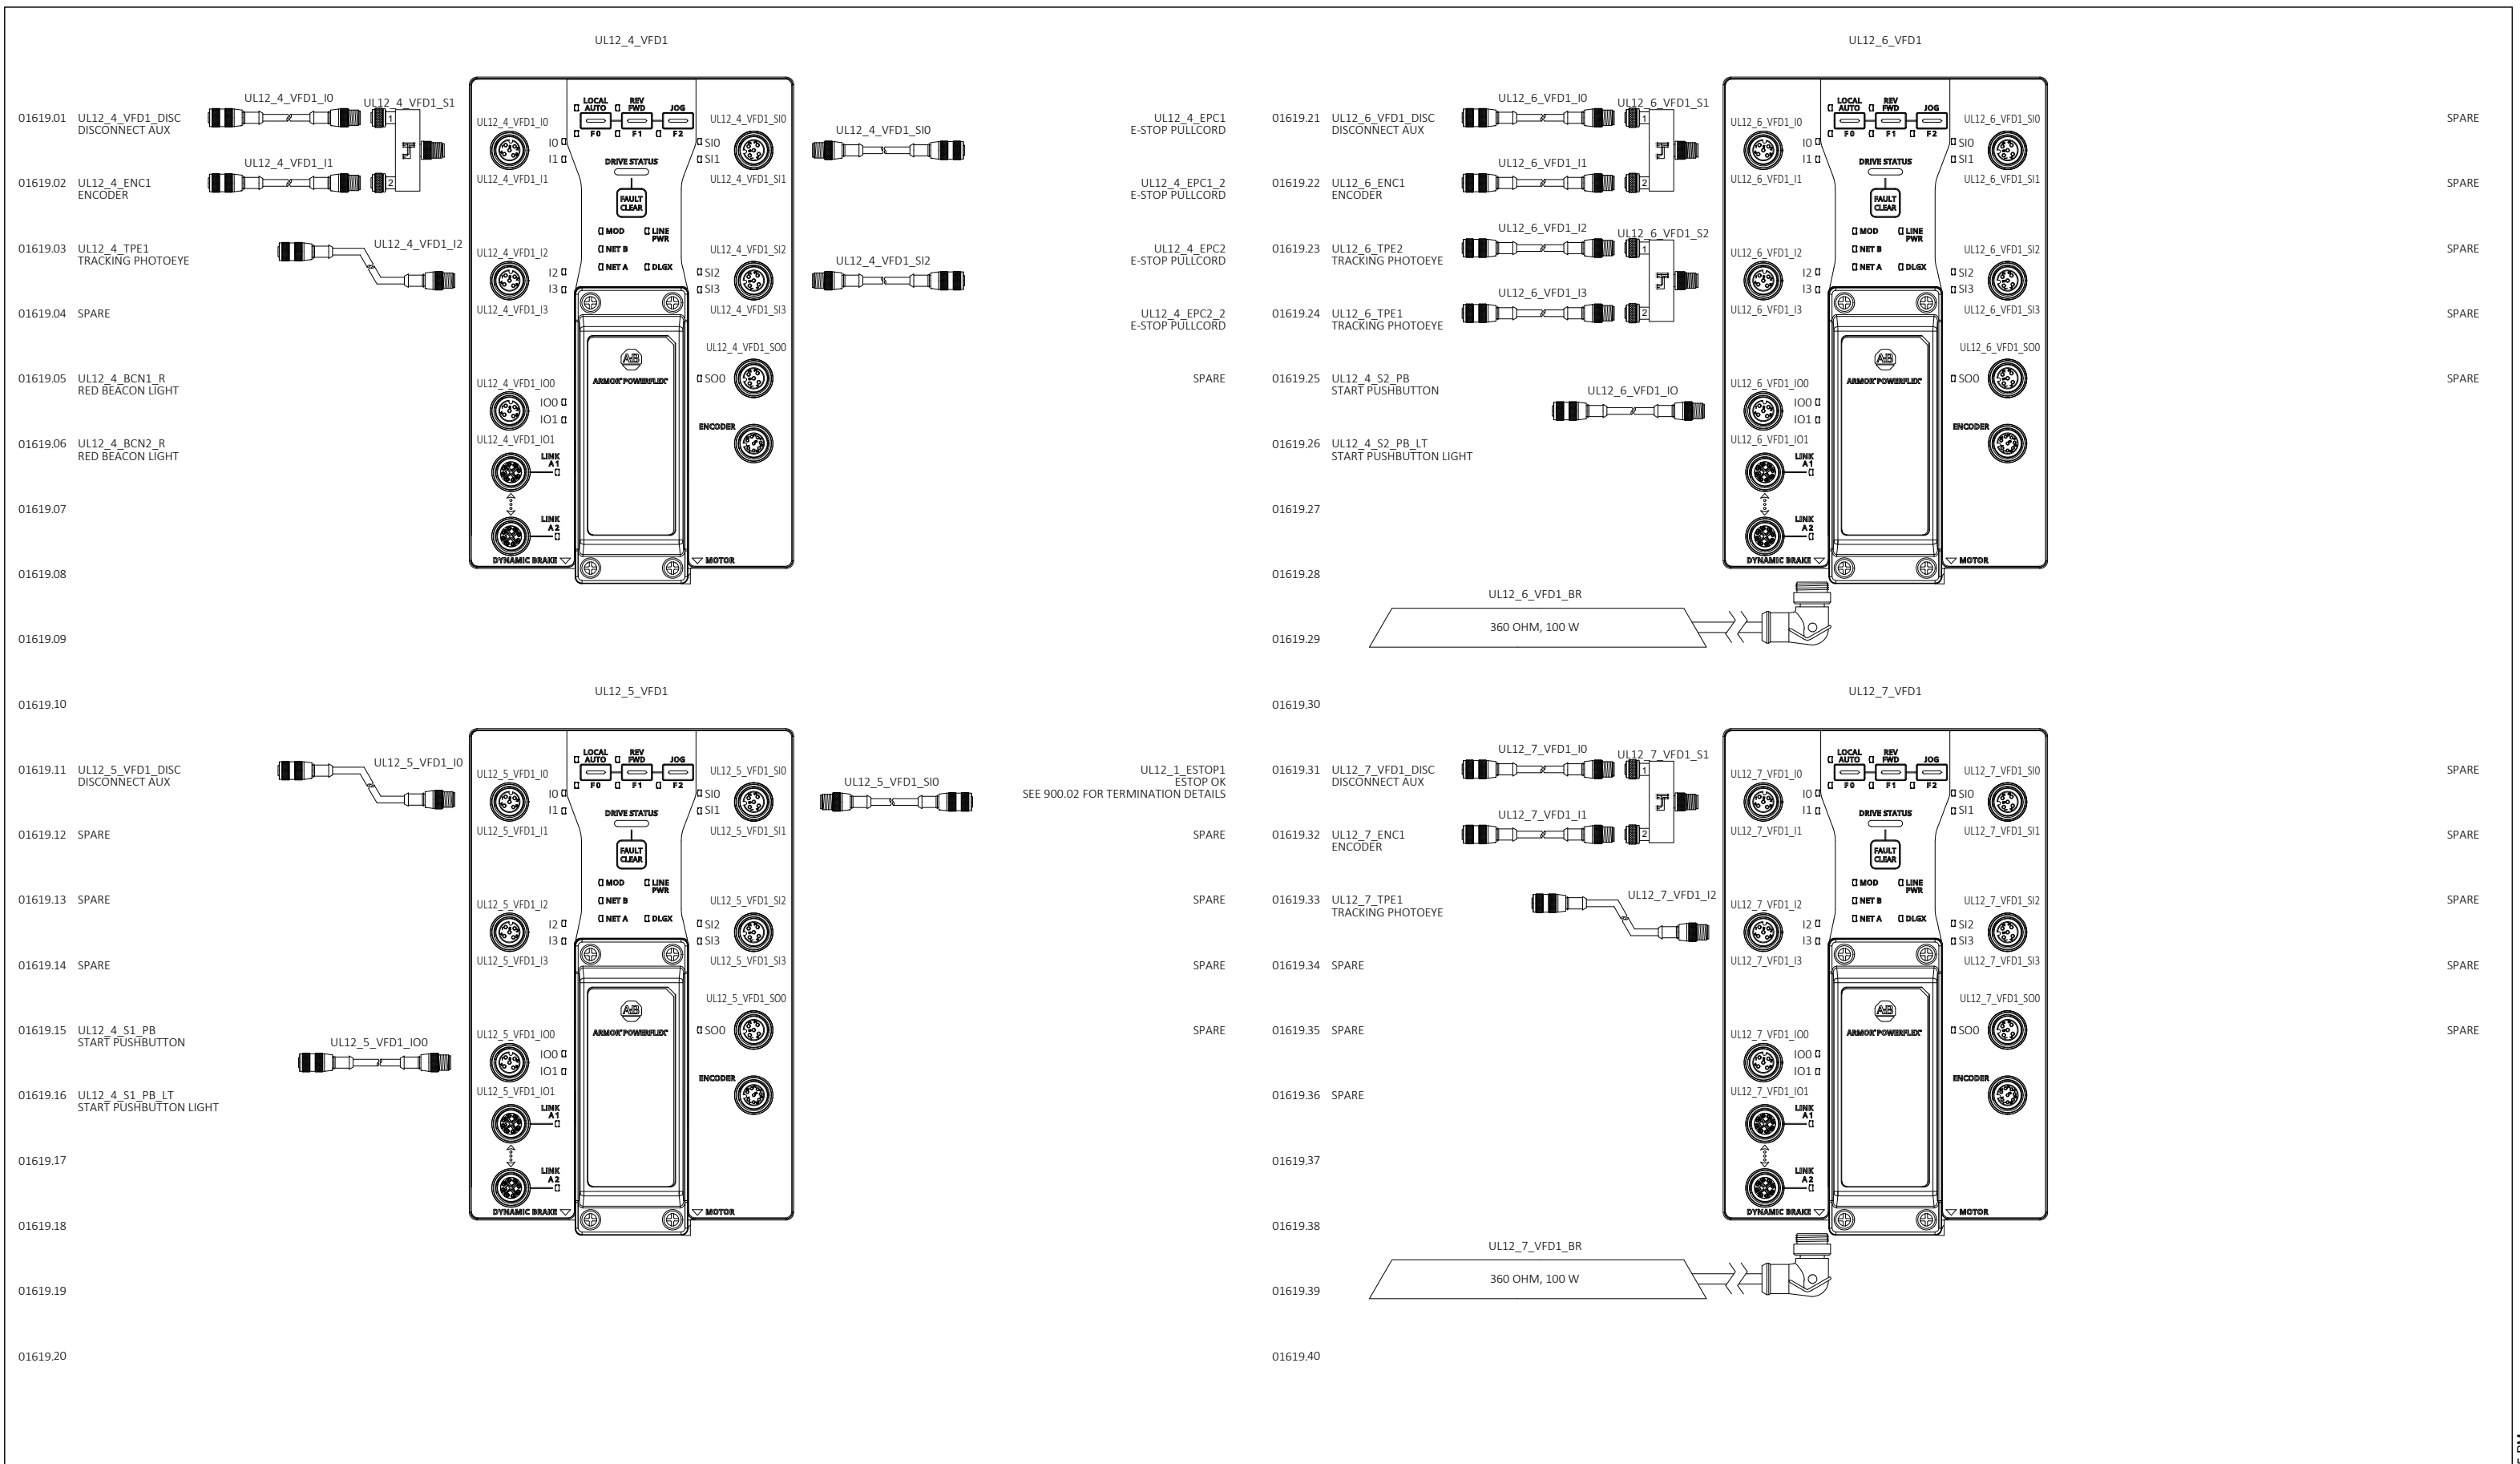

DRAWING REVISIONS			
REV	DESCRIPTION	DATE	BY
00	INITIAL DRAWINGS	05/09/2025	SK
01	ALARM HORNS	06/18/2025	SN
A	AS-BUILT	11/13/2025	LB




25K Amazon Cross-Belt Sort Center (ACBSC)
UL12_04_VFD1/UL12_05_VFD1/
UL12_06_VFD1/UL12_07_VFD1 IO DRAWINGS

**AMAZON MTN6
SPARROWS POINT, MD**

CONFIDENTIAL: THE INFORMATION CONTAINED HEREIN IS PROPRIETARY INFORMATION OF AUTOMATION STANDARD LLC AND CONSTITUTES TRADE SECRETS PURSUANT TO THE UNIFORM TRADE SECRETS ACT. THIS INFORMATION SHALL ONLY BE USED IN THE PERFORMANCE OF CONTRACT WITH AUTOSTAND. THIS INFORMATION SHALL NOT BE USED, REPRODUCED OR EMPLOYED IN WHOLE PART, EXCEPT WITH AUTOSTAND'S PRIOR WRITTEN APPROVAL.

FILENAME	
2429-AMZ-MTN6-MCM01-619	
D-SIZE SCALE	JOB NUMBER:
NTS	2429
REVISION	SHEET
A	79

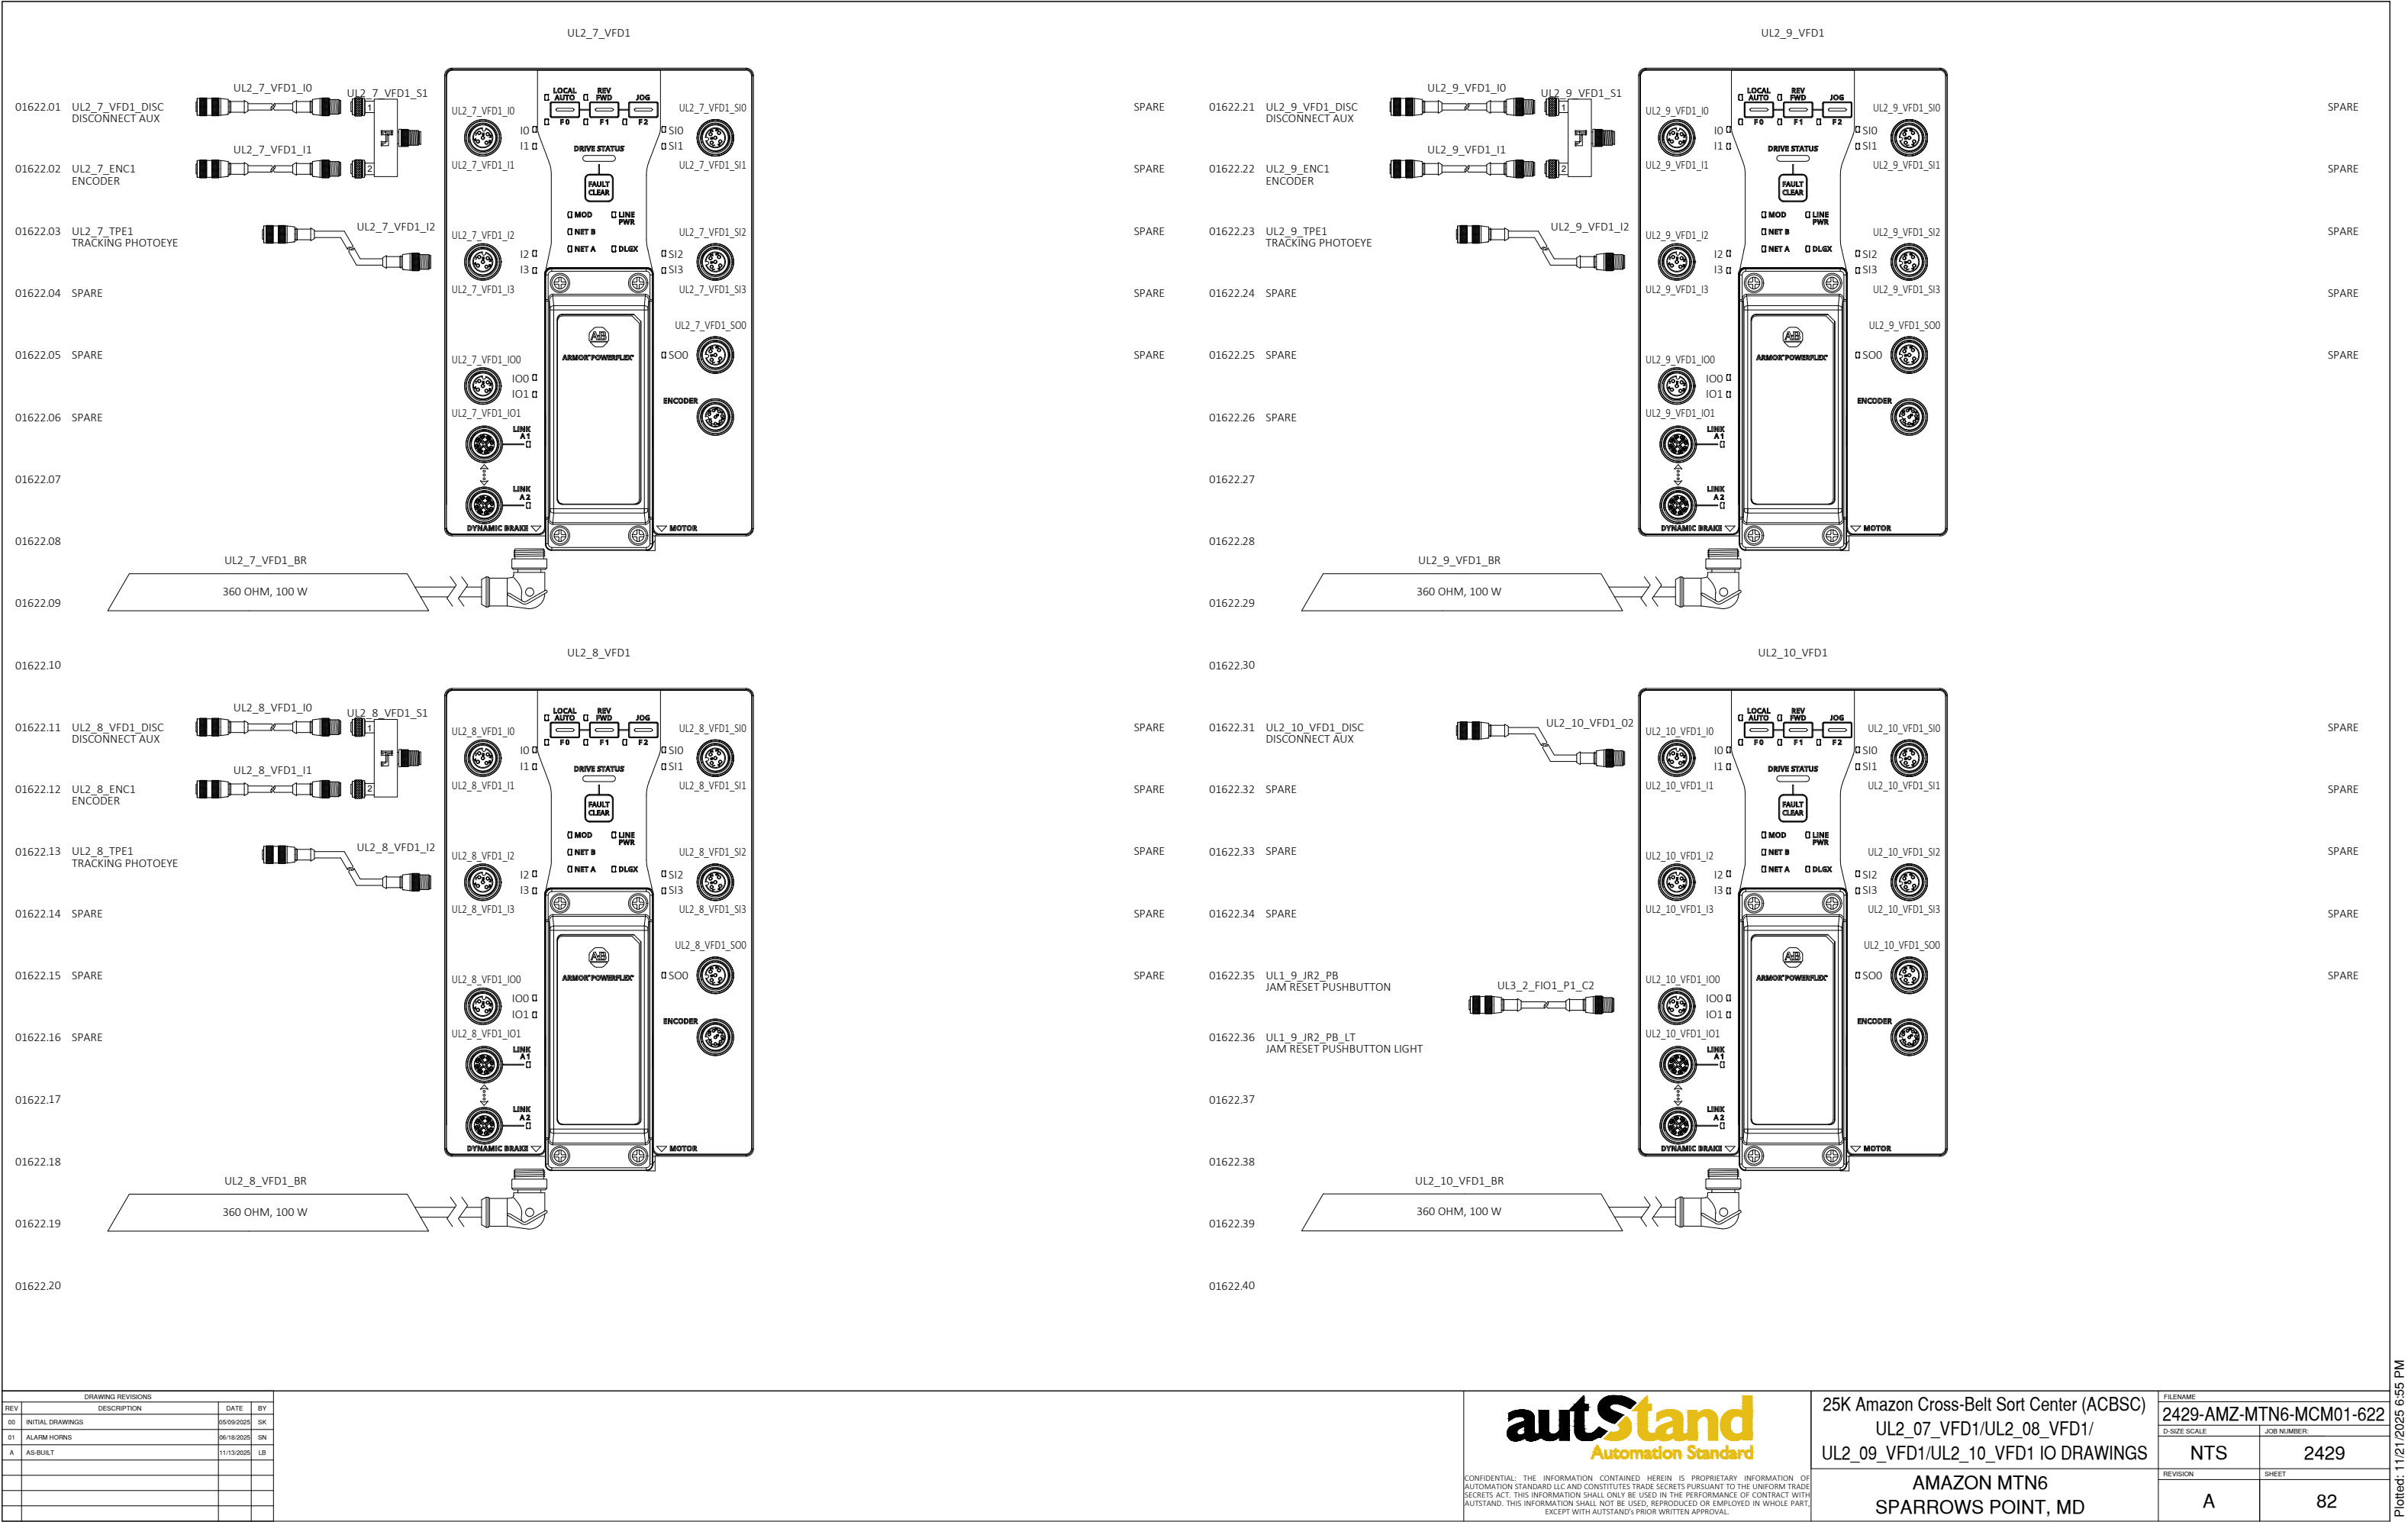

DRAWING REVISIONS			
REV	DESCRIPTION	DATE	BY
00	INITIAL DRAWINGS	05/09/2025	SK
01	ALARM HORNS	06/16/2025	SN
A	AS-BUILT	11/13/2025	LB

FILENAME	
D-SIZE SCALE	JOB NUMBER
NTS	2429
REVISION	SHEET
A	82

autStand

Automation Standard

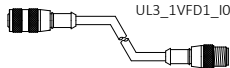
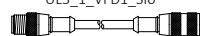
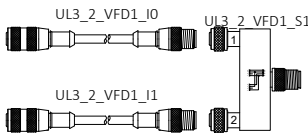
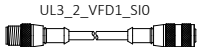
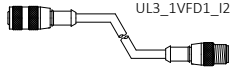
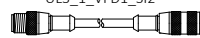
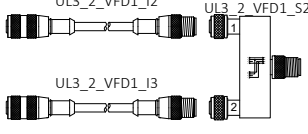
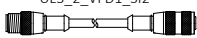
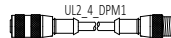
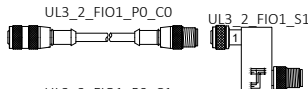
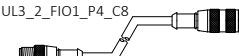
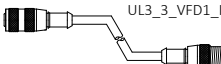
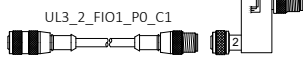
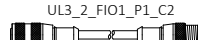
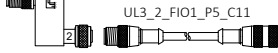
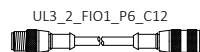
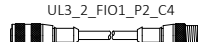
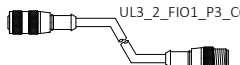
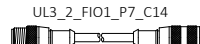
CONFIDENTIAL: THE INFORMATION CONTAINED HEREIN IS PROPRIETARY INFORMATION OF AUTOMATION STANDARD LLC AND CONSTITUTES TRADE SECRETS PURSUANT TO THE UNIFORM TRADE SECRETS ACT. THIS INFORMATION SHALL ONLY BE USED IN THE PERFORMANCE OF CONTRACT WITH AUTISTAND. THIS INFORMATION SHALL NOT BE USED, REPRODUCED OR EMPLOYED IN WHOLE PART, EXCEPT WITH AUTISTAND'S PRIOR WRITTEN APPROVAL.


25K Amazon Cross-Belt Sort Center (ACBSC)

UL2_07_VFD1/UL2_08_VFD1/
UL2_09_VFD1/UL2_10_VFD1 IO DRAWINGS

AMAZON MTN6
SPARROWS POINT, MD

Plotted: 11/21/2025 6:55 PM

			UL3_1_VFD1						UL3_2_VFD1					
01623.01	UL3_1_VFD1_DISC	DISCONNECT AUX												
01623.02	SPARE													
01623.03	UL3_1_TPE1	TRACKING PHOTOEYE												
01623.04	SPARE													
01623.05	SPARE													
01623.06	SPARE													
01623.07														
01623.08														
01623.09														
01623.10														
01623.11	UL3_1_BCN1_R	RED BEACON LIGHT										SPARE		
01623.12	UL3_1_BCN2_R	RED BEACON LIGHT										SPARE		
01623.13	UL3_1_SS1_SPB	SS STATION START PUSHBUTTON										SPARE		
01623.14	UL3_1_SS1_SPB_LT	SS STATION START PUSHBUTTON LIGHT										SPARE		
01623.15	UL3_1_SS1_STPB	SS STATION STOP PUSHBUTTON										SPARE		
01623.16	SPARE											SPARE		
01623.17	UL3_2_LPE1	LASEREYE												
01623.18	SPARE													
01623.19														
01623.20														

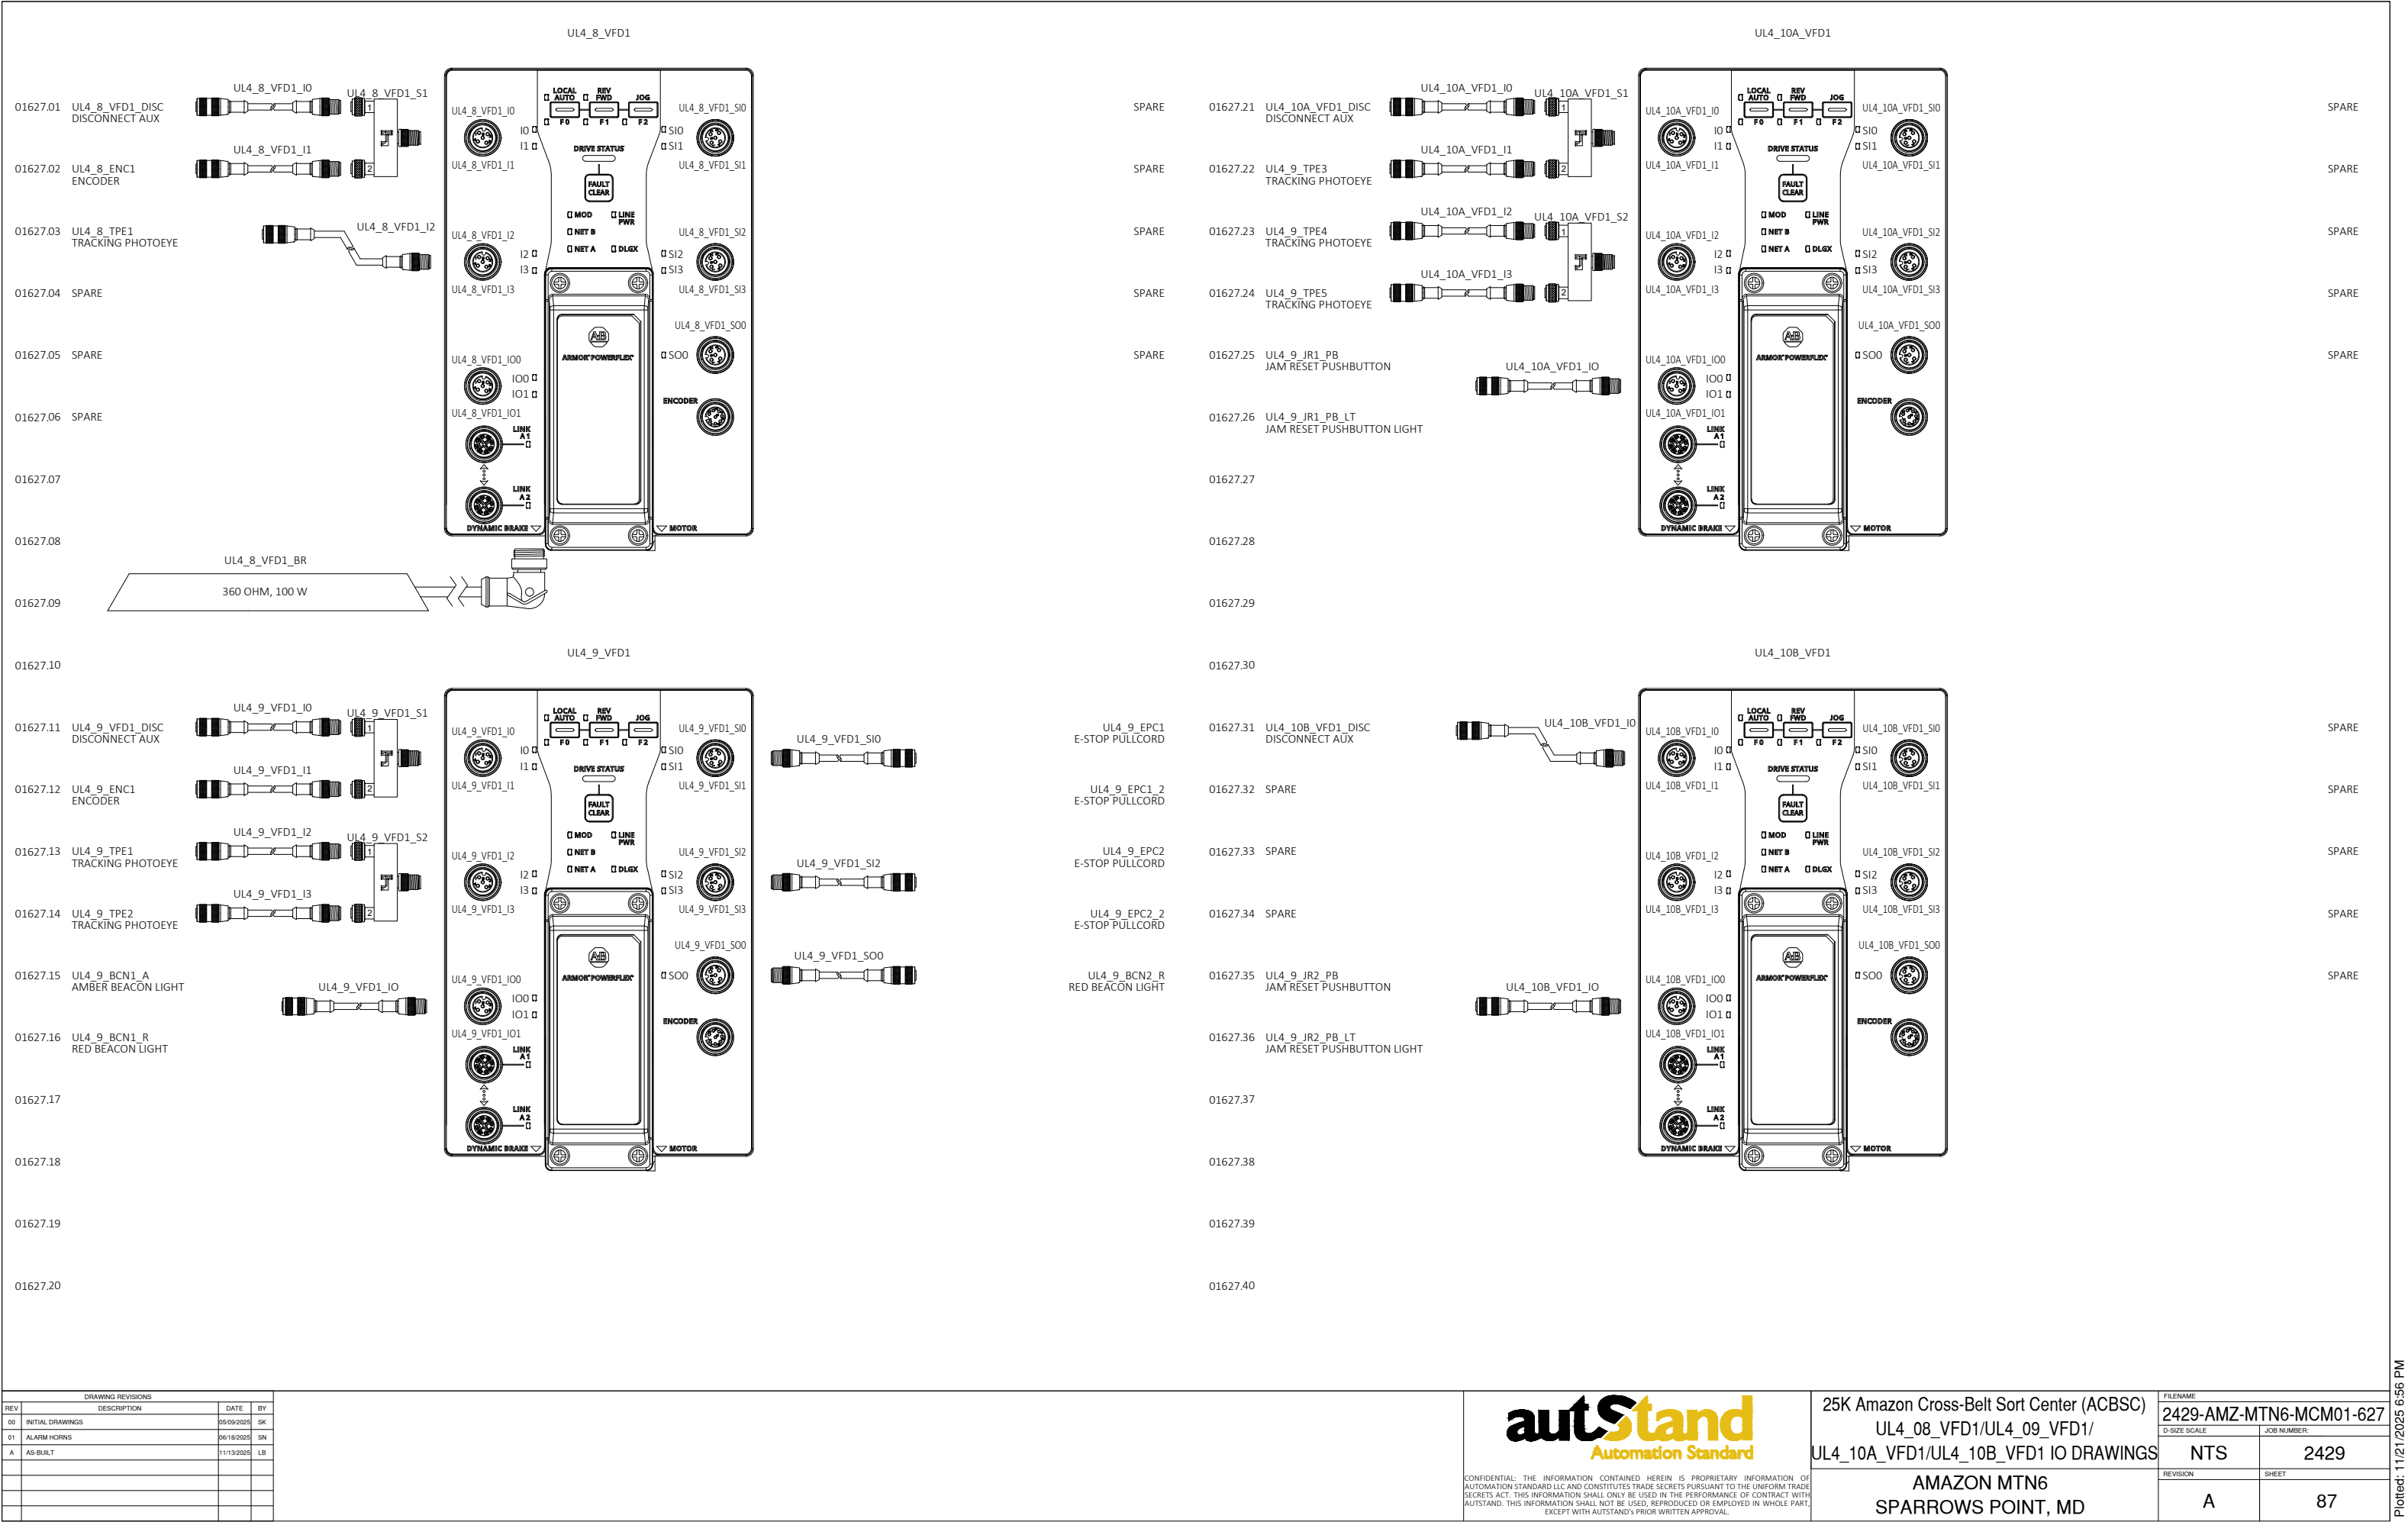

01627.12

UL4_9_ENC1
ENCODER

UL4_9_VFD1_I1

UL4_9_VFD1_S2

01627.13

UL4_9_TPE1
TRACKING PHOTOEYE

UL4_9_VFD1_I2

UL4_9_VFD1_S2

01627.14

UL4_9_TPE2
TRACKING PHOTOEYE

UL4_9_VFD1_I3

UL4_9_VFD1_S2

01627.15

UL4_9_BCN1_A
AMBER BEACON LIGHT

UL4_9_VFD1_I0

01627.16

UL4_9_BCN1_R
RED BEACON LIGHT

01627.17

01627.18

01627.19

01627.20

UL4_8_VFD1

UL4_8_VFD1_I0

UL4_8_VFD1_I1

UL4_8_VFD1_I2

UL4_8_VFD1_I3

UL4_8_VFD1_I00

UL4_8_VFD1_I01

LINK A1

LINK A2

DYNAMIC BRAKE

LOCAL
F0

REV
F1

FWD
F2

JOG

DRIVE STATUS

FAULT
CLEAR

MOD

NET B

NET A

LINE
PWR

DLSX

ENCODER

MOTOR

UL4_8_VFD1_S10

UL4_8_VFD1_S11

UL4_8_VFD1_S12

UL4_8_VFD1_S13

UL4_8_VFD1_S00

UL4_8_VFD1_S00

ENCODER

UL4_9_VFD1

UL4_9_VFD1_I0

UL4_9_VFD1_I1

UL4_9_VFD1_I2

UL4_9_VFD1_I3

UL4_9_VFD1_I00

UL4_9_VFD1_I01

LINK A1

LINK A2

DYNAMIC BRAKE

LOCAL
F0

REV
F1

FWD
F2

JOG

DRIVE STATUS

FAULT
CLEAR

MOD

NET B

NET A

LINE
PWR

DLSX

ENCODER

MOTOR

UL4_9_VFD1_S10

UL4_9_VFD1_S11

UL4_9_VFD1_S12

UL4_9_VFD1_S13

UL4_9_VFD1_S00

UL4_9_VFD1_S00

ENCODER

UL4_9_VFD1_S10

UL4_9_VFD1_S12

UL4_9_VFD1_S00

UL4_10A_VFD1

UL4_10A_VFD1_I0

UL4_10A_VFD1_I1

UL4_10A_VFD1_I2

UL4_10A_VFD1_I3

UL4_10A_VFD1_I00

UL4_10A_VFD1_I01

LINK A1

LINK A2

DYNAMIC BRAKE

LOCAL
F0

REV
F1

FWD
F2

JOG

DRIVE STATUS

FAULT
CLEAR

MOD

NET B

NET A

LINE
PWR

DLSX

ENCODER

MOTOR

UL4_10A_VFD1_S10

UL4_10A_VFD1_S11

UL4_10A_VFD1_S12

UL4_10A_VFD1_S13

UL4_10A_VFD1_S00

UL4_10A_VFD1_S00

ENCODER

UL4_10A_VFD1_S10

UL4_10A_VFD1_S12

UL4_10A_VFD1_S00

UL4_10B_VFD1

UL4_10B_VFD1_I0

UL4_10B_VFD1_I1

UL4_10B_VFD1_I2

UL4_10B_VFD1_I3

UL4_10B_VFD1_I00

UL4_10B_VFD1_I01

LINK A1

LINK A2

DYNAMIC BRAKE

LOCAL
F0

REV
F1

FWD
F2

JOG

DRIVE STATUS

FAULT
CLEAR

MOD

NET B

NET A

LINE
PWR

DLSX

ENCODER

MOTOR

UL4_10B_VFD1_S10

UL4_10B_VFD1_S11

UL4_10B_VFD1_S12

UL4_10B_VFD1_S13

UL4_10B_VFD1_S00

UL4_10B_VFD1_S00

ENCODER

UL4_10B_VFD1_S10

UL4_10B_VFD1_S12

UL4_10B_VFD1_S00

01627.21

UL4_10A_VFD1_DISC
DISCONNECT AUX

UL4_10A_VFD1_I0

UL4_10A_VFD1_S1

01627.22

UL4_9_TPE3
TRACKING PHOTOEYE

UL4_10A_VFD1_I1

UL4_10A_VFD1_S2

01627.23

UL4_9_TPE4
TRACKING PHOTOEYE

UL4_10A_VFD1_I2

UL4_10A_VFD1_S2

01627.24

UL4_9_TPE5
TRACKING PHOTOEYE

UL4_10A_VFD1_I3

UL4_10A_VFD1_S2

01627.25

UL4_9_JR1_PB
JAM RESET PUSHBUTTON

UL4_10A_VFD1_I0

01627.26

UL4_9_JR1_PB_LT
JAM RESET PUSHBUTTON LIGHT

01627.27

01627.28

01627.29

01627.30

01627.31

UL4_10B_VFD1_DISC
DISCONNECT AUX

UL4_10B_VFD1_I0

UL4_10B_VFD1_S1

01627.32

SPARE

01627.33

SPARE

01627.34

SPARE

01627.35

UL4_9_JR2_PB
JAM RESET PUSHBUTTON

UL4_10B_VFD1_I0

01627.36

UL4_9_JR2_PB_LT
JAM RESET PUSHBUTTON LIGHT

01627.37

01627.38

01627.39

01627.40

DRAWING REVISIONS			
REV	DESCRIPTION	DATE	BY
00	INITIAL DRAWINGS	05/09/2025	SK
01	ALARM HORNS	06/18/2025	SN
A	AS-BUILT	11/13/2025	LB

FILENAME	
D-SIZE SCALE	JOB NUMBER
NTS	2429
REVISION	SHEET
A	87

autStand

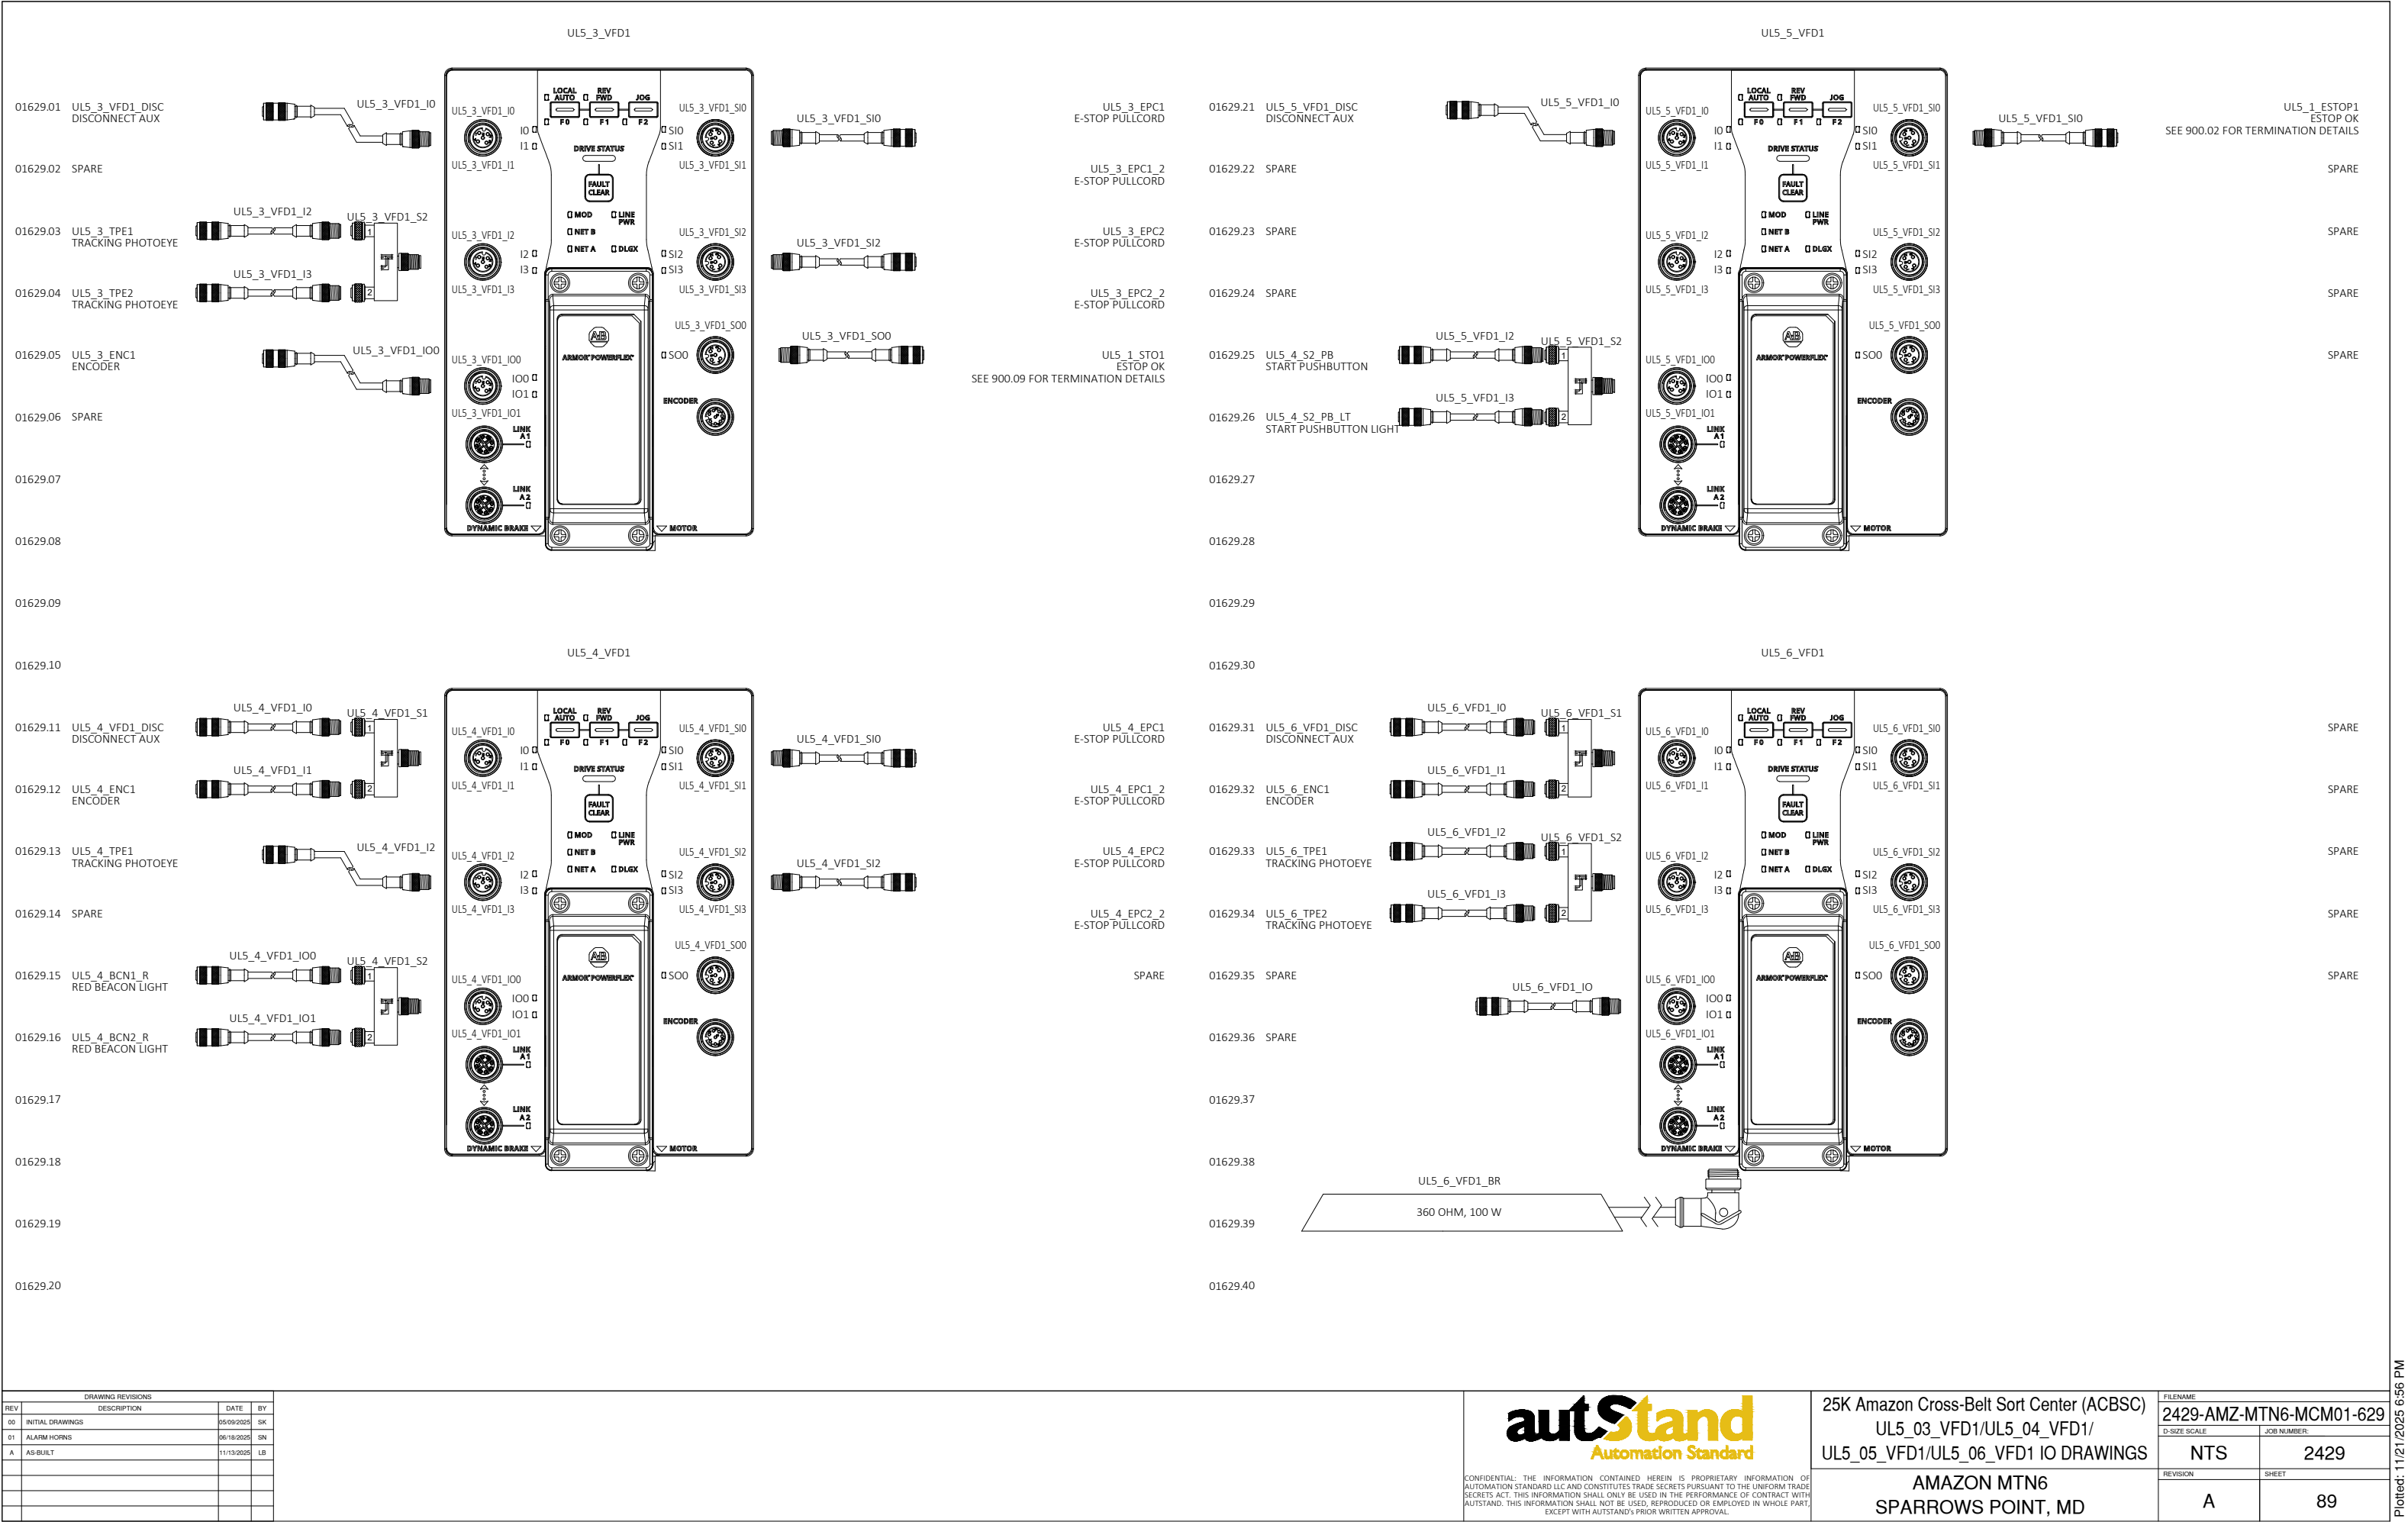
Automation Standard

CONFIDENTIAL: THE INFORMATION CONTAINED HEREIN IS PROPRIETARY INFORMATION OF AUTOMATION STANDARD LLC AND CONSTITUTES TRADE SECRETS PURSUANT TO THE UNIFORM TRADE SECRETS ACT. THIS INFORMATION SHALL ONLY BE USED IN THE PERFORMANCE OF CONTRACT WITH AUTISTAND. THIS INFORMATION SHALL NOT BE USED, REPRODUCED OR EMPLOYED IN WHOLE PART, EXCEPT WITH AUTISTAND'S PRIOR WRITTEN APPROVAL.

25K Amazon Cross-Belt Sort Center (ACBSC)

UL4_08_VFD1/UL4_09_VFD1/
UL4_10A_VFD1/UL4_10B_VFD1 IO DRAWINGS

AMAZON MTN6
SPARROWS POINT, MD



01629.122

UL5_1_ESTOP1
ESTOP OK

UL5_1_ESTOP1

01629.123

SPARE

01629.124

SPARE

01629.125

SPARE

01629.126

SPARE

01629.127

UL5_3_EPC1
E-STOP PULLCORD

01629.128

UL5_3_EPC1_2
E-STOP PULLCORD

01629.129

UL5_3_EPC2
E-STOP PULLCORD

01629.130

UL5_3_EPC2_2
E-STOP PULLCORD

01629.131

UL5_1_STO1
ESTOP OK

01629.132

UL5_3_VFD1

UL5_3_VFD1

01629.133

UL5_3_VFD1_SIO

UL5_3_VFD1_SIO

01629.134

UL5_3_VFD1_SI2

UL5_3_VFD1_SI2

01629.135

UL5_3_VFD1_S00

UL5_3_VFD1_S00

01629.136

UL5_5_VFD1

UL5_5_VFD1

01629.137

UL5_5_VFD1_SIO

UL5_5_VFD1_SIO

01629.138

UL5_5_VFD1_SI2

UL5_5_VFD1_SI2

01629.139

UL5_5_VFD1_S00

UL5_5_VFD1_S00

01629.140

UL5_4_VFD1

UL5_4_VFD1

01629.141

UL5_4_VFD1_SIO

UL5_4_VFD1_SIO

01629.142

UL5_4_VFD1_SI2

UL5_4_VFD1_SI2

01629.143

UL5_6_VFD1

UL5_6_VFD1

01629.144

UL5_6_VFD1_SIO

UL5_6_VFD1_SIO

01629.145

UL5_6_VFD1_SI2

UL5_6_VFD1_SI2

01629.146

UL5_6_VFD1_S00

UL5_6_VFD1_S00

01629.147

UL5_6_VFD1_BR

UL5_6_VFD1_BR

01629.148

360 OHM, 100 W

360 OHM, 100 W

01629.149

UL5_1_ESTOP1
ESTOP OK

UL5_1_ESTOP1

01629.150

SPARE

01629.151

SPARE

01629.152

SPARE

01629.153

SPARE

01629.154

UL5_3_EPC1
E-STOP PULLCORD

01629.155

UL5_3_EPC1_2
E-STOP PULLCORD

01629.156

UL5_3_EPC2
E-STOP PULLCORD

01629.157

UL5_3_EPC2_2
E-STOP PULLCORD

01629.158

UL5_1_STO1
ESTOP OK

01629.159

UL5_3_VFD1

UL5_3_VFD1

01629.160

UL5_3_VFD1_SIO

UL5_3_VFD1_SIO

01629.161

UL5_3_VFD1_SI2

UL5_3_VFD1_SI2

01629.162

UL5_3_VFD1_S00

UL5_3_VFD1_S00

01629.163

UL5_5_VFD1

UL5_5_VFD1

01629.164

UL5_5_VFD1_SIO

UL5_5_VFD1_SIO

01629.165

UL5_5_VFD1_SI2

UL5_5_VFD1_SI2

01629.166

UL5_5_VFD1_S00

UL5_5_VFD1_S00

01629.167

UL5_4_VFD1

UL5_4_VFD1

01629.168

UL5_4_VFD1_SIO

UL5_4_VFD1_SIO

01629.169

UL5_4_VFD1_SI2

UL5_4_VFD1_SI2

01629.170

UL5_6_VFD1

UL5_6_VFD1

01629.171

UL5_6_VFD1_SIO

UL5_6_VFD1_SIO

01629.172

UL5_6_VFD1_SI2

UL5_6_VFD1_SI2

01629.173

UL5_6_VFD1_S00

UL5_6_VFD1_S00

01629.174

UL5_6_VFD1_BR

UL5_6_VFD1_BR

01629.175

360 OHM, 100 W

360 OHM, 100 W

01629.176

UL5_1_ESTOP1
ESTOP OK

UL5_1_ESTOP1

01629.177

SPARE

01629.178

SPARE

01629.179

SPARE

01629.180

SPARE

01629.181

UL5_3_EPC1
E-STOP PULLCORD

01629.182

UL5_3_EPC1_2
E-STOP PULLCORD

01629.183

UL5_3_EPC2
E-STOP PULLCORD

01629.184

UL5_3_EPC2_2
E-STOP PULLCORD

01629.185

UL5_1_STO1
ESTOP OK

01629.186

UL5_3_VFD1

UL5_3_VFD1

01629.187

UL5_3_VFD1_SIO

UL5_3_VFD1_SIO

01629.188

UL5_3_VFD1_SI2

UL5_3_VFD1_SI2

01629.189

UL5_3_VFD1_S00

UL5_3_VFD1_S00

01629.190

UL5_5_VFD1

UL5_5_VFD1

01629.191

UL5_5_VFD1_SIO

UL5_5_VFD1_SIO

01629.192

UL5_5_VFD1_SI2

UL5_5_VFD1_SI2

01629.193

UL5_5_VFD1_S00

UL5_5_VFD1_S00

01629.194

UL5_4_VFD1

UL5_4_VFD1

01629.195

UL5_4_VFD1_SIO

UL5_4_VFD1_SIO

01629.196

UL5_4_VFD1_SI2

UL5_4_VFD1_SI2

01629.197

UL5_6_VFD1

UL5_6_VFD1

01629.198

UL5_6_VFD1_SIO

UL5_6_VFD1_SIO

01629.199

UL5_6_VFD1_SI2

UL5_6_VFD1_SI2

01629.200

UL5_6_VFD1_S00

UL5_6_VFD1_S00

01629.201

UL5_6_VFD1_BR

UL5_6_VFD1_BR

01629.202

360 OHM, 100 W

360 OHM, 100 W

01629.203

UL5_1_ESTOP1
ESTOP OK

UL5_1_ESTOP1

01629.204

SPARE

01629.205

SPARE

01629.206

SPARE

01629.207

SPARE

01629.208

UL5_3_EPC1
E-STOP PULLCORD

01629.209

UL5_3_EPC1_2
E-STOP PULLCORD

01629.210

UL5_3_EPC2
E-STOP PULLCORD

01629.211

UL5_3_EPC2_2
E-STOP PULLCORD

01629.212

UL5_1_STO1
ESTOP OK

01629.213

UL5_3_VFD1

UL5_3_VFD1

01629.214

UL5_3_VFD1_SIO

UL5_3_VFD1_SIO

01629.215

UL5_3_VFD1_SI2

UL5_3_VFD1_SI2

01629.216

UL5_3_VFD1_S00

UL5_3_VFD1_S00

01629.217

UL5_5_VFD1

UL5_5_VFD1

01629.218

UL5_5_VFD1_SIO

UL5_5_VFD1_SIO

01629.219

UL5_5_VFD1_SI2

UL5_5_VFD1_SI2

01629.220

UL5_5_VFD1_S00

UL5_5_VFD1_S00

01629.221

UL5_4_VFD1

UL5_4_VFD1

01629.222

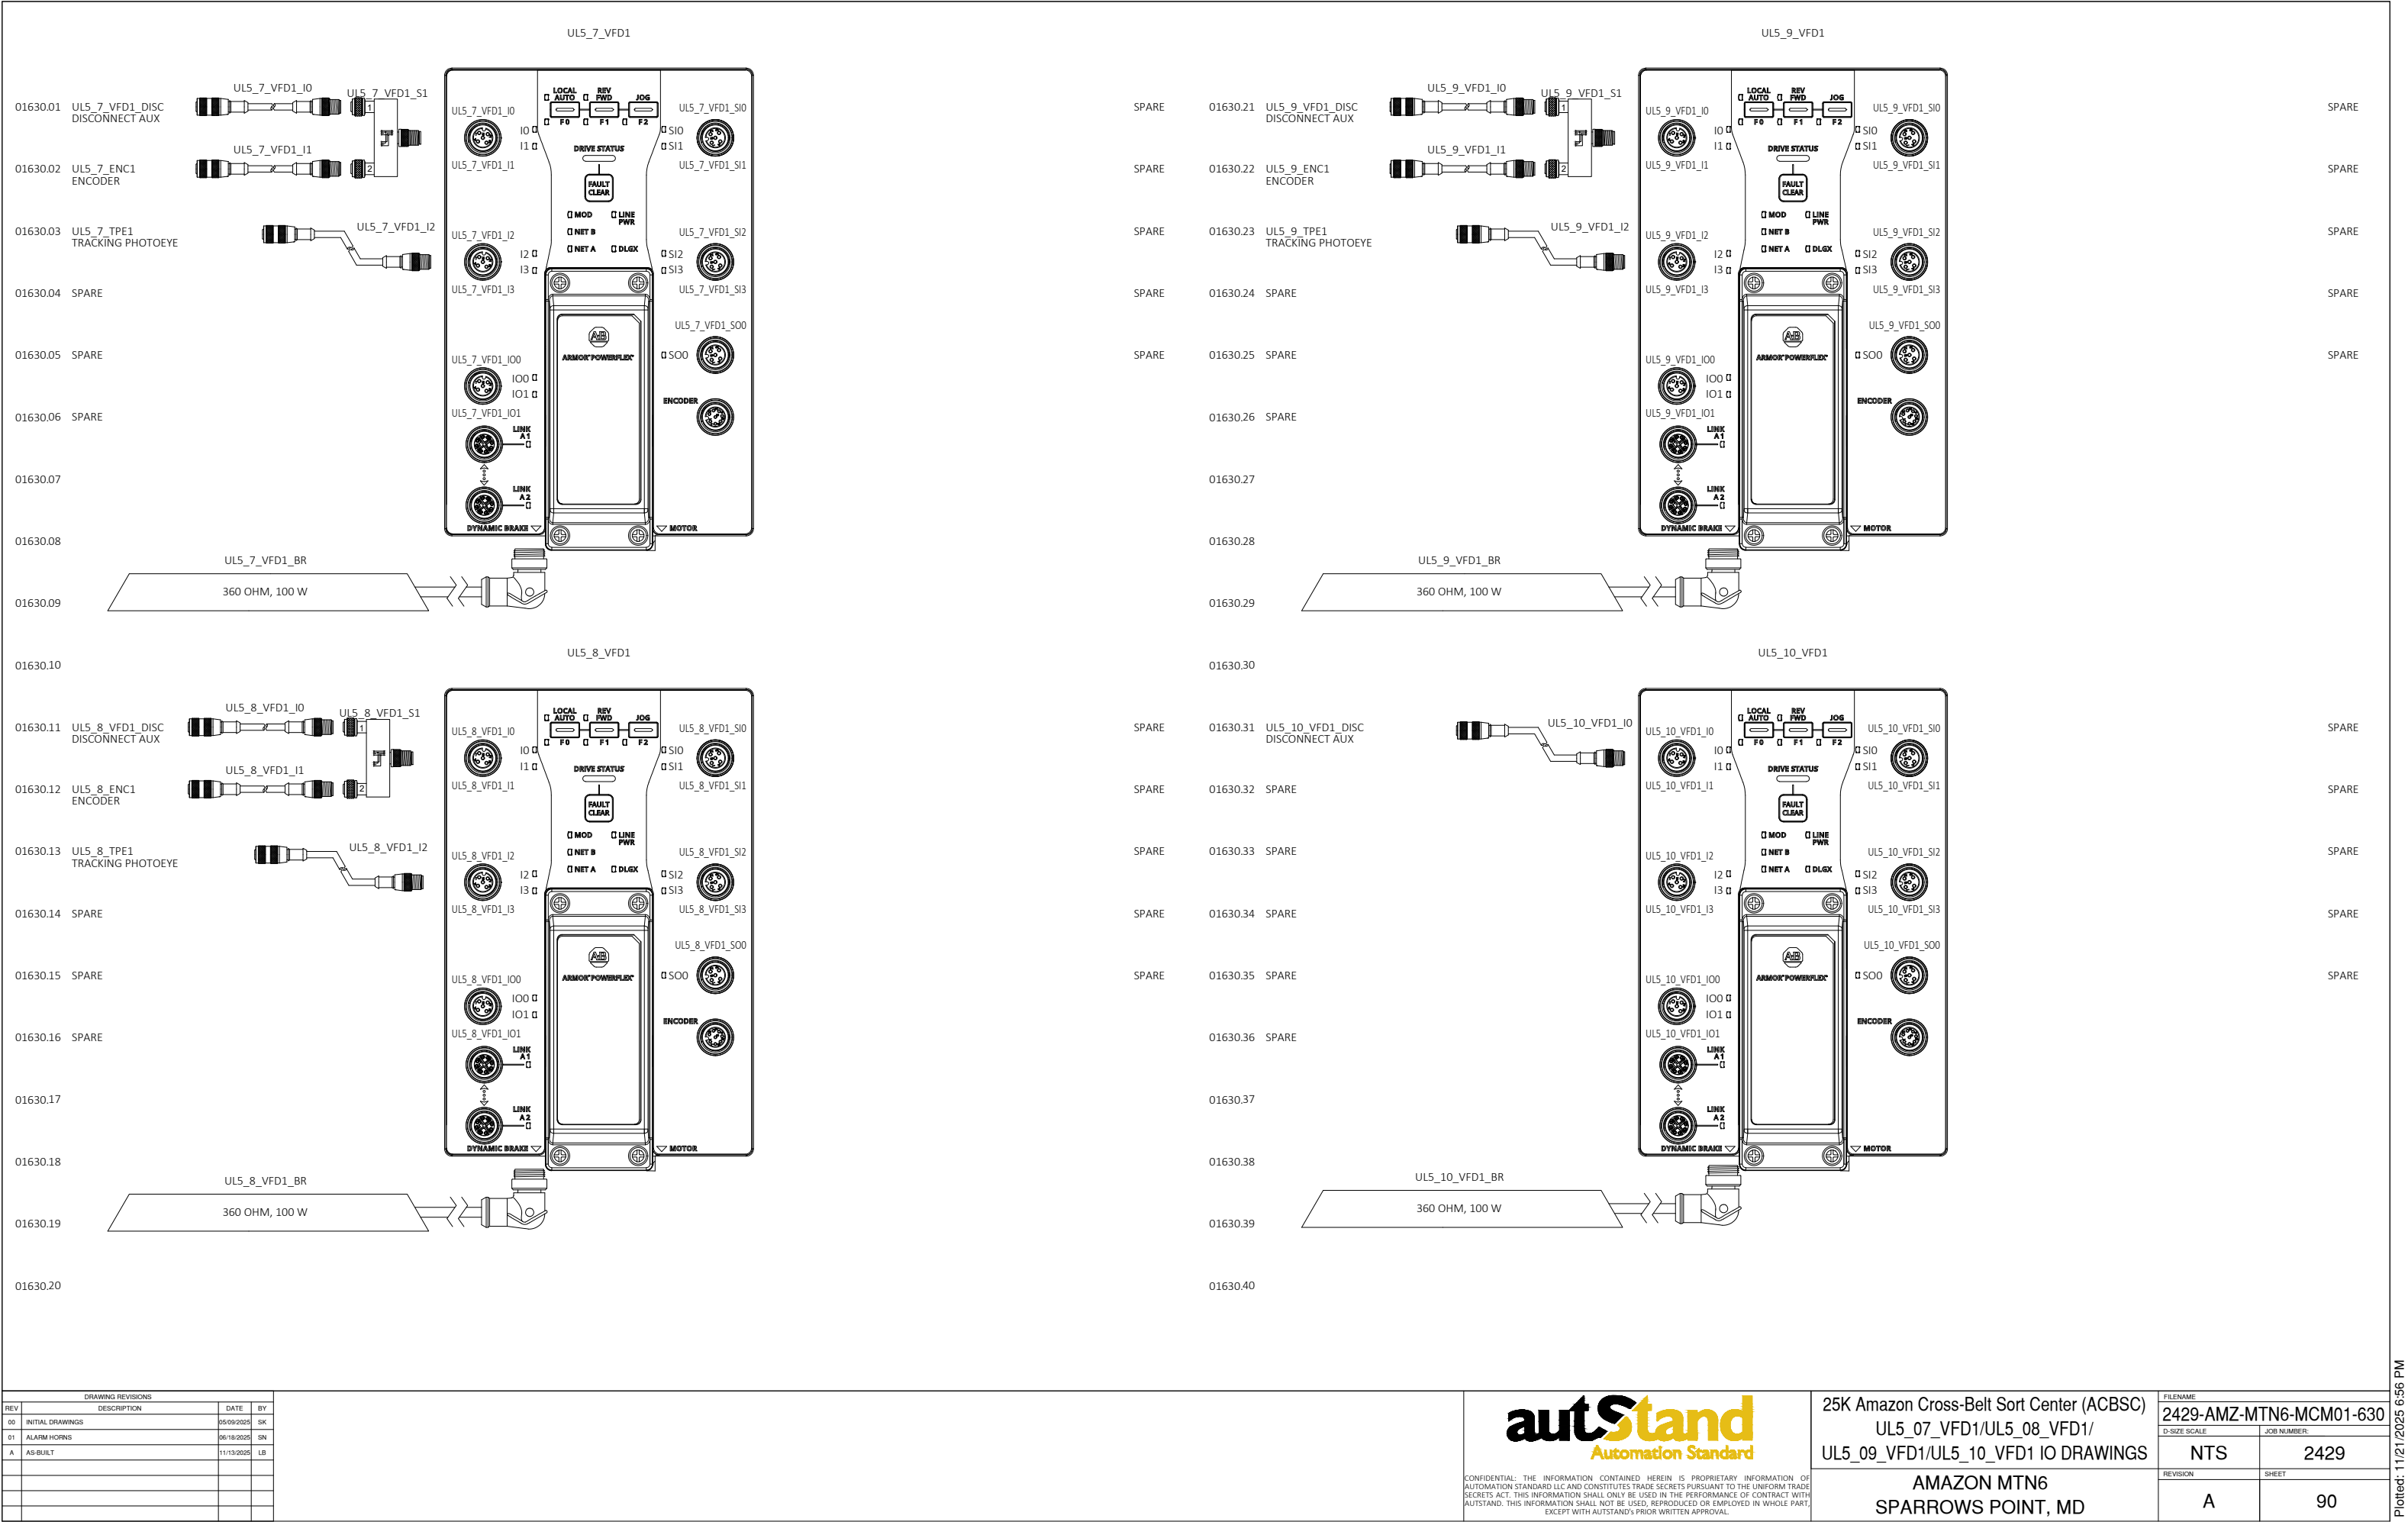
UL5_4_VFD1_SIO

UL5_4_VFD1_SIO


01629.223


UL5_4_VFD1_SI2





<



DRAWING REVISIONS				DATE				BY			
00 INITIAL DRAWINGS				05/09/2025				SK			
01 ALARM HORNS				06/18/2025				SN			
A AS-BUILT				11/13/2025				LB			

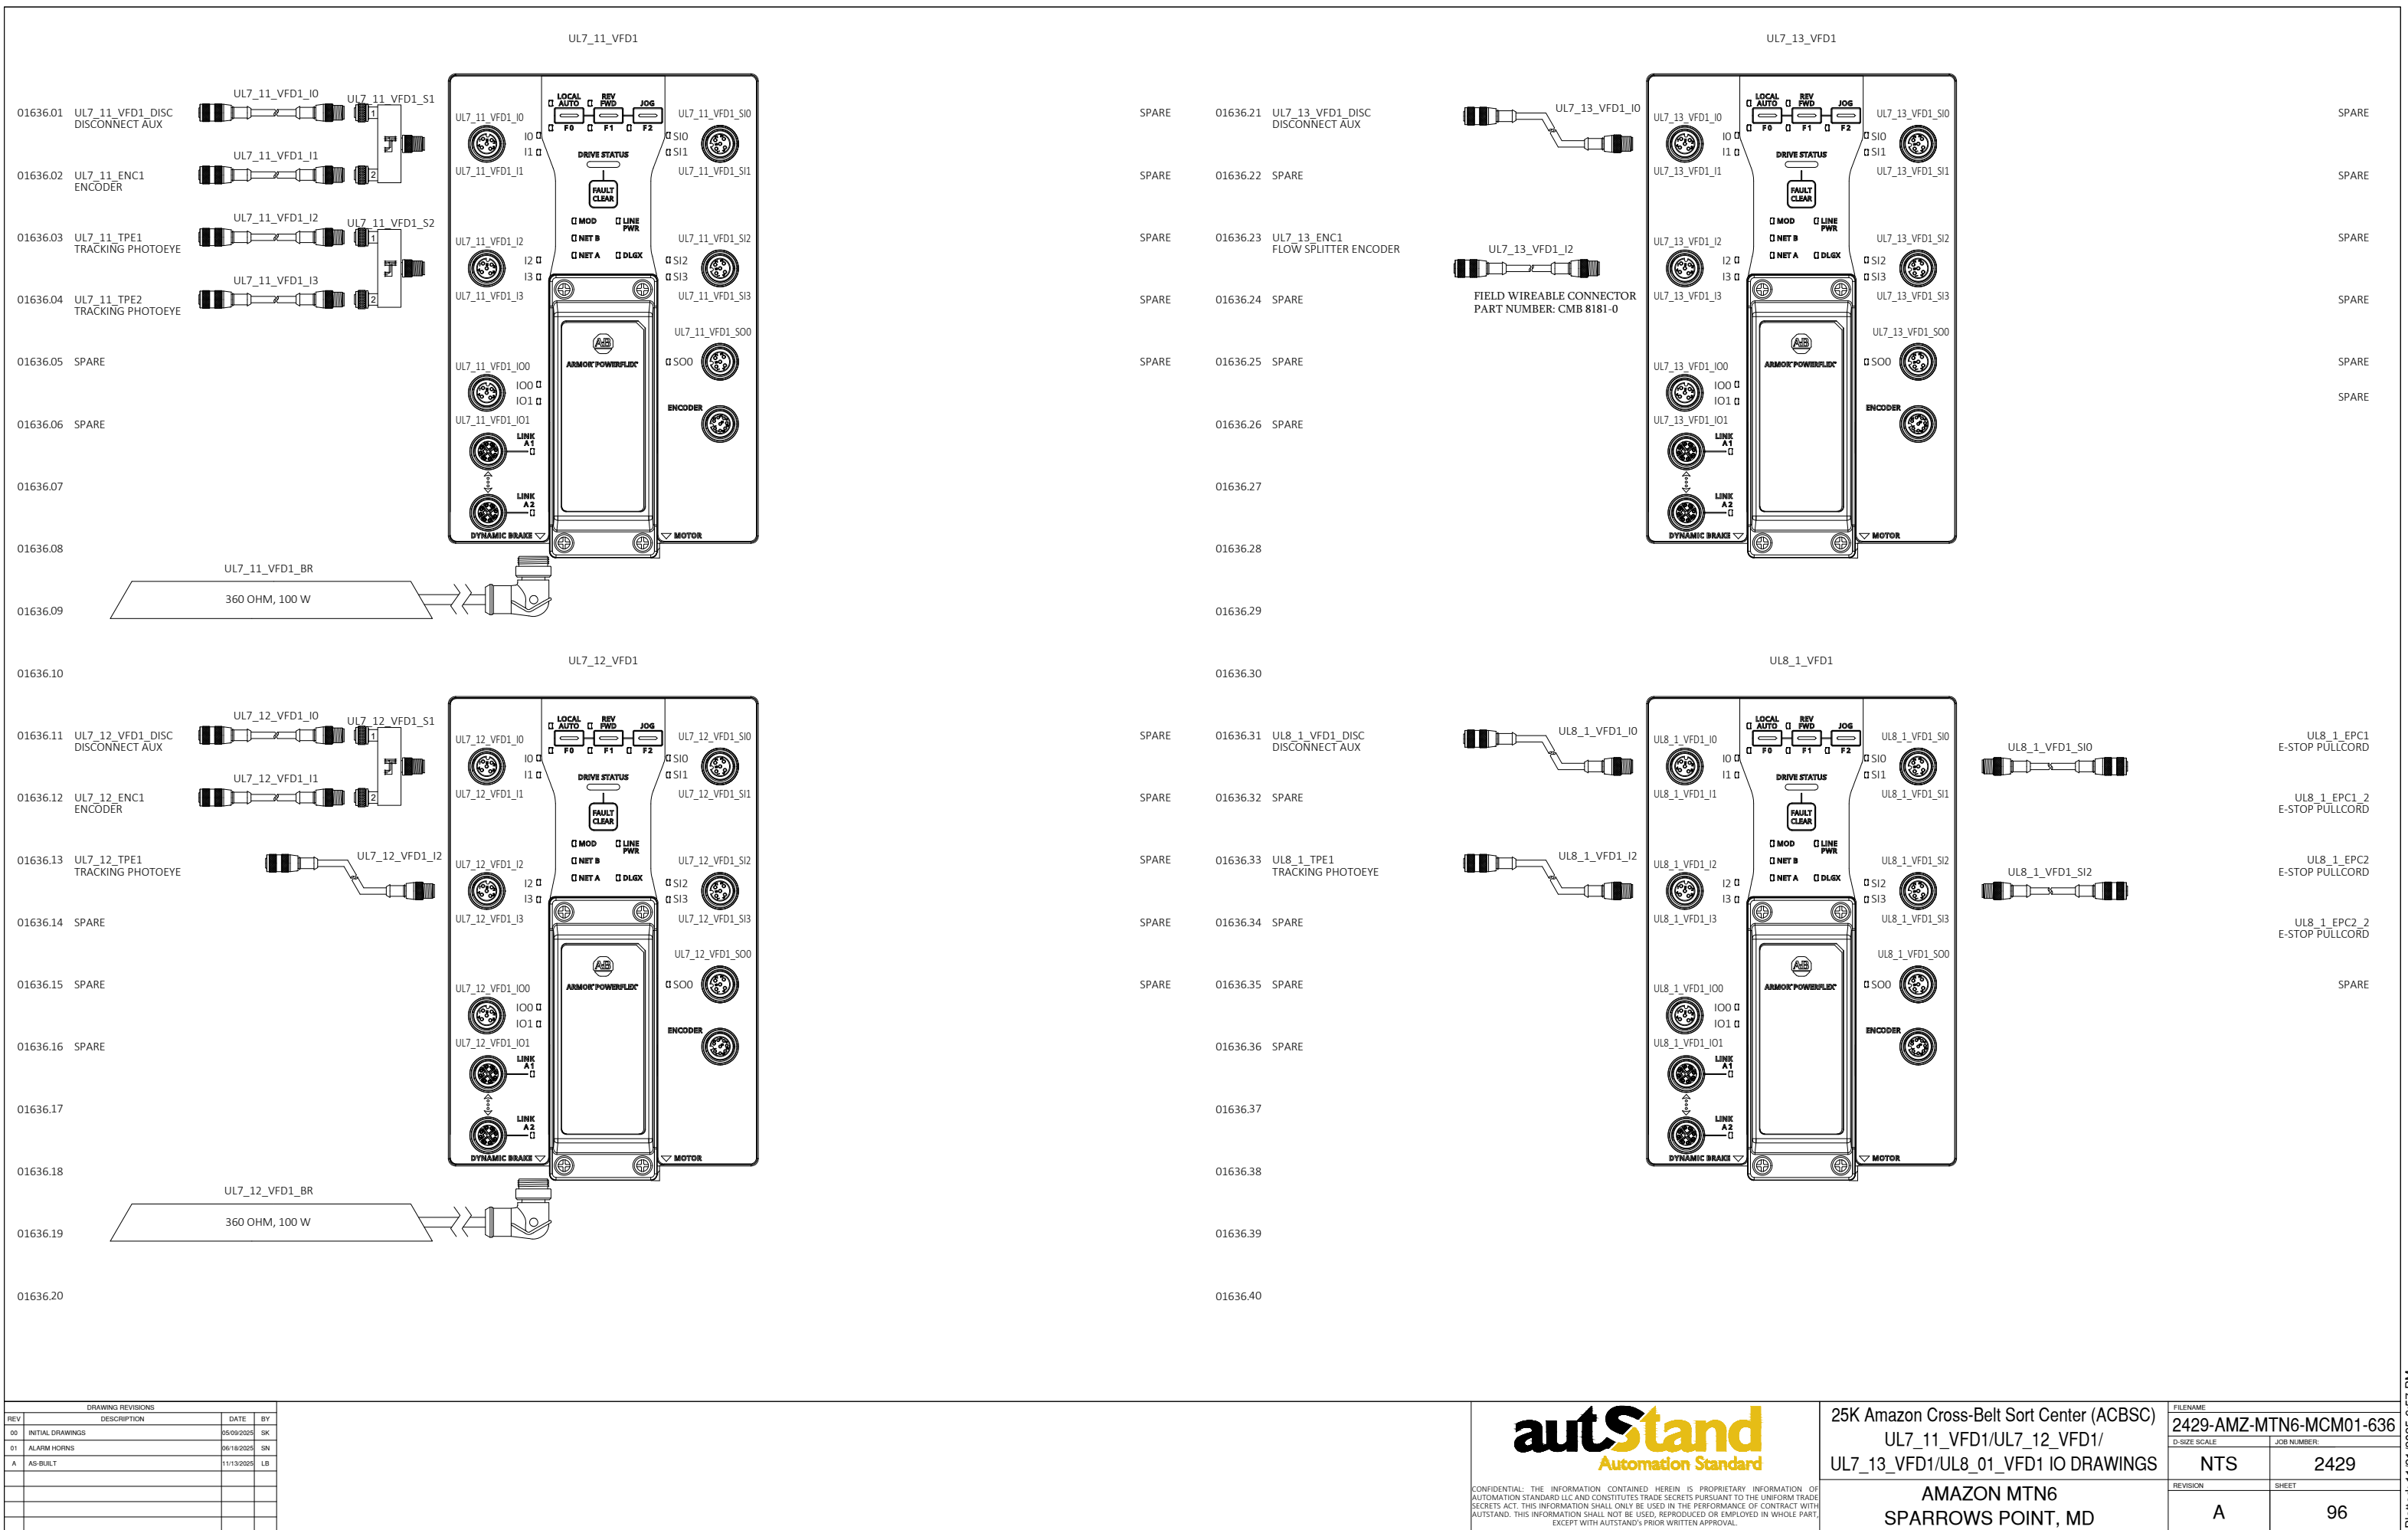

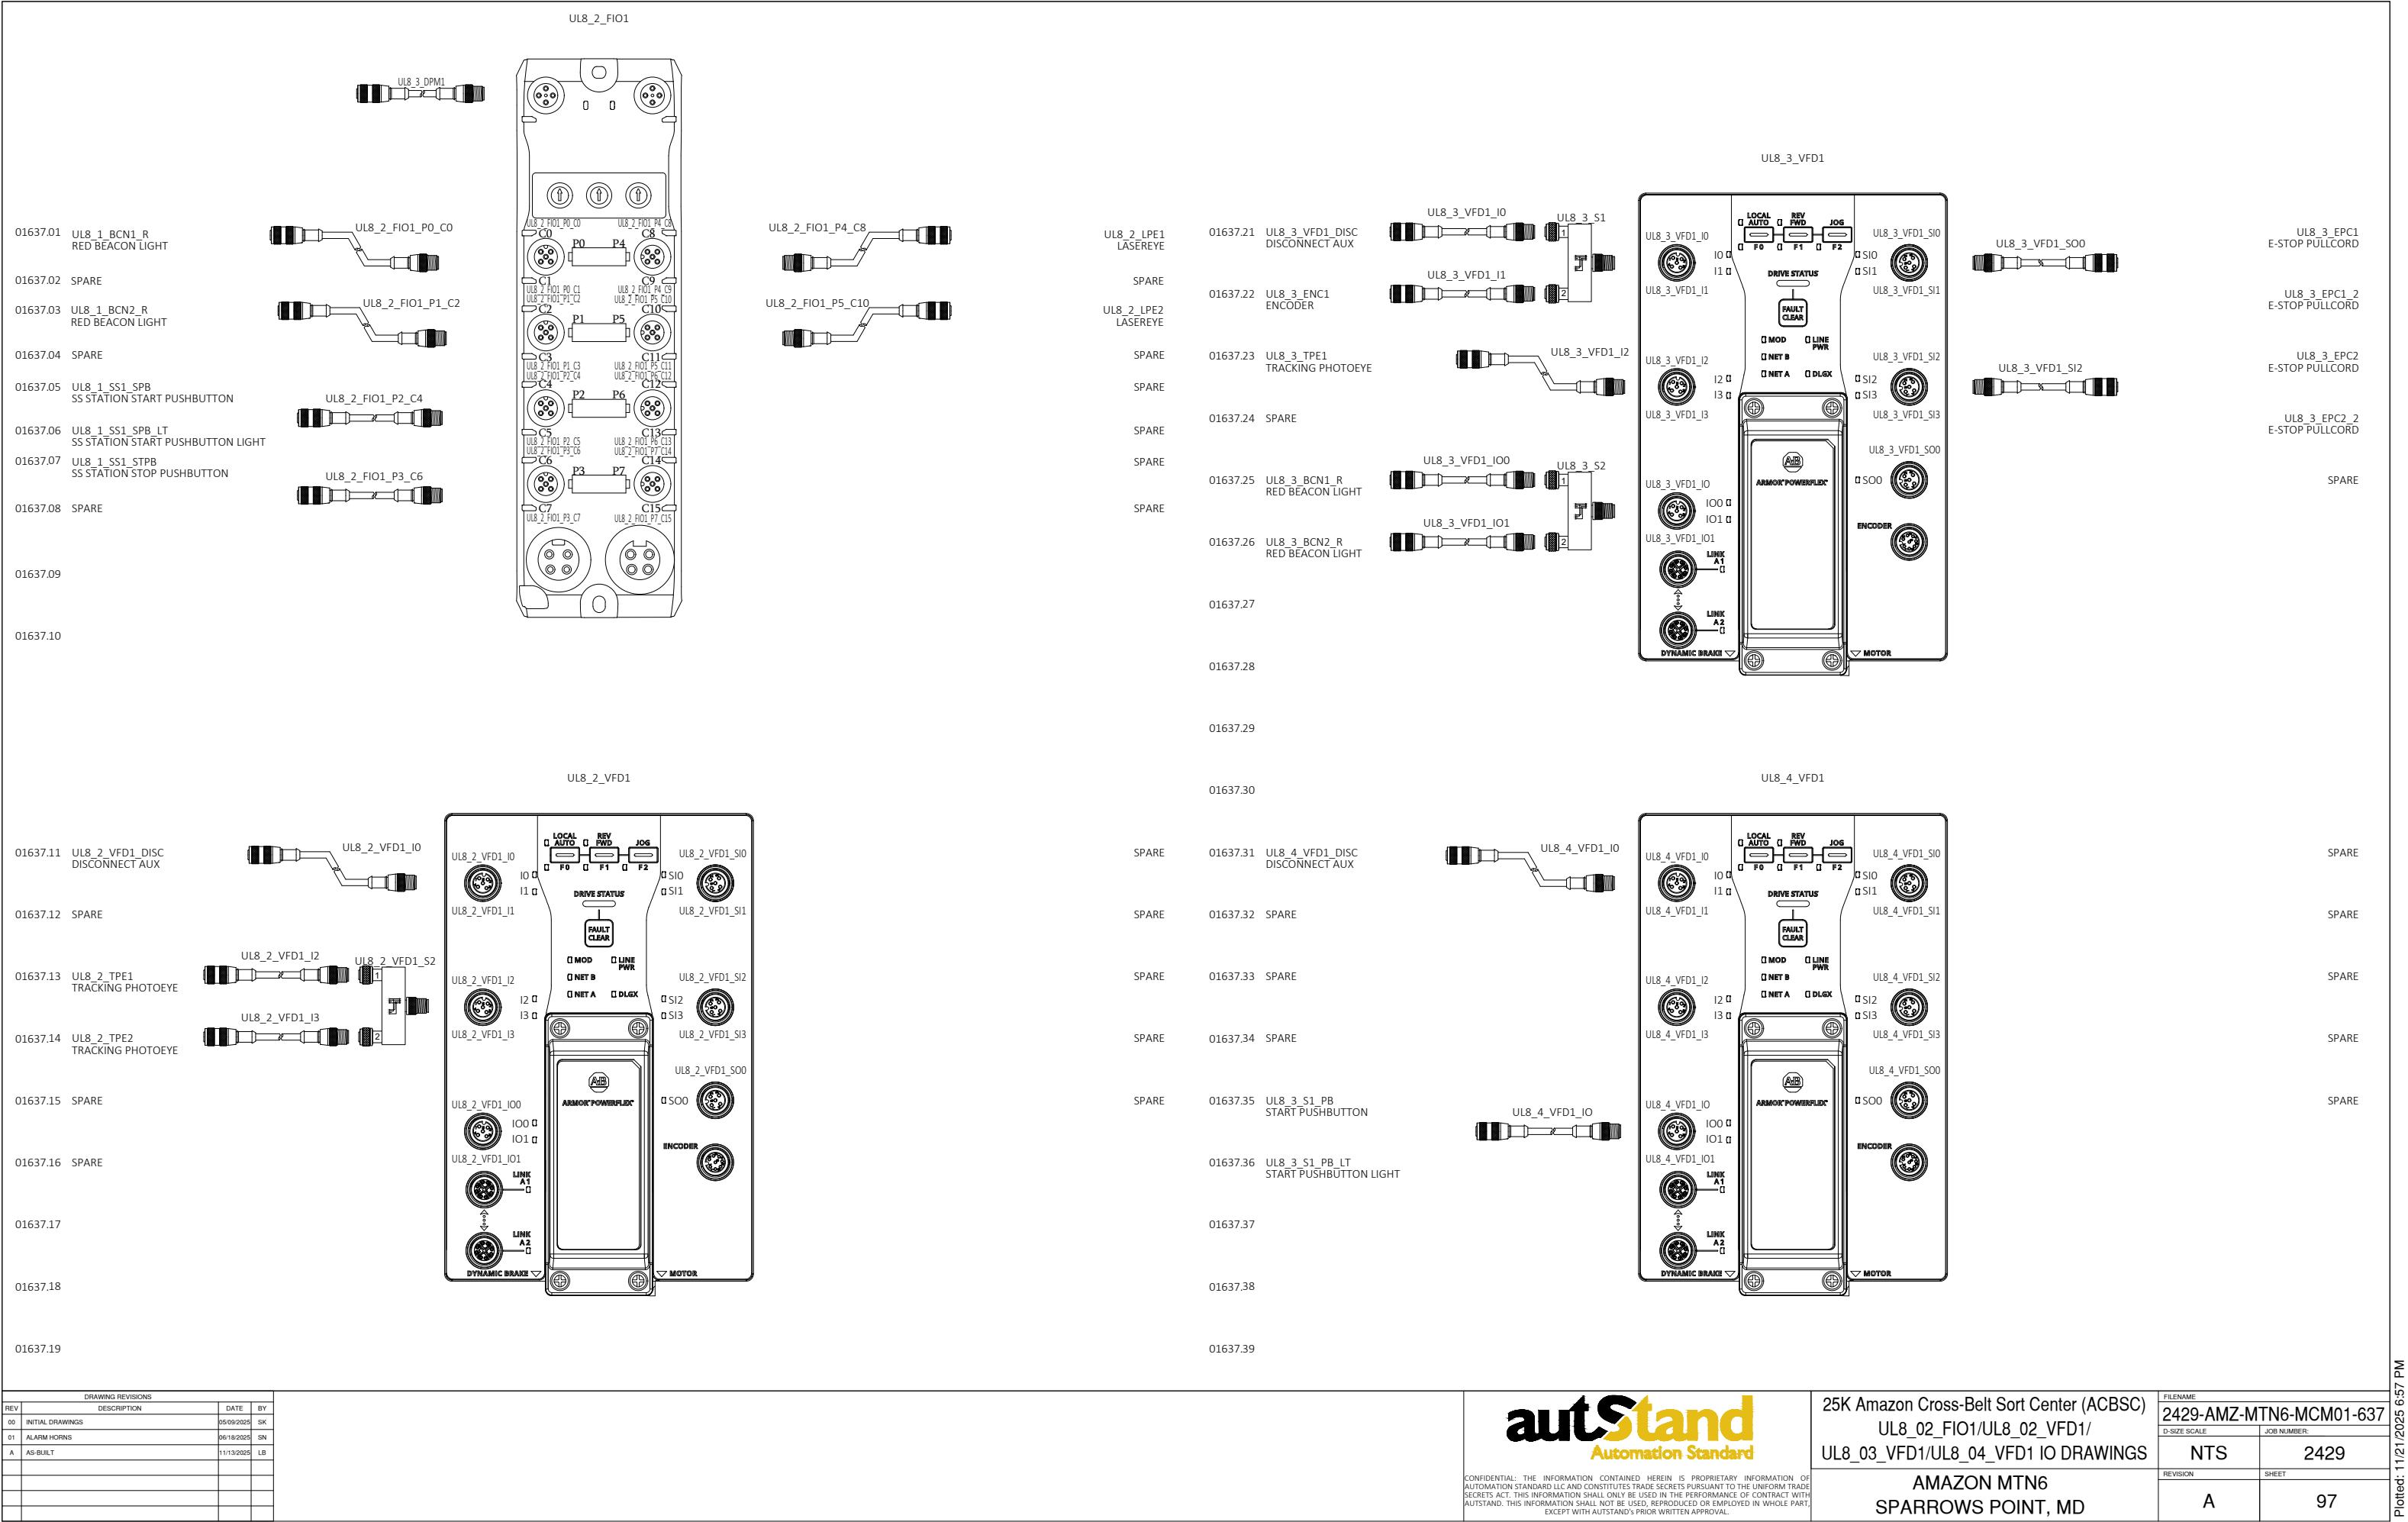

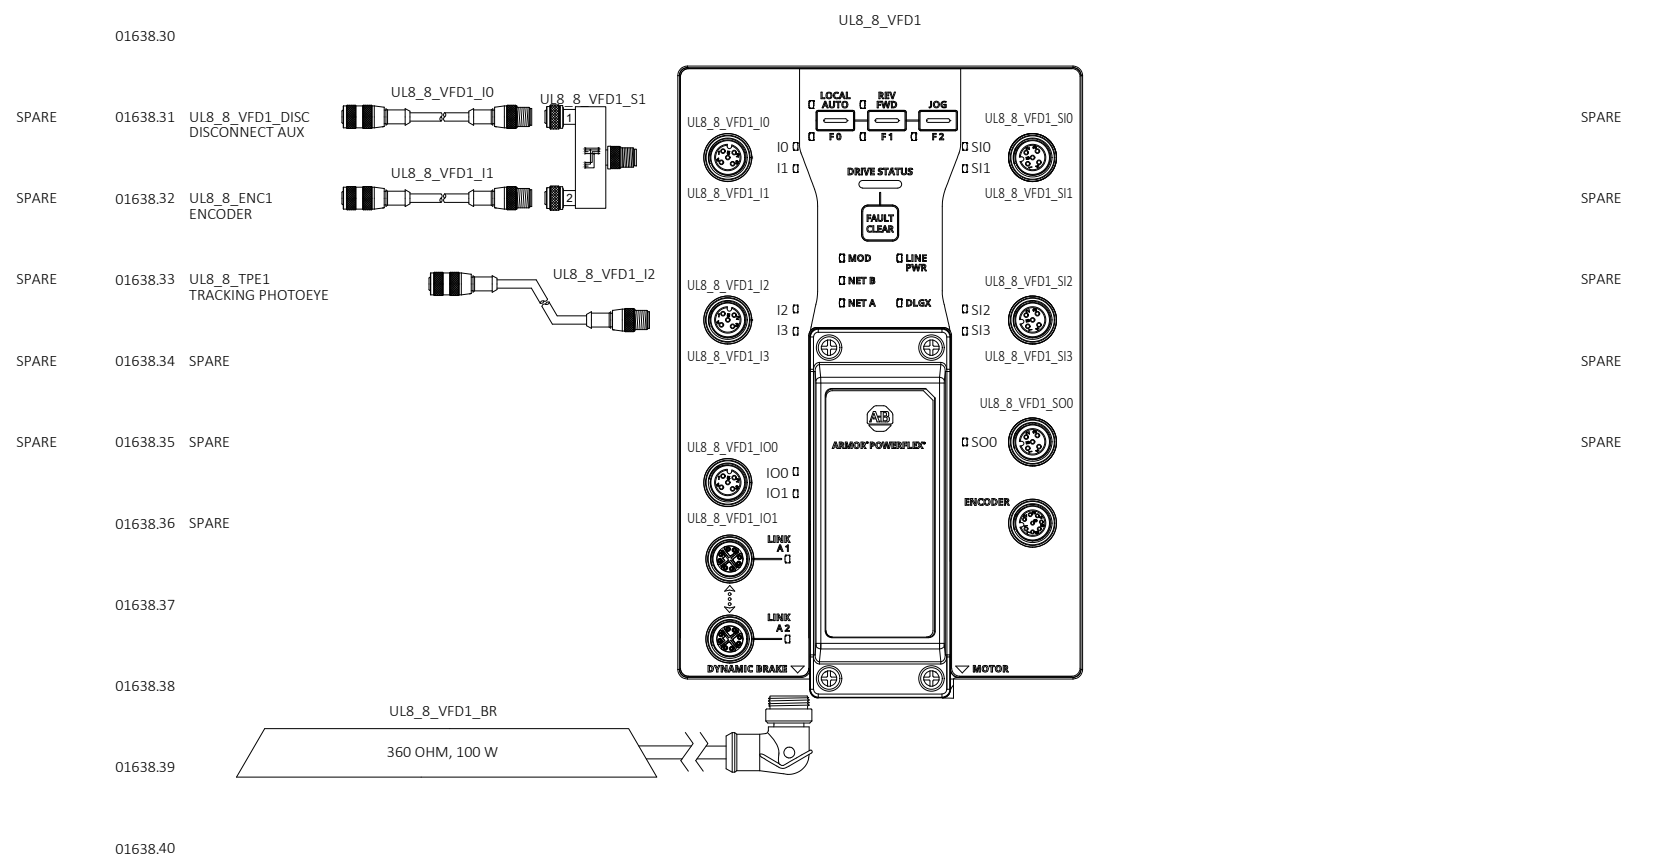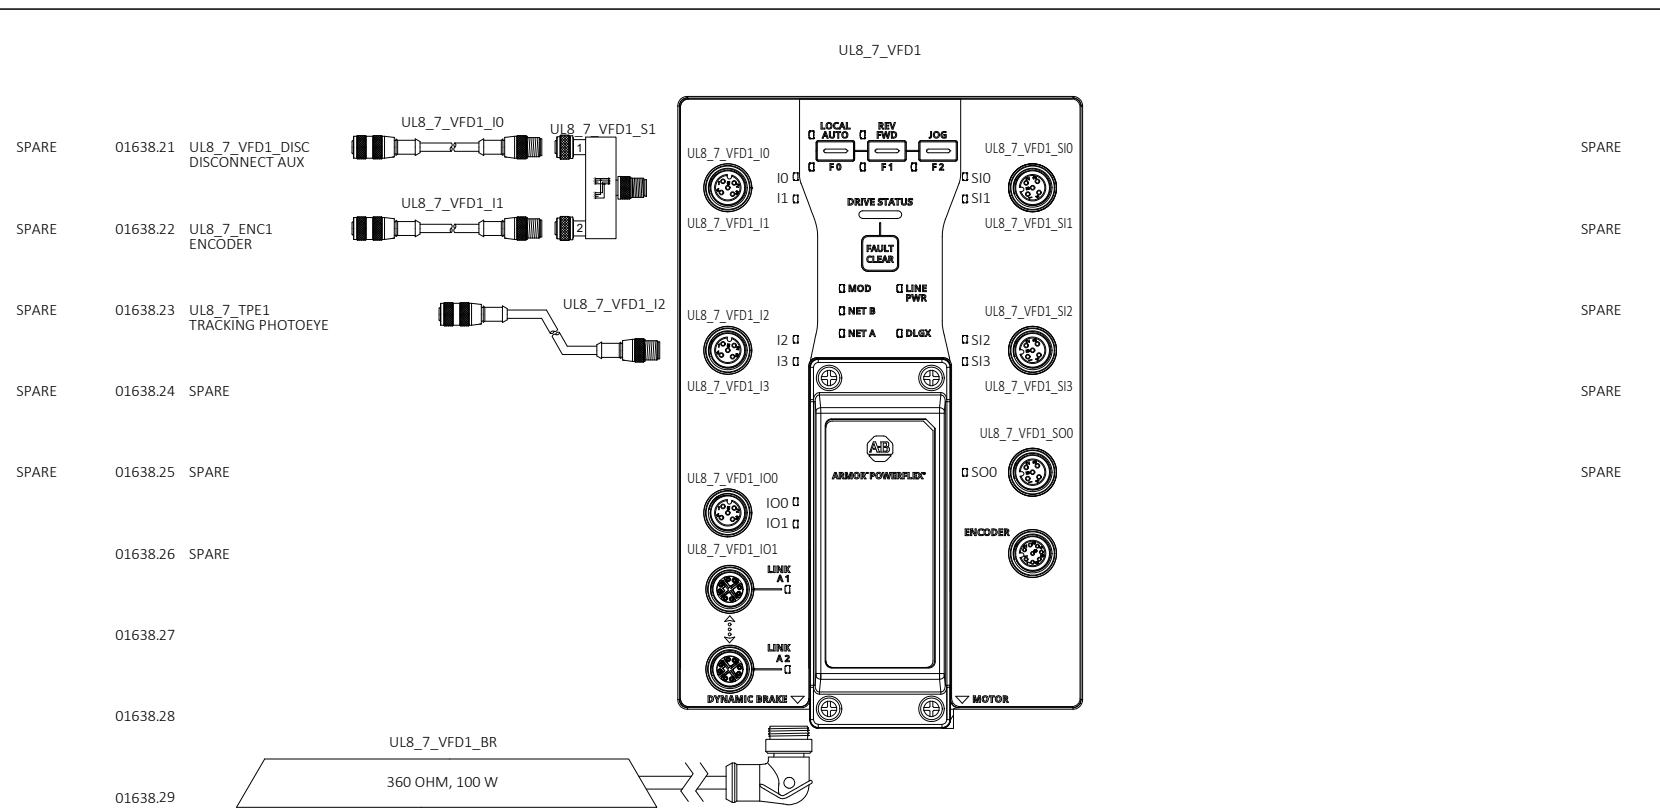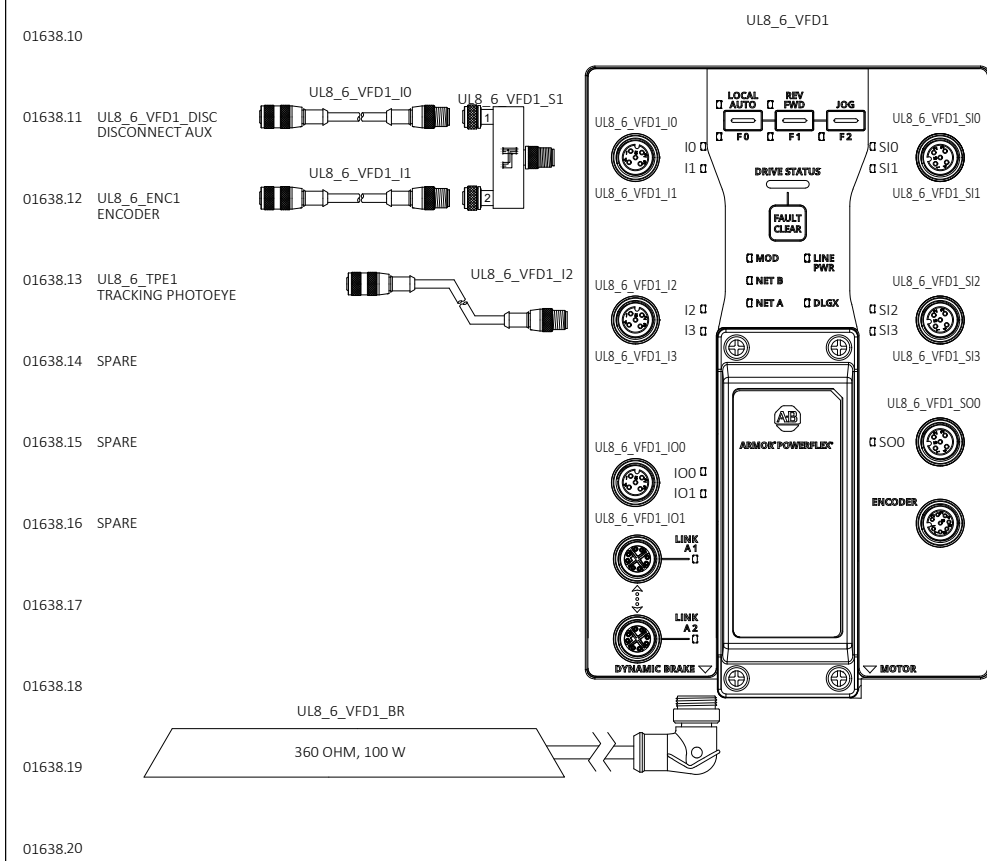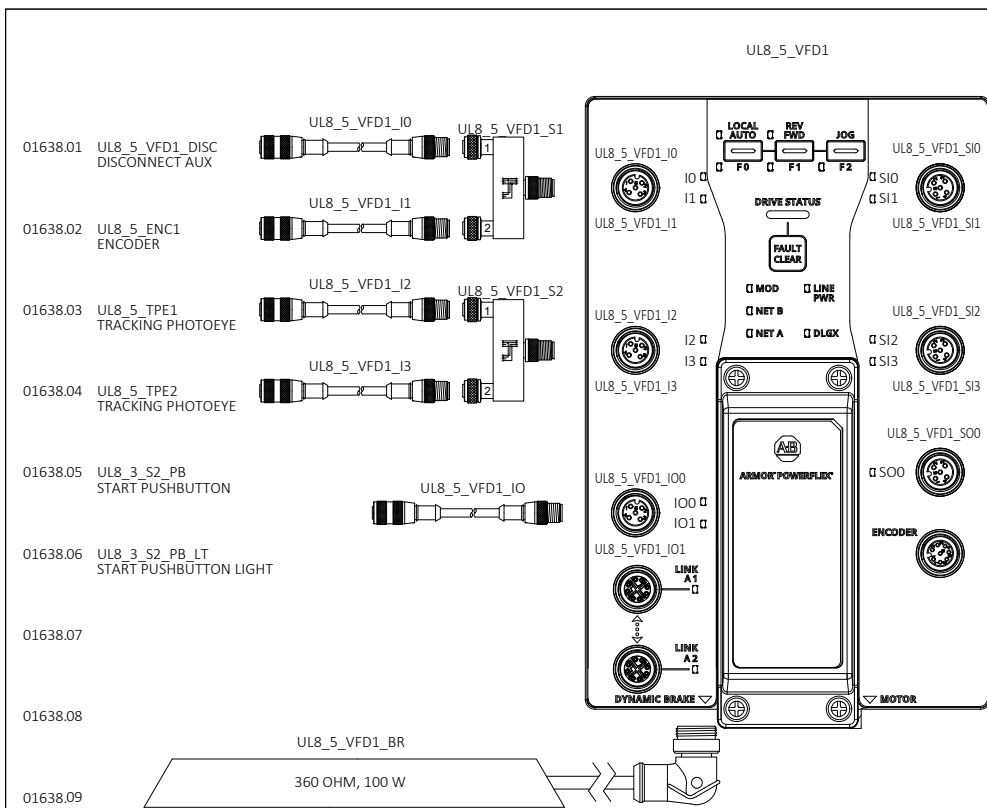


DRAWING REVISIONS				
REV	DESCRIPTION	DATE	BY	
00	INITIAL DRAWINGS	05/09/2025	SK	
01	ALARM HORNS	06/18/2025	SN	
A	AS-BUILT	11/13/2025	LB	




CONFIDENTIAL: THE INFORMATION CONTAINED HEREIN IS PROPRIETARY INFORMATION OF AUTOMATION STANDARD LLC AND CONSTITUTES TRADE SECRETS PURSUANT TO THE UNIFORM TRADE SECRETS ACT. THIS INFORMATION SHALL ONLY BE USED IN THE PERFORMANCE OF CONTRACT WITH AUTSTAND. THIS INFORMATION SHALL NOT BE USED, REPRODUCED OR EMPLOYED IN WHOLE PART, EXCEPT WITH AUTSTAND'S PRIOR WRITTEN APPROVAL.

25K Amazon Cross-Belt Sort Center (ACBSC) UL8_05_VFD1/UL8_06_VFD1/ UL8_07_VFD1/UL8_08_VFD1 IO DRAWINGS
AMAZON MTN6 SPARROWS POINT, MD

FILENAME	
2429-AMZ-MTN6-MCM01-638	
D-SIZE SCALE	JOB NUMBER:
NTS	2429
REVISION	SHEET
A	98

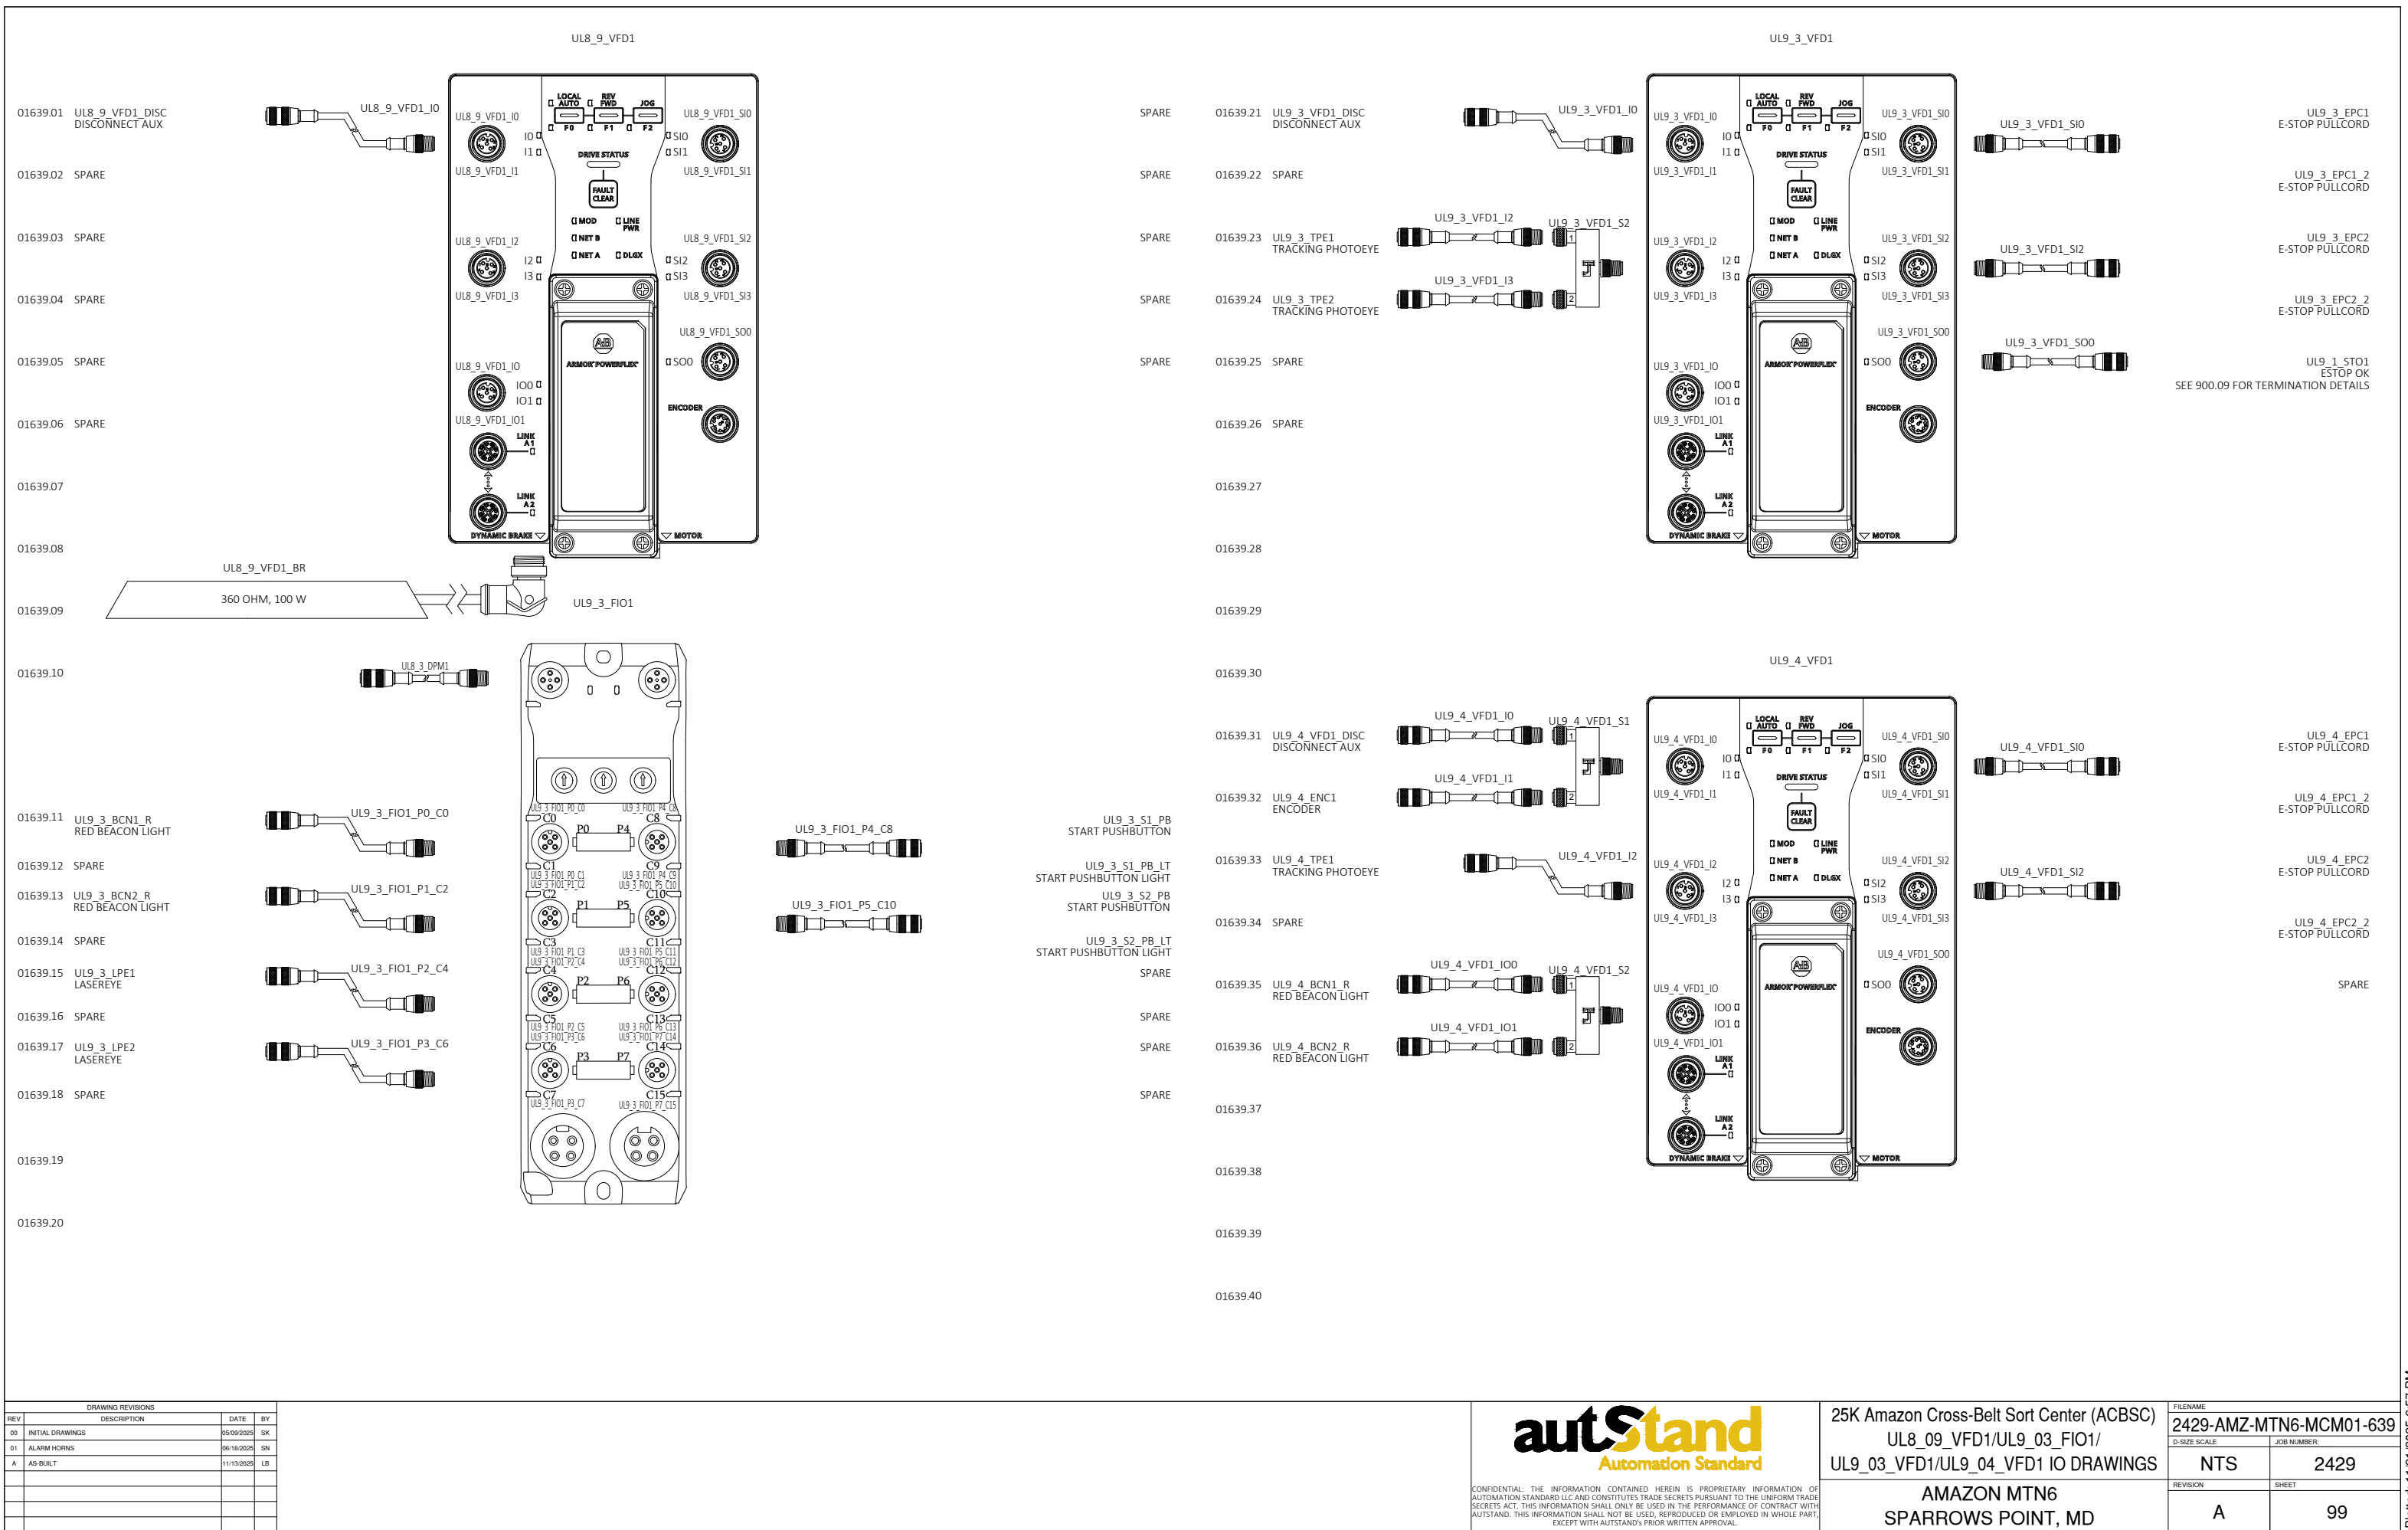

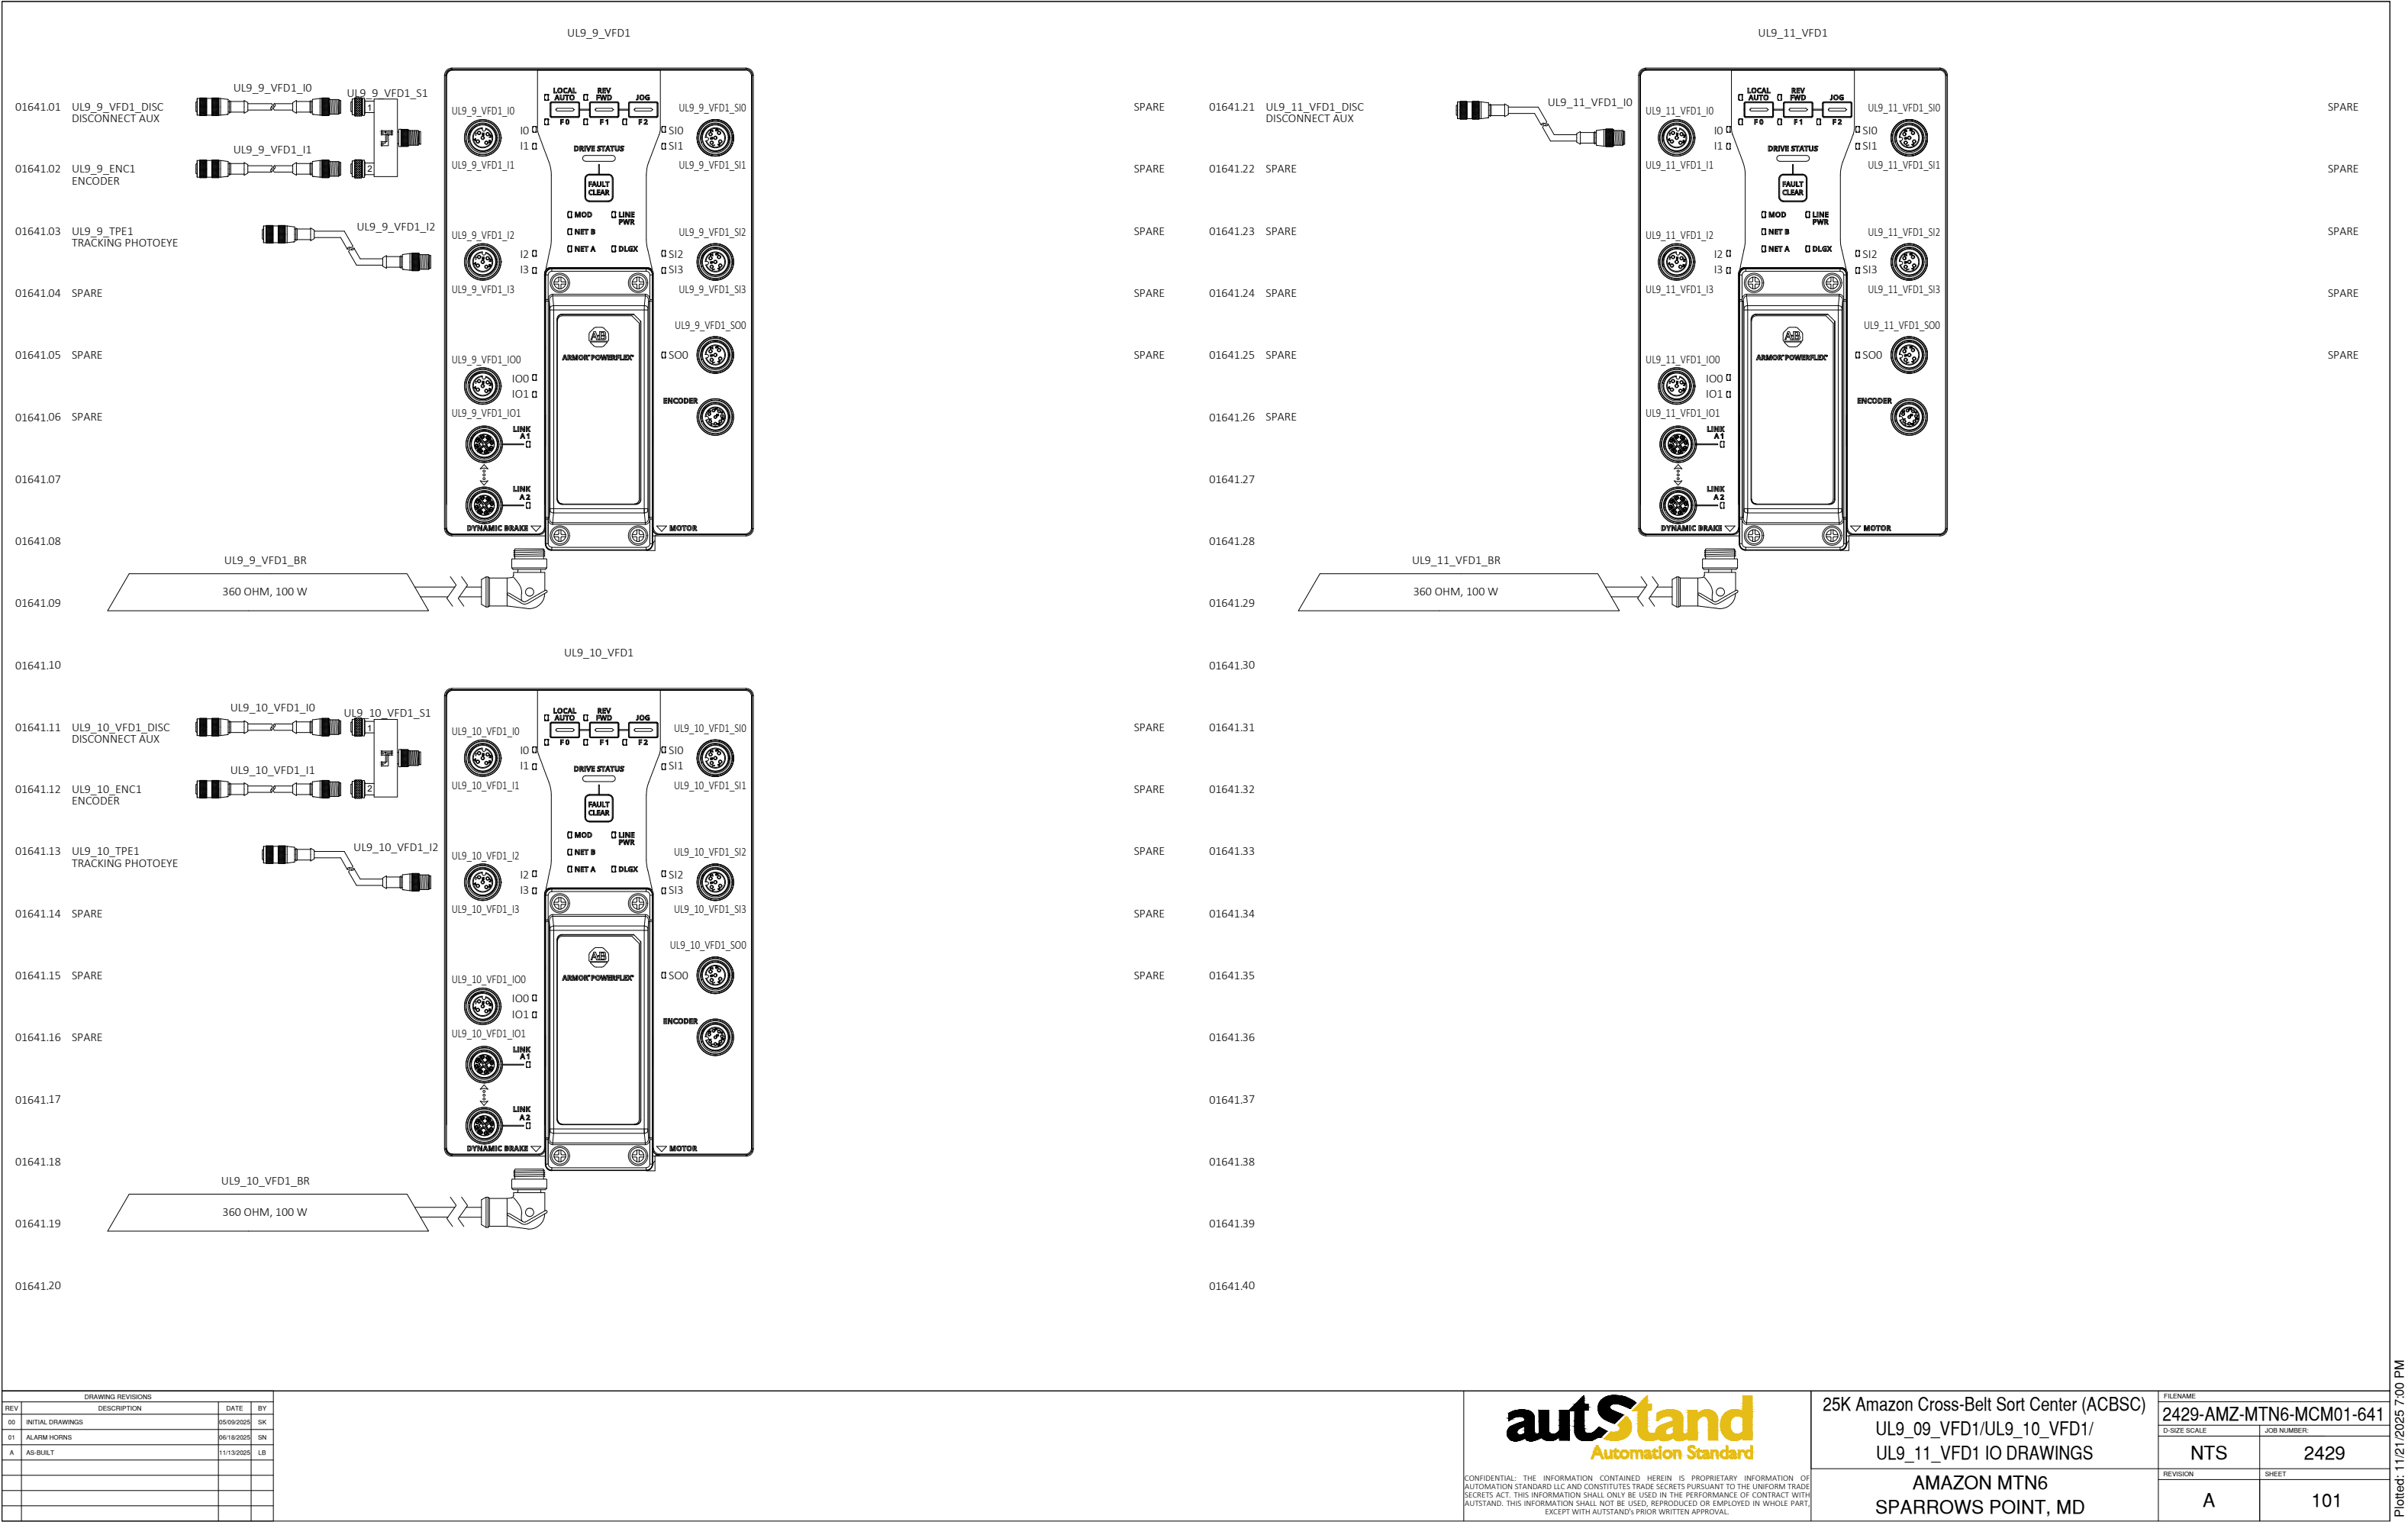

01641.01

UL9_9_VFD1_DISC
DISCONNECT AUX

01641.02

UL9_9_ENC1
ENCODER

01641.03

UL9_9_TPE1
TRACKING PHOTOEYE

01641.04

SPARE

01641.05

SPARE

01641.06

SPARE

01641.07

01641.08

01641.09

UL9_9_VFD1_I0

UL9_9_VFD1_I1

UL9_9_VFD1_I2

UL9_9_VFD1_S1

UL9_9_VFD1_S2

UL9_9_VFD1_S3

UL9_9_VFD1_BR

360 OHM, 100 W

UL9_10_VFD1_I0

UL9_10_VFD1_I1

UL9_10_VFD1_I2

UL9_10_VFD1_S1

UL9_10_VFD1_S2

UL9_10_VFD1_S3

UL9_10_VFD1_BR

360 OHM, 100 W

UL9_11_VFD1_I0

UL9_11_VFD1_I1

UL9_11_VFD1_I2

UL9_11_VFD1_S1

UL9_11_VFD1_S2

UL9_11_VFD1_S3

UL9_11_VFD1_BR

360 OHM, 100 W

UL9_9_VFD1_I0

UL9_9_VFD1_I1

UL9_9_VFD1_I2

UL9_9_VFD1_I3

UL9_9_VFD1_I00

UL9_9_VFD1_I01

LINK A1

LINK A2

DYNAMIC BRAKE

UL9_9_VFD1_S10

UL9_9_VFD1_S11

UL9_9_VFD1_S12

UL9_9_VFD1_S13

UL9_9_VFD1_S00

ENCODER

MOTOR

UL9_10_VFD1_I0

UL9_10_VFD1_I1

UL9_10_VFD1_I2

UL9_10_VFD1_I3

UL9_10_VFD1_I00

UL9_10_VFD1_I01

LINK A1

LINK A2

DYNAMIC BRAKE

UL9_10_VFD1_S10

UL9_10_VFD1_S11

UL9_10_VFD1_S12

UL9_10_VFD1_S13

UL9_10_VFD1_S00

ENCODER

MOTOR

UL9_11_VFD1_I0

UL9_11_VFD1_I1

UL9_11_VFD1_I2

UL9_11_VFD1_I3

UL9_11_VFD1_I00

UL9_11_VFD1_I01

LINK A1

LINK A2

DYNAMIC BRAKE

UL9_11_VFD1_S10

UL9_11_VFD1_S11

UL9_11_VFD1_S12

UL9_11_VFD1_S13

UL9_11_VFD1_S00

ENCODER

MOTOR

01641.21

UL9_11_VFD1_DISC
DISCONNECT AUX

01641.22

SPARE

01641.23

SPARE

01641.24

SPARE

01641.25

SPARE

01641.26

SPARE

01641.27

01641.28

01641.29

01641.30

01641.31

SPARE

01641.32

SPARE

01641.33

SPARE

01641.34

SPARE

01641.35

SPARE

01641.36

01641.37

01641.38

01641.39

01641.40

01641.01

UL9_9_VFD1_DISC
DISCONNECT AUX

01641.02

UL9_9_ENC1
ENCODER

01641.03

UL9_9_TPE1
TRACKING PHOTOEYE

01641.04

SPARE

01641.05

SPARE

01641.06

SPARE

01641.07

01641.08

01641.09

UL9_9_VFD1_I0

UL9_9_VFD1_I1

UL9_9_VFD1_I2

UL9_9_VFD1_S1

UL9_9_VFD1_S2

UL9_9_VFD1_S3

UL9_9_VFD1_BR

360 OHM, 100 W

UL9_10_VFD1_I0

UL9_10_VFD1_I1

UL9_10_VFD1_I2

UL9_10_VFD1_S1

UL9_10_VFD1_S2

UL9_10_VFD1_S3

UL9_10_VFD1_BR

360 OHM, 100 W

UL9_11_VFD1_I0

UL9_11_VFD1_I1

UL9_11_VFD1_I2

UL9_11_VFD1_S1

UL9_11_VFD1_S2

UL9_11_VFD1_S3

UL9_11_VFD1_BR

360 OHM, 100 W

UL9_9_VFD1_I0

UL9_9_VFD1_I1

UL9_9_VFD1_I2

UL9_9_VFD1_I3

UL9_9_VFD1_I00

UL9_9_VFD1_I01

LINK A1

LINK A2

DYNAMIC BRAKE

UL9_9_VFD1_S10

UL9_9_VFD1_S11

UL9_9_VFD1_S12

UL9_9_VFD1_S13

UL9_9_VFD1_S00

ENCODER

MOTOR

UL9_10_VFD1_I0

UL9_10_VFD1_I1

UL9_10_VFD1_I2

UL9_10_VFD1_I3

UL9_10_VFD1_I00

UL9_10_VFD1_I01

LINK A1

LINK A2

DYNAMIC BRAKE

UL9_10_VFD1_S10

UL9_10_VFD1_S11

UL9_10_VFD1_S12

UL9_10_VFD1_S13

UL9_10_VFD1_S00

ENCODER

MOTOR

UL9_11_VFD1_I0

UL9_11_VFD1_I1

UL9_11_VFD1_I2

UL9_11_VFD1_I3

UL9_11_VFD1_I00

UL9_11_VFD1_I01

LINK A1

LINK A2

DYNAMIC BRAKE

UL9_11_VFD1_S10

UL9_11_VFD1_S11

UL9_11_VFD1_S12

UL9_11_VFD1_S13

UL9_11_VFD1_S00

ENCODER

MOTOR

01641.21

UL9_11_VFD1_DISC
DISCONNECT AUX

01641.22

SPARE

01641.23

SPARE

01641.24

SPARE

01641.25

SPARE

01641.26

SPARE

01641.27

01641.28

01641.29

01641.30

01641.31

SPARE

01641.32

SPARE

01641.33

SPARE

01641.34

SPARE

01641.35

SPARE

01641.36

01641.37

01641.38

01641.39

01641.40

DRAWING REVISIONS			
REV	DESCRIPTION	DATE	BY
00	INITIAL DRAWINGS	05/09/2025	SK
01	ALARM HORNS	06/18/2025	SN
A	AS-BUILT	11/13/2025	LB

autStand

Automation Standard

CONFIDENTIAL: THE INFORMATION CONTAINED HEREIN IS PROPRIETARY INFORMATION OF AUTOMATION STANDARD LLC AND CONSTITUTES TRADE SECRETS PURSUANT TO THE UNIFORM TRADE SECRETS ACT. THIS INFORMATION SHALL ONLY BE USED IN THE PERFORMANCE OF CONTRACT WITH AUTISTAND. THIS INFORMATION SHALL NOT BE USED, REPRODUCED OR EMPLOYED IN WHOLE PART, EXCEPT WITH AUTISTAND'S PRIOR WRITTEN APPROVAL.

25K Amazon Cross-Belt Sort Center (ACBSC)	
UL9_09_VFD1/UL9_10_VFD1/ UL9_11_VFD1 IO DRAWINGS	
AMAZON MTN6 SPARROWS POINT, MD	

FILENAME	
2429-AMZ-MTN6-MCM01-641	
D-SIZE SCALE	JOB NUMBER
NTS	2429
REVISION	SHEET
A	101

