


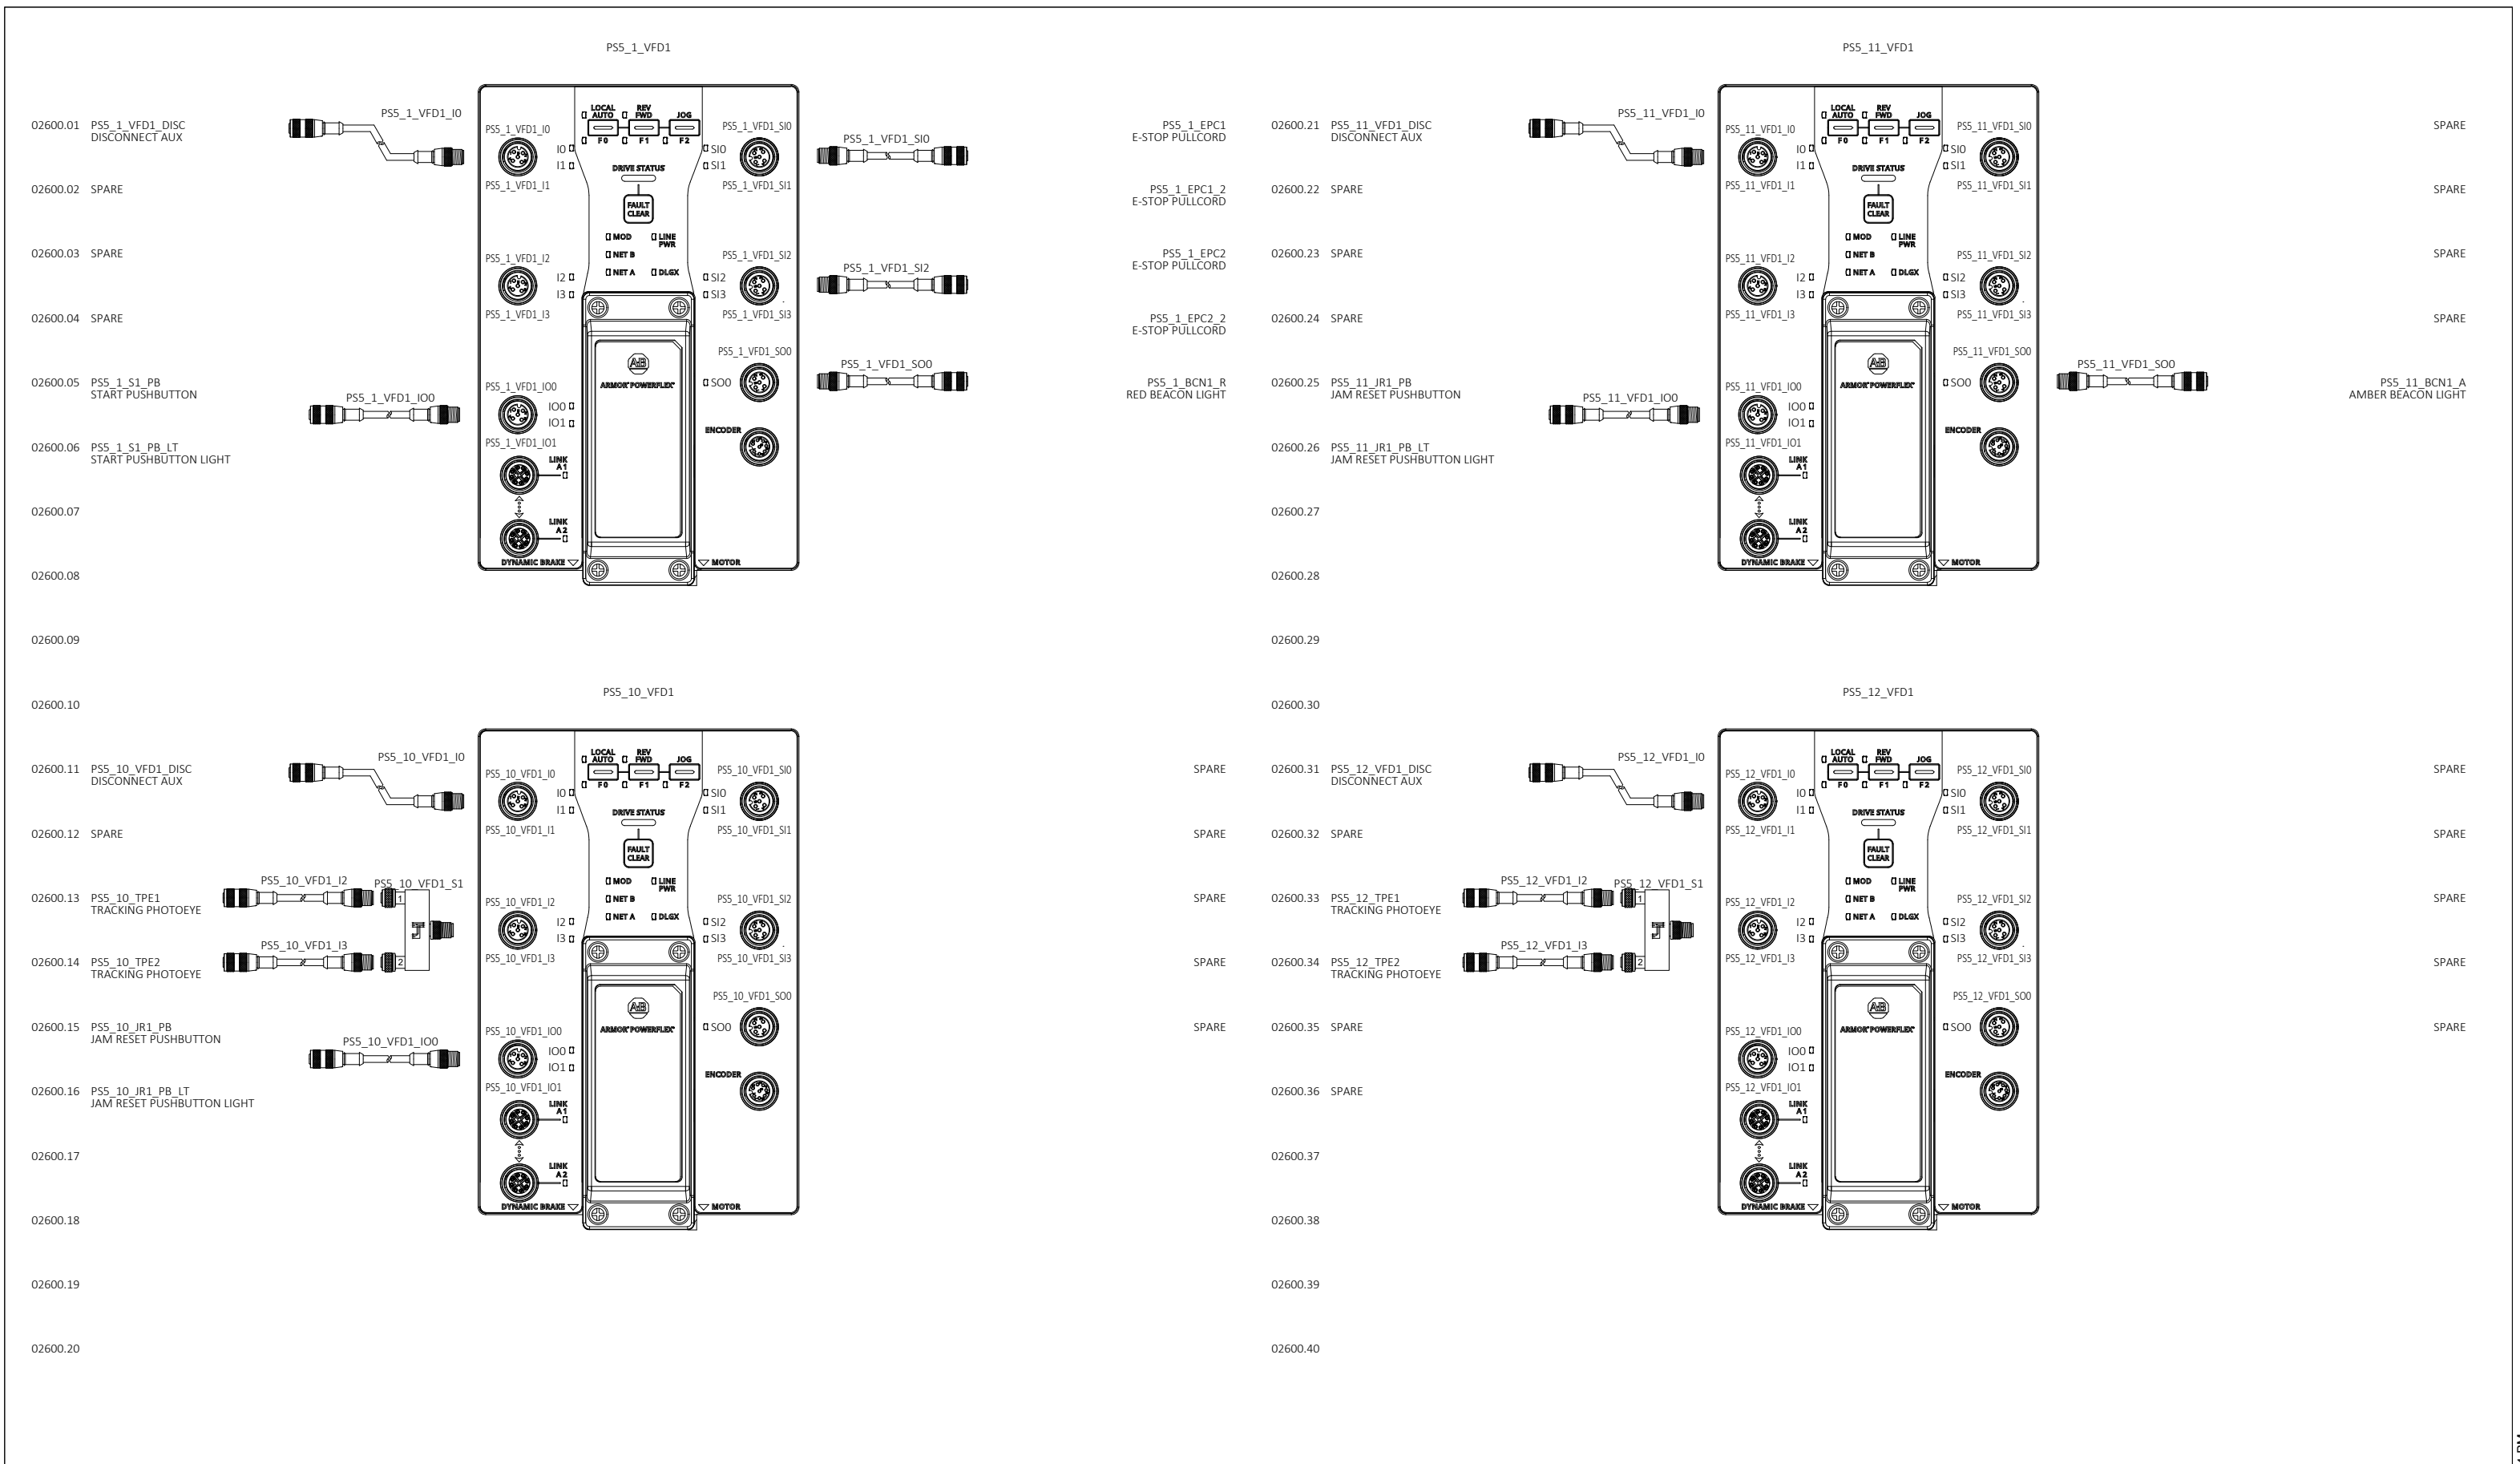
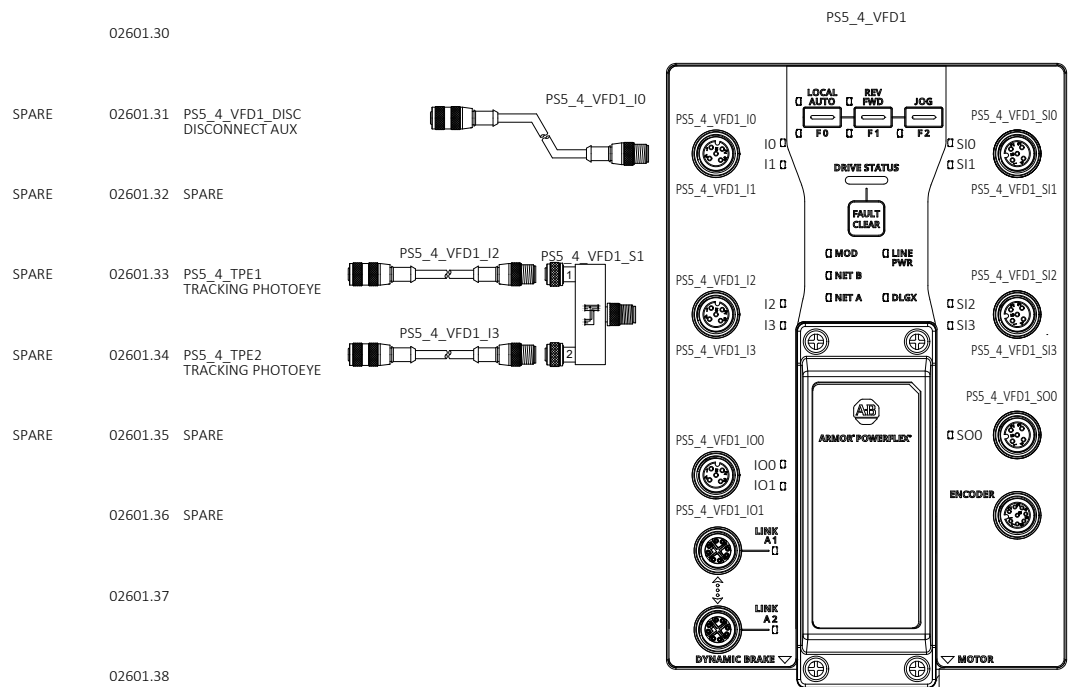


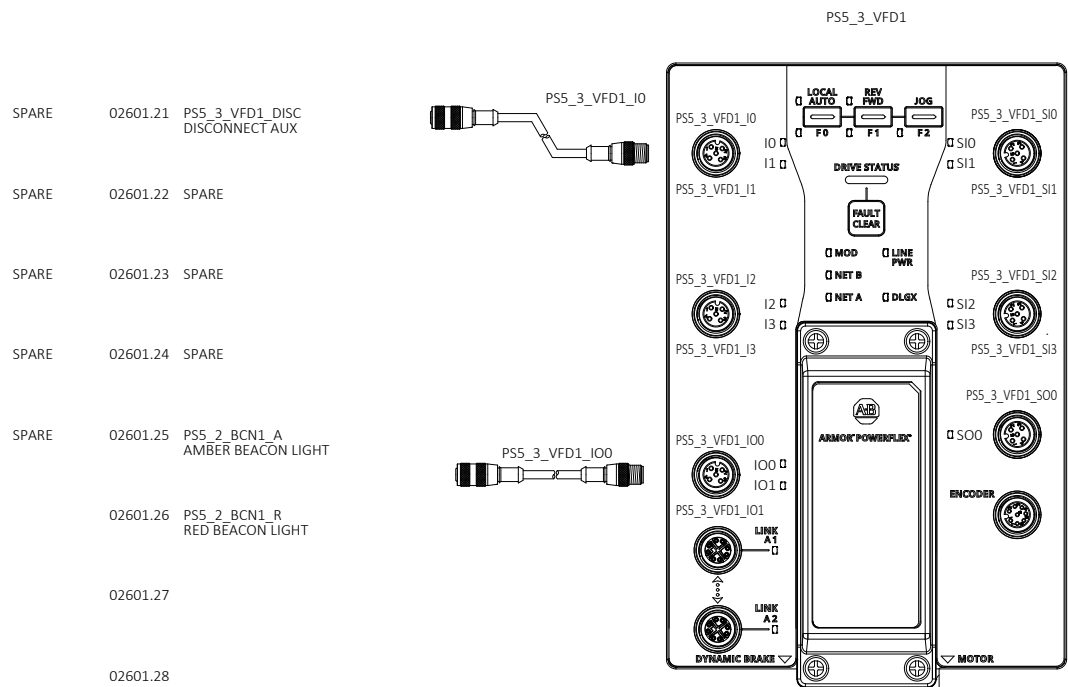

DRAWING REVISIONS				 25K Amazon Cross-Belt Sort Center (ACBSC) PS5_1_VFD1/PS5_10_VFD1/ PS5_11_VFD1/PS5_12_VFD1 IO DRAWINGS AMAZON MTN6 SPARROWS POINT, MD	FILENAME 2429-AMZ-MTN6-MCM02-600	
REV	DESCRIPTION	DATE	BY		D-SIZE SCALE	JOB NUMBER
00	INITIAL DRAWINGS	05/19/2025	SK		NTS	2429
01	ALARM HORN	06/18/2025	SN			
A	AS-BUILT	11/13/2025	LB		REVISION	SHEET
					A	58

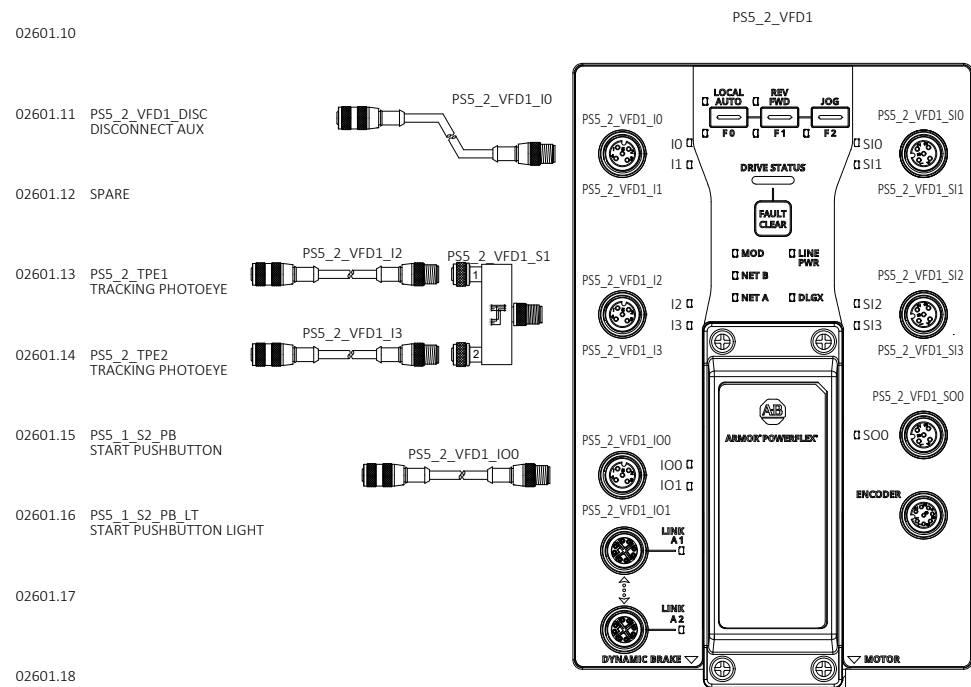

DRAWING REVISIONS			
REV	DESCRIPTION	DATE	BY
00	INITIAL DRAWINGS	05/19/2025	SK
01	ALARM HORN	06/18/2025	SN
A	AS-BUILT	11/13/2025	LB

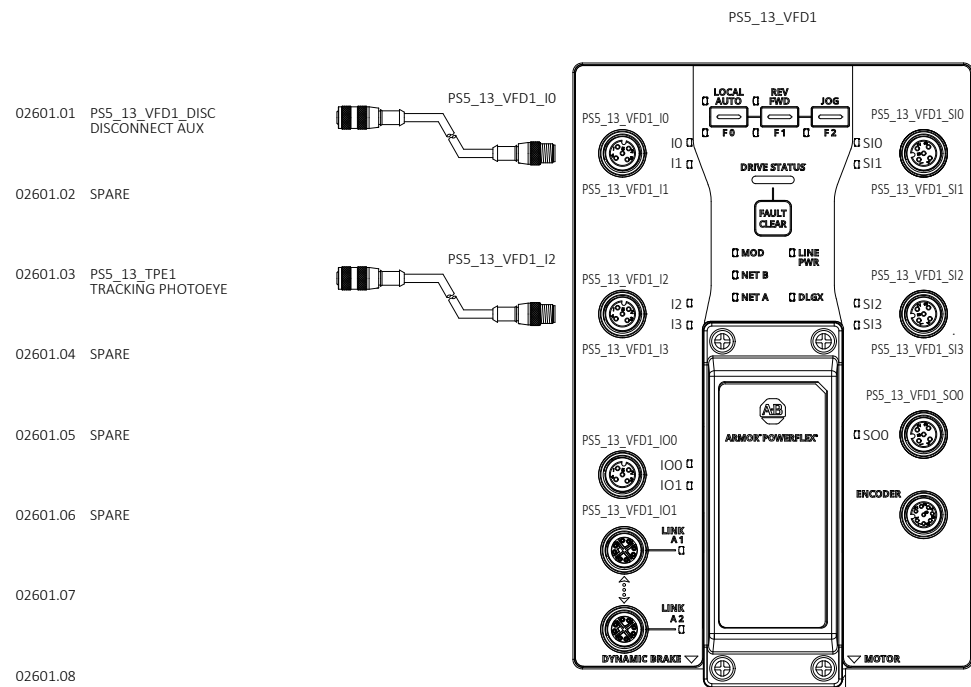

autostand
Automation Standard

CONFIDENTIAL: THE INFORMATION CONTAINED HEREIN IS PROPRIETARY INFORMATION OF AUTOMATION STANDARD LLC AND CONSTITUTES TRADE SECRETS PURSUANT TO THE UNIFORM TRADE SECRETS ACT. THIS INFORMATION SHALL ONLY BE USED IN THE PERFORMANCE OF CONTRACT WITH AUTOSTAND. THIS INFORMATION SHALL NOT BE USED, REPRODUCED OR EMPLOYED IN WHOLE PART, EXCEPT WITH AUTOSTAND'S PRIOR WRITTEN APPROVAL.


25K Amazon Cross-Belt Sort Center (ACBSC) PS5_13_VFD1/PS5_2_VFD1/ PS5_3_VFD1/PS5_4_VFD1 IO DRAWINGS	FILENAME 2429-AMZ-MTN6-MCM02-601	
	D-SIZE SCALE	JOB NUMBER:
	NTS	2429
	AMAZON MTN6 SPARROWS POINT, MD	REVISION A

		PS5_5_VFD1				PS5_7_VFD1					
02602.01	PS5_5_VFD1_DISC DISCONNECT AUX										
02602.02	SPARE			SPARE				SPARE			
02602.03	PS5_5_TPE1 TRACKING PHOTOEYE			SPARE				SPARE			
02602.04	SPARE			SPARE				SPARE			
02602.05	SPARE			SPARE				SPARE			
02602.06	SPARE			SPARE				SPARE			
02602.07		PS5_6_VFD1				PS5_8_VFD1					
02602.08											
02602.09				SPARE				SPARE			
02602.10				SPARE				SPARE			
02602.11	PS5_6_VFD1_DISC DISCONNECT AUX			SPARE				SPARE			
02602.12	SPARE			SPARE				SPARE			
02602.13	SPARE			SPARE				SPARE			
02602.14	SPARE			SPARE				SPARE			
02602.15	PS5_6_JR1_PB JAM RESET PUSHBUTTON										
02602.16	PS5_6_JR1_PB_LT JAM RESET PUSHBUTTON LIGHT										
02602.17											
02602.18											
02602.19											
02602.20											
		PS5_9_VFD1				PS5_10_VFD1					
02602.21	PS5_9_VFD1_DISC DISCONNECT AUX			SPARE				SPARE			
02602.22	SPARE			SPARE				SPARE			
02602.23	PS5_9_TPE1 TRACKING PHOTOEYE			SPARE				SPARE			
02602.24	SPARE			SPARE				SPARE			
02602.25	SPARE			SPARE				SPARE			
02602.26	SPARE			SPARE				SPARE			
02602.27		PS5_11_VFD1				PS5_12_VFD1					
02602.28											
02602.29				SPARE				SPARE			
02602.30				SPARE				SPARE			
02602.31	PS5_8_VFD1_DISC DISCONNECT AUX			SPARE				SPARE			
02602.32	SPARE			SPARE				SPARE			
02602.33	PS5_8_TPE1 TRACKING PHOTOEYE			SPARE				SPARE			
02602.34	PS5_8_TPE2 TRACKING PHOTOEYE			SPARE				SPARE			
02602.35	PS5_9_JR2_PB JAM RESET PUSHBUTTON										
02602.36	PS5_9_JR2_PB_LT JAM RESET PUSHBUTTON LIGHT										
02602.37											
02602.38											
02602.39											
02602.40											
		PS5_13_VFD1				PS5_14_VFD1					
02602.41	PS5_13_VFD1_DISC DISCONNECT AUX			SPARE				SPARE			
02602.42	SPARE			SPARE				SPARE			
02602.43	PS5_13_TPE1 TRACKING PHOTOEYE			SPARE				SPARE			
02602.44	SPARE			SPARE				SPARE			
02602.45	SPARE			SPARE				SPARE			
02602.46	SPARE			SPARE				SPARE			
		PS5_15_VFD1				PS5_16_VFD1					
02602.47	PS5_15_VFD1_DISC DISCONNECT AUX			SPARE				SPARE			
02602.48	SPARE			SPARE				SPARE			
02602.49	PS5_15_TPE1 TRACKING PHOTOEYE			SPARE				SPARE			
02602.50	SPARE			SPARE				SPARE			
02602.51	SPARE			SPARE				SPARE			
02602.52	SPARE			SPARE				SPARE			
		PS5_17_VFD1				PS5_18_VFD1					
02602.53	PS5_17_VFD1_DISC DISCONNECT AUX			SPARE				SPARE			
02602.54	SPARE			SPARE				SPARE			
02602.55	PS5_17_TPE1 TRACKING PHOTOEYE			SPARE				SPARE			
02602.56	SPARE			SPARE				SPARE			
02602.57	SPARE			SPARE				SPARE			
02602.58	SPARE			SPARE				SPARE			
		PS5_19_VFD1				PS5_20_VFD1					
02602.59	PS5_19_VFD1_DISC DISCONNECT AUX			SPARE				SPARE			
02602.60	SPARE			SPARE				SPARE			
02602.61	PS5_19_TPE1 TRACKING PHOTOEYE			SPARE				SPARE			
02602.62	SPARE			SPARE				SPARE			
02602.63	SPARE			SPARE				SPARE			
02602.64	SPARE			SPARE				SPARE			
		PS5_21_VFD1				PS5_22_VFD1					
02602.65	PS5_21_VFD1_DISC DISCONNECT AUX			SPARE				SPARE			
02602.66	SPARE			SPARE				SPARE			
02602.67	PS5_21_TPE1 TRACKING PHOTOEYE			SPARE				SPARE			
02602.68	SPARE			SPARE				SPARE			
02602.69	SPARE			SPARE				SPARE			
02602.70	SPARE			SPARE				SPARE			
		PS5_23_VFD1				PS5_24_VFD1					
02602.71	PS5_23_VFD1_DISC DISCONNECT AUX			SPARE				SPARE			
02602.72	SPARE			SPARE				SPARE			
02602.73	PS5_23_TPE1 TRACKING PHOTOEYE			SPARE				SPARE			
02602.74	SPARE			SPARE				SPARE			
02602.75	SPARE			SPARE				SPARE			
02602.76	SPARE			SPARE				SPARE			
		PS5_25_VFD1				PS5_26_VFD1					
02602.77	PS5_25_VFD1_DISC DISCONNECT AUX			SPARE				SPARE			
02602.78	SPARE			SPARE				SPARE			
02602.79	PS5_25_TPE1 TRACKING PHOTOEYE			SPARE				SPARE			
02602.80	SPARE			SPARE				SPARE			
02602.81	SPARE			SPARE				SPARE			
02602.82	SPARE			SPARE				SPARE			
		PS5_27_VFD1				PS5_28_VFD1					
02602.83	PS5_27_VFD1_DISC DISCONNECT AUX			SPARE				SPARE			
02602.84	SPARE			SPARE				SPARE			
02602.85	PS5_27_TPE1 TRACKING PHOTOEYE			SPARE				SPARE			
02602.86	SPARE			SPARE				SPARE			
02602.87	SPARE			SPARE				SPARE			
02602.88	SPARE			SPARE				SPARE			
		PS5_29_VFD1				PS5_30_VFD1					
02602.89	PS5_29_VFD1_DISC DISCONNECT AUX			SPARE				SPARE			
02602.90	SPARE			SPARE				SPARE			
02602.91	PS5_29_TPE1 TRACKING PHOTOEYE			SPARE				SPARE			
02602.92	SPARE			SPARE				SPARE			
02602.93	SPARE			SPARE				SPARE			
02602.94	SPARE			SPARE				SPARE			
		PS5_31_VFD1				PS5_32_VFD1					
02602.95	PS5_31_VFD1_DISC DISCONNECT AUX			SPARE				SPARE			
02602.96	SPARE			SPARE				SPARE			
02602.97	PS5_31_TPE1 TRACKING PHOTOEYE			SPARE				SPARE			
02602.98											





DRAWING REVISIONS			
REV	DESCRIPTION	DATE	BY
00	INITIAL DRAWINGS	05/19/2025	SK
01	ALARM HORN	06/18/2025	SN
A	AS-BUILT	11/13/2025	LB

	25K Amazon Cross-Belt Sort Center (ACBSC) PS5_5_VFD1/PS5_6_VFD1/ PS5_7_VFD1/PS5_8_VFD1 IO DRAWINGS	FILENAME 2429-AMZ-MTN6-MCM02-602
	AMAZON MTN6 SPARROWS POINT, MD	D-SIZE SCALE NTS
	CONFIDENTIAL: THE INFORMATION CONTAINED HEREIN IS PROPRIETARY INFORMATION OF AUTOMATION STANDARD LLC AND CONSTITUTES TRADE SECRETS PURSUANT TO THE UNIFORM TRADE SECRETS ACT. THIS INFORMATION SHALL ONLY BE USED IN THE PERFORMANCE OF CONTRACT WITH AUTSTAND. THIS INFORMATION SHALL NOT BE USED, REPRODUCED OR EMPLOYED IN WHOLE PART, EXCEPT WITH AUTSTAND'S PRIOR WRITTEN APPROVAL.	JOB NUMBER: 2429
		REVISION A
		SHEET 60


lotted: 11/21/2025 9:14 PM

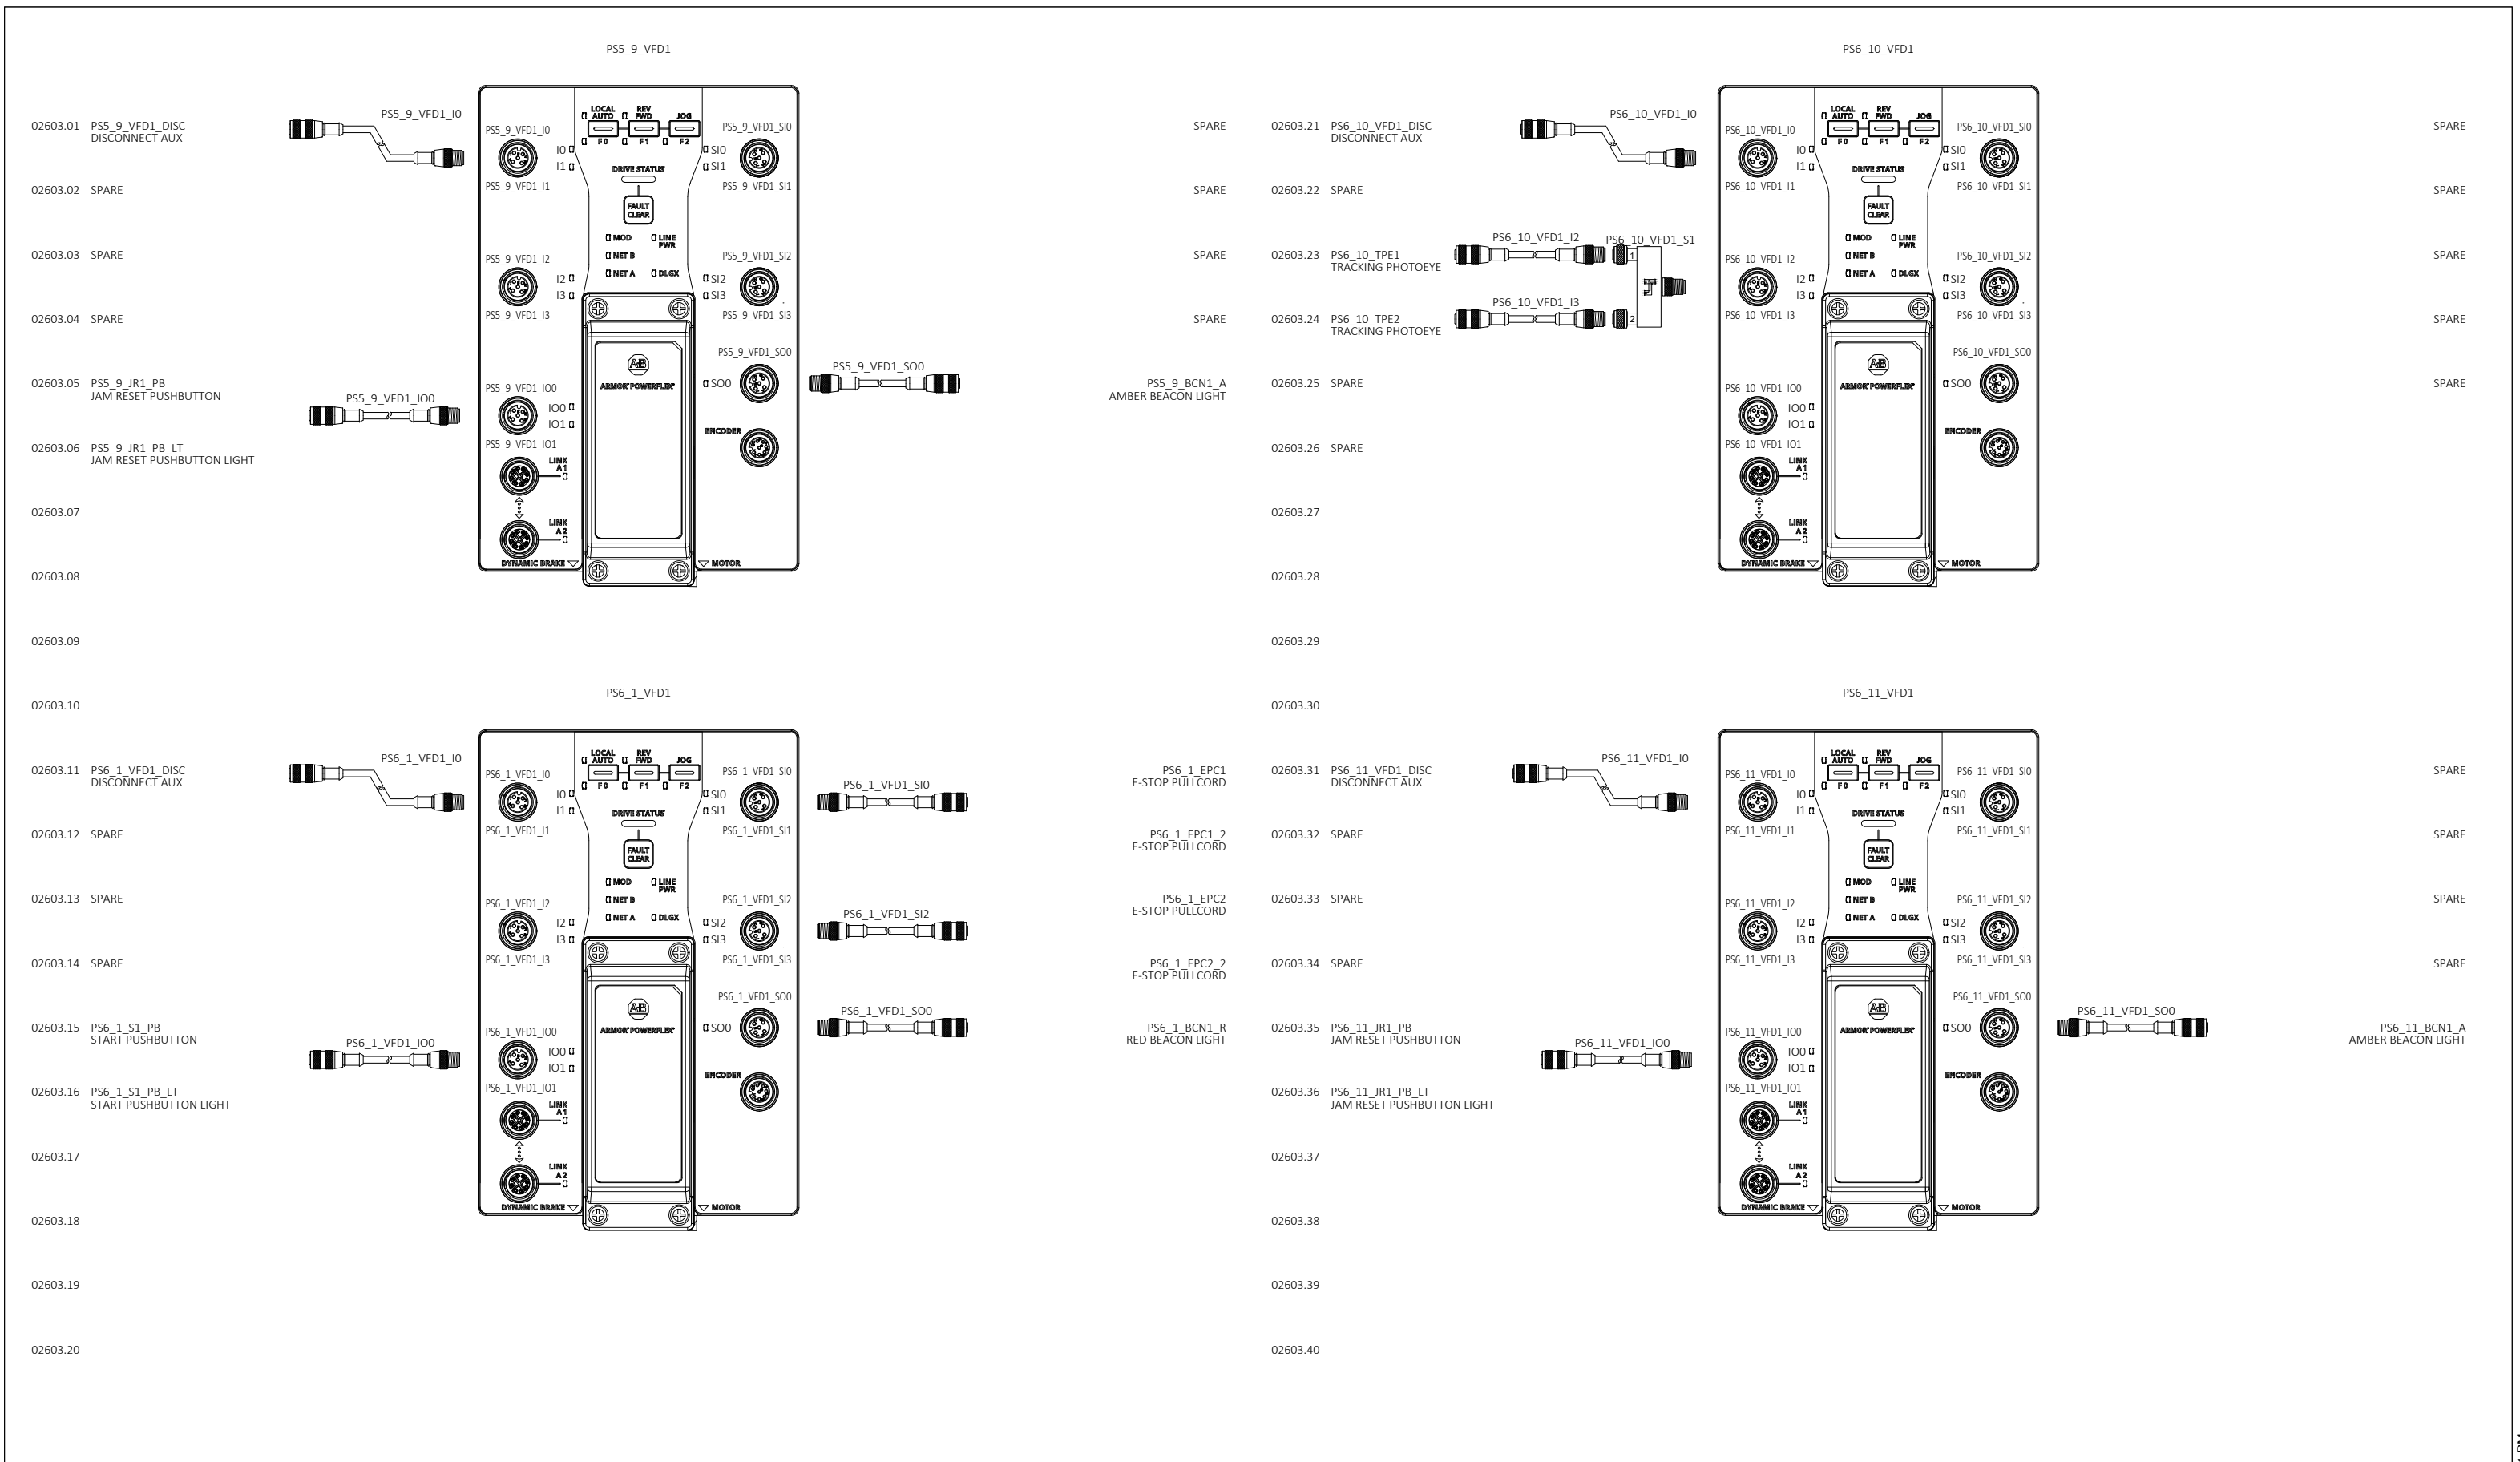





DRAWING REVISIONS				 CONFIDENTIAL: THE INFORMATION CONTAINED HEREIN IS PROPRIETARY INFORMATION OF AUTOMATION STANDARD LLC AND CONSTITUTES TRADE SECRETS PURSUANT TO THE UNIFORM TRADE SECRETS ACT. THIS INFORMATION SHALL ONLY BE USED IN THE PERFORMANCE OF CONTRACT WITH AUTOSTAND. THIS INFORMATION SHALL NOT BE USED, REPRODUCED OR EMPLOYED IN WHOLE PART, EXCEPT WITH AUTOSTAND'S PRIOR WRITTEN APPROVAL.	25K Amazon Cross-Belt Sort Center (ACBSC) PS5_9_VFD1/PS6_1_VFD1/ PS6_10_VFD1/PS6_11_VFD1 IO DRAWINGS AMAZON MTN6 SPARROWS POINT, MD	FILENAME 2429-AMZ-MTN6-MCM02-603	
REV	DESCRIPTION	DATE	BY			D-SIZE SCALE	JOB NUMBER:
00	INITIAL DRAWINGS	05/19/2025	SK			NTS	2429
01	ALARM HORN	06/18/2025	SN				
A	AS-BUILT	11/13/2025	LB			REVISION	SHEET
						A	61

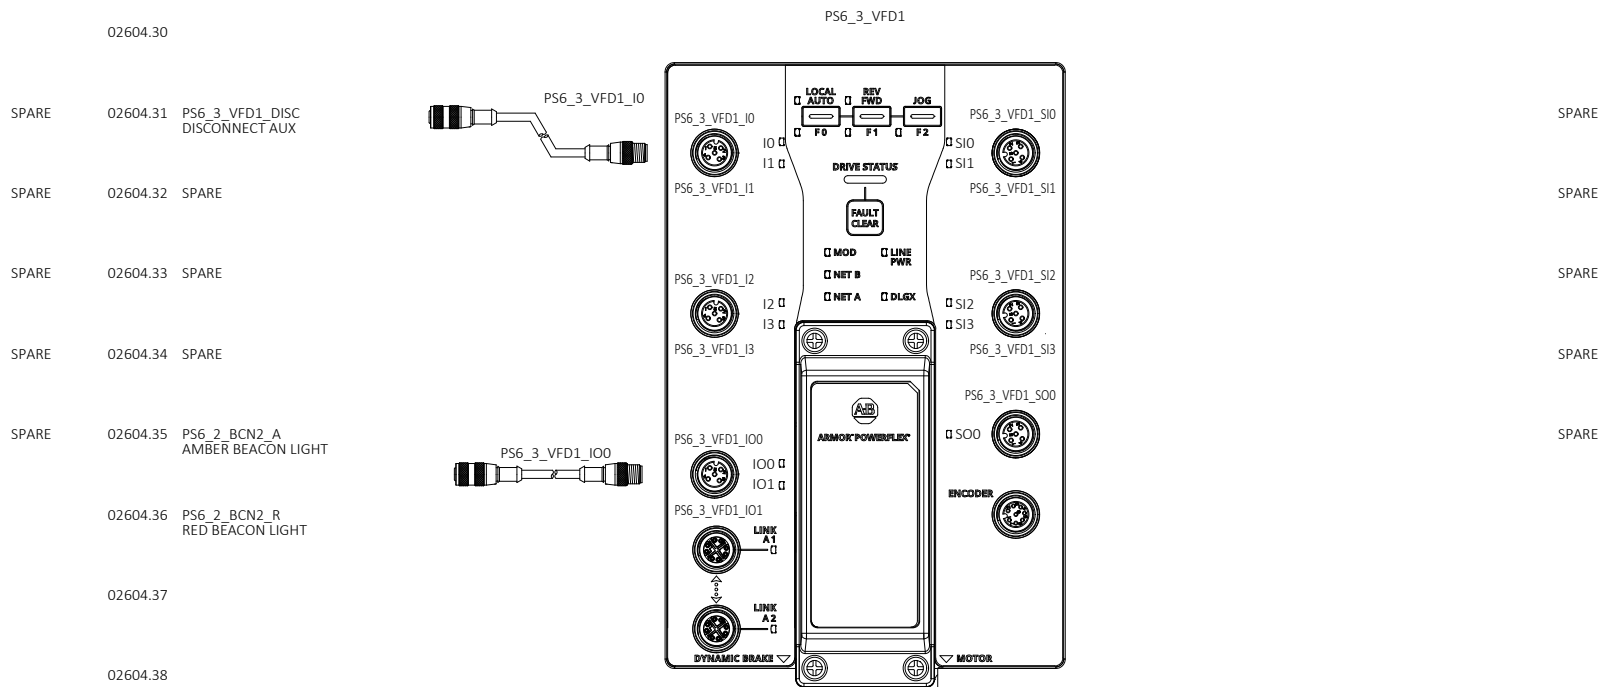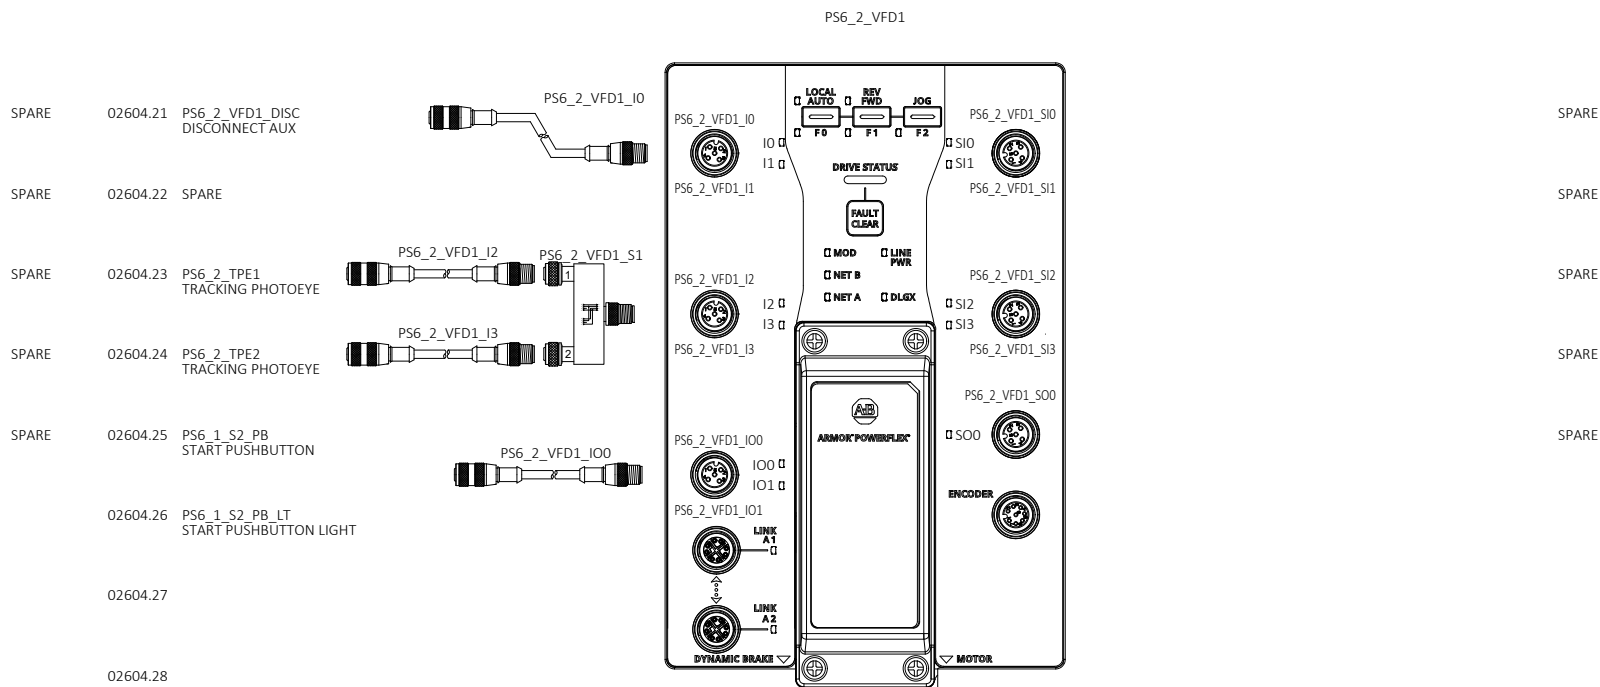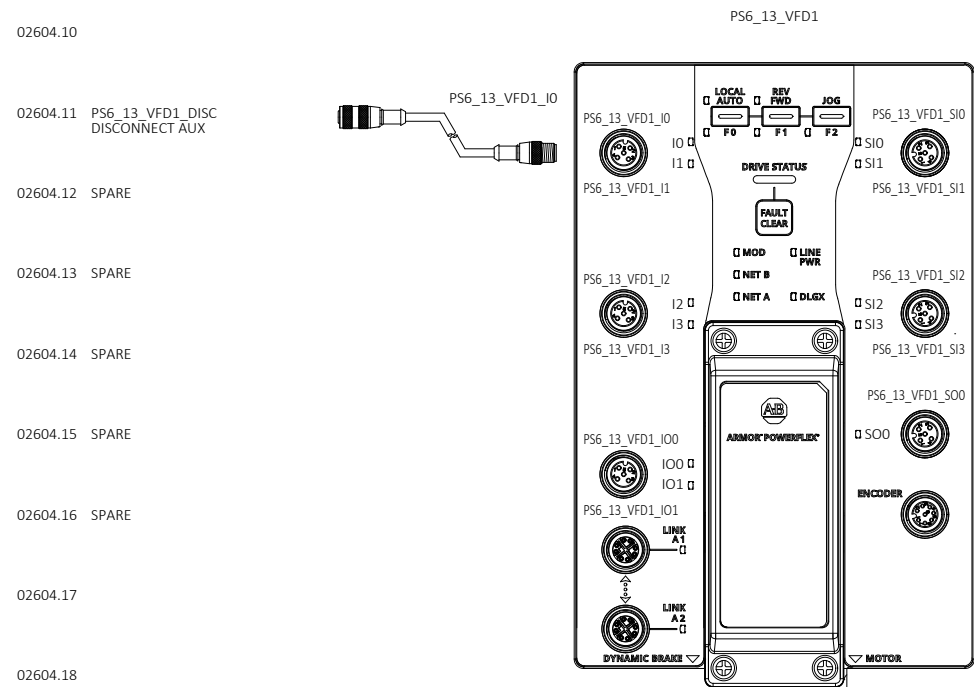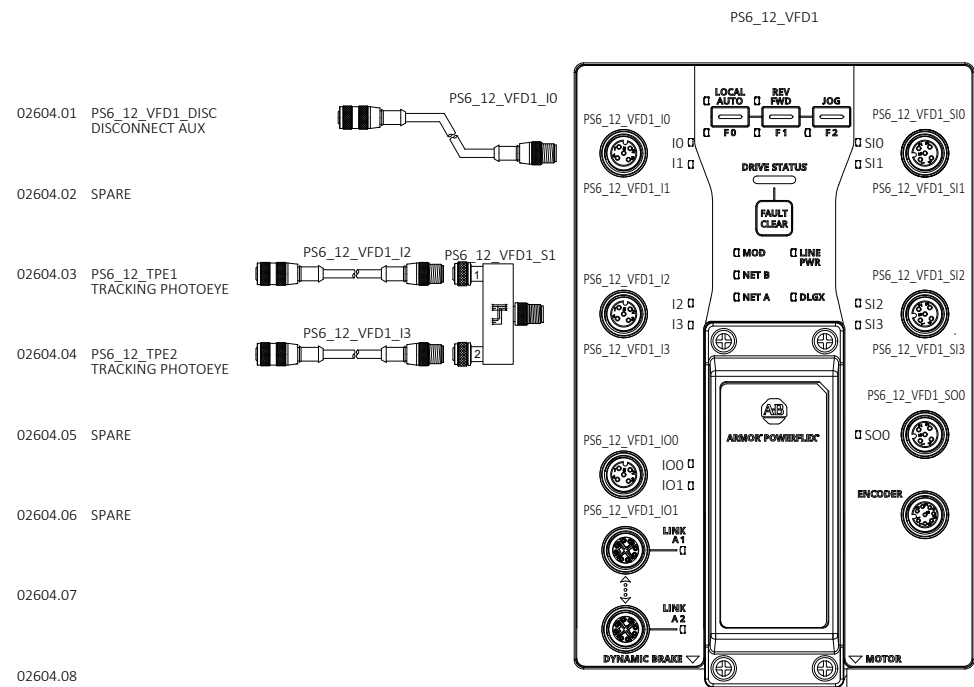

DRAWING REVISIONS			
REV	DESCRIPTION	DATE	BY
00	INITIAL DRAWINGS	05/19/2025	SK
01	ALARM HORN	06/18/2025	SN
A	AS-BUILT	11/13/2025	LB

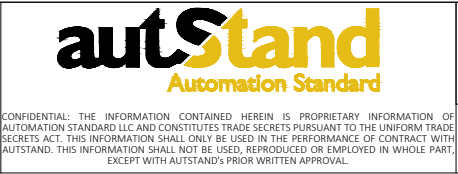

25K Amazon Cross-Belt Sort Center (ACBSC) PS6_12_VFD1/PS6_13_VFD1/ PS6_2_VFD1/PS6_3_VFD1 IO DRAWINGS AMAZON MTN6 SPARROWS POINT, MD	FILENAME 2429-AMZ-MTN6-MCM02-604	
	D-SIZE SCALE NTS	JOB NUMBER: 2429
	REVISION A	SHEET 62

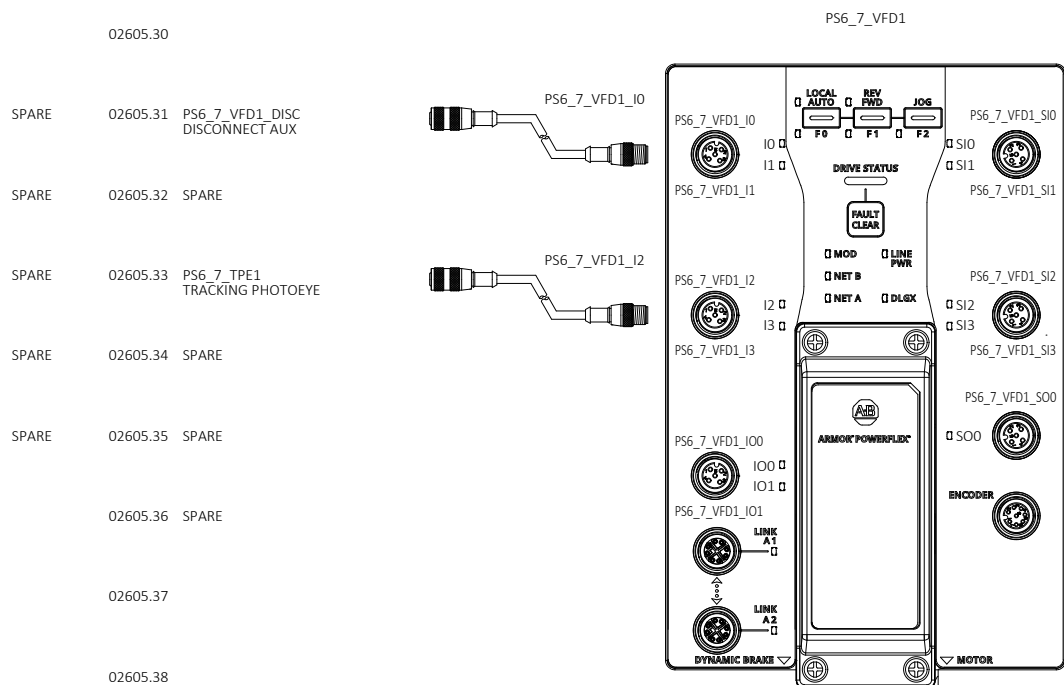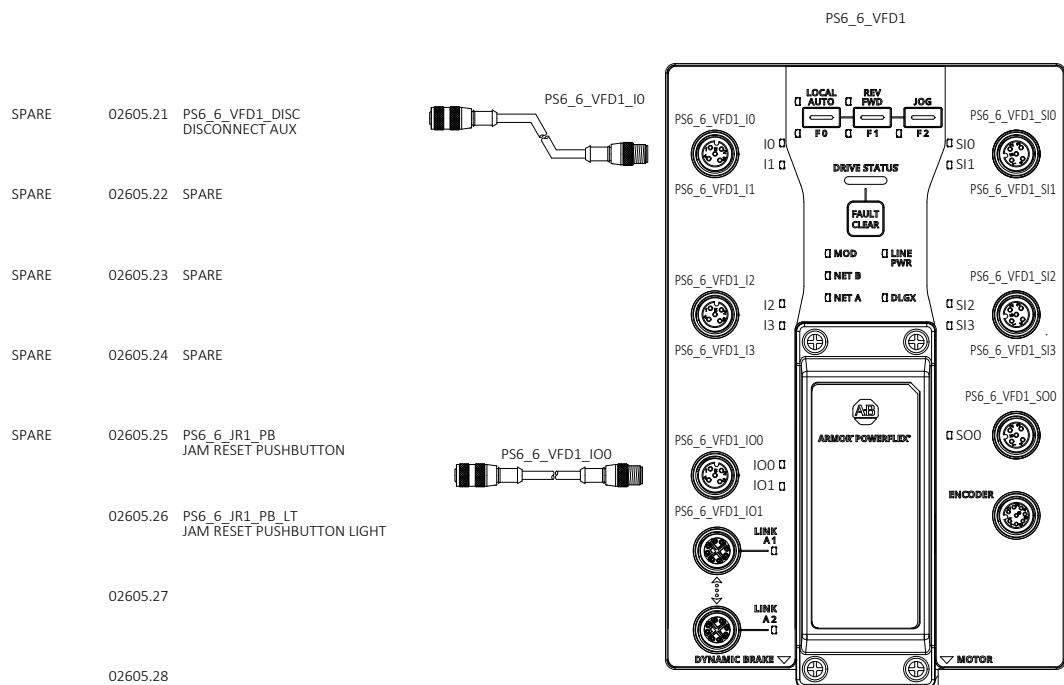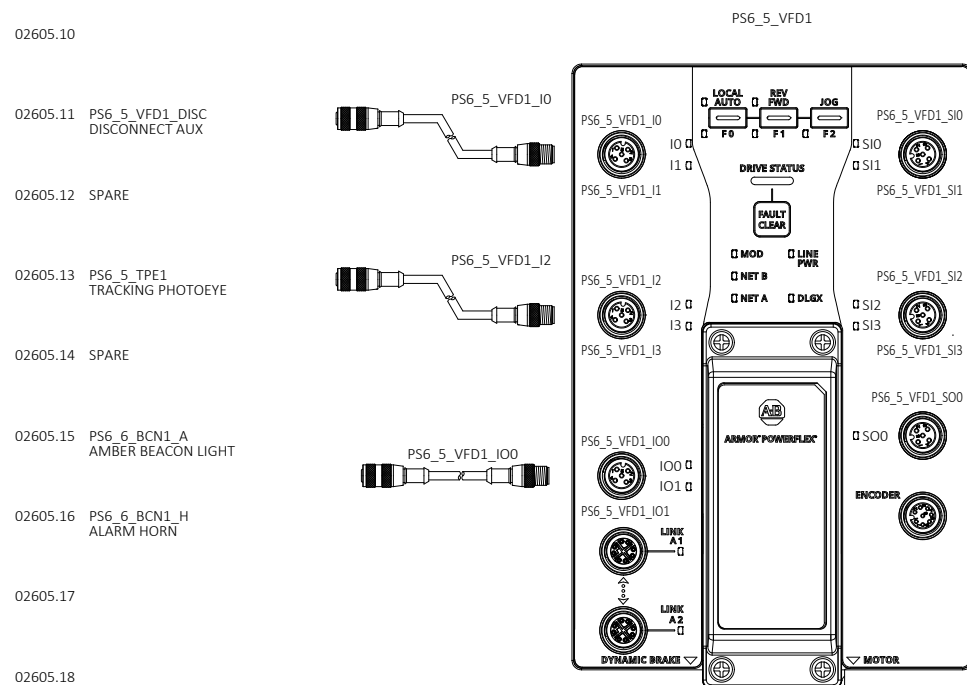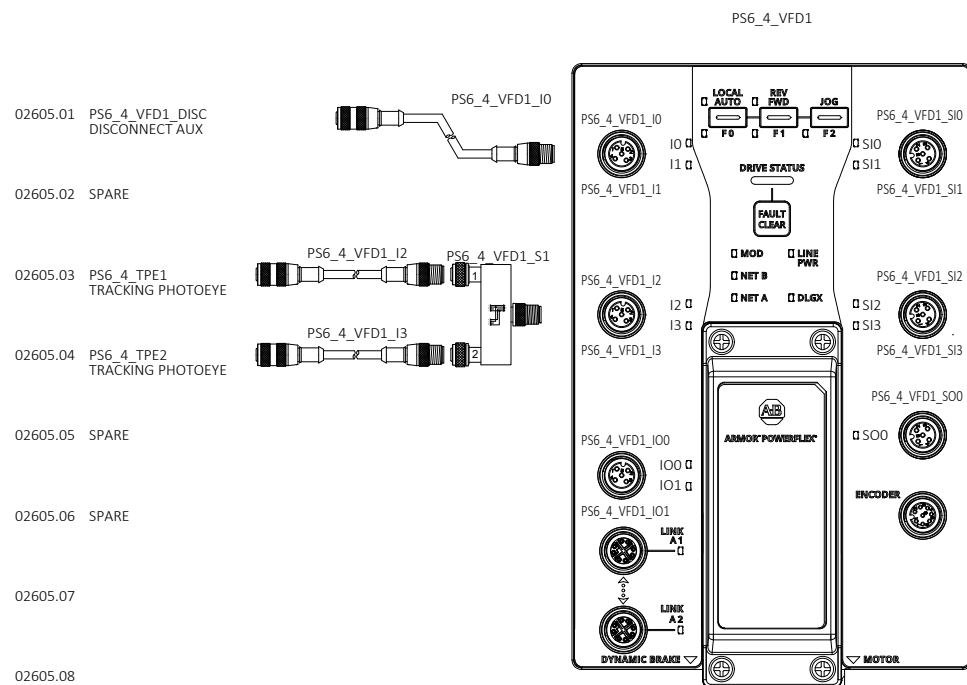

DRAWING REVISIONS			
REV	DESCRIPTION	DATE	BY
00	INITIAL DRAWINGS	05/19/2025	SK
01	ALARM HORN	06/18/2025	SN
A	AS-BUILT	11/13/2025	LB



CONFIDENTIAL: THE INFORMATION CONTAINED HEREIN IS PROPRIETARY INFORMATION OF AUTOSTAND INFORMATION STANDARD LLC AND CONSTITUTES TRADE SECRETS PURSUANT TO THE UNIFORM TRADE SECRETS ACT. THIS INFORMATION SHALL ONLY BE USED IN THE PERFORMANCE OF CONTRACT WITH AUTOSTAND. THIS INFORMATION SHALL NOT BE USED, REPRODUCED OR EMPLOYED IN WHOLE PART, EXCEPT WITH AUTOSTAND'S PRIOR WRITTEN APPROVAL.





25K Amazon Cross-Belt Sort Center (ACBSC)
PS6_4_VFD1/PS6_5_VFD1/
PS6 6 VFD1/PS6 7 VFD1 IO DRAWINGS

AMAZON MTN6
SPARROWS POINT, MD


FILENAME	
2429-AMZ-MTN6-MCM02-605	
D-SIZE SCALE	JOB NUMBER:
NTS	2429
REVISION	SHEET
A	63

[illegible]

		PS7_11_VFD1				PS7_13_VFD1	
02607.01	PS7_11_VFD1_DISC DISCONNECT AUX						
02607.02	SPARE						
02607.03	PS7_12_TPE1 TRACKING PHOTOEYE						
02607.04	SPARE						
02607.05	PS7_11_JR1_PB JAM RESET PUSHBUTTON						
02607.06	PS7_11_JR1_PB_LT JAM RESET PUSHBUTTON LIGHT						
02607.07							
02607.08							
02607.09							
02607.10				PS7_12_VFD1			
02607.11	PS7_12_VFD1_DISC DISCONNECT AUX						
02607.12	SPARE						
02607.13	PS7_12_TPE2 TRACKING PHOTOEYE						
02607.14	SPARE						
02607.15	PS7_13_BCN1_A AMBER BEACON LIGHT						
02607.16	PS7_13_BCN1_H ALARM HORN						
02607.17							
02607.18							
02607.19							
02607.20							

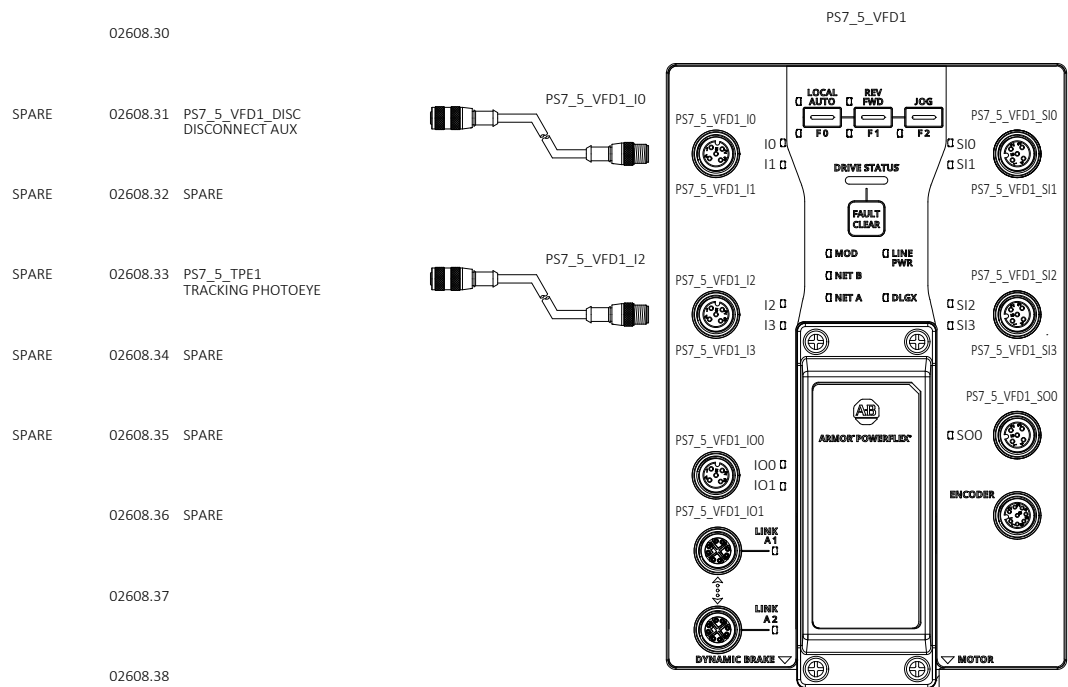
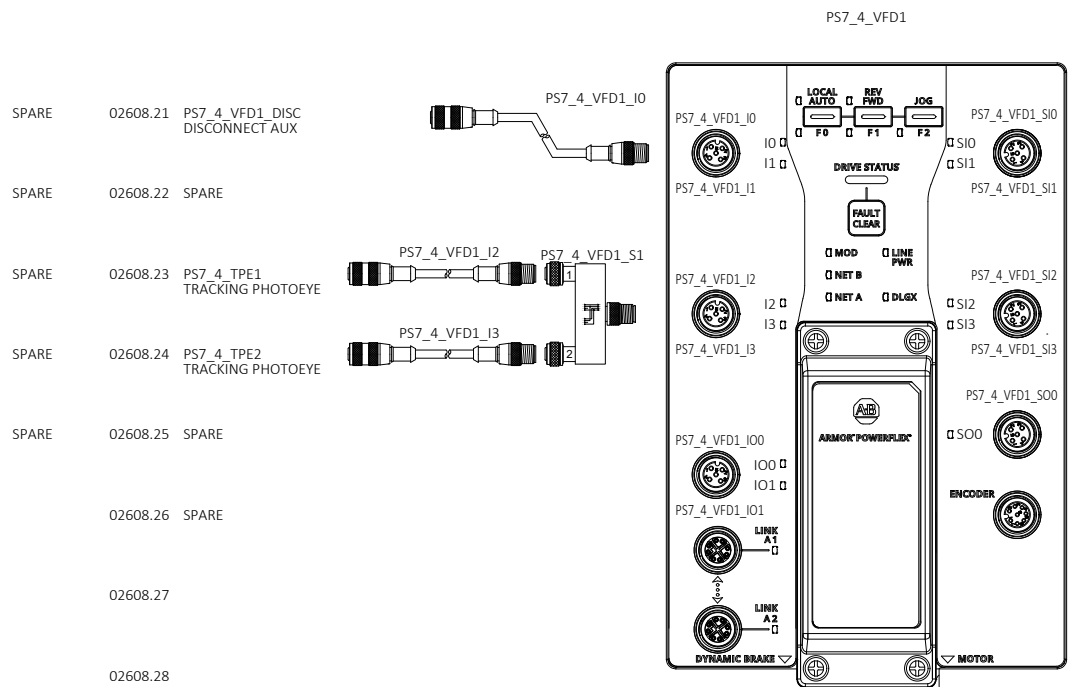
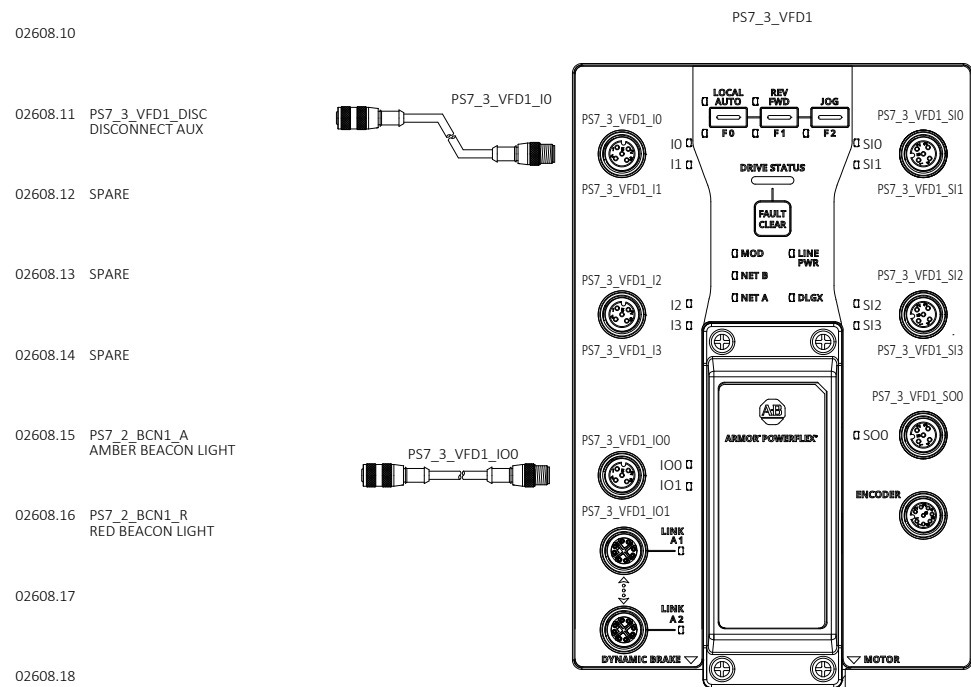
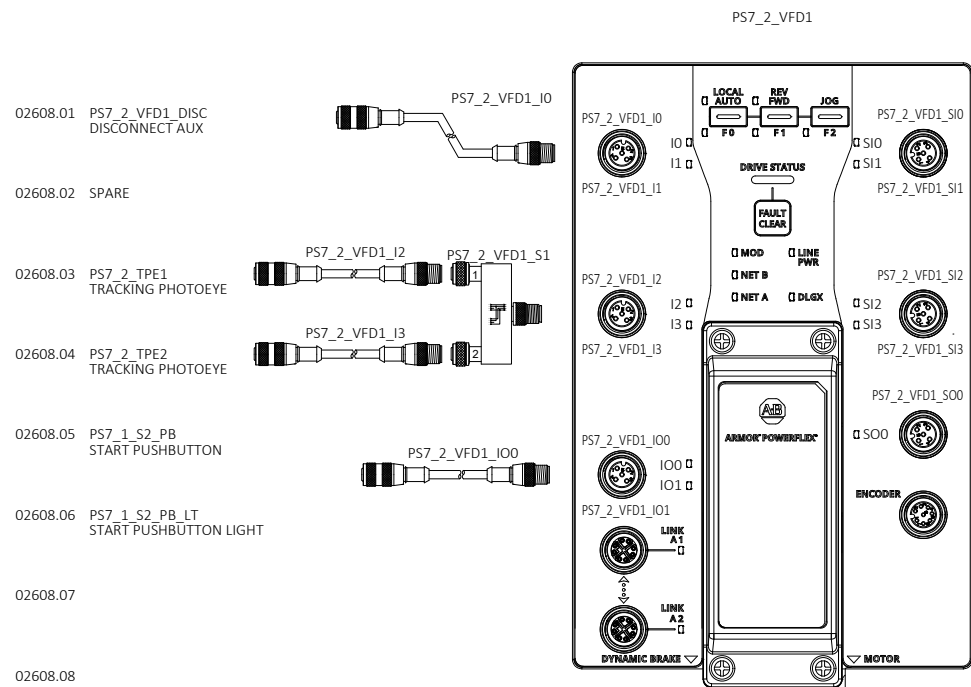


DRAWING REVISIONS			
REV	DESCRIPTION	DATE	BY
00	INITIAL DRAWINGS	05/19/2025	SK
01	ALARM HORN	06/18/2025	SN
A	AS-BUILT	11/13/2025	LB

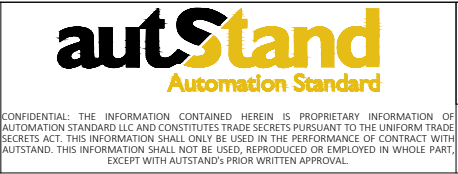

25K Amazon Cross-Belt Sort Center (ACBSC) PS7_2_VFD1/PS7_3_VFD1/ PS7_4_VFD1/PS7_5_VFD1 IO DRAWINGS
AMAZON MTN6 SPARROWS POINT, MD

FILENAME	
2429-AMZ-MTN6-MCM02-608	
D-SIZE SCALE	JOB NUMBER:
NTS	2429
REVISION	SHEET
A	66

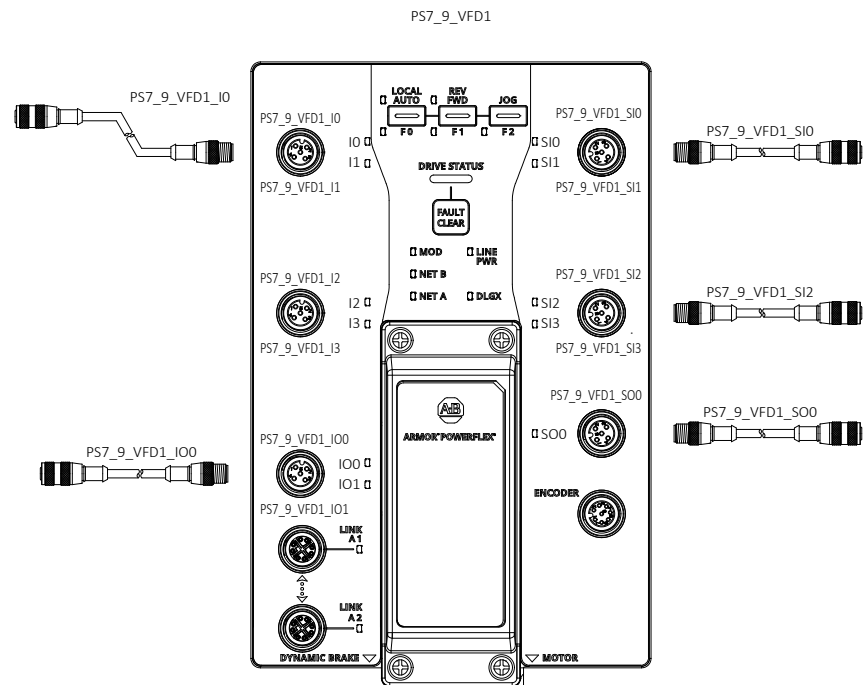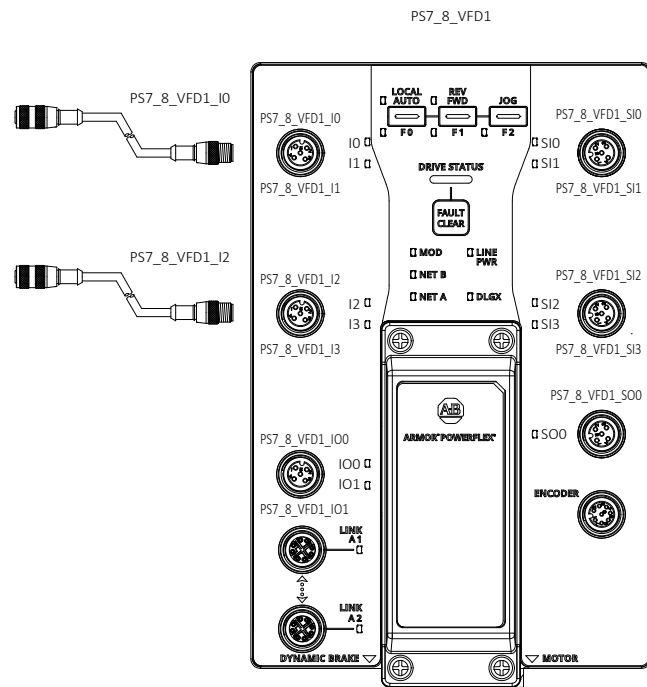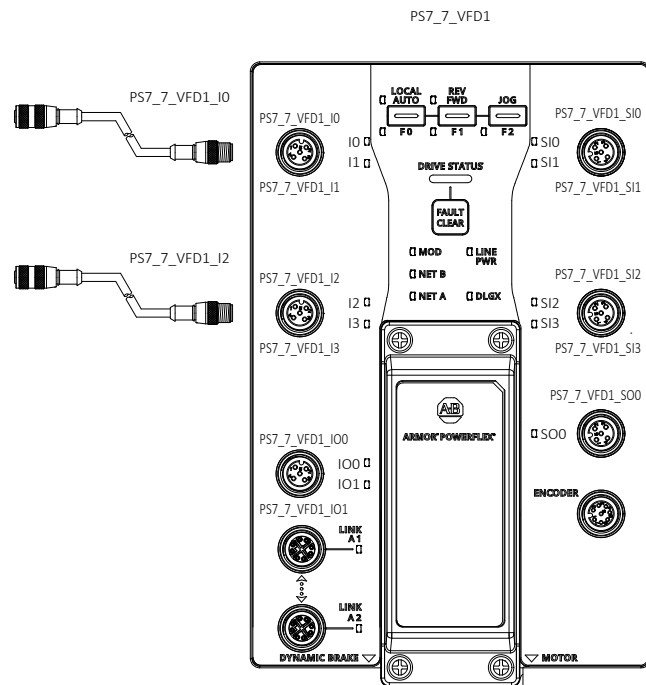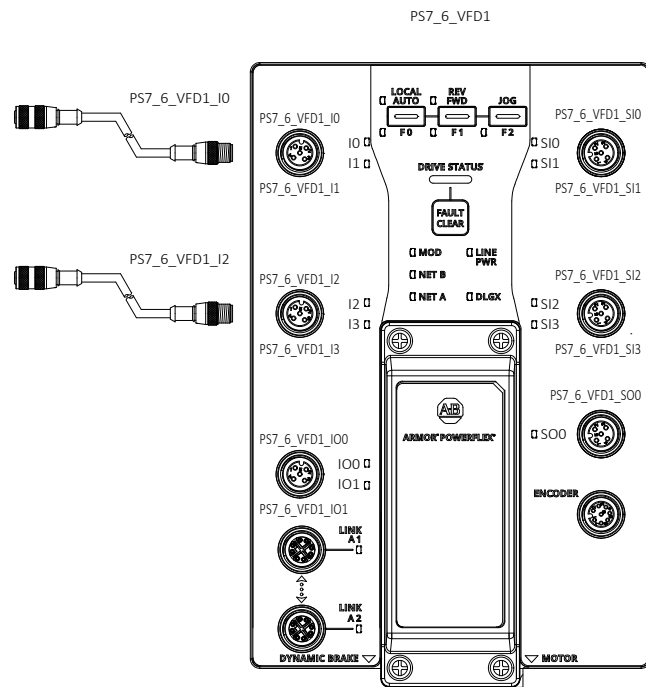

DRAWING REVISIONS				
REV	DESCRIPTION	DATE	BY	
00	INITIAL DRAWINGS	05/19/2025	SK	
01	ALARM HORN	06/18/2025	SN	
A	AS-BUILT	11/13/2025	LB	







autStandard
Automation Standard

CONFIDENTIAL: THE INFORMATION CONTAINED HEREIN IS PROPRIETARY INFORMATION OF AUTOMATION STANDARD LLC AND CONSTITUTES TRADE SECRETS PURSUANT TO THE UNIFORM TRADE SECRETS ACT. THIS INFORMATION SHALL ONLY BE USED IN THE PERFORMANCE OF CONTRACT WITH AUTOSTANDARD. THIS INFORMATION SHALL NOT BE USED, REPRODUCED OR EMPLOYED IN WHOLE PART EXCEPT WITH AUTOSTANDARD'S PRIOR WRITTEN APPROVAL.

25K Amazon Cross-Belt Sort Center (ACBSC) PS7_6_VFD1/PS7_7_VFD1/ PS7_8_VFD1/PS7_9_VFD1 IO DRAWINGS
AMAZON MTN6 SPARROWS POINT, MD

FILENAME	
2429-AMZ-MTN6-MCM02-609	
D-SIZE SCALE	JOB NUMBER:
NTS	2429
REVISION	SHEET
A	67

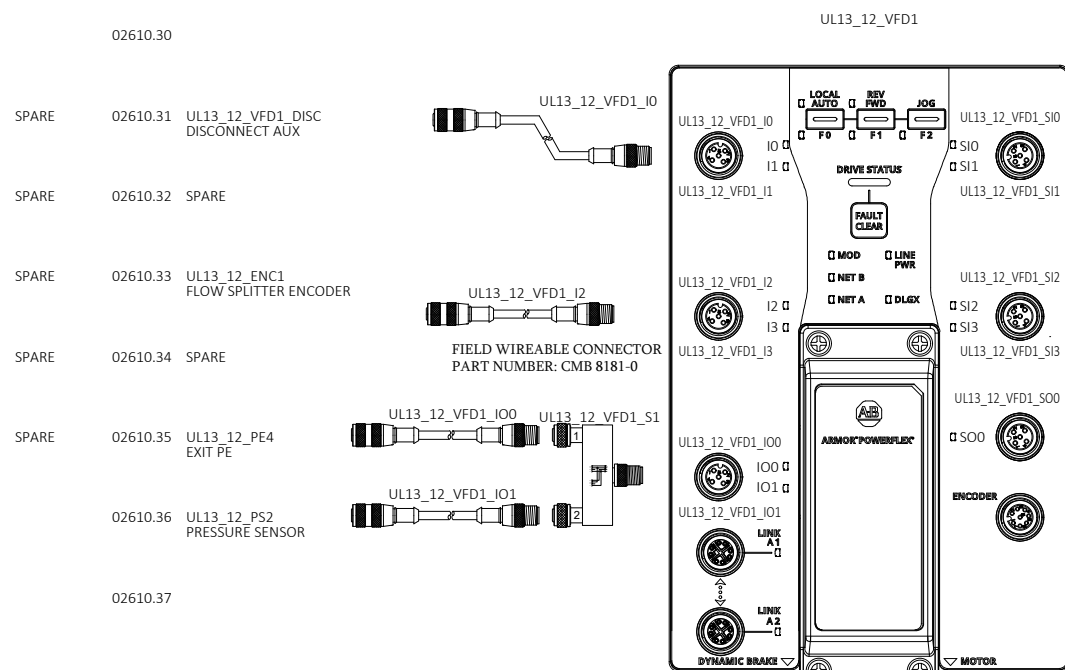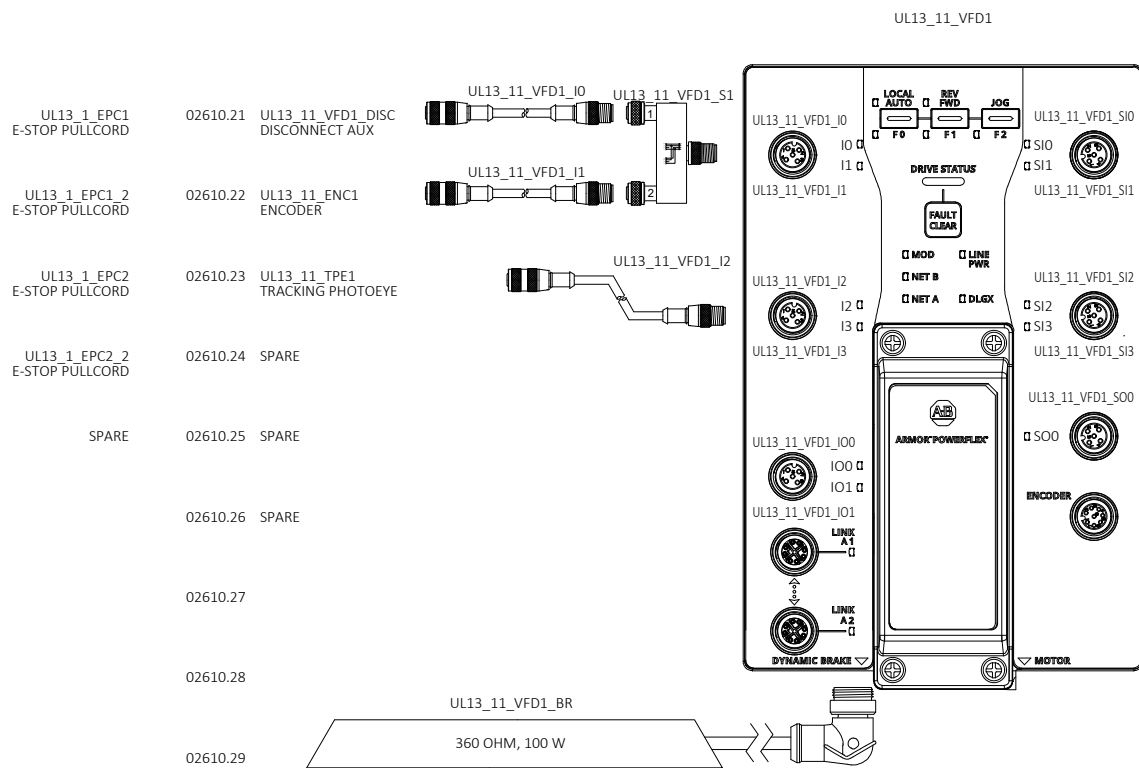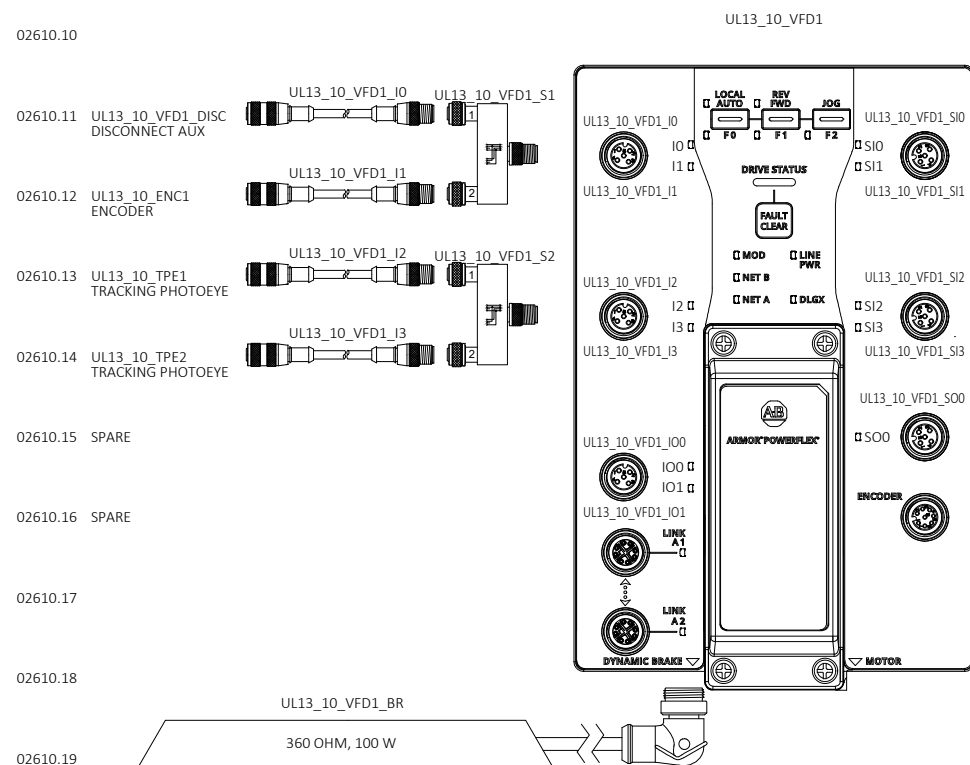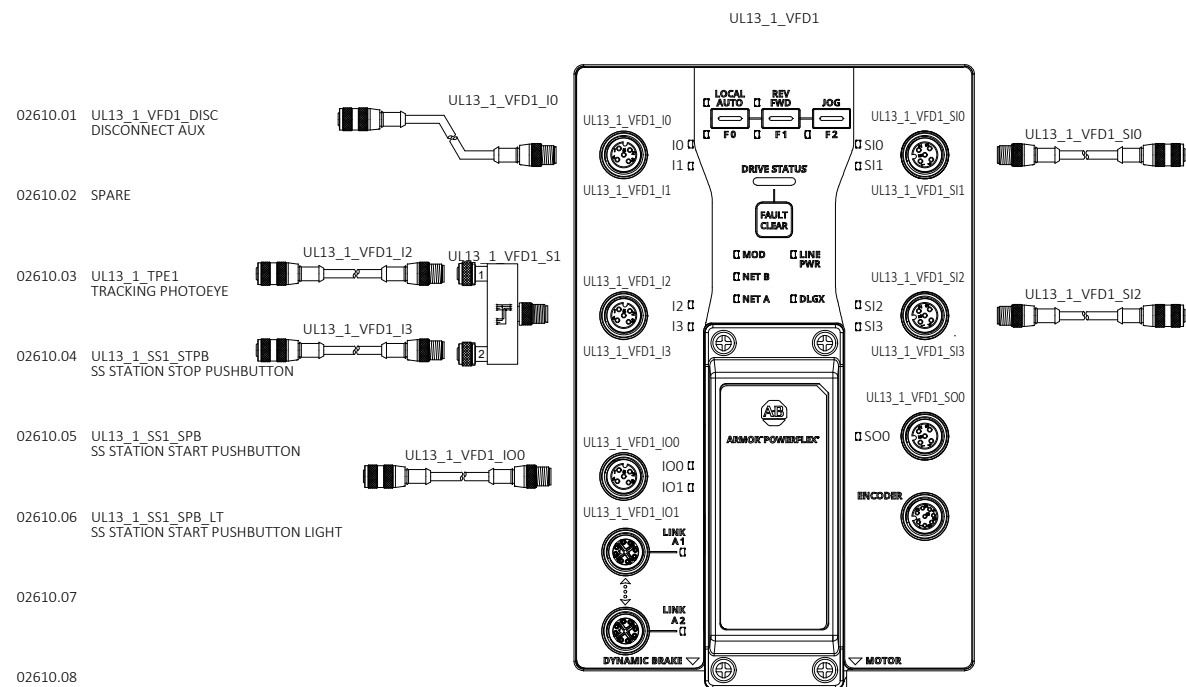





DRAWING REVISIONS			
REV	DESCRIPTION	DATE	BY
00	INITIAL DRAWINGS	05/19/2025	SK
01	IO REMAPPING	07/01/2025	SN
A	AS-BUILT	11/13/2025	LB



autostand
Automation Standard

CONFIDENTIAL: THE INFORMATION CONTAINED HEREIN IS PROPRIETARY INFORMATION OF AUTOMATION STANDARD LLC AND CONSTITUTES TRADE SECRETS PURSUANT TO THE UNIFORM TRADE SECRETS ACT. THIS INFORMATION SHALL ONLY BE USED IN THE PERFORMANCE OF CONTRACT WITH AUTOSTAND. THIS INFORMATION SHALL NOT BE USED, REPRODUCED OR EMPLOYED IN WHOLE PART EXCEPT WITH AUTOSTAND'S PRIOR WRITTEN APPROVAL.

25K Amazon Cross-Belt Sort Center (ACBSC) UL13_1_VFD1/UL13_10_VFD1/ UL13_11_VFD1/UL13_12_VFD1 IO DRAWINGS	FILENAME 2429-AMZ-MTN6-MCM02-610	
	D-SIZE SCALE	JOB NUMBER
	NTS	2429
	AMAZON MTN6 SPARROWS POINT, MD	REVISION A

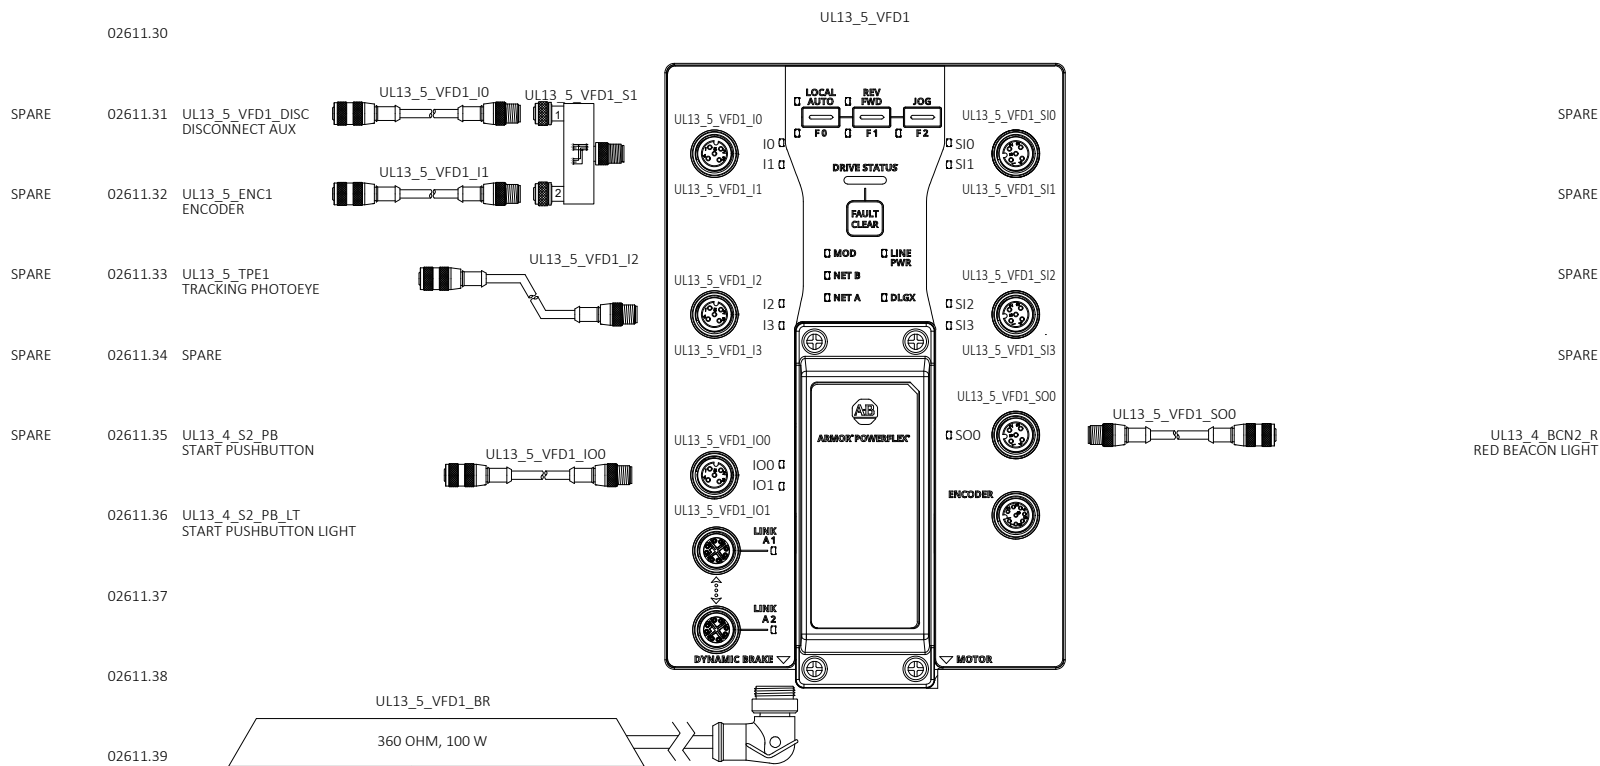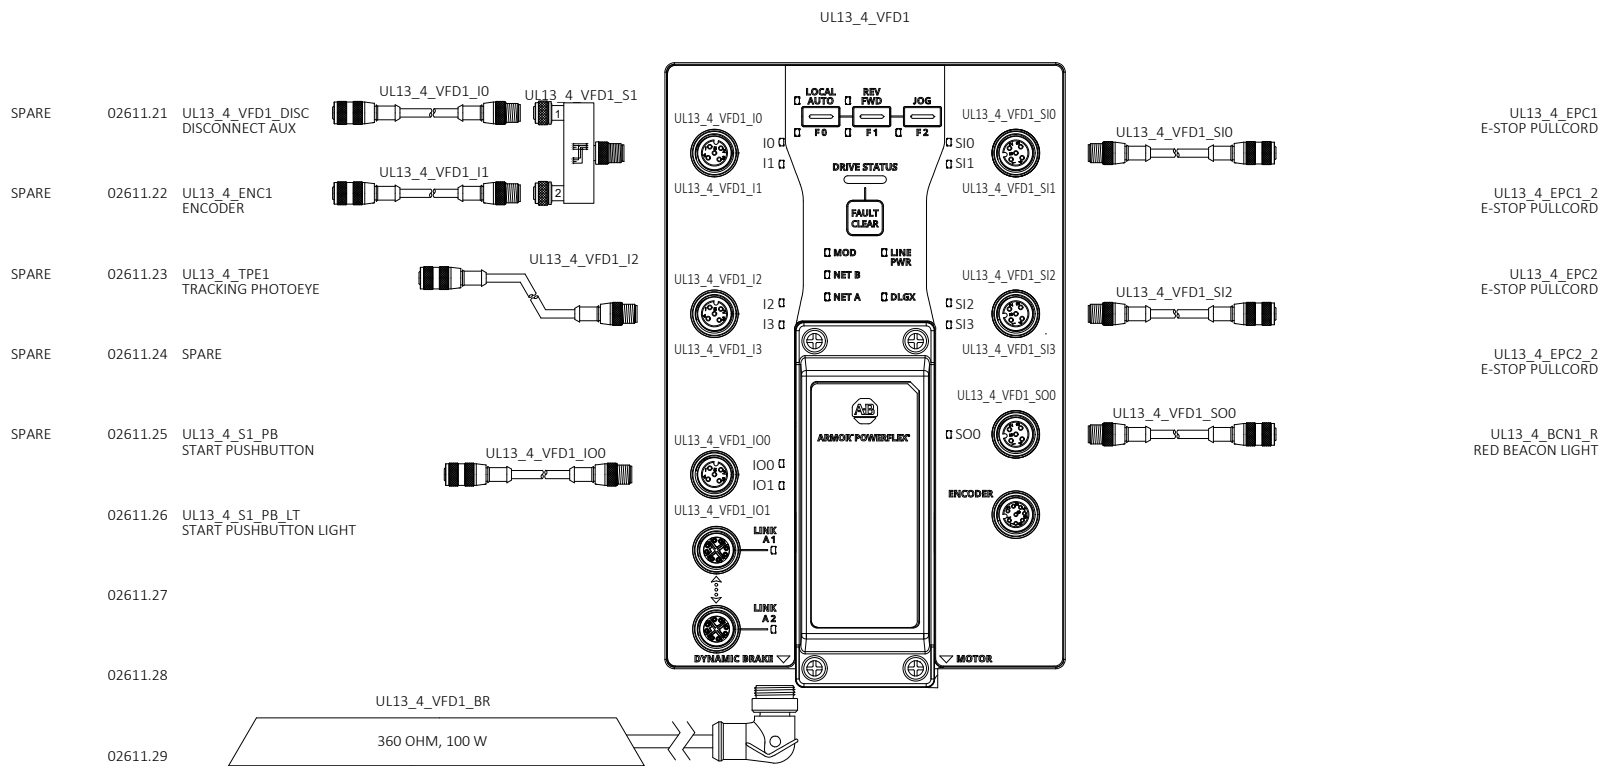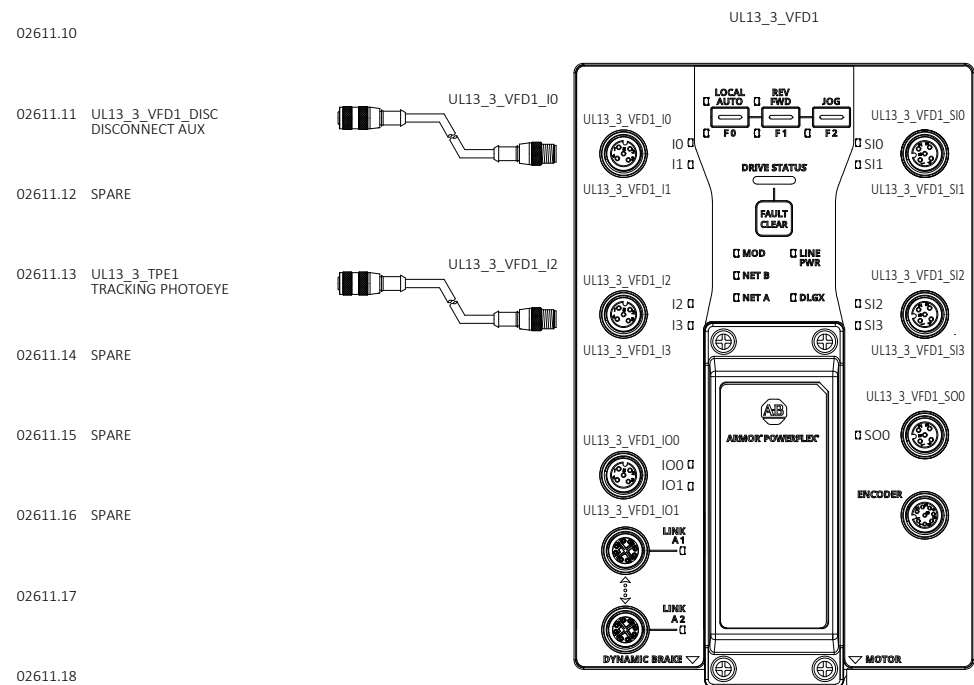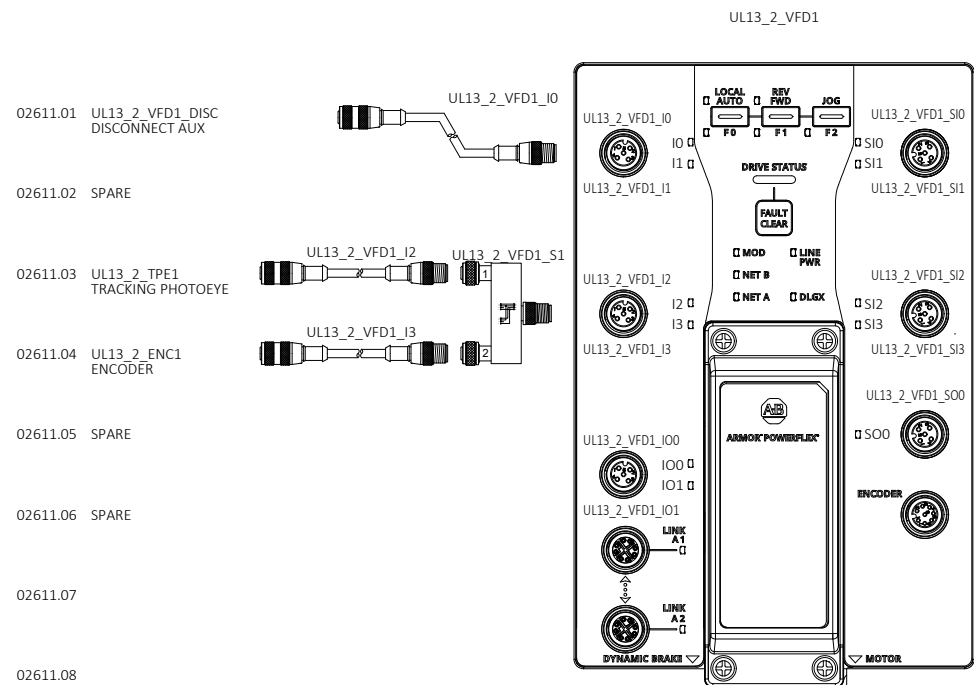





DRAWING REVISIONS			
REV	DESCRIPTION	DATE	BY
00	INITIAL DRAWINGS	05/19/2025	SK
01	ALARM HORN	06/18/2025	SN
A	AS-BUILT	11/13/2025	LB




autistand
Automation Standard

CONFIDENTIAL: THE INFORMATION CONTAINED HEREIN IS PROPRIETARY INFORMATION OF AUTOMATION STANDARD LLC AND CONSTITUTES TRADE SECRETS PURSUANT TO THE UNIFORM TRADE SECRETS ACT. THIS INFORMATION SHALL ONLY BE USED IN THE PERFORMANCE OF CONTRACT WITH AUTISTAND. THIS INFORMATION SHALL NOT BE USED, REPRODUCED OR EMPLOYED IN WHOLE PART, EXCEPT WITH AUTISTAND'S PRIOR WRITTEN APPROVAL.

25K Amazon Cross-Belt Sort Center (ACBSC) UL13_2_VFD1/UL13_3_VFD1/ UL13_4_VFD1/UL13_5_VFD1 IO DRAWINGS	FILENAME	
	2429-AMZ-MTN6-MCM02-611	
	D-SIZE SCALE	JOB NUMBER:
	NTS	2429
AMAZON MTN6 SPARROWS POINT, MD	REVISION	SHEET
	A	69

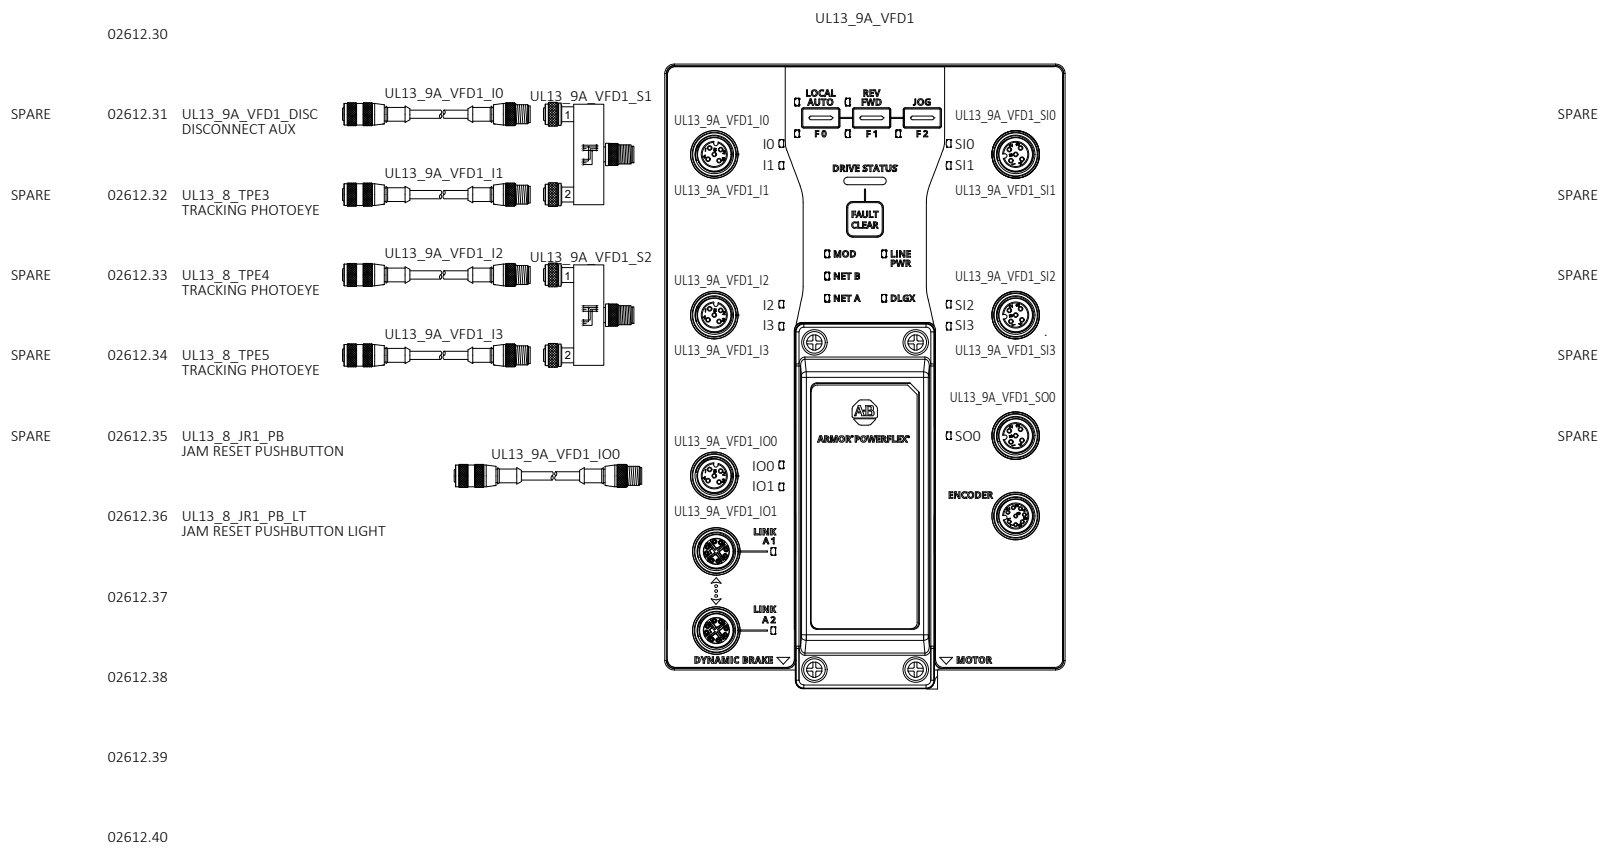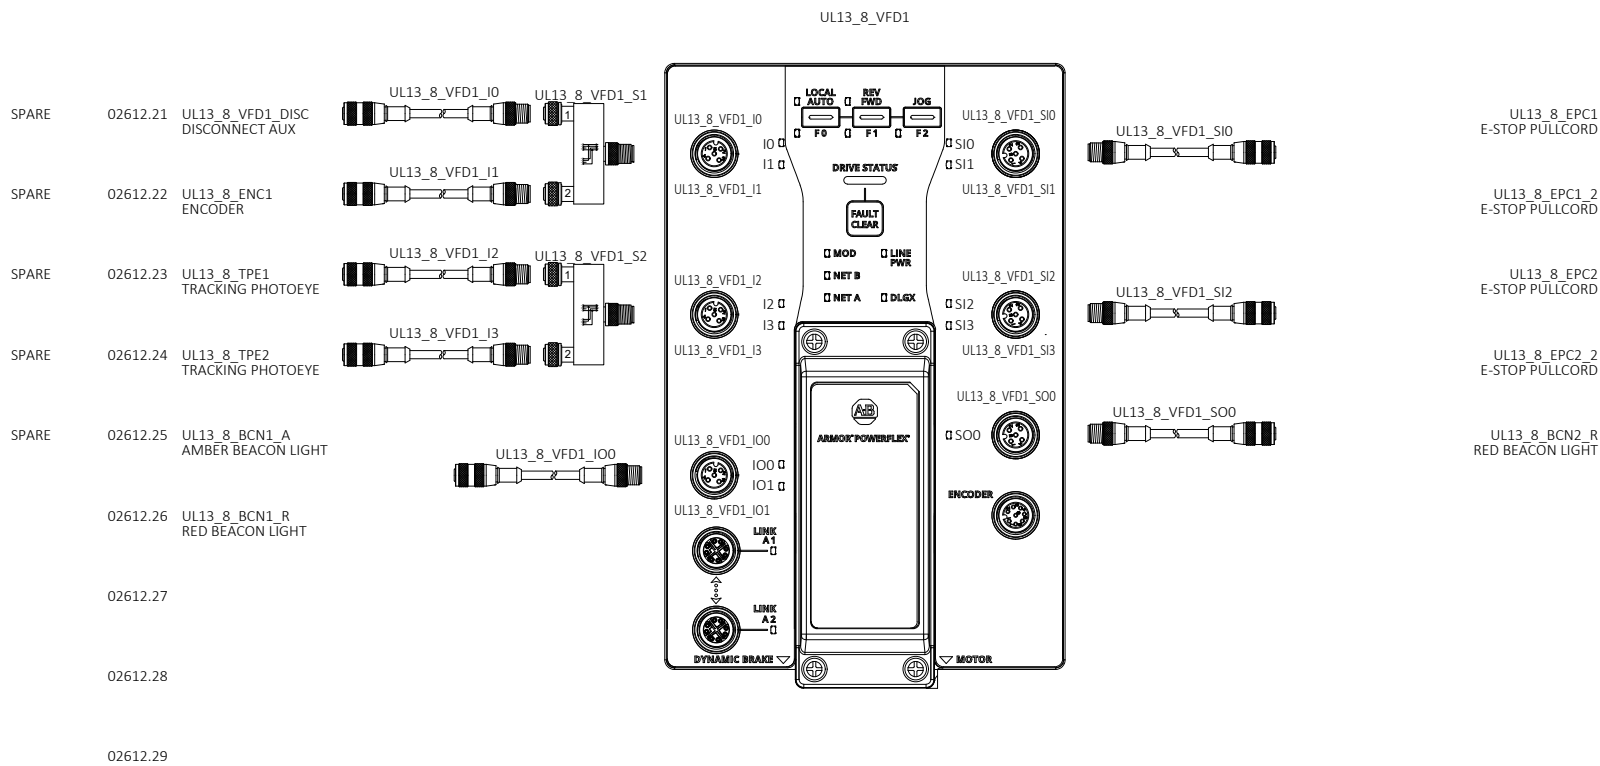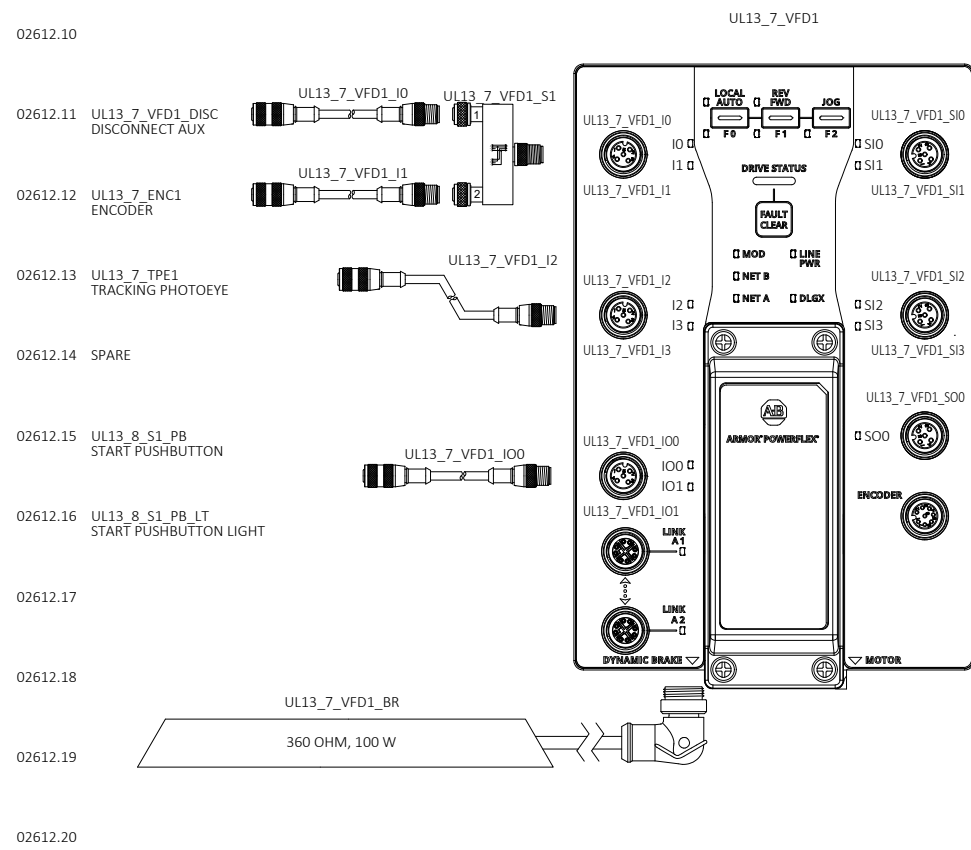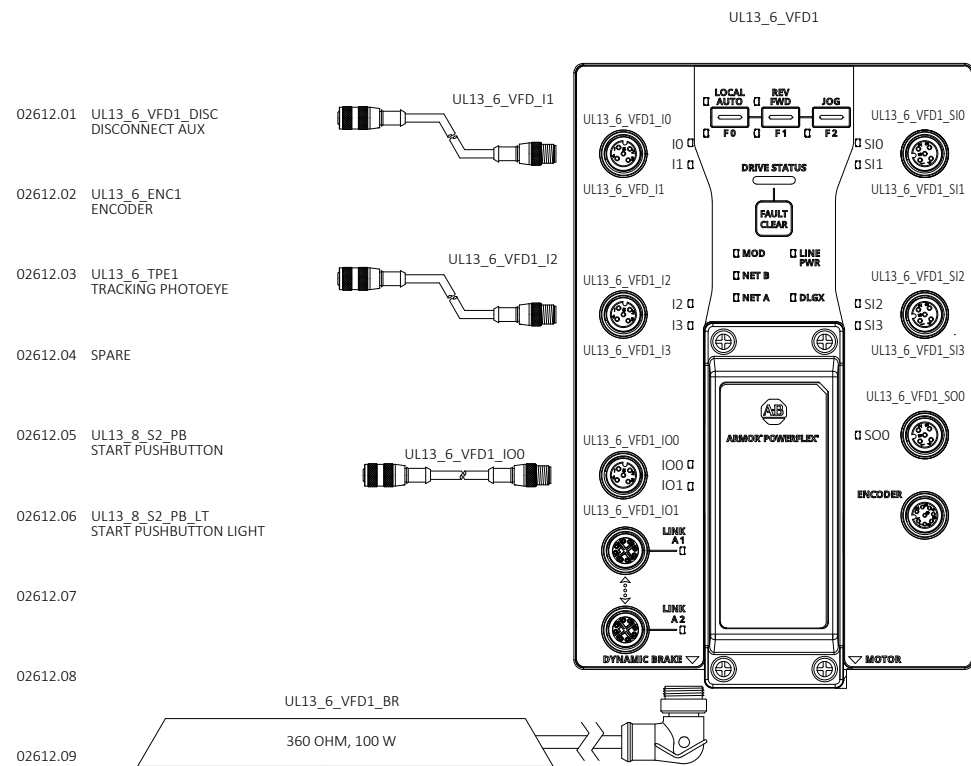


DRAWING REVISIONS			
REV	DESCRIPTION	DATE	BY
00	INITIAL DRAWINGS	05/19/2025	SK
01	ALARM HORN	06/18/2025	SN
A	AS-BUILT	11/13/2025	LB

 

CONFIDENTIAL: THE INFORMATION CONTAINED HEREIN IS PROPRIETARY INFORMATION OF AUTOMATION STANDARD LLC AND CONSTITUTES TRADE SECRETS PURSUANT TO THE UNIFORM TRADE SECRETS ACT. THIS INFORMATION SHALL ONLY BE USED IN THE PERFORMANCE OF CONTRACT WITH AUTOSTAND. THIS INFORMATION SHALL NOT BE USED, REPRODUCED OR EMPLOYED IN WHOLE PART EXCEPT WITH AUTOSTAND'S PRIOR WRITTEN APPROVAL.

25K Amazon Cross-Belt Sort Center (ACBSC) UL13_6_VFD1/UL13_7_VFD1/ UL13_8_VFD1/UL13_9A_VFD1 IO DRAWINGS	FILENAME 2429-AMZ-MTN6-MCM02-612	
	D-SIZE SCALE NTS	JOB NUMBER: 2429
	REVISION A	SHEET 70
	AMAZON MTN6 SPARROWS POINT, MD	

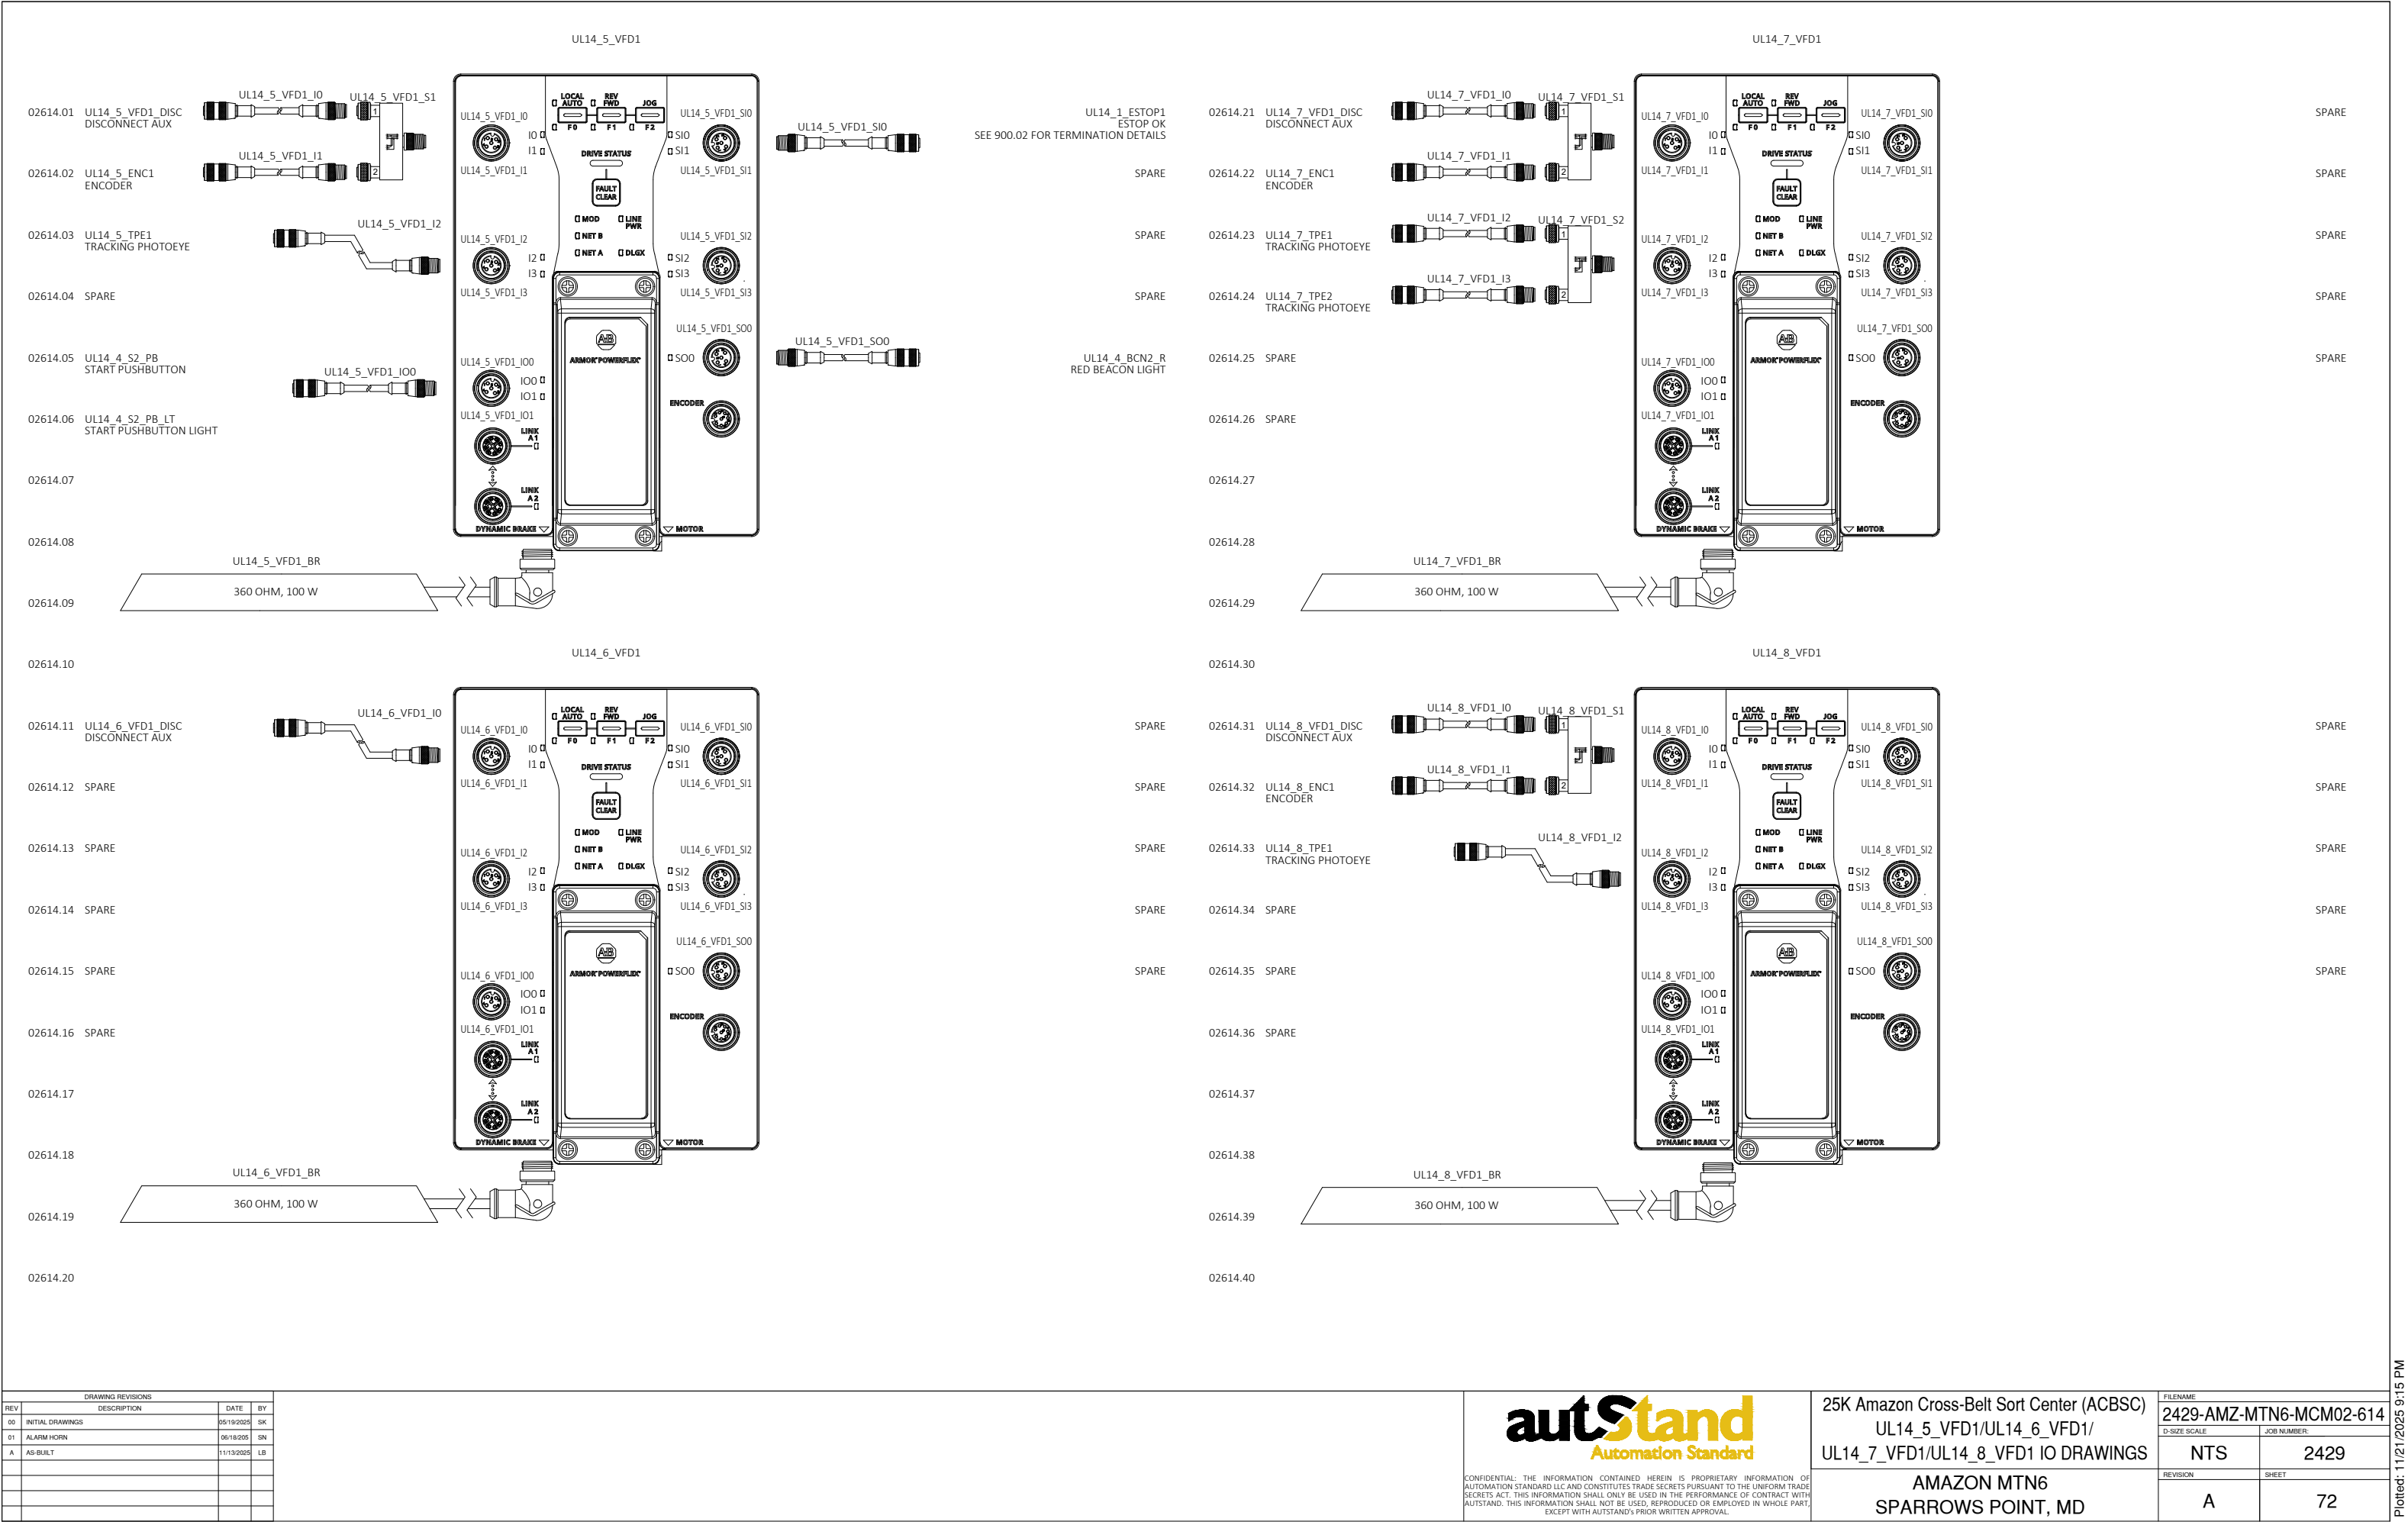

02614.30

02614.31

UL14_8_VFD1_DISC
DISCONNECT AUX

02614.32

UL14_8_ENC1
ENCODER

02614.33

UL14_8_TPE1
TRACKING PHOTOEYE

02614.34

SPARE

02614.35

SPARE

02614.36

SPARE

02614.37

02614.38

02614.39

UL14_8_VFD1_I0

UL14_8_VFD1_I1

UL14_8_VFD1_I2

UL14_8_VFD1_I3

UL14_8_VFD1_I00

UL14_8_VFD1_I01

LINK A1

LINK A2

UL14_8_VFD1_S1

UL14_8_VFD1_S10

UL14_8_VFD1_S11

UL14_8_VFD1_S12

UL14_8_VFD1_S13

UL14_8_VFD1_S00

ENCODER

MOTOR

UL14_8_VFD1

LOCAL
F0

REV
F1

JOG
F2

DRIVE STATUS

FAULT
CLEAR

MOD

LINE
PWR

NET B

NET A

DLGX

ARMORPOWERFLUX

DYNAMIC BRAKE

UL14_8_VFD1_I0

UL14_8_VFD1_I1

UL14_8_VFD1_I2

UL14_8_VFD1_I3

UL14_8_VFD1_I00

UL14_8_VFD1_I01

LINK A1

LINK A2

UL14_8_VFD1_S10

UL14_8_VFD1_S11

UL14_8_VFD1_S12

UL14_8_VFD1_S13

UL14_8_VFD1_S00

ENCODER

MOTOR

UL14_8_VFD1_BR

360 OHM, 100 W

UL14_8_VFD1_S10

UL14_8_VFD1_S00

UL14_1_ESTOP1
ESTOP OK
SEE 900.02 FOR TERMINATION DETAILS

SPARE

SPARE

SPARE

UL14_4_BCN2_R
RED BEACON LIGHT

02614.40

REV	DESCRIPTION	DATE	BY
00	INITIAL DRAWINGS	05/19/2025	SK
01	ALARM HORN	06/18/2025	SN
A	AS-BUILT	11/13/2025	LB

FILENAME	
2429-AMZ-MTN6-MCM02-614	
D-SIZE SCALE	JOB NUMBER
NTS	2429
REVISION	SHEET
A	72

autStand

Automation Standard





CONFIDENTIAL: THE INFORMATION CONTAINED HEREIN IS PROPRIETARY INFORMATION OF AUTOMATION STANDARD LLC AND CONSTITUTES TRADE SECRETS PURSUANT TO THE UNIFORM TRADE SECRETS ACT. THIS INFORMATION SHALL ONLY BE USED IN THE PERFORMANCE OF CONTRACT WITH AUTISTAND. THIS INFORMATION SHALL NOT BE USED, REPRODUCED OR EMPLOYED IN WHOLE PART, EXCEPT WITH AUTISTAND'S PRIOR WRITTEN APPROVAL.

25K Amazon Cross-Belt Sort Center (ACBSC)

UL14_5_VFD1/UL14_6_VFD1/
UL14_7_VFD1/UL14_8_VFD1 IO DRAWINGS

AMAZON MTN6
SPARROWS POINT, MD

Plotted: 11/21/2025 9:15 PM

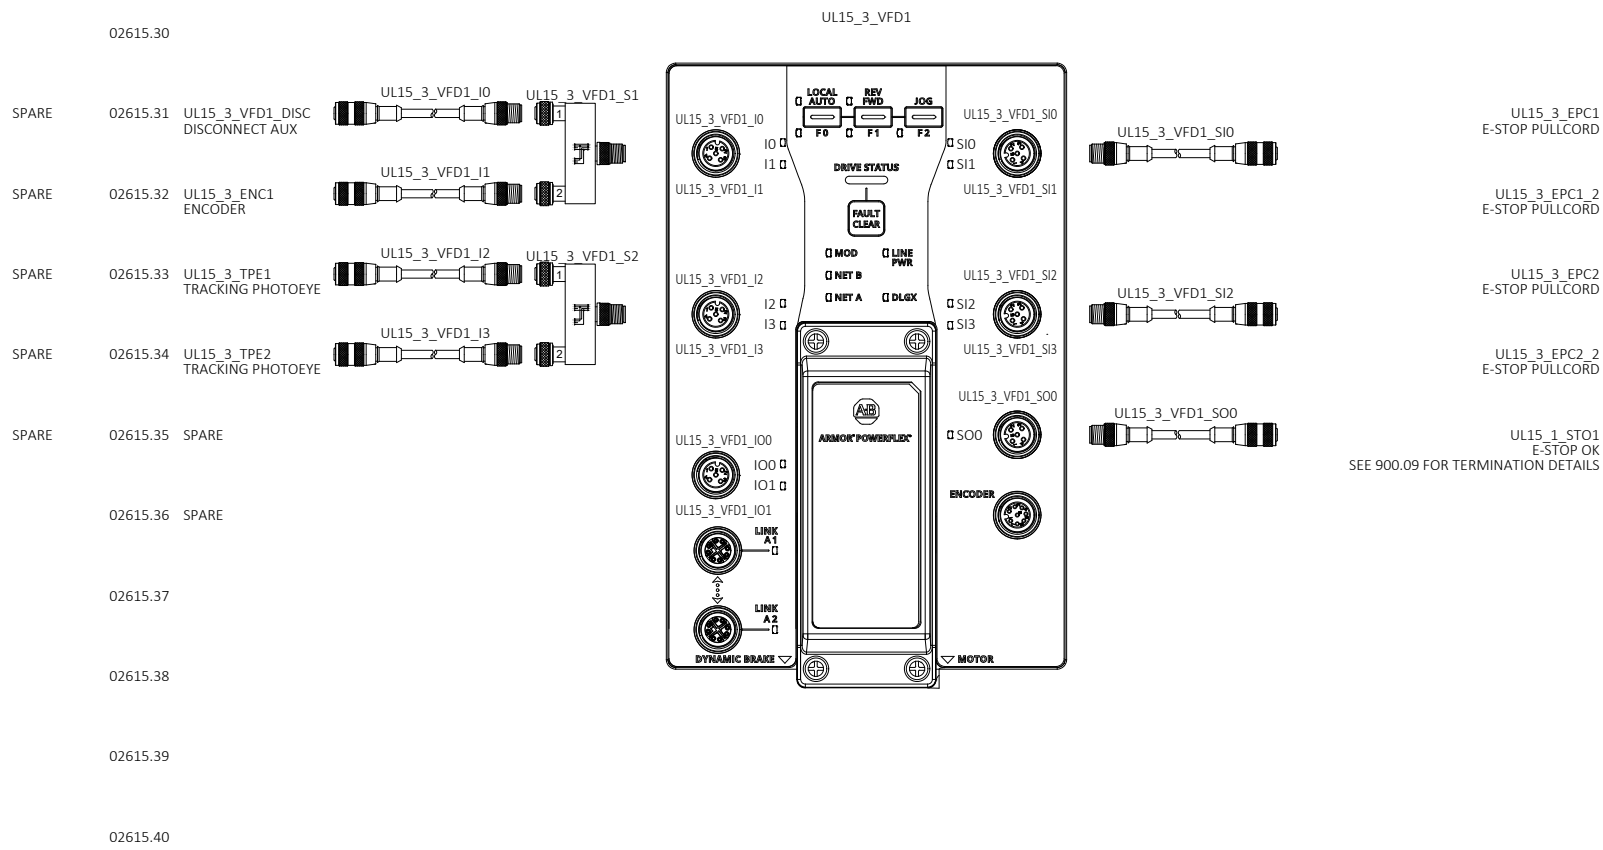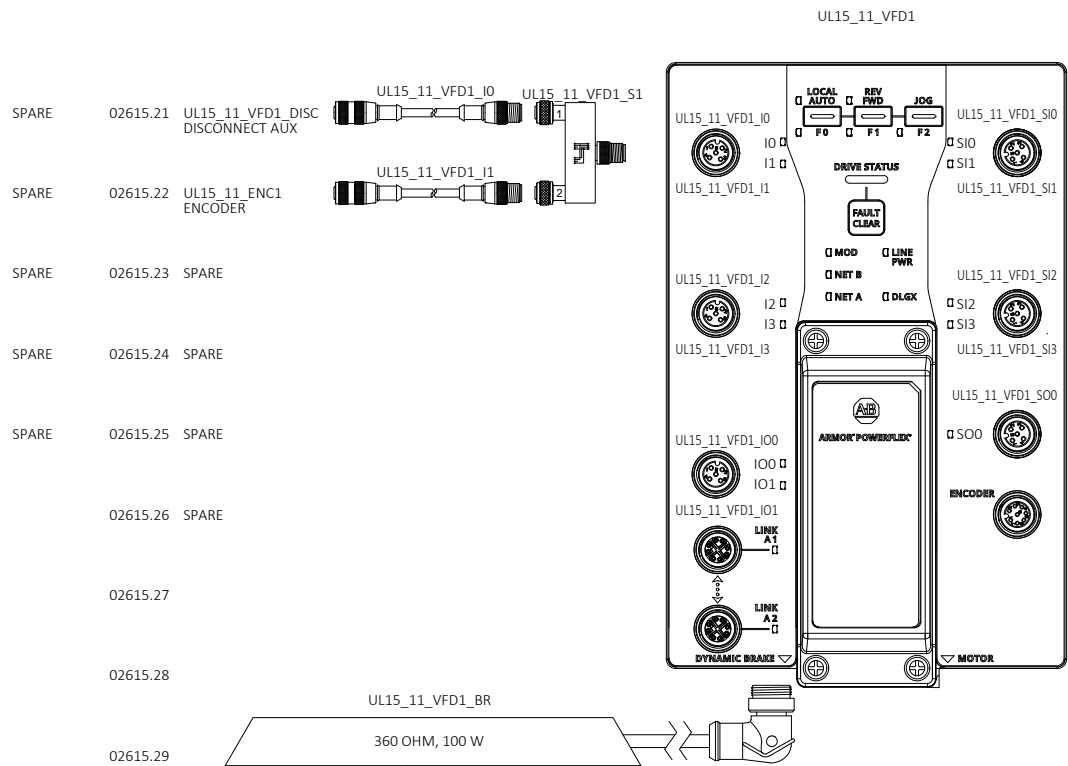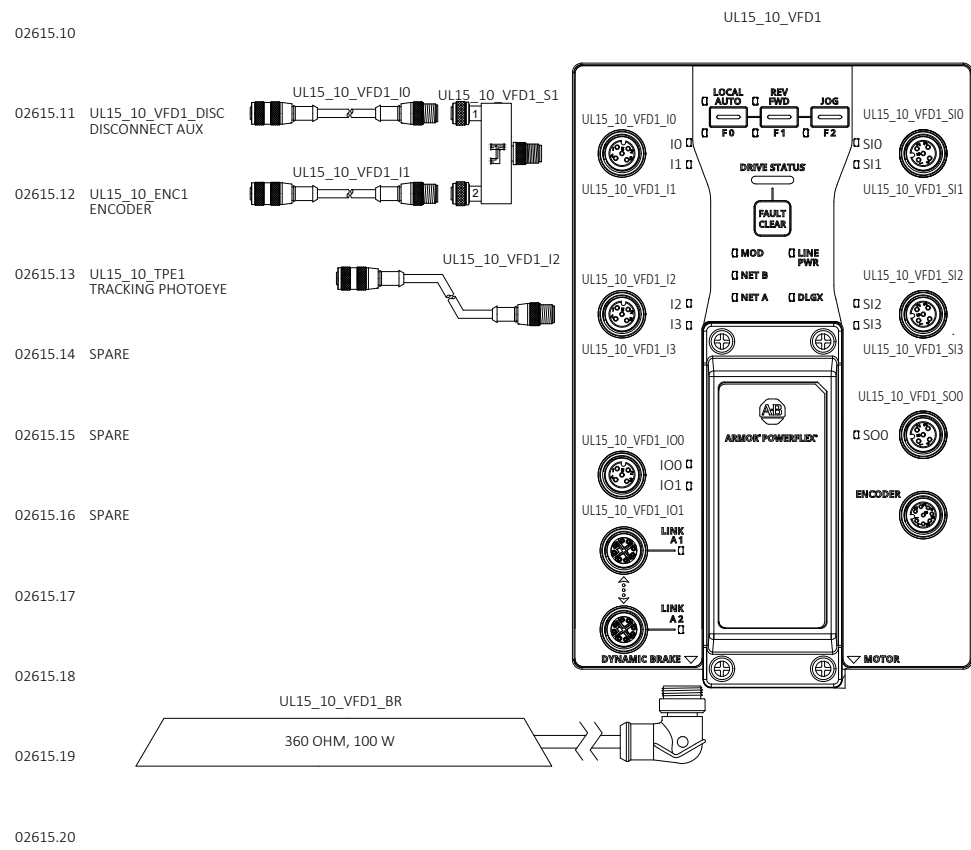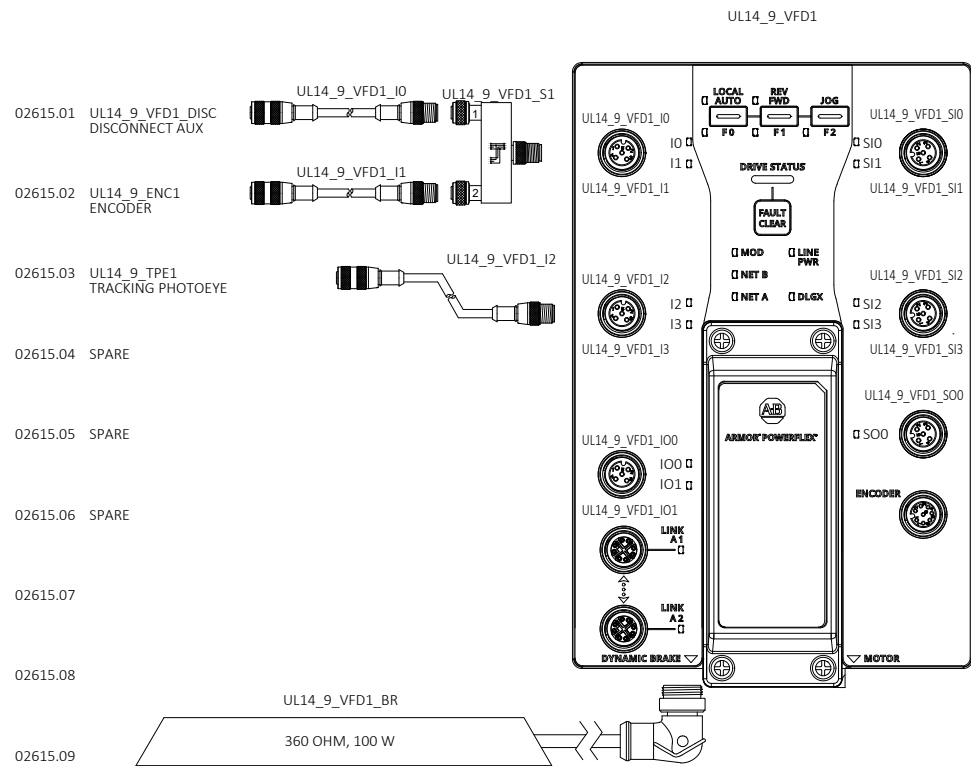

DRAWING REVISIONS			
REV	DESCRIPTION	DATE	BY
00	INITIAL DRAWINGS	05/19/2025	SK
01	ALARM HORN	06/18/2025	SN
A	AS-BUILT	11/13/2025	LB












autostand
Automation Standard

CONFIDENTIAL: THE INFORMATION CONTAINED HEREIN IS PROPRIETARY INFORMATION OF AUTOMATION STANDARD LLC AND CONSTITUTES TRADE SECRETS PURSUANT TO THE UNIFORM TRADE SECRETS ACT. THIS INFORMATION SHALL ONLY BE USED IN THE PERFORMANCE OF CONTRACT WITH AUTOSTAND. THIS INFORMATION SHALL NOT BE USED, REPRODUCED OR EMPLOYED IN WHOLE PART, EXCEPT WITH AUTOSTAND'S PRIOR WRITTEN APPROVAL.

25K Amazon Cross-Belt Sort Center (ACBSC)
UL14_9_VFD1/UL15_10_VFD1/
UL15_11_VFD1/UL15_3_VFD1 IO DRAWINGS

AMAZON MTN6
SPARROWS POINT, MD

FILENAME	
2429-AMZ-MTN6-MCM02-615	
D-SIZE SCALE	JOB NUMBER:
NTS	2429
REVISION	SHEET
A	73

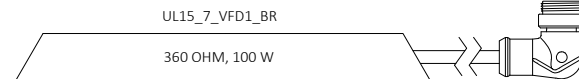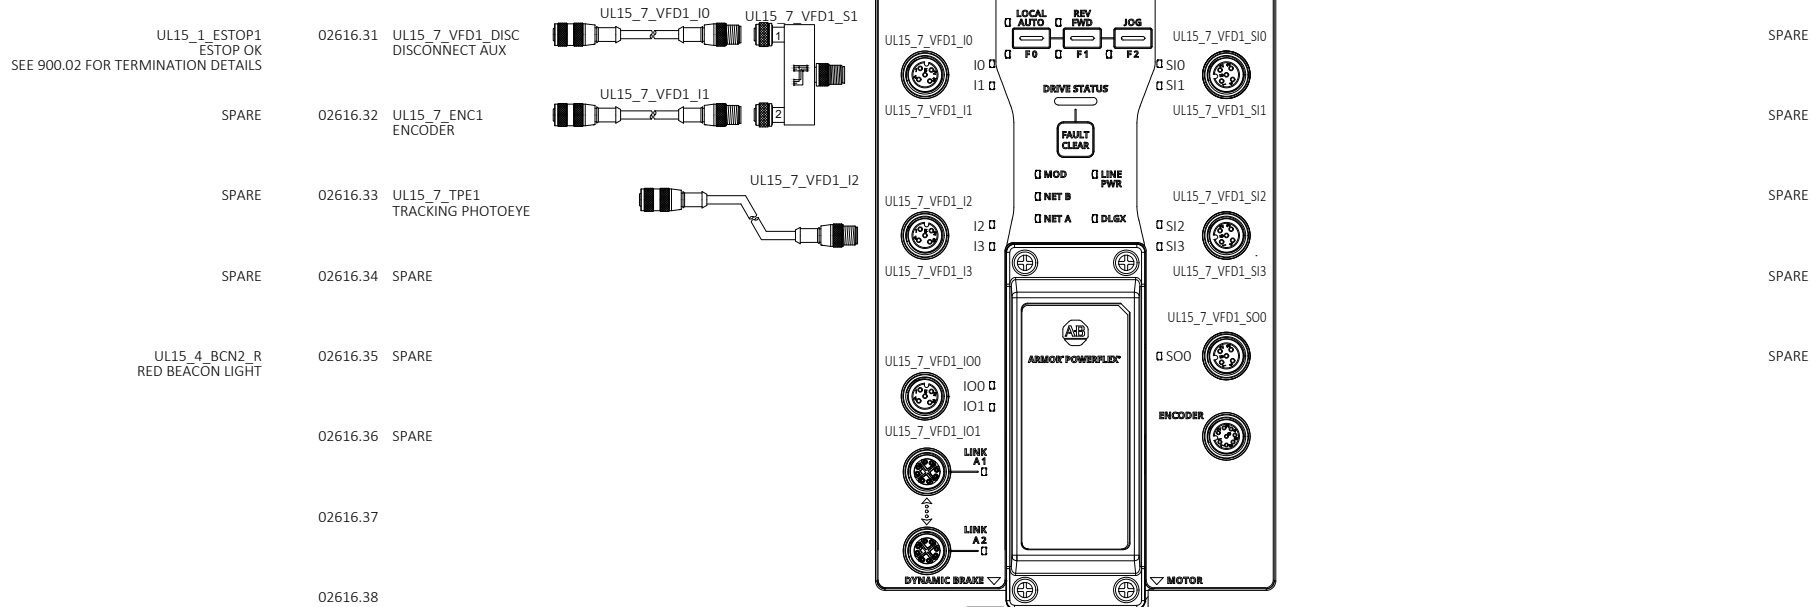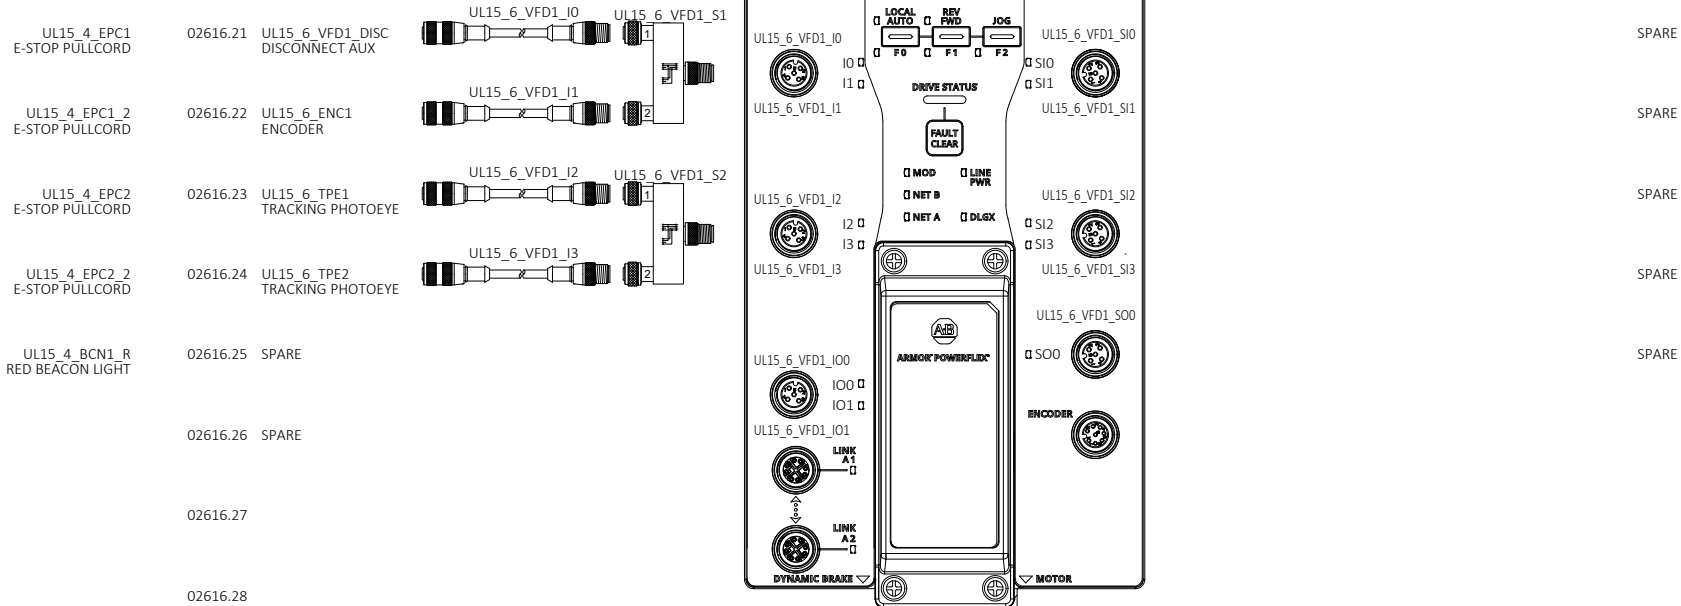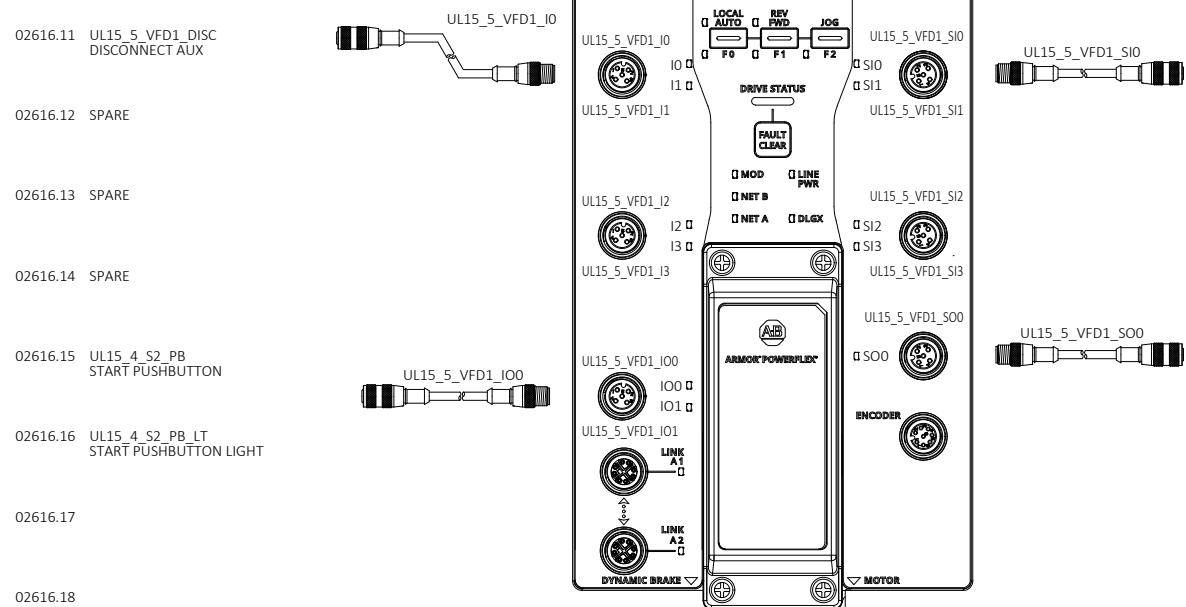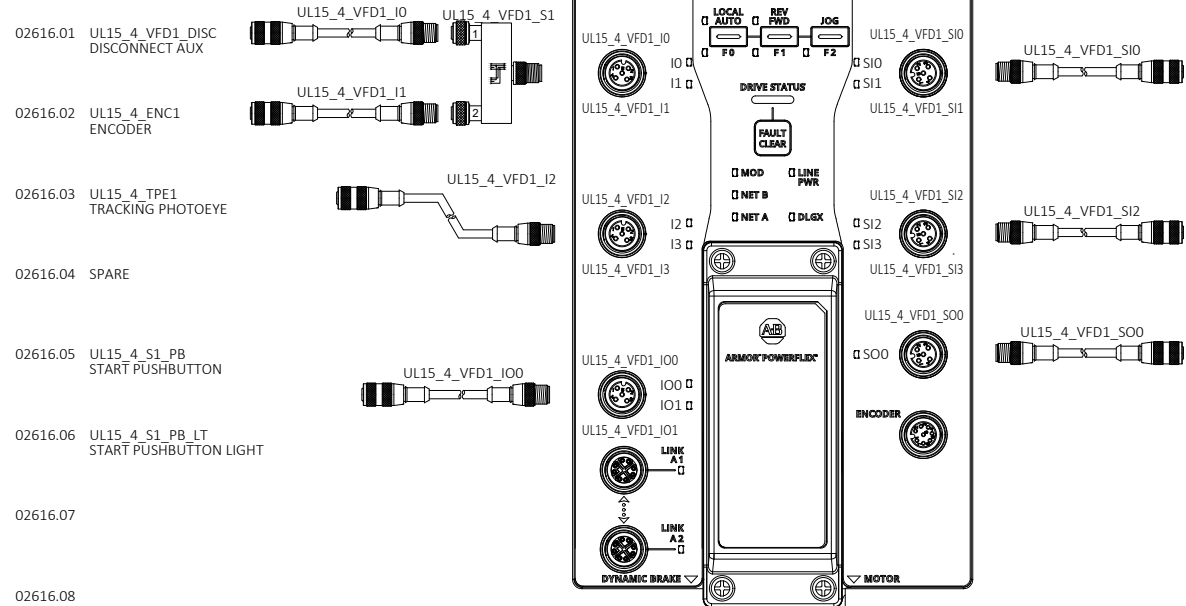   
 


DRAWING REVISIONS			
REV	DESCRIPTION	DATE	BY
00	INITIAL DRAWINGS	05/19/2025	SK
01	ALARM HORN	06/18/2025	SN
A	AS-BUILT	11/13/2025	LB























CONFIDENTIAL: THE INFORMATION CONTAINED HEREIN IS PROPRIETARY INFORMATION OF AUTOMATION STANDARD LLC AND CONSTITUTES TRADE SECRETS PURSUANT TO THE UNIFORM TRADE SECRETS ACT. THIS INFORMATION SHALL ONLY BE USED IN THE PERFORMANCE OF CONTRACT WITH AUTOSTAND. THIS INFORMATION SHALL NOT BE USED, REPRODUCED OR EMPLOYED IN WHOLE PART EXCEPT WITH AUTOSTAND'S PRIOR WRITTEN APPROVAL.


25K Amazon Cross-Belt Sort Center (ACBSC) UL15_4_VFD1/UL15_5_VFD1/ UL15_6_VFD1/UL15_7_VFD1 IO DRAWINGS	FILENAME 2429-AMZ-MTN6-MCM02-616	
	D-SIZE SCALE NTS	JOB NUMBER: 2429
	REVISION A	SHEET 74
	AMAZON MTN6 SPARROWS POINT, MD	

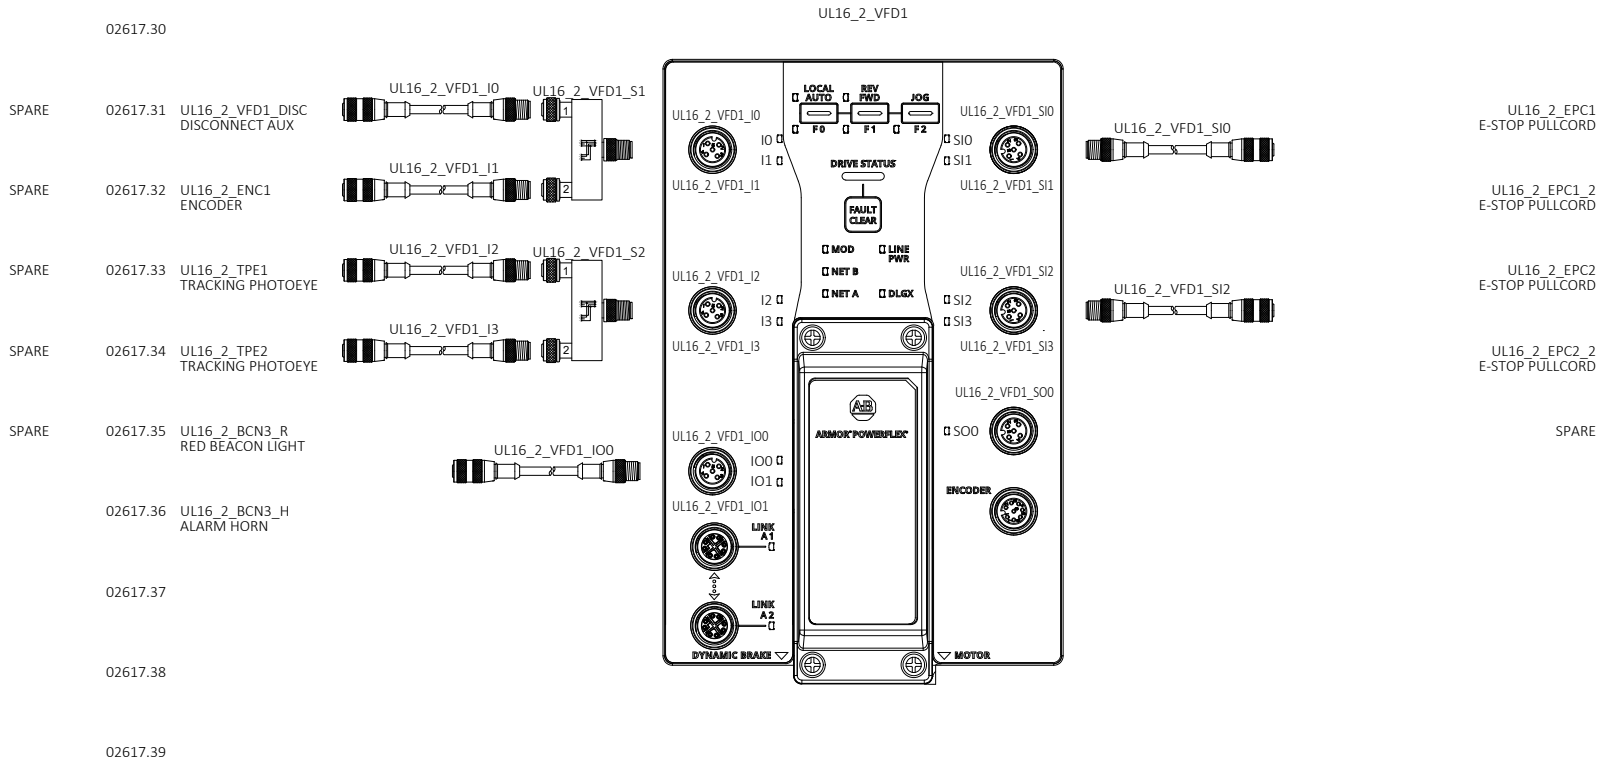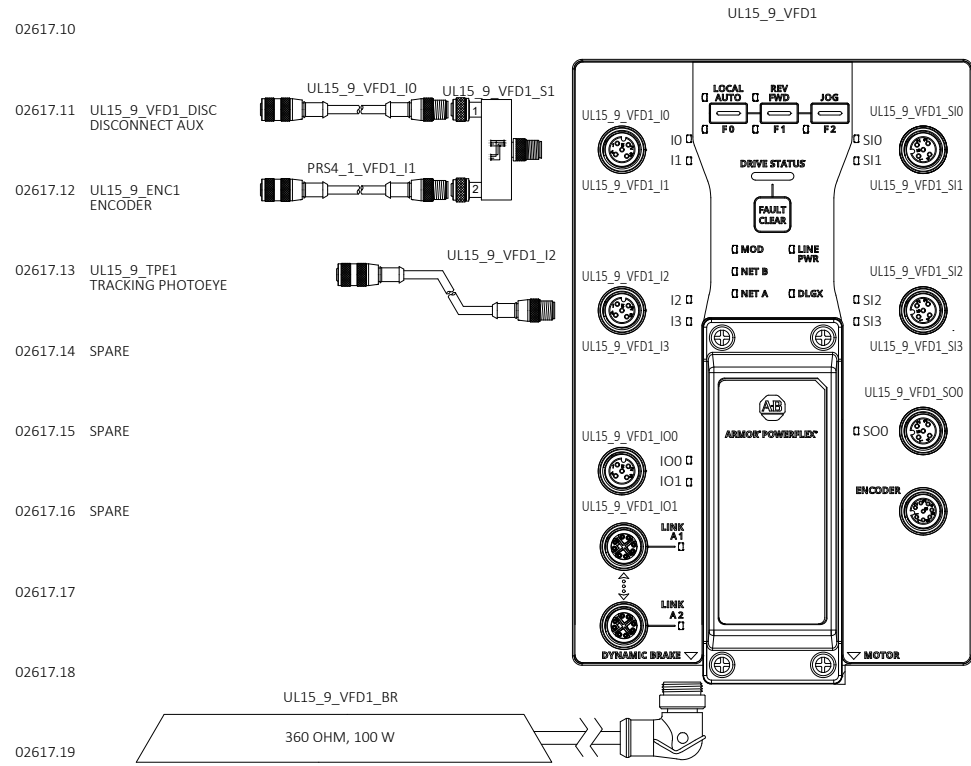

	25K Amazon Cross-Belt Sort Center (ACBSC)	FILENAME	
	UL15_8_VFD1/UL15_9_VFD1/	2429-AMZ-MTN6-MCM02-617	
	UL16_1_VFD1/UL16_2_VFD1 IO DRAWINGS	D-SIZE SCALE	JOB NUMBER:
		NTS	2429
		REVISION	SHEET
AMAZON MTN6		A	75
SPARROWS POINT, MD			
CONFIDENTIAL: THE INFORMATION CONTAINED HEREIN IS PROPRIETARY INFORMATION OF AUTOMATION STANDARD LLC AND CONSTITUTES TRADE SECRETS PURSUANT TO THE UNIFORM TRADE SECRETS ACT. THIS INFORMATION SHALL ONLY BE USED IN THE PERFORMANCE OF CONTRACT WITH AUTOSTAND. THIS INFORMATION SHALL NOT BE USED, REPRODUCED OR EMPLOYED IN WHOLE PART, EXCEPT WITH AUTOSTAND'S PRIOR WRITTEN APPROVAL.			

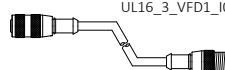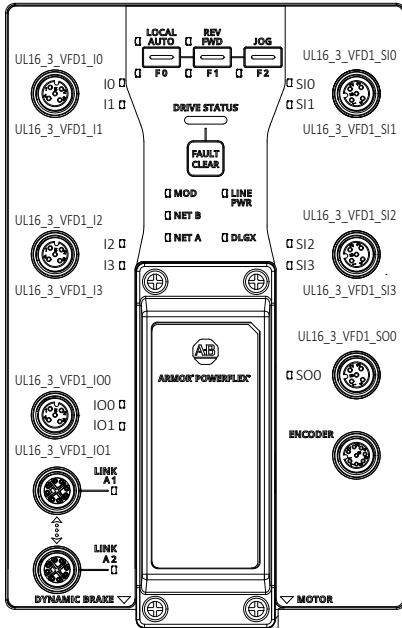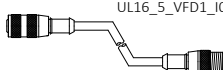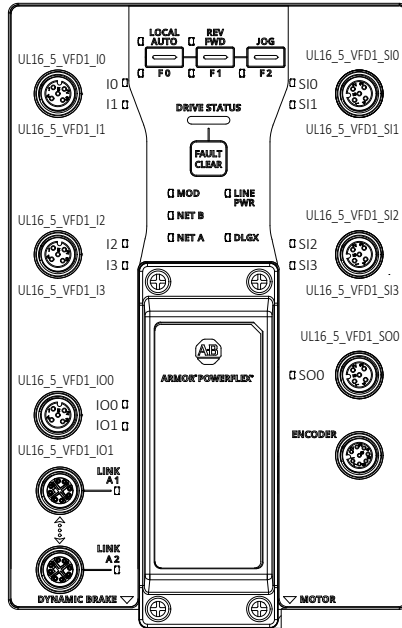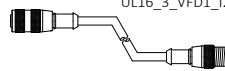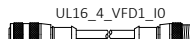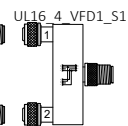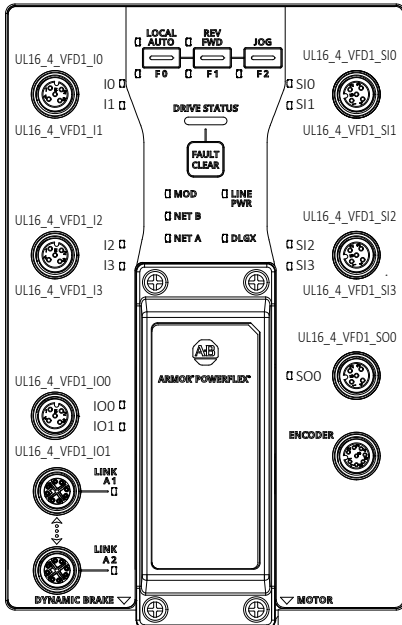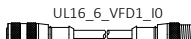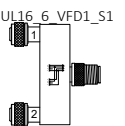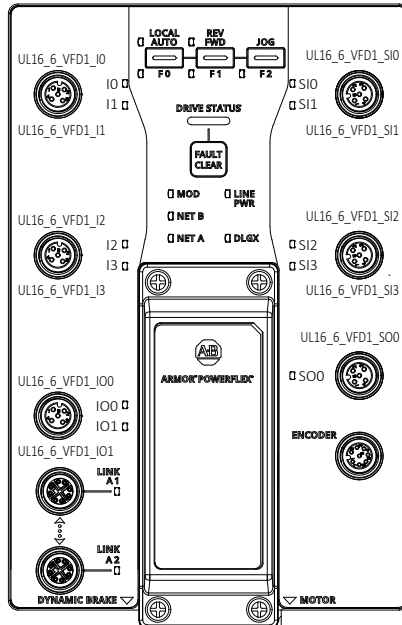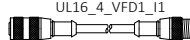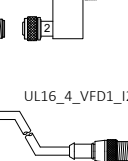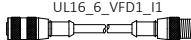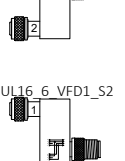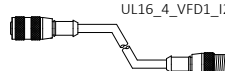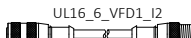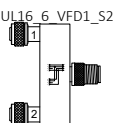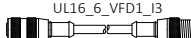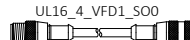				UL16_3_VFD1								UL16_5_VFD1																																											
02618.01	UL16_3_VFD1_DISC	DISCONNECT AUX						SPARE	02618.21	UL16_5_VFD1_DISC	DISCONNECT AUX							SPARE																																					
02618.02	SPARE							SPARE	02618.22	SPARE								SPARE																																					
02618.03	UL16_3_TPE1	TRACKING PHOTOEYE						SPARE	02618.23	SPARE								SPARE																																					
02618.04	SPARE							SPARE	02618.24	SPARE								SPARE																																					
02618.05	SPARE							SPARE	02618.25	SPARE								SPARE																																					
02618.06	SPARE								02618.26	SPARE																																													
02618.07									02618.27																																														
02618.08									02618.28																																														
02618.09									02618.29																																														
02618.10				UL16_4_VFD1					02618.30				UL16_6_VFD1																																										
02618.11	UL16_4_VFD1_DISC	DISCONNECT AUX	 					SPARE	02618.31	UL16_6_VFD1_DISC	DISCONNECT AUX	 						SPARE																																					
02618.12	UL16_4_ENC1	ENCODER	 					SPARE	02618.32	UL16_6_ENC1	ENCODER	 						SPARE																																					
02618.13	UL16_4_TPE1	TRACKING PHOTOEYE						SPARE	02618.33	UL16_6_TPE1	TRACKING PHOTOEYE	 						SPARE																																					
02618.14	SPARE							SPARE	02618.34	UL16_6_TPE2	TRACKING PHOTOEYE	 						SPARE																																					
02618.15	SPARE							UL16_2_BCN4_R RED BEACON LIGHT	02618.35	SPARE								SPARE																																					
02618.16	SPARE								02618.36	SPARE																																													
02618.17									02618.37																																														
02618.18									02618.38																																														
02618.19	UL16_4_VFD1_BR	360 OHM, 100 W							02618.39	UL16_6_VFD1_BR	360 OHM, 100 W																																												
02618.20									02618.40																																														
<table><tr><th colspan="4">DRAWING REVISIONS</th></tr><tr><th>REV</th><th>DESCRIPTION</th><th>DATE</th><th>BY</th></tr><tr><td>00</td><td>INITIAL DRAWINGS</td><td>05/19/2025</td><td>SK</td></tr><tr><td>01</td><td>ALARM HORN</td><td>06/18/2025</td><td>SN</td></tr><tr><td>A</td><td>AS-BUILT</td><td>11/13/2025</td><td>LB</td></tr><tr><td></td><td></td><td></td><td></td></tr><tr><td></td><td></td><td></td><td></td></tr><tr><td></td><td></td><td></td><td></td></tr><tr><td></td><td></td><td></td><td></td></tr></table>				DRAWING REVISIONS				REV	DESCRIPTION	DATE	BY	00	INITIAL DRAWINGS	05/19/2025	SK	01	ALARM HORN	06/18/2025	SN	A	AS-BUILT	11/13/2025	LB																									25K Amazon Cross-Belt Sort Center (ACBSC) UL16_3_VFD1/UL16_4_VFD1/ UL16_5_VFD1/UL16_6_VFD1 IO DRAWINGS				2429-AMZ-MTN6-MCM02-618			
DRAWING REVISIONS																																																							
REV	DESCRIPTION	DATE	BY																																																				
00	INITIAL DRAWINGS	05/19/2025	SK																																																				
01	ALARM HORN	06/18/2025	SN																																																				
A	AS-BUILT	11/13/2025	LB																																																				
												AMAZON MTN6 SPARROWS POINT, MD				D-SIZE SCALE																																							
												NTS				JOB NUMBER																																							
												A				2429																																							
																REVISION																																							
																SHEET																																							
																76																																							

11/21/2025 9:16 PM

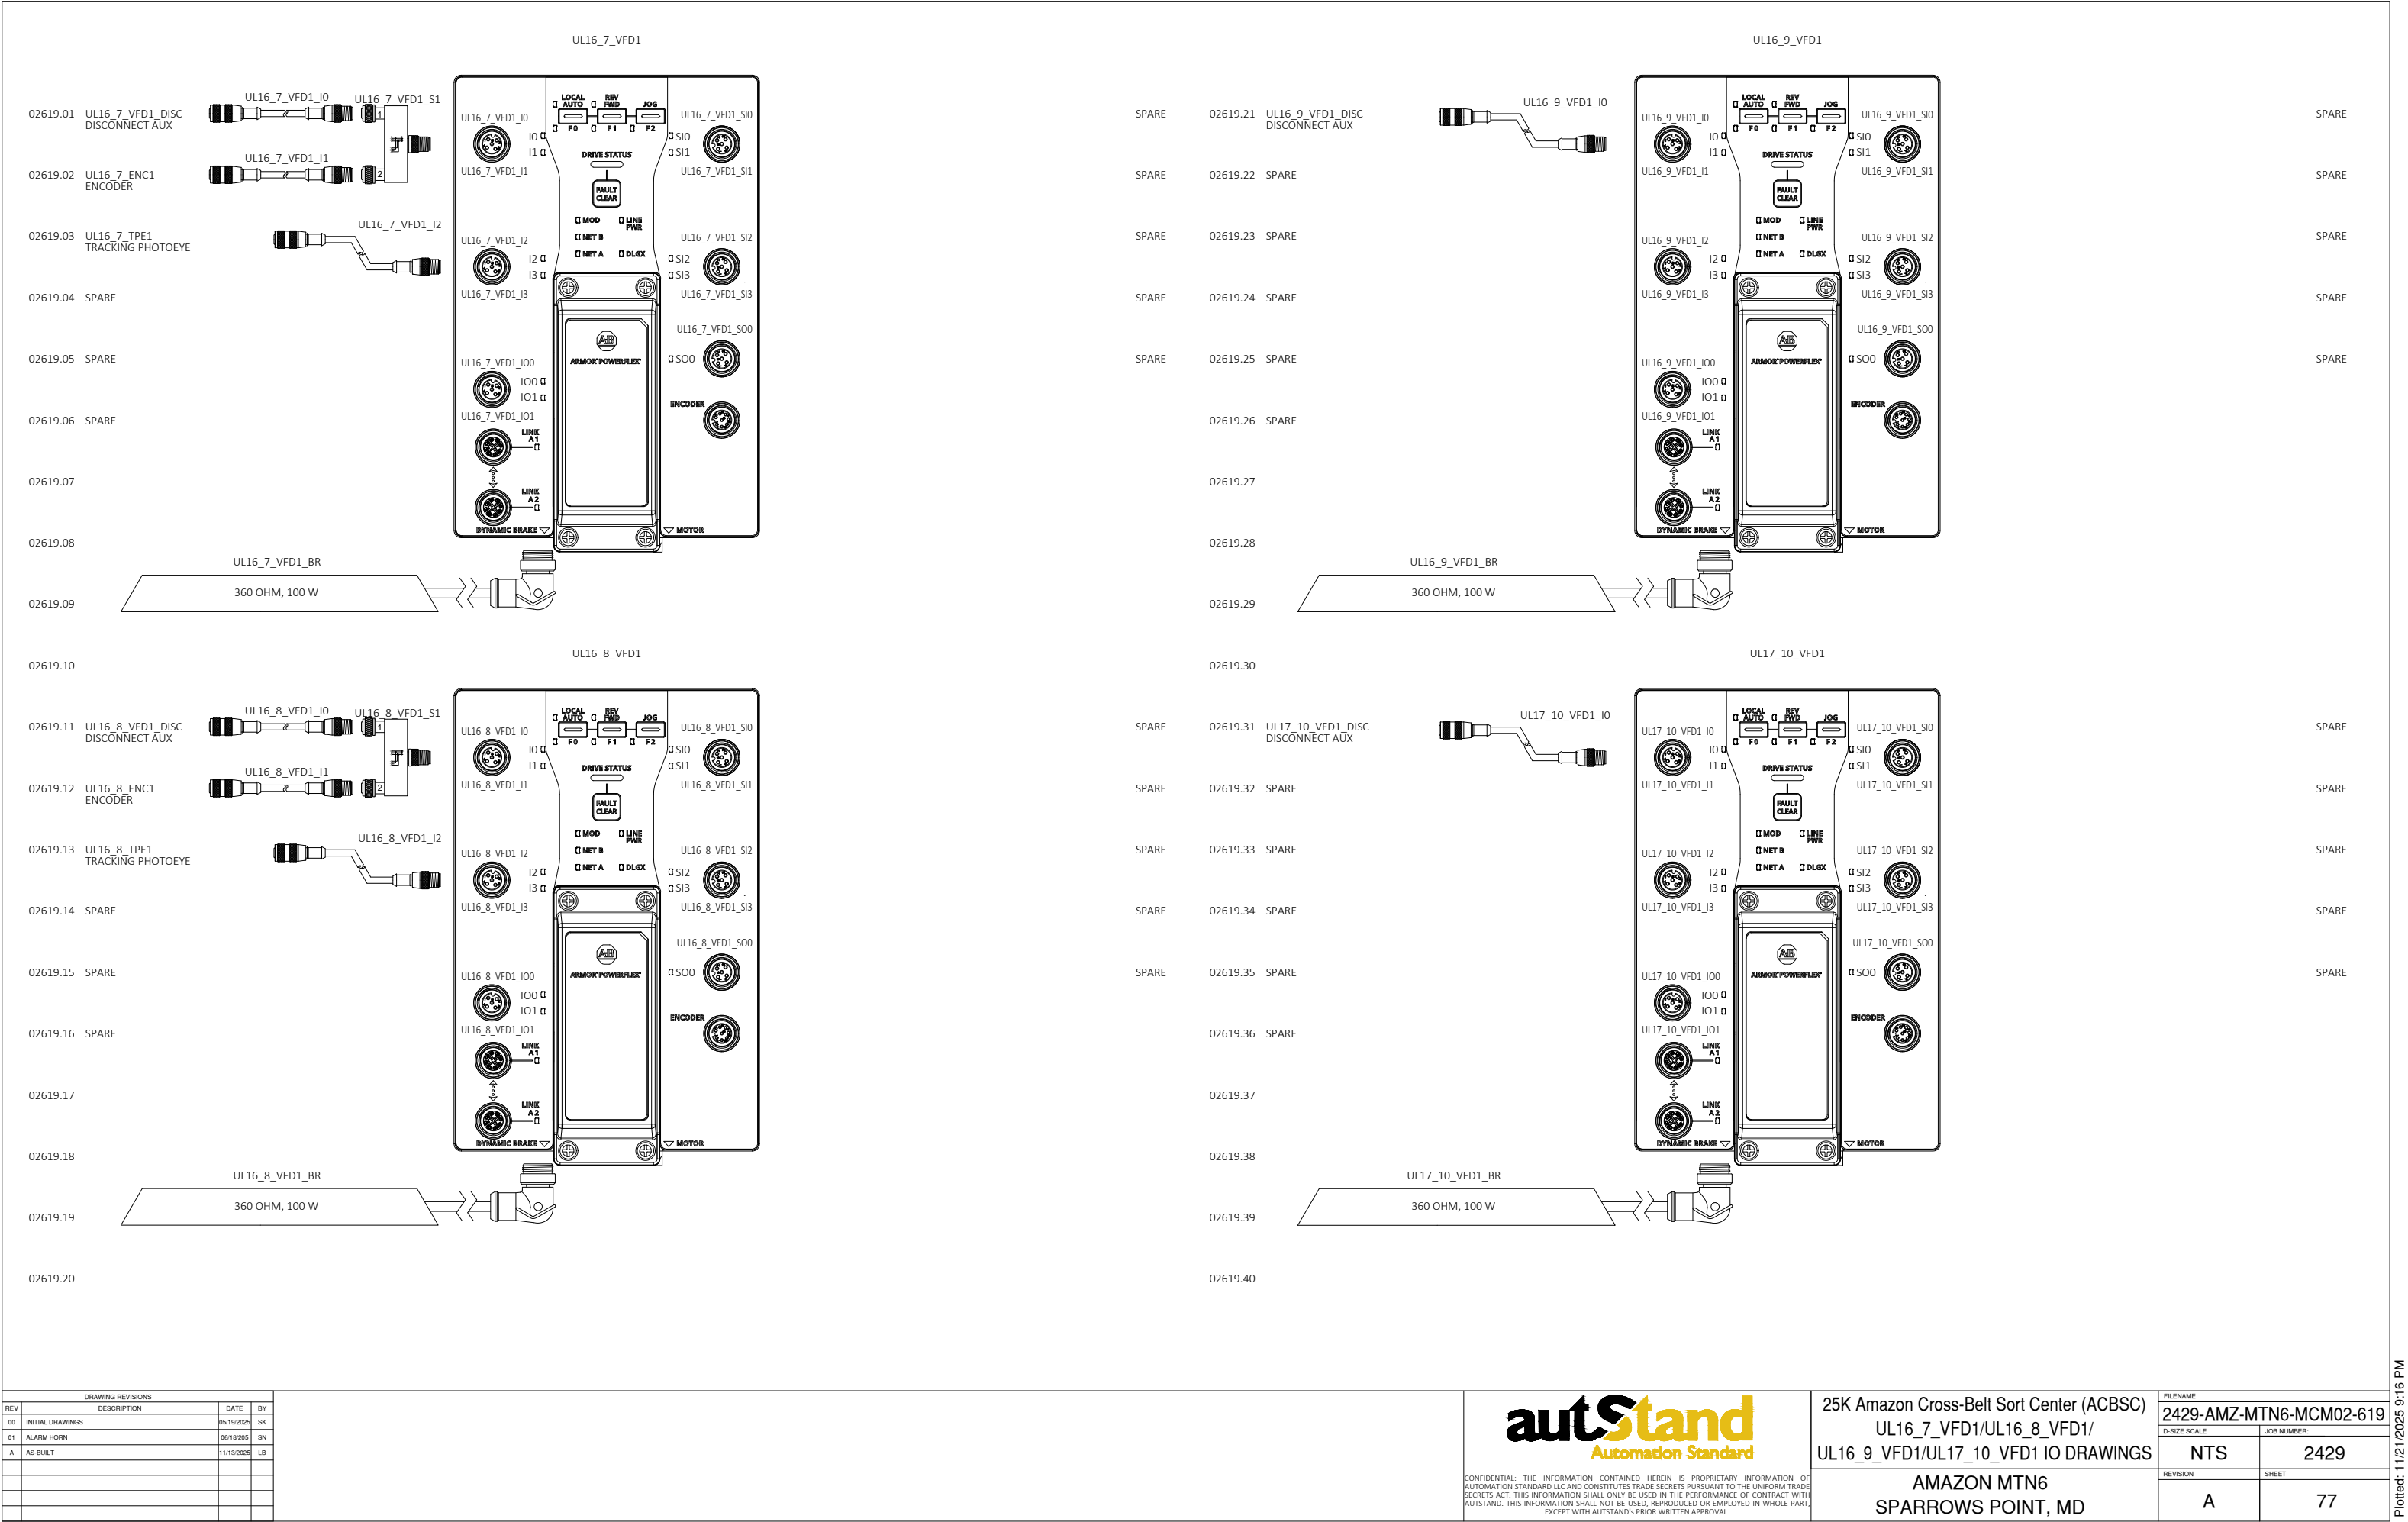

SPARE

02619.21

UL16_9_VFD1_DISC
DISCONNECT AUX

UL16_9_VFD1_I0

SPARE

02619.22

SPARE

SPARE

02619.23

SPARE

SPARE

02619.24

SPARE

SPARE

02619.25

SPARE

02619.26

SPARE

02619.27

02619.28

02619.29

UL16_9_VFD1_BR
360 OHM, 100 W

02619.30

UL16_9_VFD1

UL16_9_VFD1_I0

UL16_9_VFD1_I1

UL16_9_VFD1_I2

UL16_9_VFD1_I3

UL16_9_VFD1_I00

UL16_9_VFD1_I01

LINK A1

LINK A2

DYNAMIC BRAKE

UL16_9_VFD1_S10

UL16_9_VFD1_S11

UL16_9_VFD1_S12

UL16_9_VFD1_S13

UL16_9_VFD1_S00

ENCODER

MOTOR

SPARE

02619.31

UL17_10_VFD1_DISC
DISCONNECT AUX

UL17_10_VFD1_I0

SPARE

02619.32

SPARE

SPARE

02619.33

SPARE

SPARE

02619.34

SPARE

SPARE

02619.35

SPARE

02619.36

SPARE

02619.37

02619.38

02619.39

UL17_10_VFD1_BR
360 OHM, 100 W

02619.40

UL17_10_VFD1

UL17_10_VFD1_I0

UL17_10_VFD1_I1

UL17_10_VFD1_I2

UL17_10_VFD1_I3

UL17_10_VFD1_I00

UL17_10_VFD1_I01

LINK A1

LINK A2

DYNAMIC BRAKE

UL17_10_VFD1_S10

UL17_10_VFD1_S11

UL17_10_VFD1_S12

UL17_10_VFD1_S13

UL17_10_VFD1_S00

ENCODER

MOTOR

autStand

Automation Standard

CONFIDENTIAL: THE INFORMATION CONTAINED HEREIN IS PROPRIETARY INFORMATION OF AUTOMATION STANDARD LLC AND CONSTITUTES TRADE SECRETS PURSUANT TO THE UNIFORM TRADE SECRETS ACT. THIS INFORMATION SHALL ONLY BE USED IN THE PERFORMANCE OF CONTRACT WITH AUTISTAND. THIS INFORMATION SHALL NOT BE USED, REPRODUCED OR EMPLOYED IN WHOLE PART, EXCEPT WITH AUTISTAND'S PRIOR WRITTEN APPROVAL.


25K Amazon Cross-Belt Sort Center (ACBSC)

UL16_7_VFD1/UL16_8_VFD1/
UL16_9_VFD1/UL17_10_VFD1 IO DRAWINGS

AMAZON MTN6
SPARROWS POINT, MD

FILENAME	
2429-AMZ-MTN6-MCM02-619	
D-SIZE SCALE	JOB NUMBER
NTS	2429
REVISION	SHEET
A	77

Plotted: 11/21/2025 9:16 PM

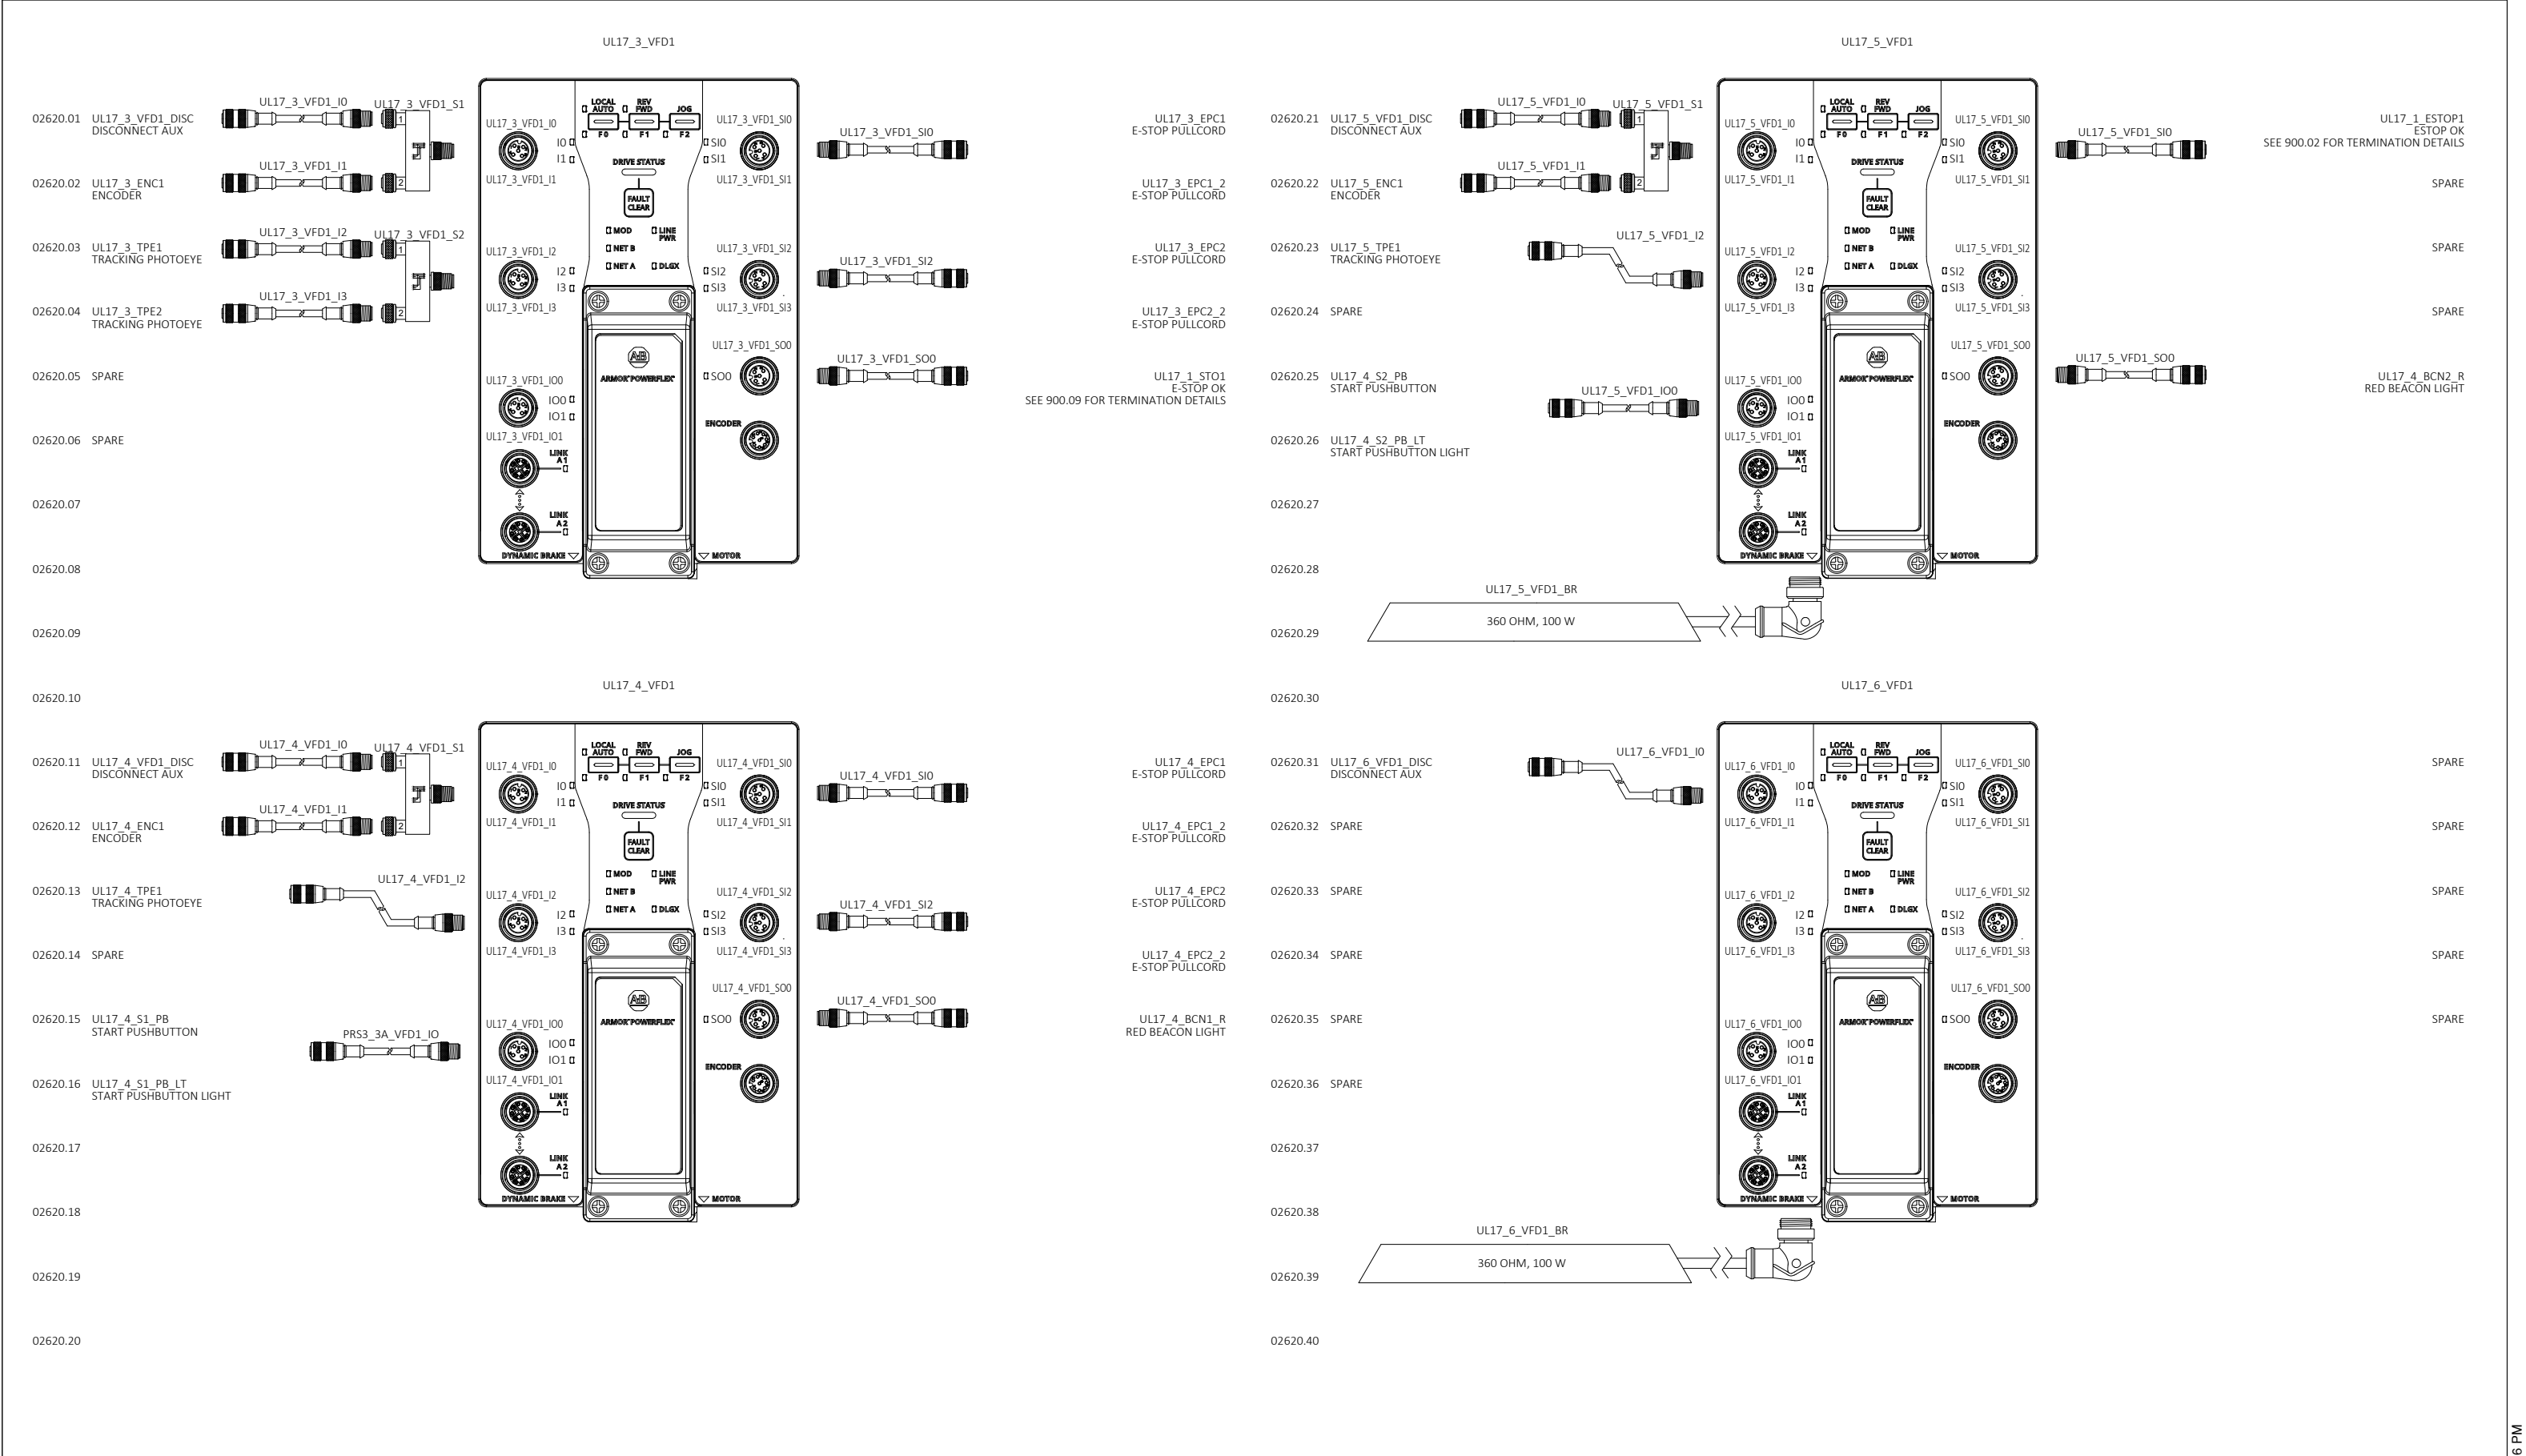

UL17_5_VFD1

02620.21

UL17_5_VFD1_DISC
DISCONNECT AUX

UL17_5_VFD1_I0

UL17_5_VFD1_S1

02620.22

UL17_5_ENC1
ENCODER

UL17_5_VFD1_I1

2

02620.23

UL17_5_TPE1
TRACKING PHOTOEYE

UL17_5_VFD1_I2

02620.24

SPARE

02620.25

UL17_4_S2_PB
START PUSHBUTTON

UL17_5_VFD1_I00

02620.26

UL17_4_S2_PB_LT
START PUSHBUTTON LIGHT

02620.27

02620.28

02620.29

02620.30

02620.31

UL17_6_VFD1_DISC
DISCONNECT AUX

UL17_6_VFD1_I0

02620.32

SPARE

02620.33

SPARE

02620.34

SPARE

02620.35

SPARE

02620.36

SPARE

02620.37

02620.38

02620.39

02620.40

UL17_5_VFD1

UL17_5_VFD1_I0

UL17_5_VFD1_I1

UL17_5_VFD1_I2

UL17_5_VFD1_I3

UL17_5_VFD1_I00

UL17_5_VFD1_I01

LINK A1

LINK A2

DYNAMIC BRAKE

LOCAL
F0

REV
F1

FWD
F2

DRIVE STATUS

FAULT
CLEAR

MOD

NET B

NET A

LINE
PWR

DLGX

ARMOR POWERFLDT

ENCODER

MOTOR

UL17_5_VFD1_S10

UL17_5_VFD1_S11

UL17_5_VFD1_S12

UL17_5_VFD1_S13

UL17_5_VFD1_S00

UL17_5_VFD1_S10

UL17_5_VFD1_S11

UL17_5_VFD1_S12

UL17_5_VFD1_S13

UL17_5_VFD1_S00

UL17_5_VFD1_S10

UL17_5_VFD1_S12

UL17_5_VFD1_S00

UL17_1_ESTOP1
ESTOP OK

SEE 900.02 FOR TERMINATION DETAILS

SPARE

SPARE

SPARE

UL17_4_BCN2_R
RED BEACON LIGHT

UL17_5_VFD1_BR

360 OHM, 100 W

UL17_6_VFD1

UL17_6_VFD1_I0

UL17_6_VFD1_I1

UL17_6_VFD1_I2

UL17_6_VFD1_I3

UL17_6_VFD1_I00

UL17_6_VFD1_I01

LINK A1

LINK A2

DYNAMIC BRAKE

LOCAL
F0

REV
F1

FWD
F2

DRIVE STATUS

FAULT
CLEAR

MOD

NET B

NET A

LINE
PWR

DLGX

ARMOR POWERFLDT

ENCODER

MOTOR

UL17_6_VFD1_S10

UL17_6_VFD1_S11

UL17_6_VFD1_S12

UL17_6_VFD1_S13

UL17_6_VFD1_S00

UL17_6_VFD1_S10

UL17_6_VFD1_S11

UL17_6_VFD1_S12

UL17_6_VFD1_S13

UL17_6_VFD1_S00

UL17_6_VFD1_S10

UL17_6_VFD1_S12

UL17_6_VFD1_S00

UL17_6_VFD1_BR

360 OHM, 100 W

DRAWING REVISIONS							FILENAME	
REV	DESCRIPTION	DATE	BY				2429-AMZ-MTN6-MCM02-620	
00	INITIAL DRAWINGS	05/19/2025	SK				D-SIZE SCALE	JOB NUMBER
01	ALARM HORN	06/18/2025	SN				NTS	2429
A	AS-BUILT	11/13/2025	LB				REVISION	SHEET
							A	78

autStand





Automation Standard

CONFIDENTIAL: THE INFORMATION CONTAINED HEREIN IS PROPRIETARY INFORMATION OF AUTOMATION STANDARD LLC AND CONSTITUTES TRADE SECRETS PURSUANT TO THE UNIFORM TRADE SECRETS ACT. THIS INFORMATION SHALL ONLY BE USED IN THE PERFORMANCE OF CONTRACT WITH AUTISTAND. THIS INFORMATION SHALL NOT BE USED, REPRODUCED OR EMPLOYED IN WHOLE PART, EXCEPT WITH AUTISTAND'S PRIOR WRITTEN APPROVAL.

25K Amazon Cross-Belt Sort Center (ACBSC)

UL17_3_VFD1/UL17_4_VFD1/
UL17_5_VFD1/UL17_6_VFD1 IO DRAWINGS

AMAZON MTN6
SPARROWS POINT, MD

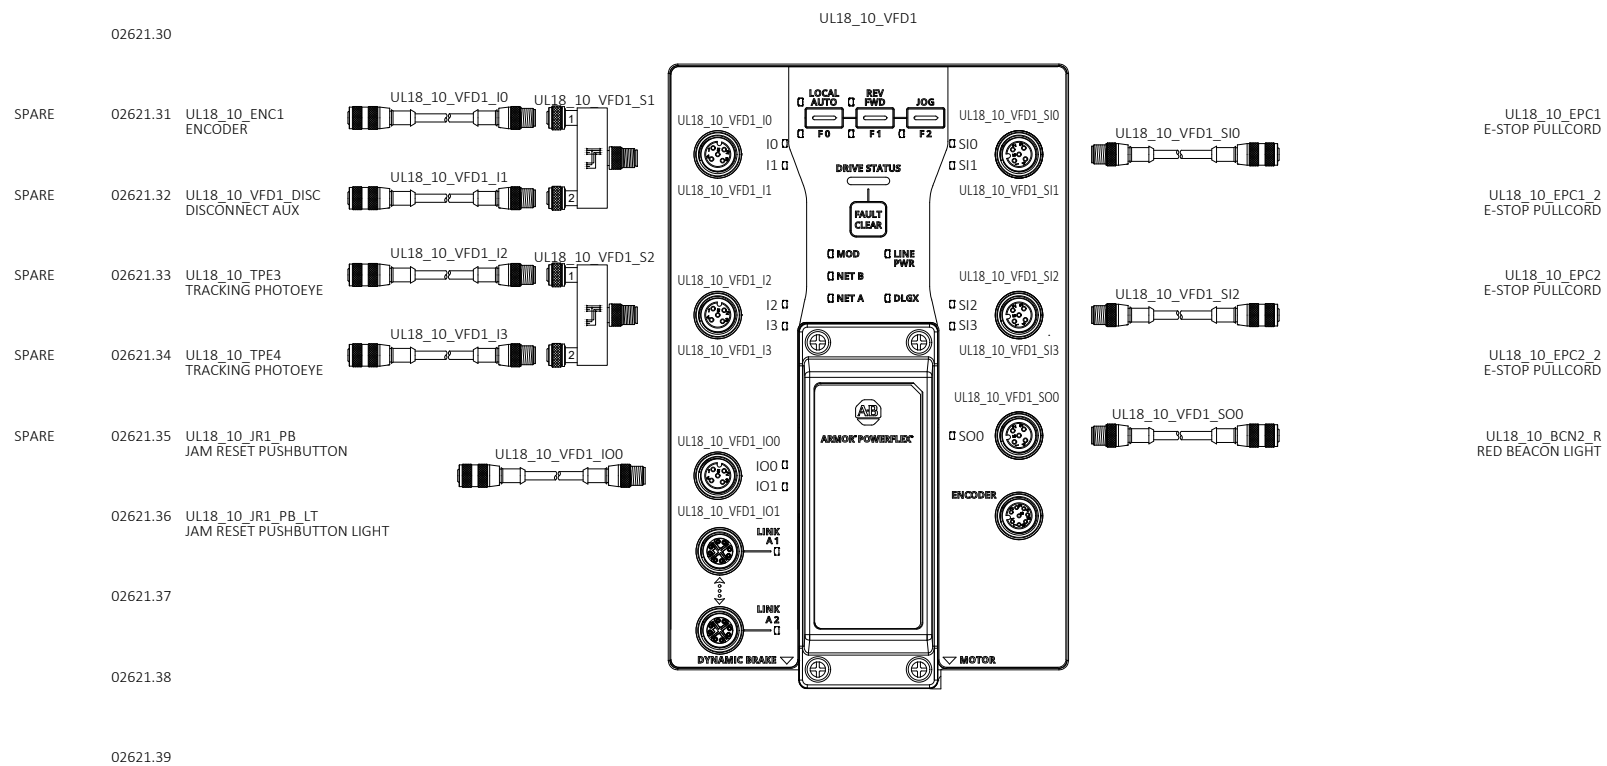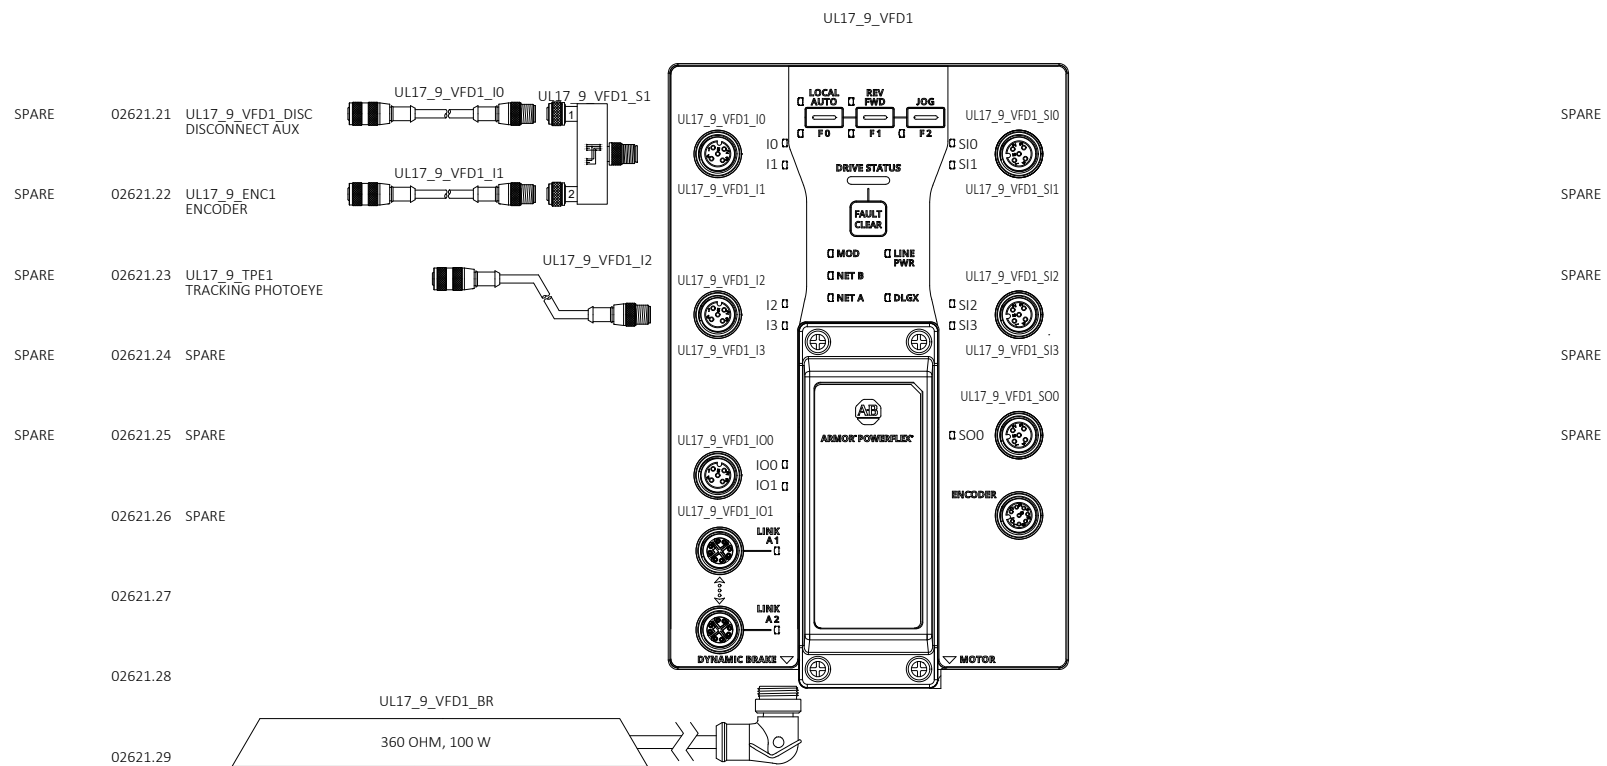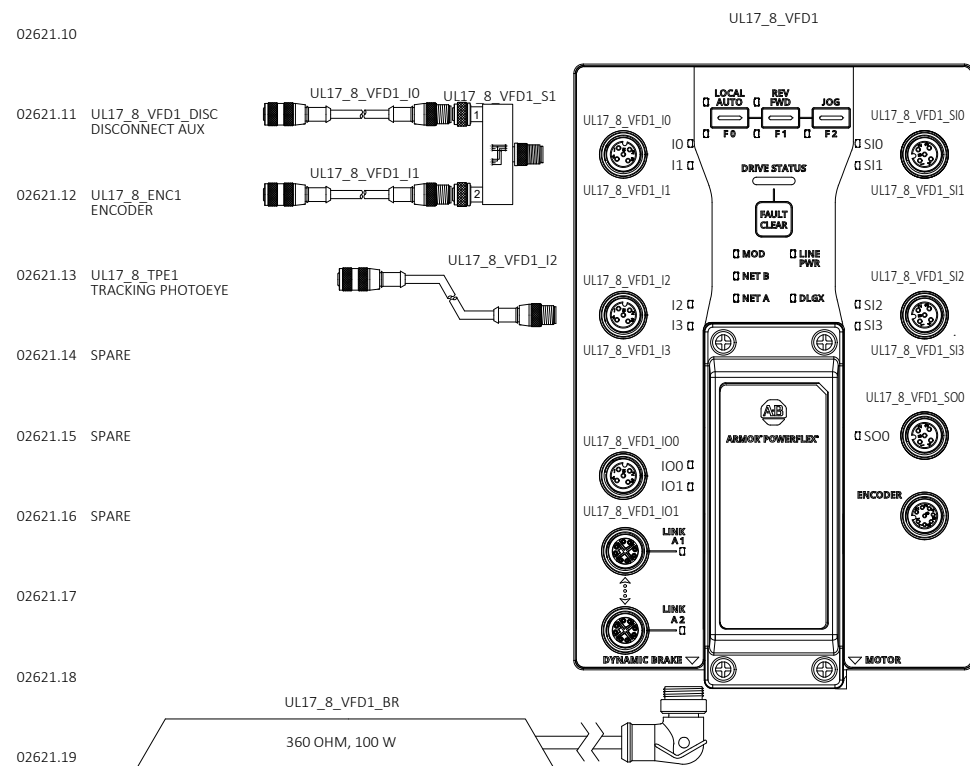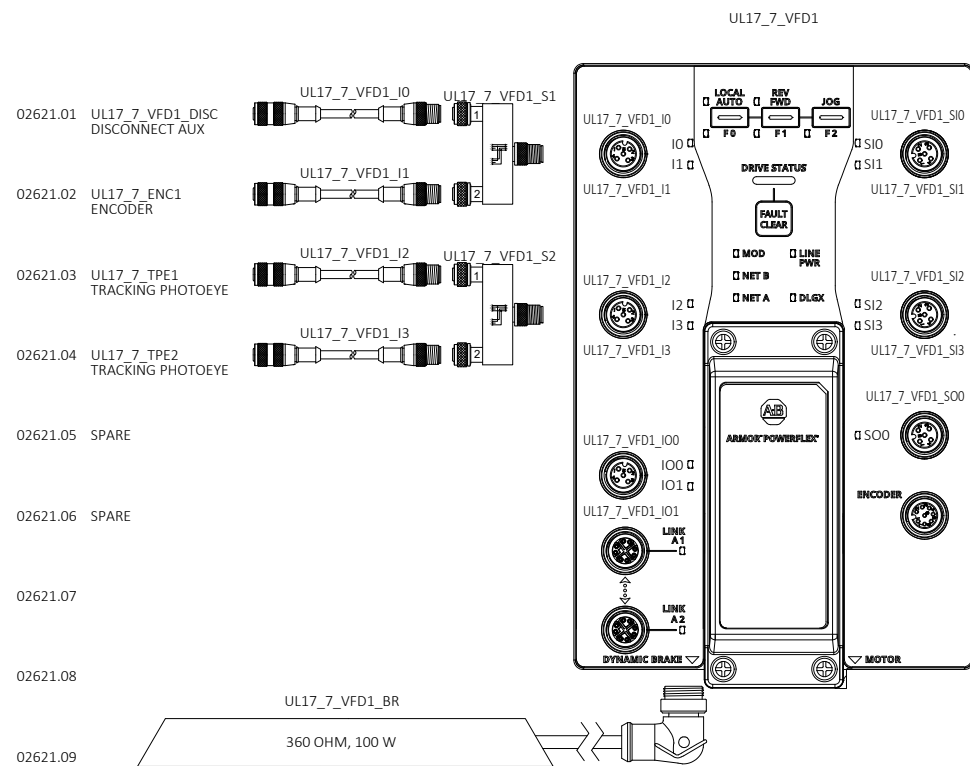











DRAWING REVISIONS			
REV	DESCRIPTION	DATE	BY
00	INITIAL DRAWINGS	05/19/2025	SK
01	ALARM HORN	06/18/2025	SN
A	AS-BUILT	11/13/2025	LB



CONFIDENTIAL: THE INFORMATION CONTAINED HEREIN IS PROPRIETARY INFORMATION OF AUTOMATION STANDARD LLC AND CONSTITUTES TRADE SECRETS PURSUANT TO THE UNIFORM TRADE SECRETS ACT. THIS INFORMATION SHALL ONLY BE USED IN THE PERFORMANCE OF CONTRACT WITH AUTOSTAND. THIS INFORMATION SHALL NOT BE USED, REPRODUCED OR EMPLOYED IN WHOLE PART EXCEPT WITH AUTOSTAND'S PRIOR WRITTEN APPROVAL.

25K Amazon Cross-Belt Sort Center (ACBSC) UL17_7_VFD1/UL17_8_VFD1/ UL17_9_VFD1/UL18_10_VFD1 IO DRAWINGS
AMAZON MTN6 SPARROWS POINT, MD



FILENAME	
2429-AMZ-MTN6-MCM02-621	
D-SIZE SCALE	JOB NUMBER:
NTS	2429
REVISION	SHEET
A	79

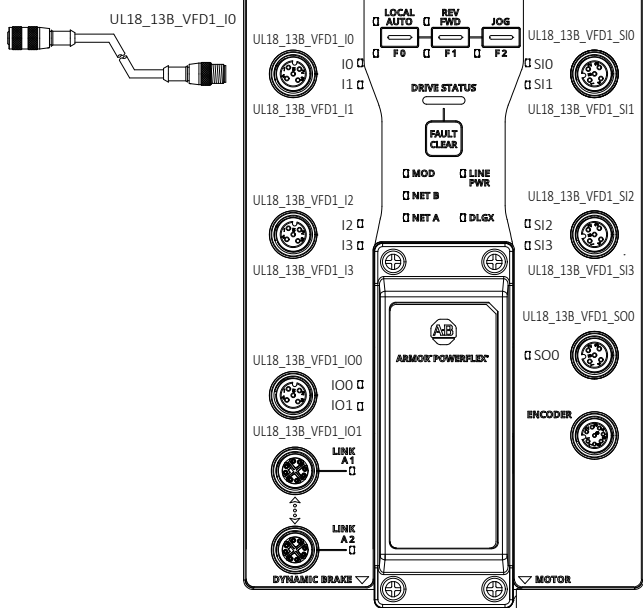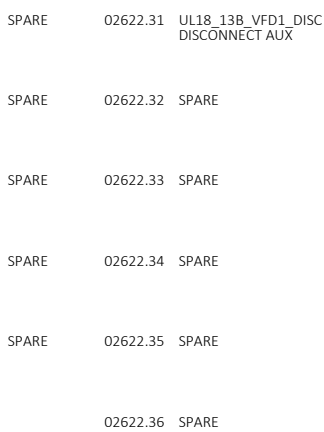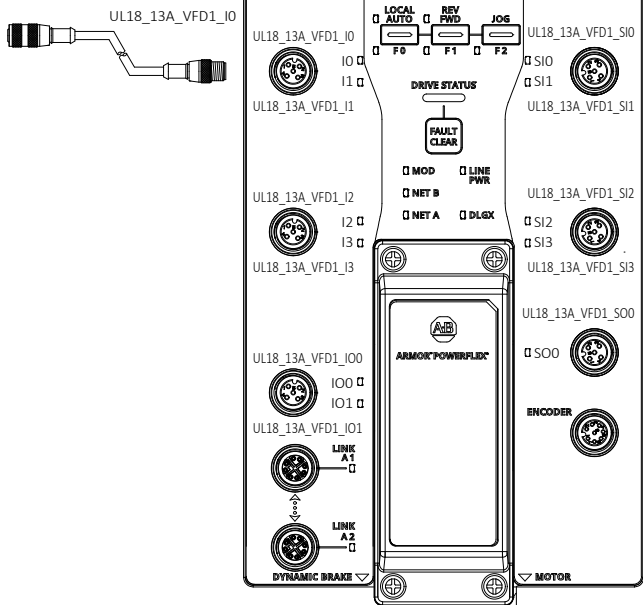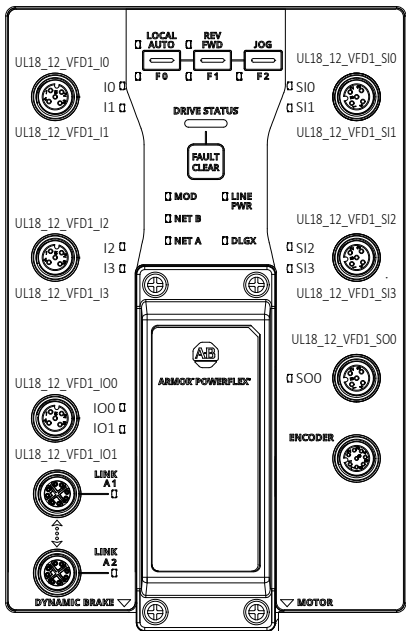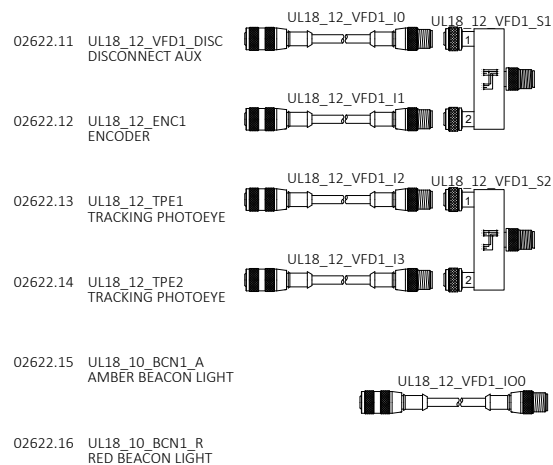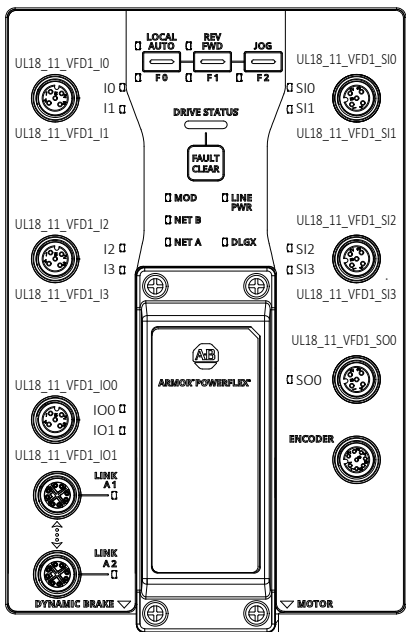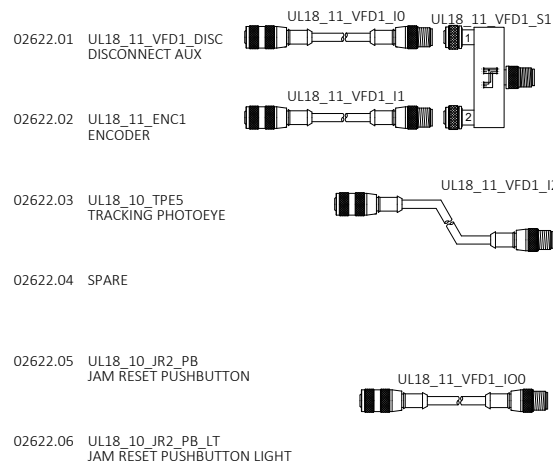   







DRAWING REVISIONS			
REV	DESCRIPTION	DATE	BY
00	INITIAL DRAWINGS	05/19/2025	SK
01	ALARM HORN	06/18/2025	SN
A	AS-BUILT	11/13/2025	LB

	25K Amazon Cross-Belt Sort Center (ACBSC)	FILENAME	
	UL18_11_VFD1/UL18_12_VFD1/	2429-AMZ-MTN6-MCM02-622	
	UL18_13A_VFD1/UL18_13B_VFD1 IO DRAWINGS	D-SIZE SCALE	JOB NUMBER:
		NTS	2429
CONFIDENTIAL: THE INFORMATION CONTAINED HEREIN IS PROPRIETARY INFORMATION OF AUTOMATION STANDARD LLC AND CONSTITUTES TRADE SECRETS PURSUANT TO THE UNIFORM TRADE SECRETS ACT. THIS INFORMATION SHALL ONLY BE USED IN THE PERFORMANCE OF CONTRACT WITH AUTOSTAND. THIS INFORMATION SHALL NOT BE USED, REPRODUCED OR EMPLOYED IN WHOLE PART, EXCEPT WITH AUTOSTAND'S PRIOR WRITTEN APPROVAL.	AMAZON MTN6	REVISION	SHEET
	SPARROWS POINT, MD	A	80

Plotted: 11/21/2025 9:17 PM

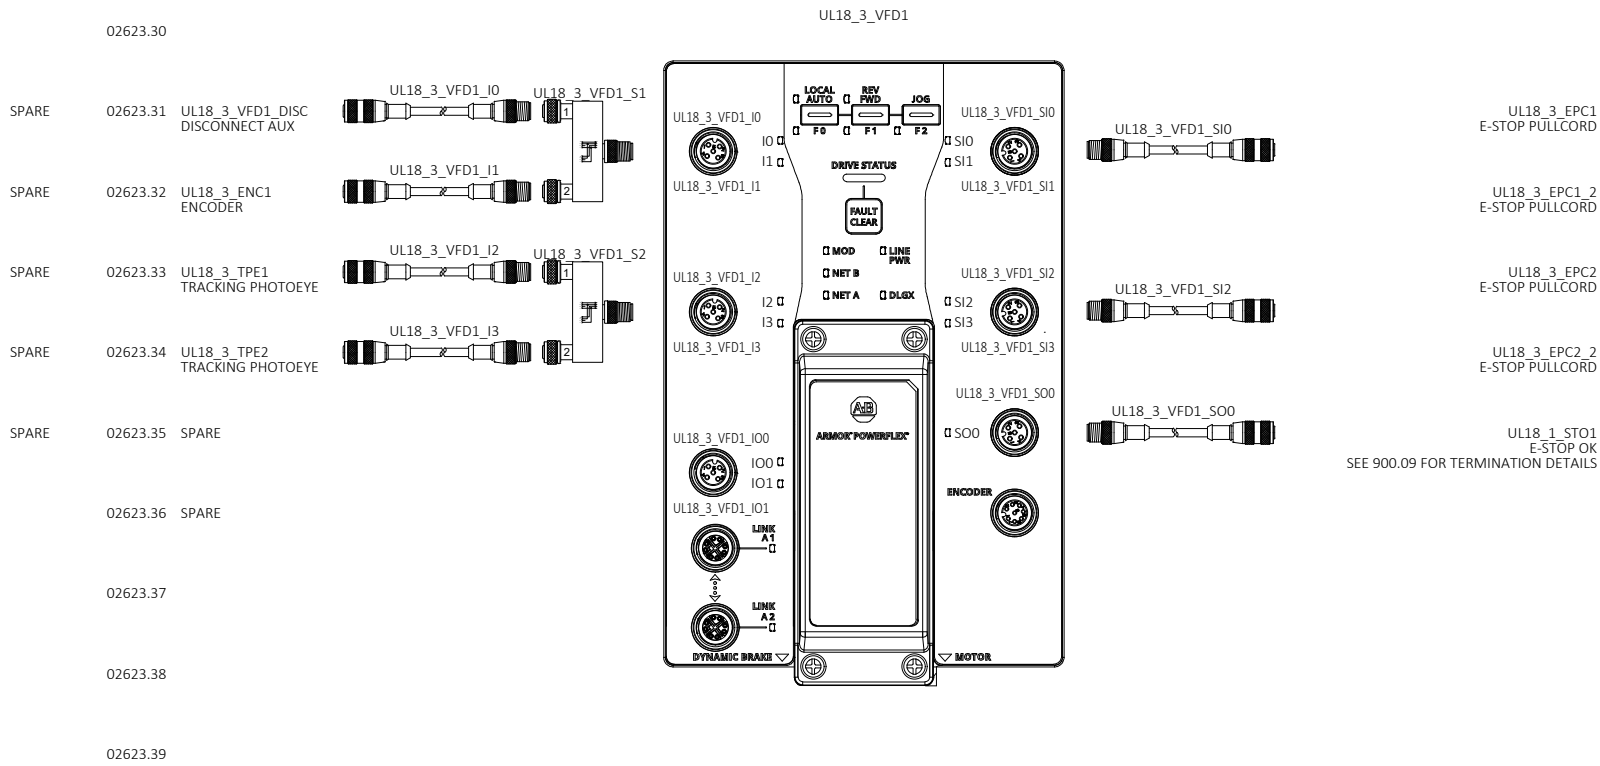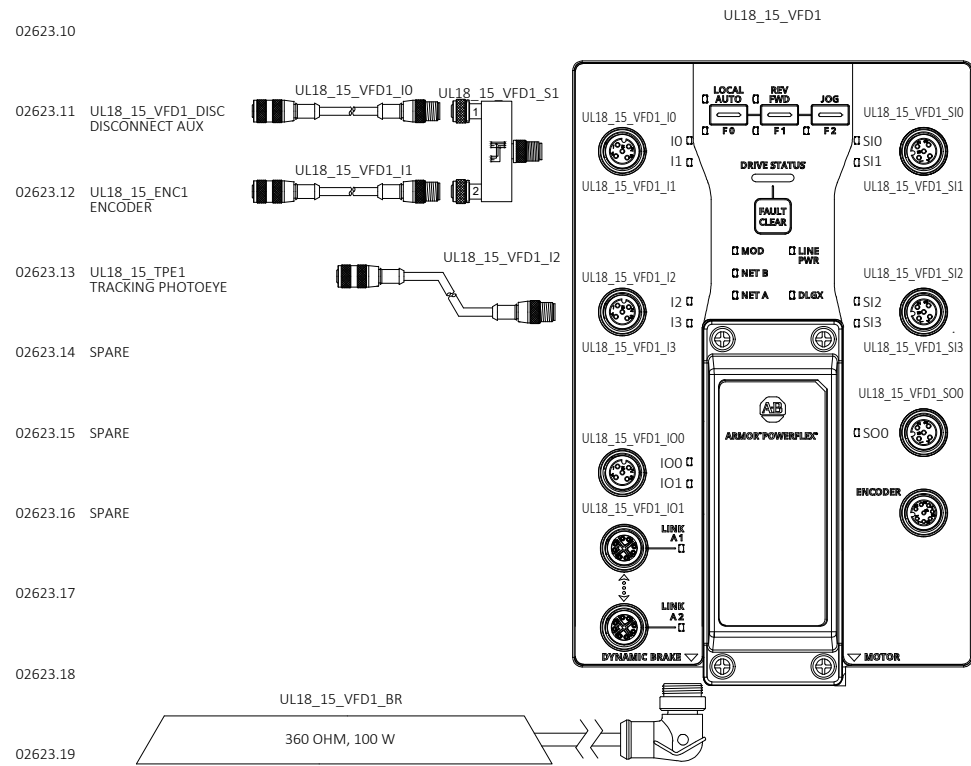

 CONFIDENTIAL: THE INFORMATION CONTAINED HEREIN IS PROPRIETARY INFORMATION OF AUTOMATION STANDARD LLC AND CONSTITUTES TRADE SECRETS PURSUANT TO THE UNIFORM TRADE SECRETS ACT. THIS INFORMATION SHALL ONLY BE USED IN THE PERFORMANCE OF CONTRACT WITH AUTOSTAND. THIS INFORMATION SHALL NOT BE USED, REPRODUCED OR EMPLOYED IN WHOLE PART, EXCEPT WITH AUTOSTAND'S PRIOR WRITTEN APPROVAL.	25K Amazon Cross-Belt Sort Center (ACBSC)	FILENAME	
	UL18_14_VFD1/UL18_15_VFD1/	2429-AMZ-MTN6-MCM02-623	
	UL18_16_VFD1/UL18_3_VFD1 IO DRAWINGS	D-SIZE SCALE	JOB NUMBER:
		NTS	2429
	AMAZON MTN6	REVISION	SHEET
	SPARROWS POINT, MD	A	81

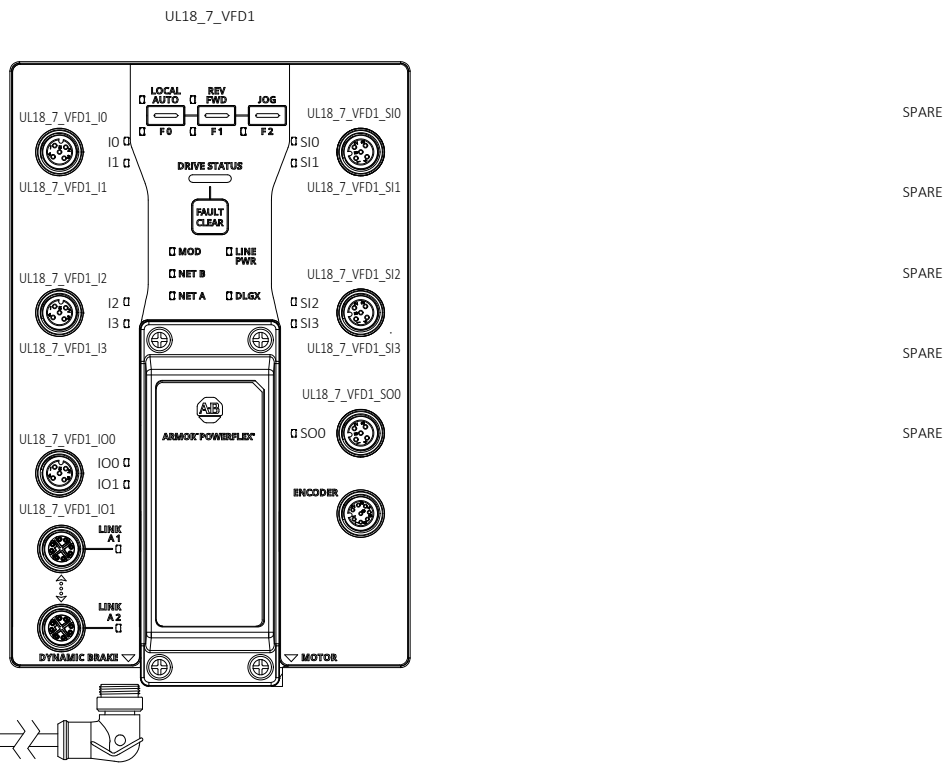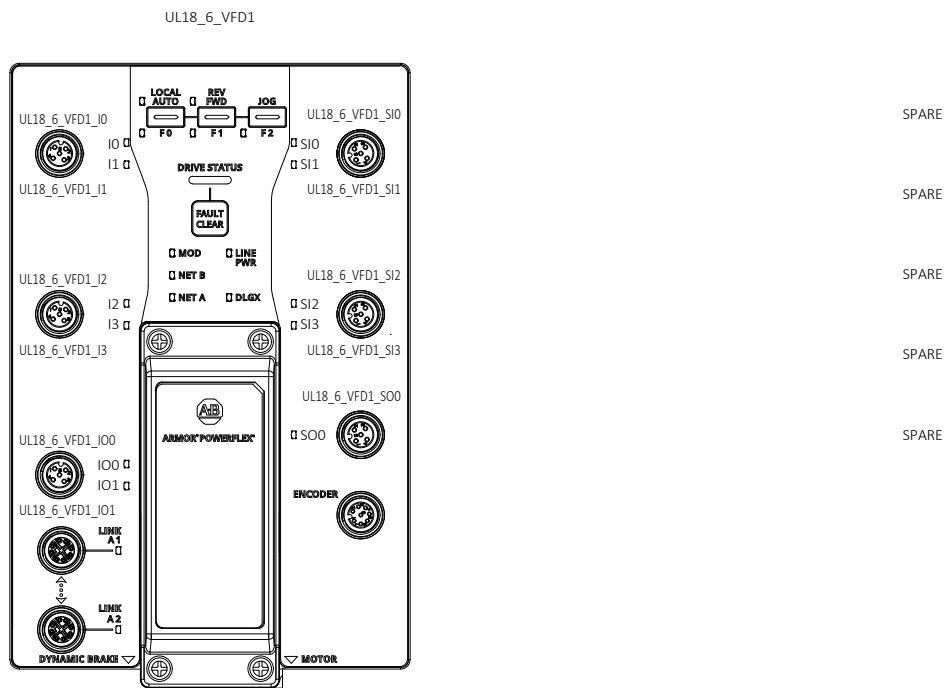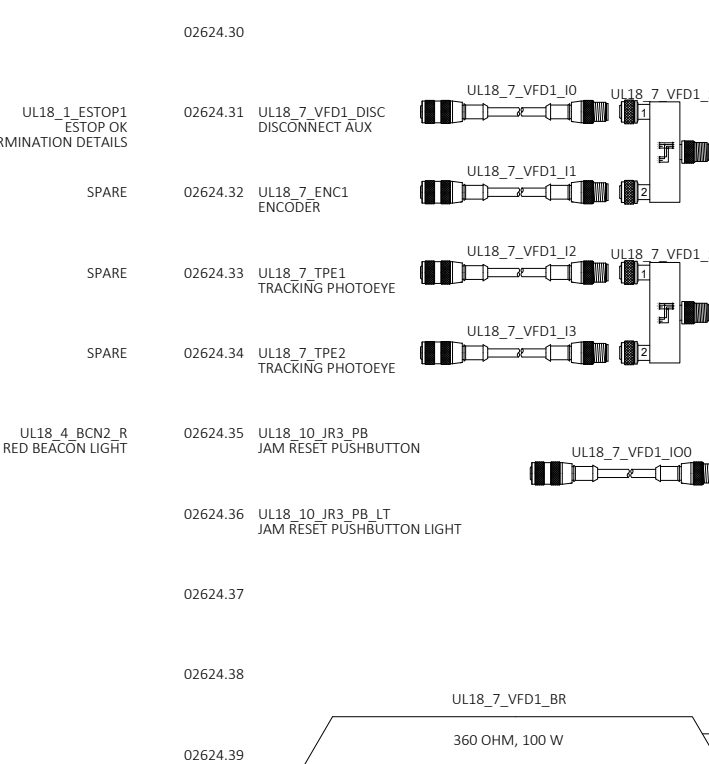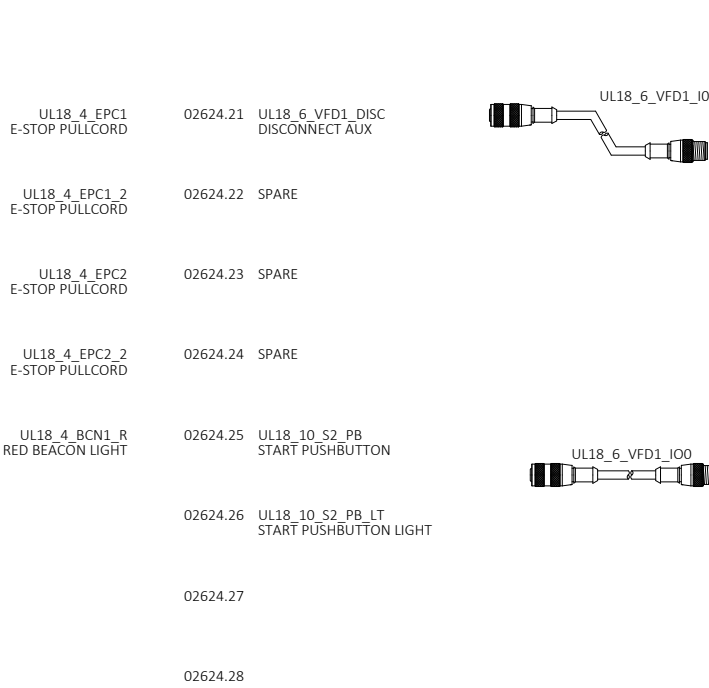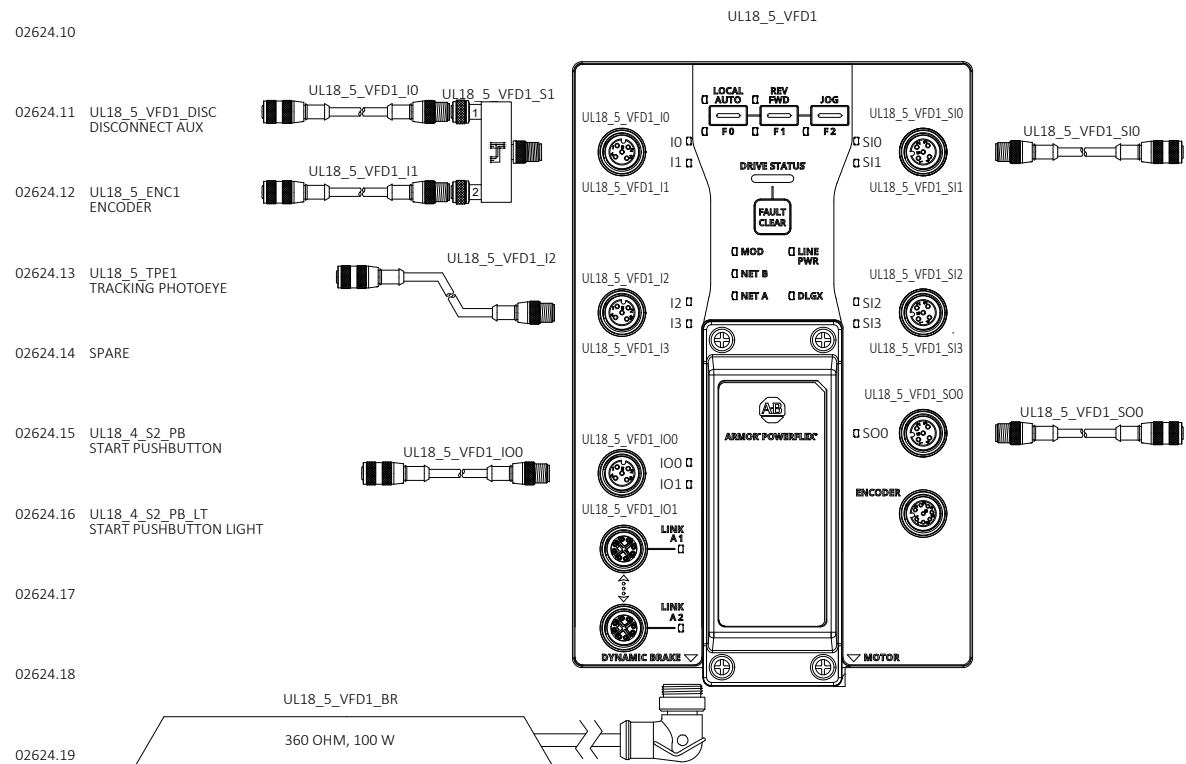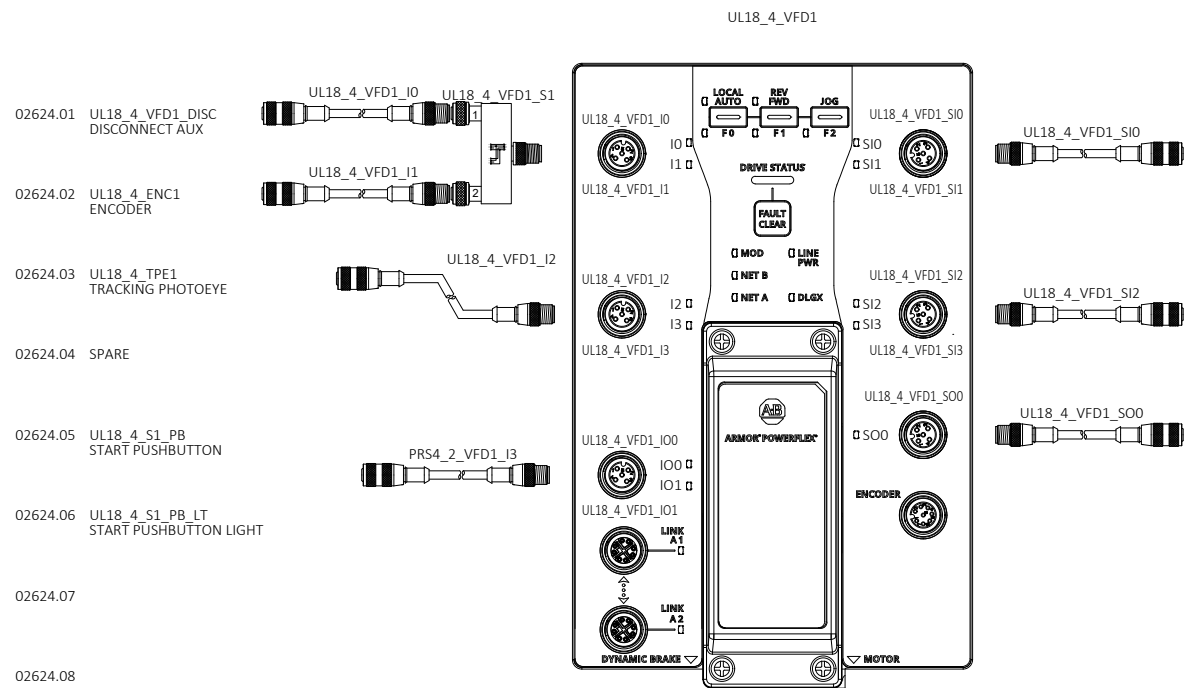

DRAWING REVISIONS			
REV	DESCRIPTION	DATE	BY
00	INITIAL DRAWINGS	05/19/2025	SK
01	ALARM HORN	06/18/2025	SN
A	AS-BUILT	11/13/2025	LB








CONFIDENTIAL: THE INFORMATION CONTAINED HEREIN IS PROPRIETARY INFORMATION OF AUTOMATION STANDARD LLC AND CONSTITUTES TRADE SECRETS PURSUANT TO THE UNIFORM TRADE SECRETS ACT. THIS INFORMATION SHALL ONLY BE USED IN THE PERFORMANCE OF CONTRACT WITH AUTOSTAND. THIS INFORMATION SHALL NOT BE USED, REPRODUCED OR EMPLOYED IN WHOLE PART EXCEPT WITH AUTOSTAND'S PRIOR WRITTEN APPROVAL.

25K Amazon Cross-Belt Sort Center (ACBSC)
UL18_4_VFD1/UL18_5_VFD1/
UL18_6_VFD1/UL18_7_VFD1 IO DRAWINGS

AMAZON MTN6
SPARROWS POINT, MD

FILENAME	
2429-AMZ-MTN6-MCM02-624	
D-SIZE SCALE	JOB NUMBER:
NTS	2429
REVISION	SHEET
A	82

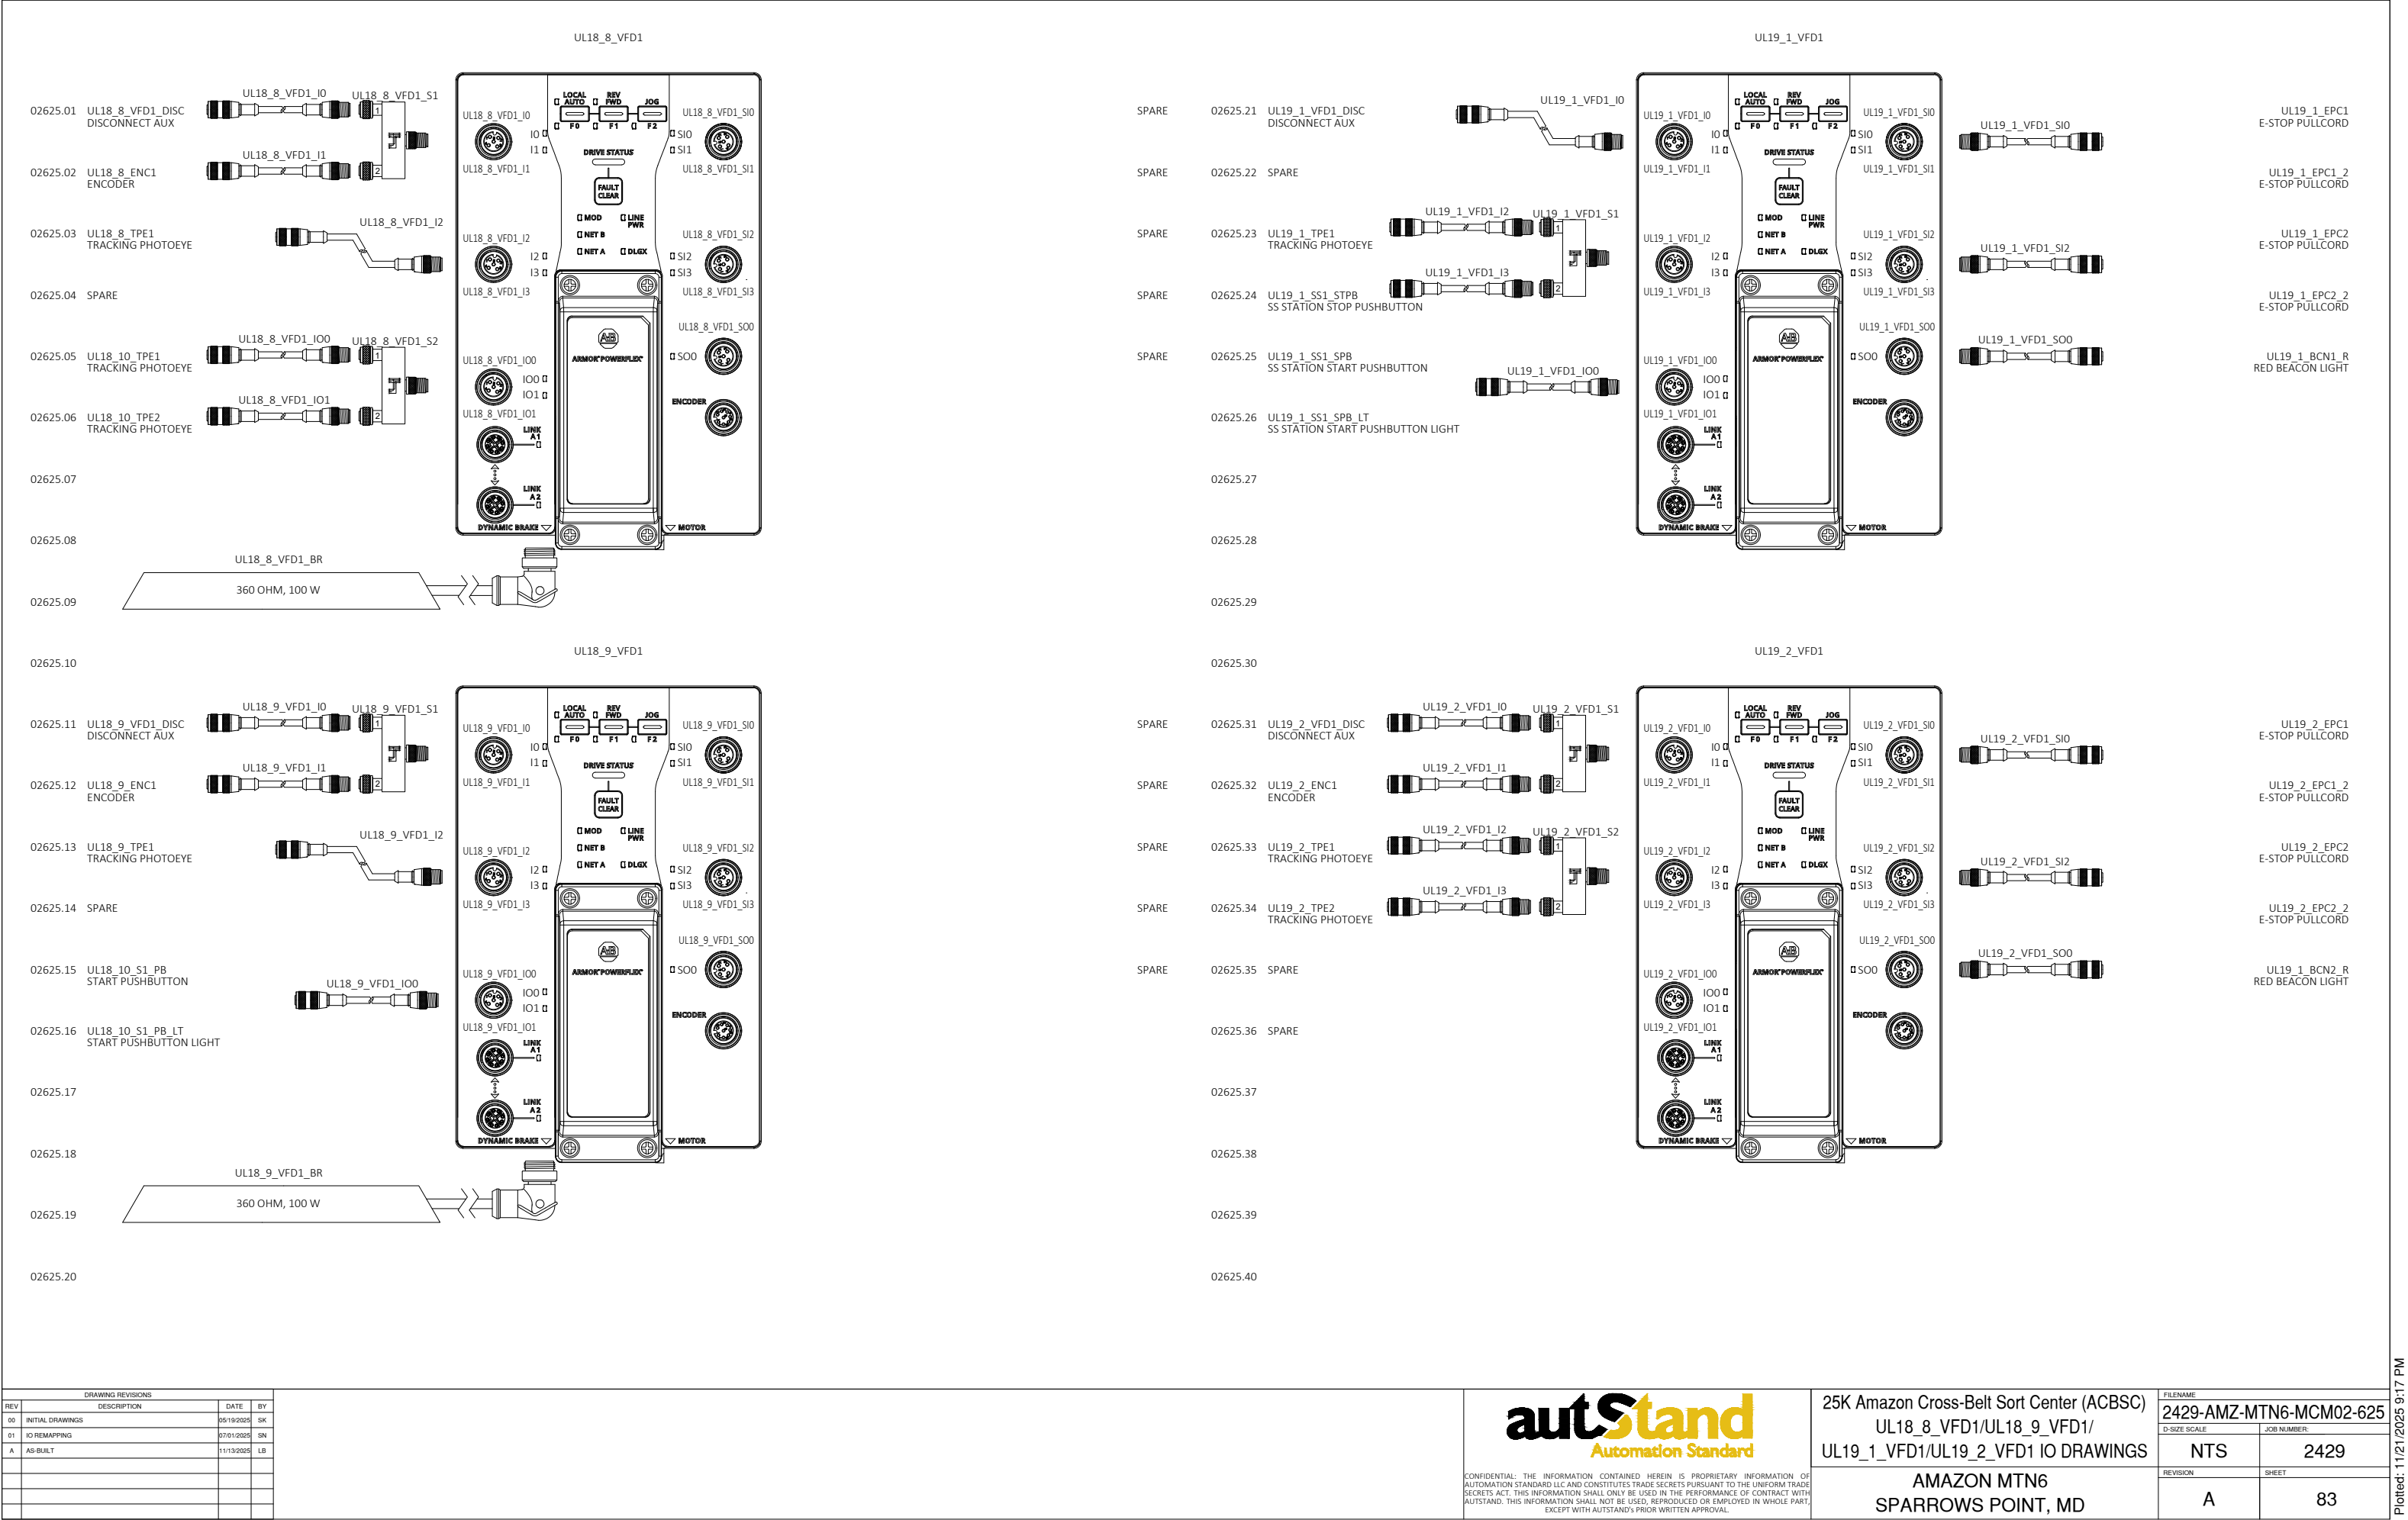

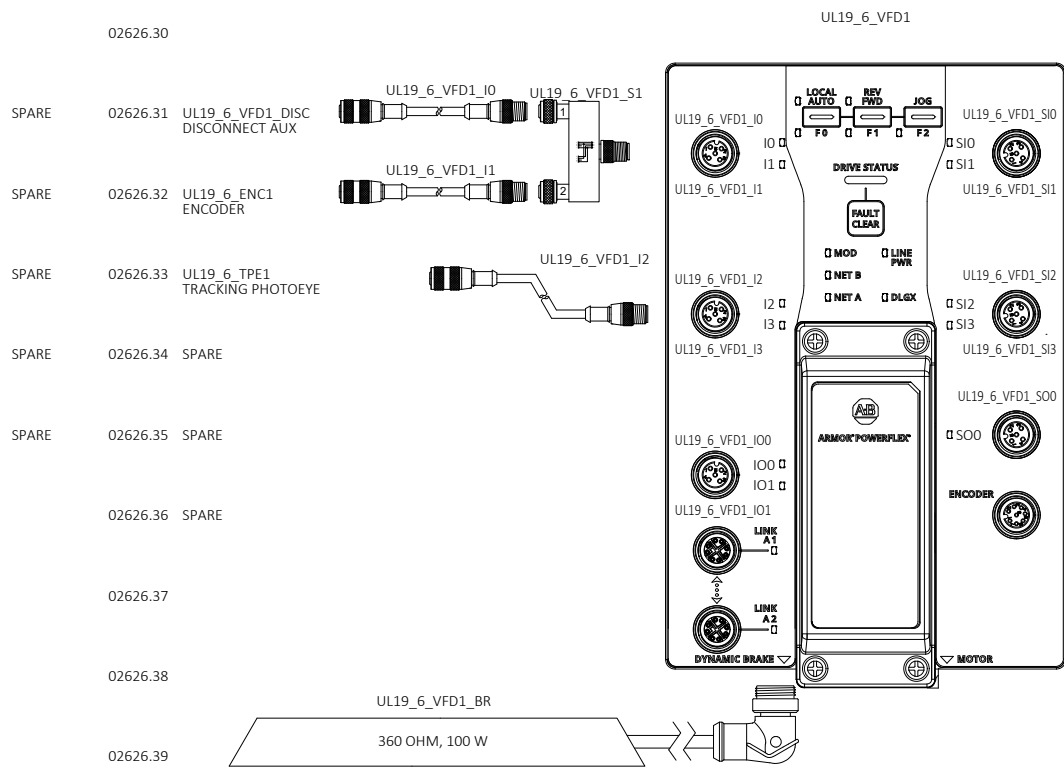
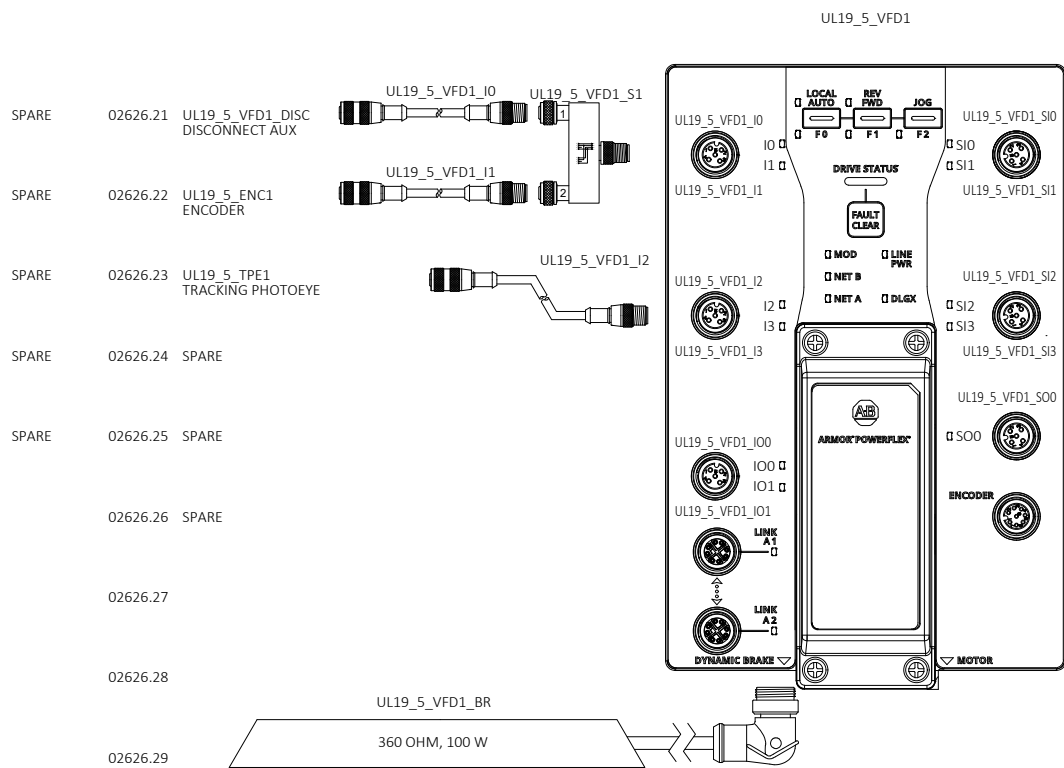
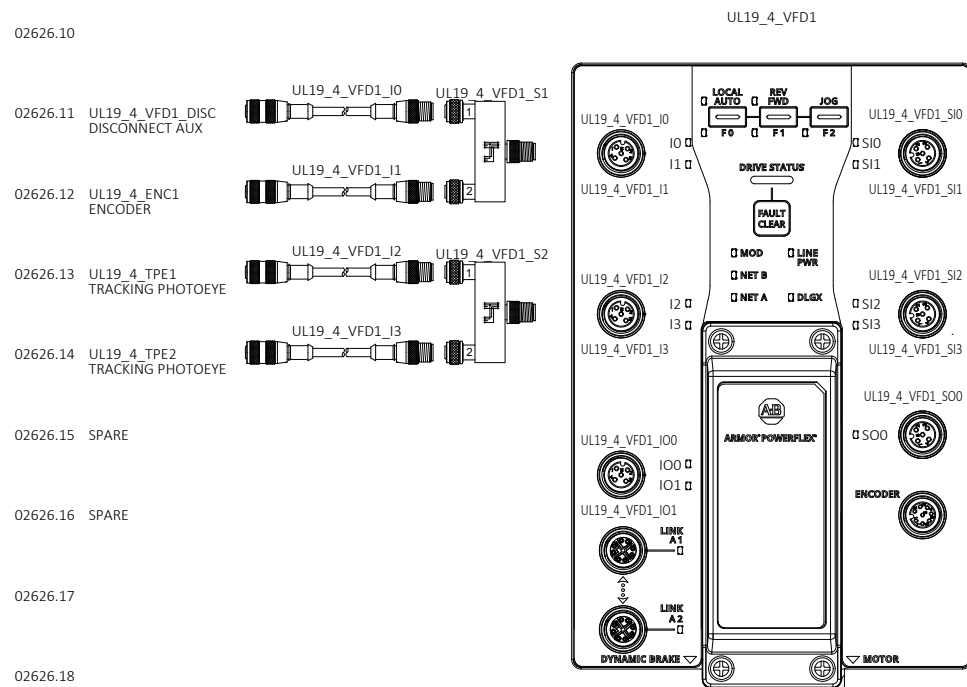
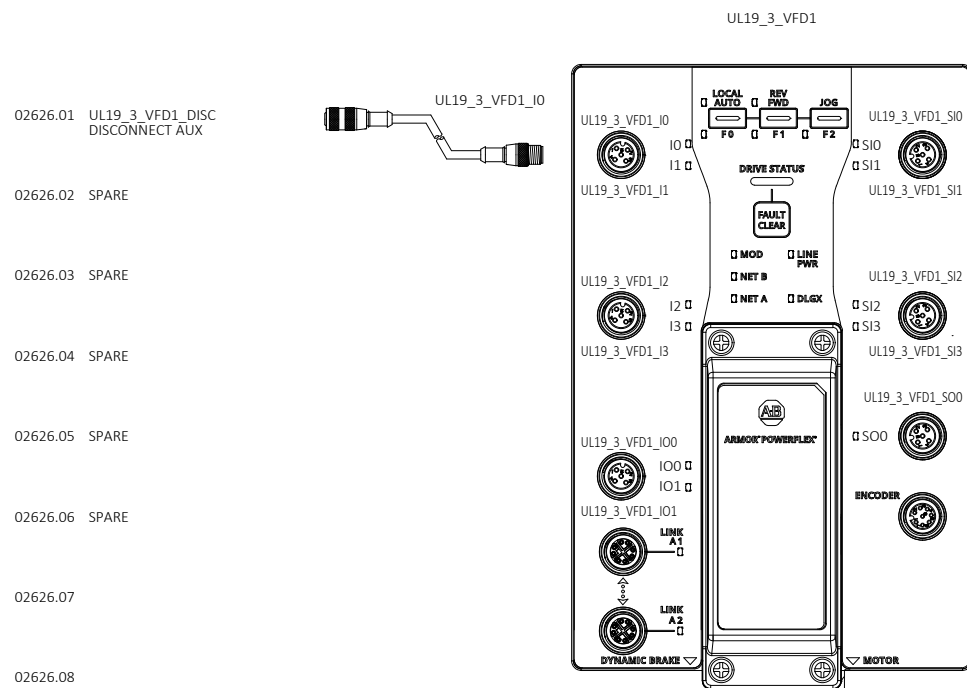


DRAWING REVISIONS			
REV	DESCRIPTION	DATE	BY
00	INITIAL DRAWINGS	05/19/2025	SK
01	ALARM HORN	06/18/2025	SN
A	AS-BUILT	11/13/2025	LB



CONFIDENTIAL: THE INFORMATION CONTAINED HEREIN IS PROPRIETARY INFORMATION OF AUTOMATION STANDARD LLC AND CONSTITUTES TRADE SECRETS PURSUANT TO THE UNIFORM TRADE SECRETS ACT. THIS INFORMATION SHALL ONLY BE USED IN THE PERFORMANCE OF CONTRACT WITH AUTOSTAND. THIS INFORMATION SHALL NOT BE USED, REPRODUCED OR EMPLOYED IN WHOLE PART EXCEPT WITH AUTOSTAND'S PRIOR WRITTEN APPROVAL.

25K Amazon Cross-Belt Sort Center (ACBSC) UL19_3_VFD1/UL19_4_VFD1/ UL19_5_VFD1/UL19_6_VFD1 IO DRAWINGS AMAZON MTN6 SPARROWS POINT, MD	FILENAME 2429-AMZ-MTN6-MCM02-626	
	D-SIZE SCALE NTS	JOB NUMBER: 2429
	REVISION A	SHEET 84

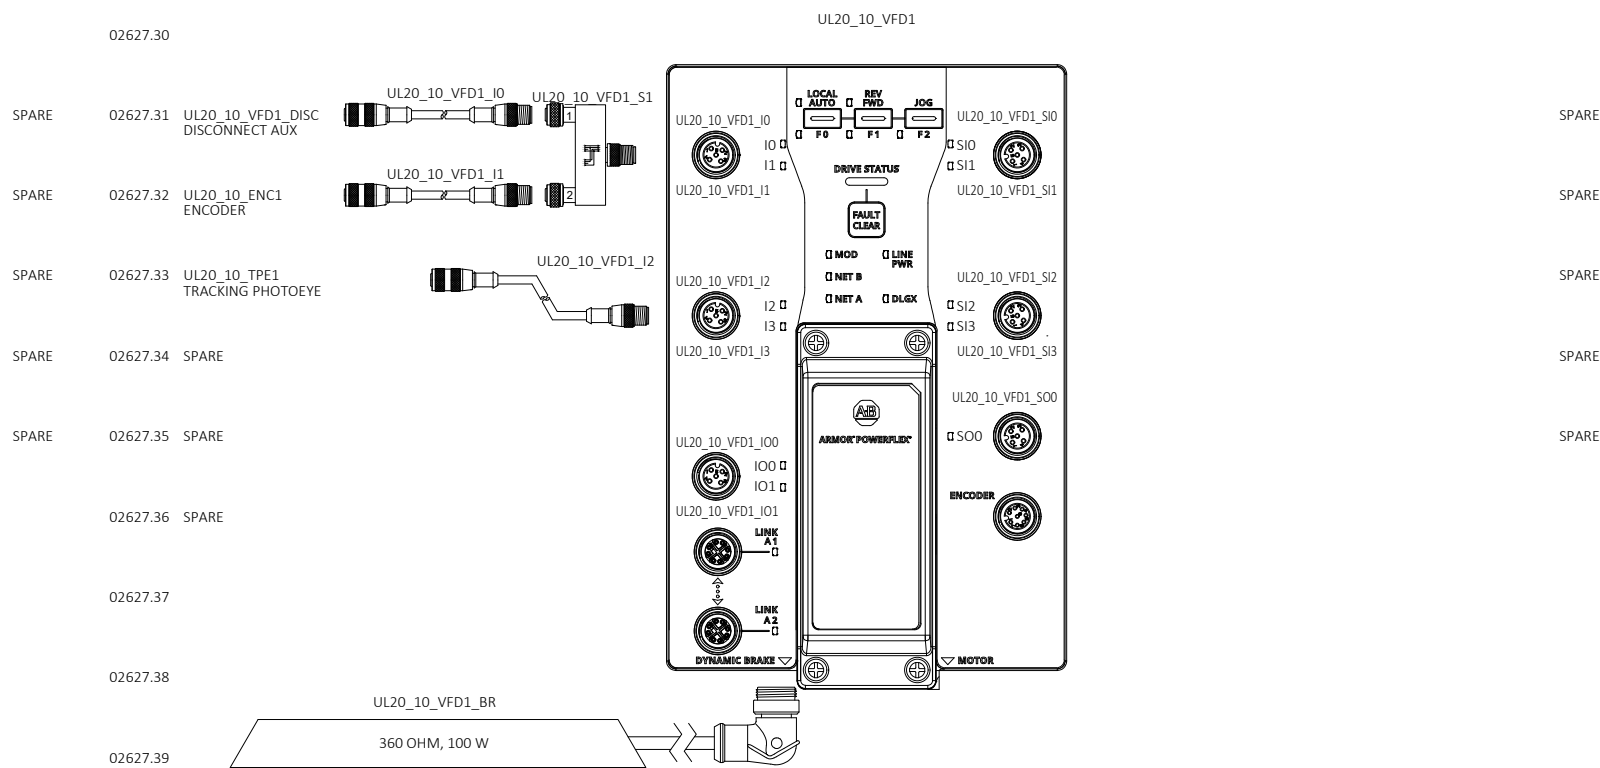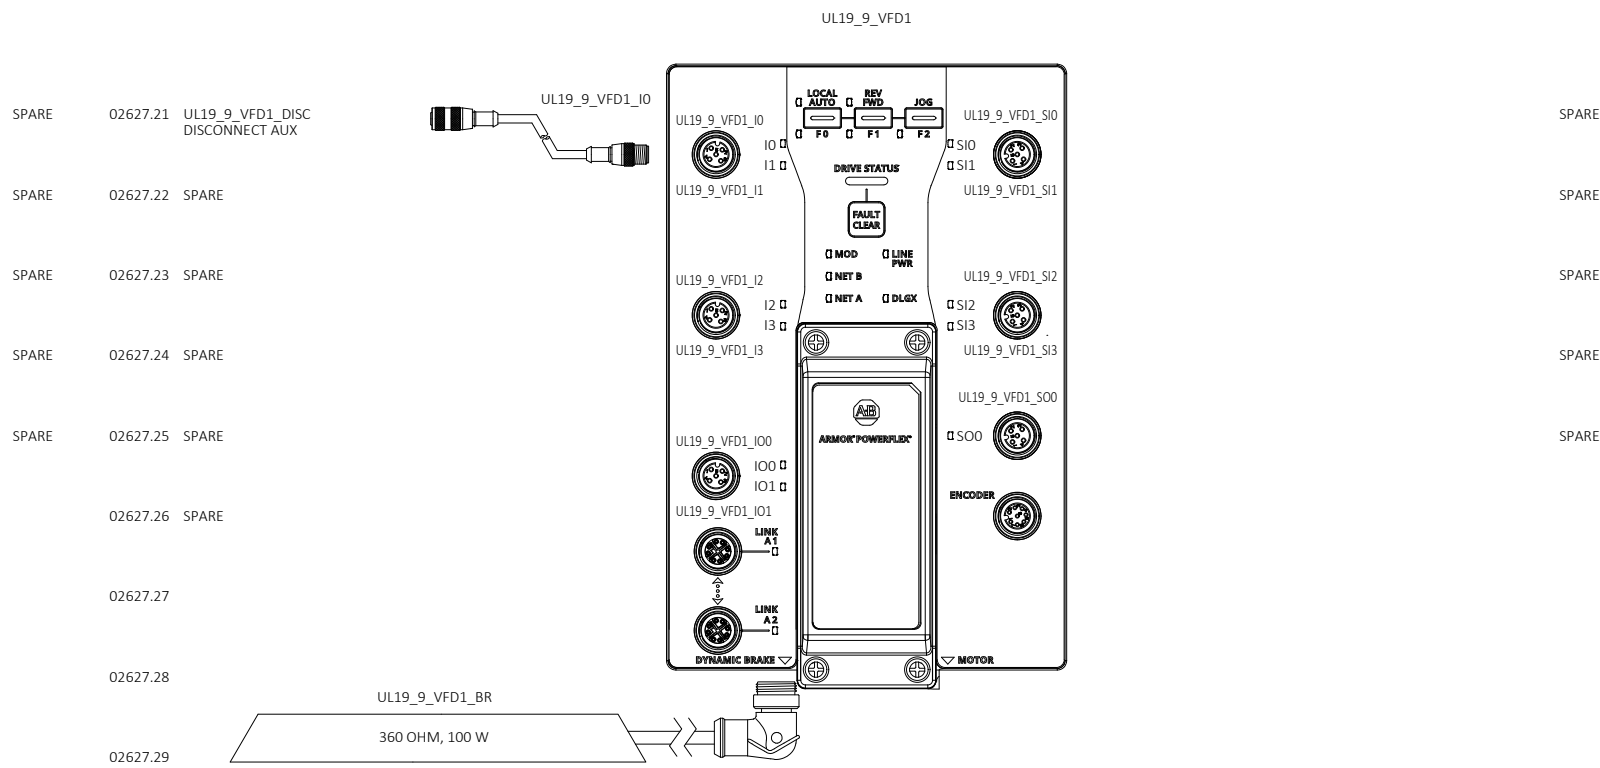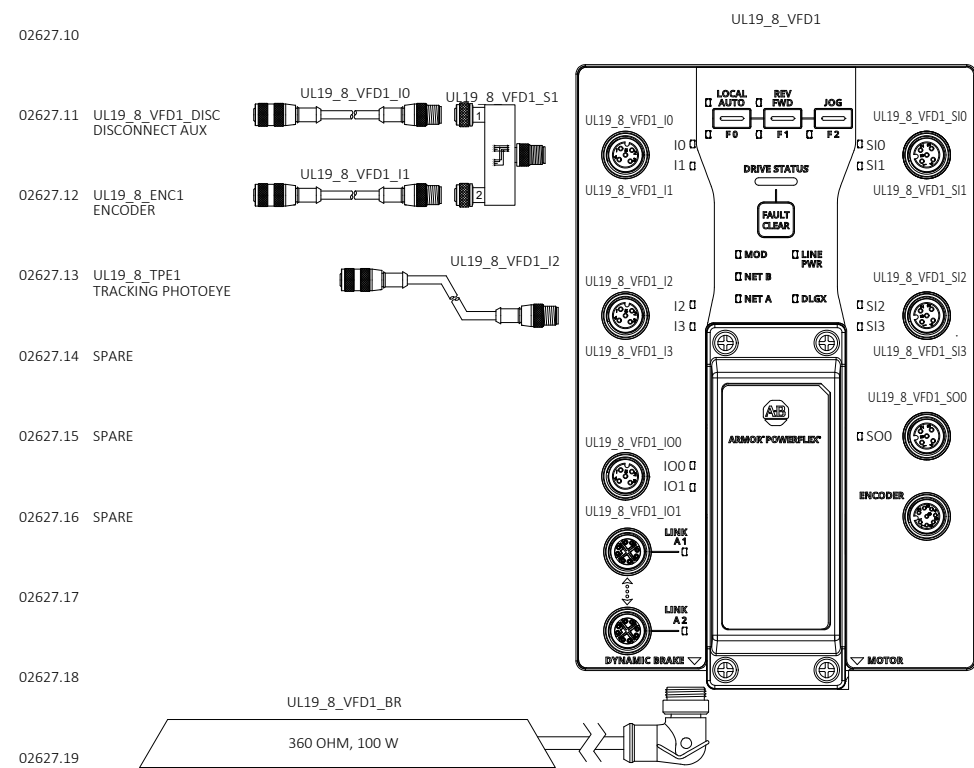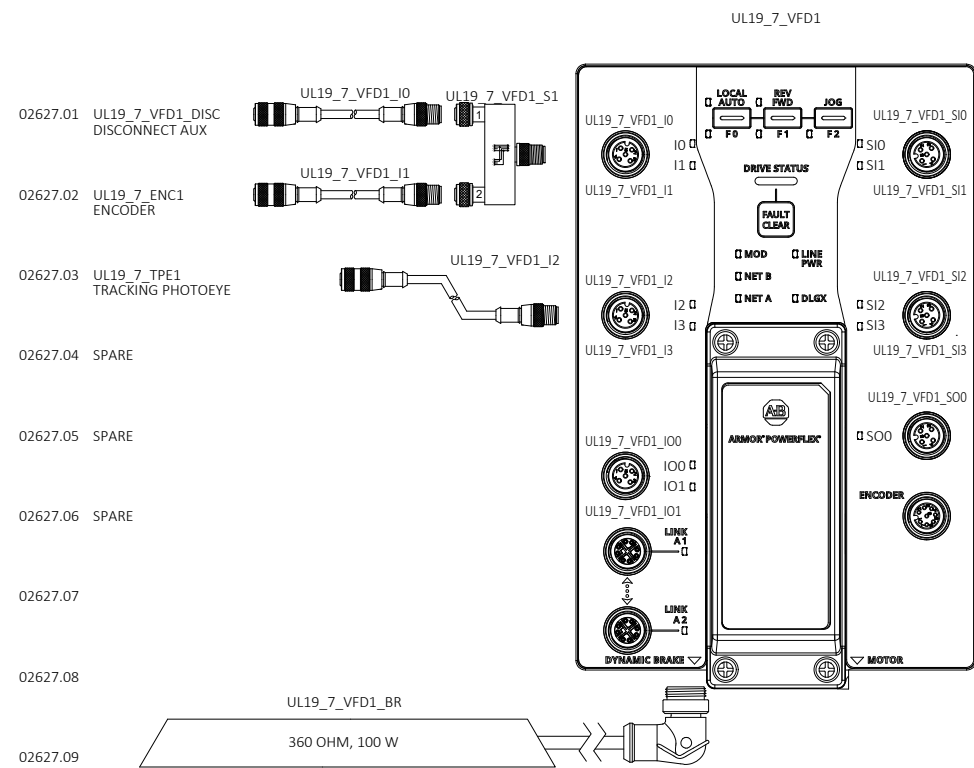

DRAWING REVISIONS			
REV	DESCRIPTION	DATE	BY
00	INITIAL DRAWINGS	05/19/2025	SK
01	ALARM HORN	06/18/2025	SN
A	AS-BUILT	11/13/2025	LB







CONFIDENTIAL: THE INFORMATION CONTAINED HEREIN IS PROPRIETARY INFORMATION OF AUTOSTAND INFORMATION STANDARD LLC AND CONSTITUTES TRADE SECRETS PURSUANT TO THE UNIFORM TRADE SECRETS ACT. THIS INFORMATION SHALL ONLY BE USED IN THE PERFORMANCE OF CONTRACT WITH AUTOSTAND. THIS INFORMATION SHALL NOT BE USED, REPRODUCED OR EMPLOYED IN WHOLE PART, EXCEPT WITH AUTOSTAND'S PRIOR WRITTEN APPROVAL.

25K Amazon Cross-Belt Sort Center (ACBSC)
UL19_7_VFD1/UL19_8_VFD1/
UL19_9_VFD1/UL20_10_VFD1 IO DRAWINGS

AMAZON MTN6
SPARROWS POINT, MD

FILENAME	
2429-AMZ-MTN6-MCM02-627	
D-SIZE SCALE	JOB NUMBER:
NTS	2429
REVISION	SHEET
A	85

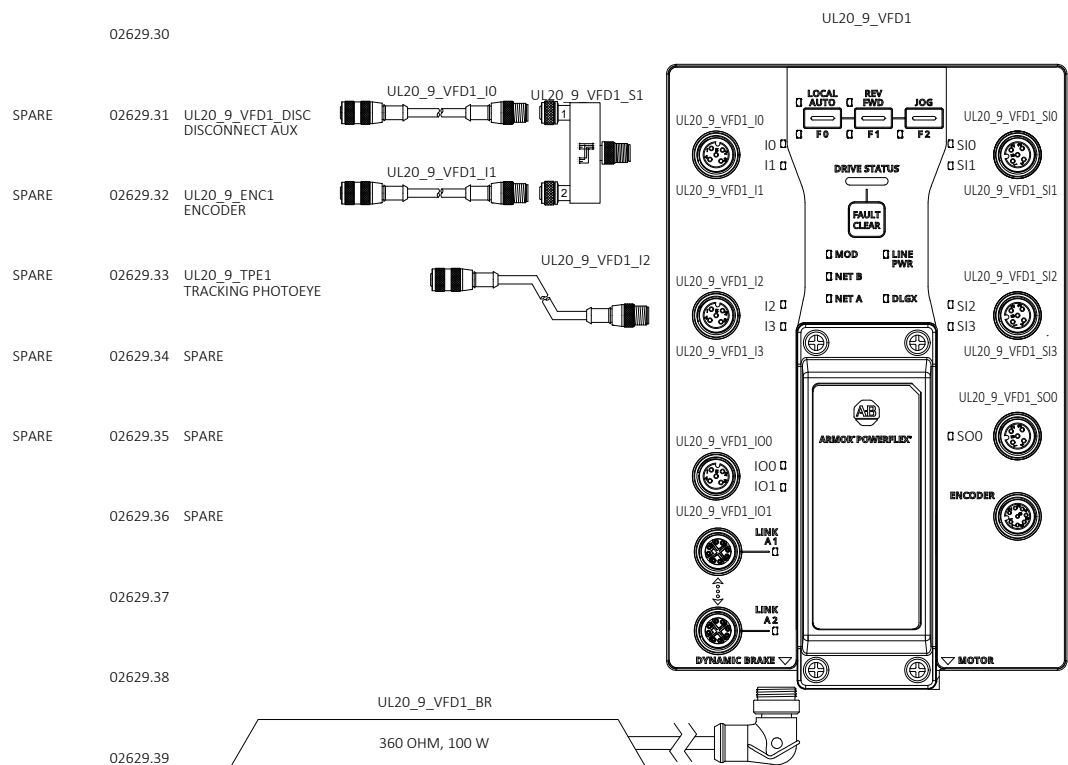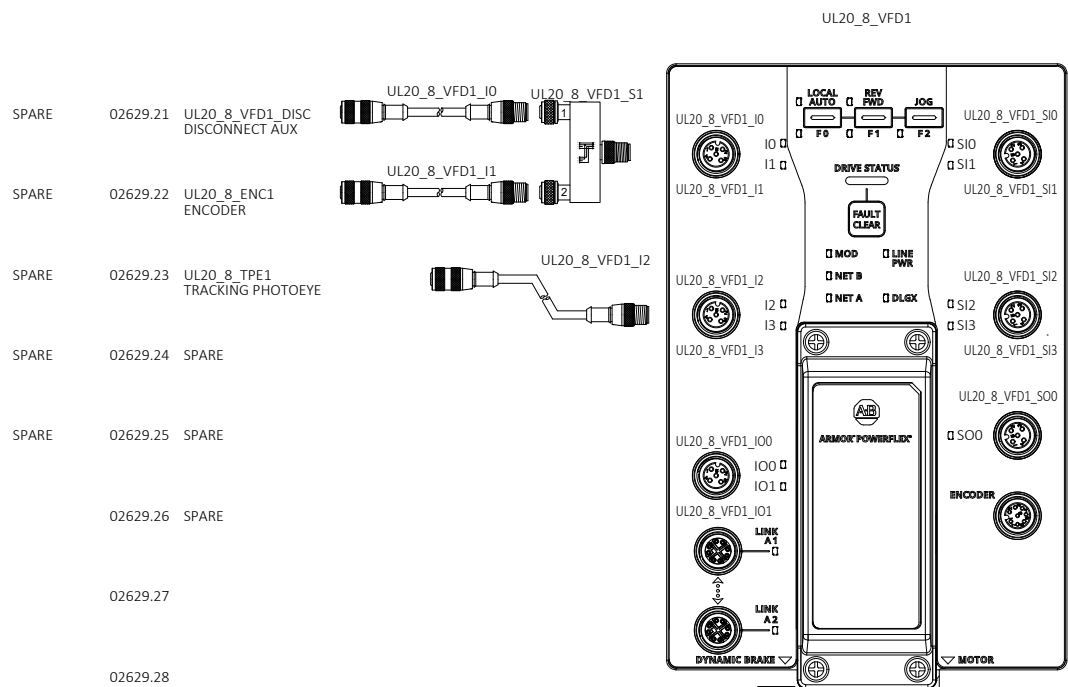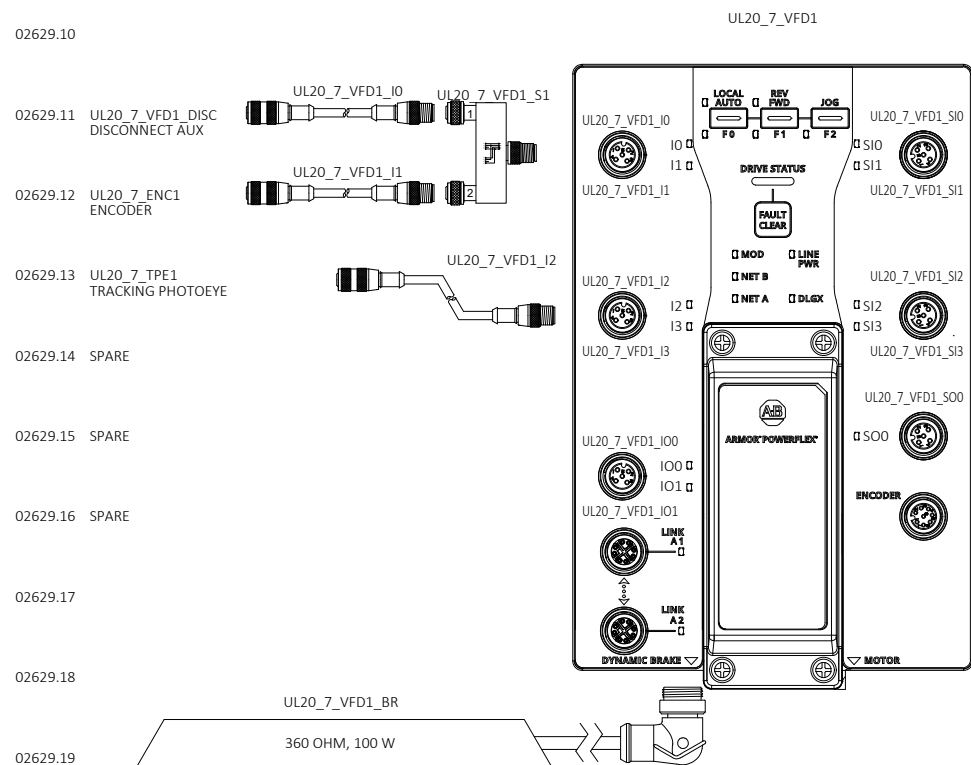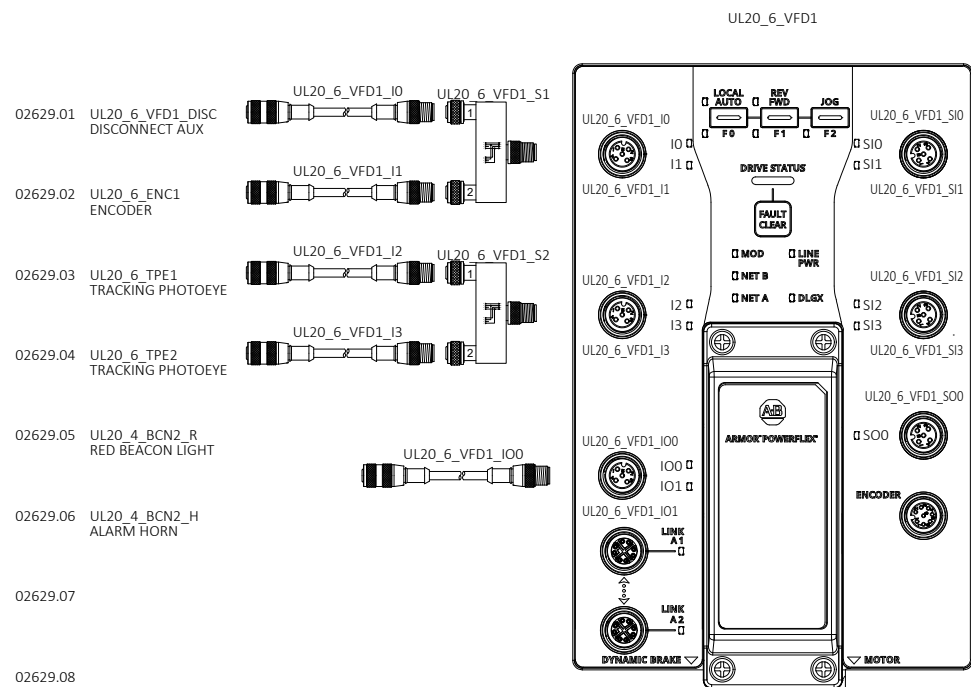

DRAWING REVISIONS			
REV	DESCRIPTION	DATE	BY
00	INITIAL DRAWINGS	05/19/2025	SK
01	ALARM HORN	06/18/2025	SN
A	AS-BUILT	11/13/2025	LB







CONFIDENTIAL: THE INFORMATION CONTAINED HEREIN IS PROPRIETARY INFORMATION OF AUTOSTAND INFORMATION STANDARD LLC AND CONSTITUTES TRADE SECRETS PURSUANT TO THE UNIFORM TRADE SECRETS ACT. THIS INFORMATION SHALL ONLY BE USED IN THE PERFORMANCE OF CONTRACT WITH AUTOSTAND. THIS INFORMATION SHALL NOT BE USED, REPRODUCED OR EMPLOYED IN WHOLE PART, EXCEPT WITH AUTOSTAND'S PRIOR WRITTEN APPROVAL.


25K Amazon Cross-Belt Sort Center (ACBSC)
UL20_6_VFD1/UL20_7_VFD1/
UL20_8_VFD1/UL20_9_VFD1 IO DRAWINGS

AMAZON MTN6
SPARROWS POINT, MD





FILENAME	
2429-AMZ-MTN6-MCM02-629	
D-SIZE SCALE	JOB NUMBER:
NTS	2429
REVISION	SHEET
A	87

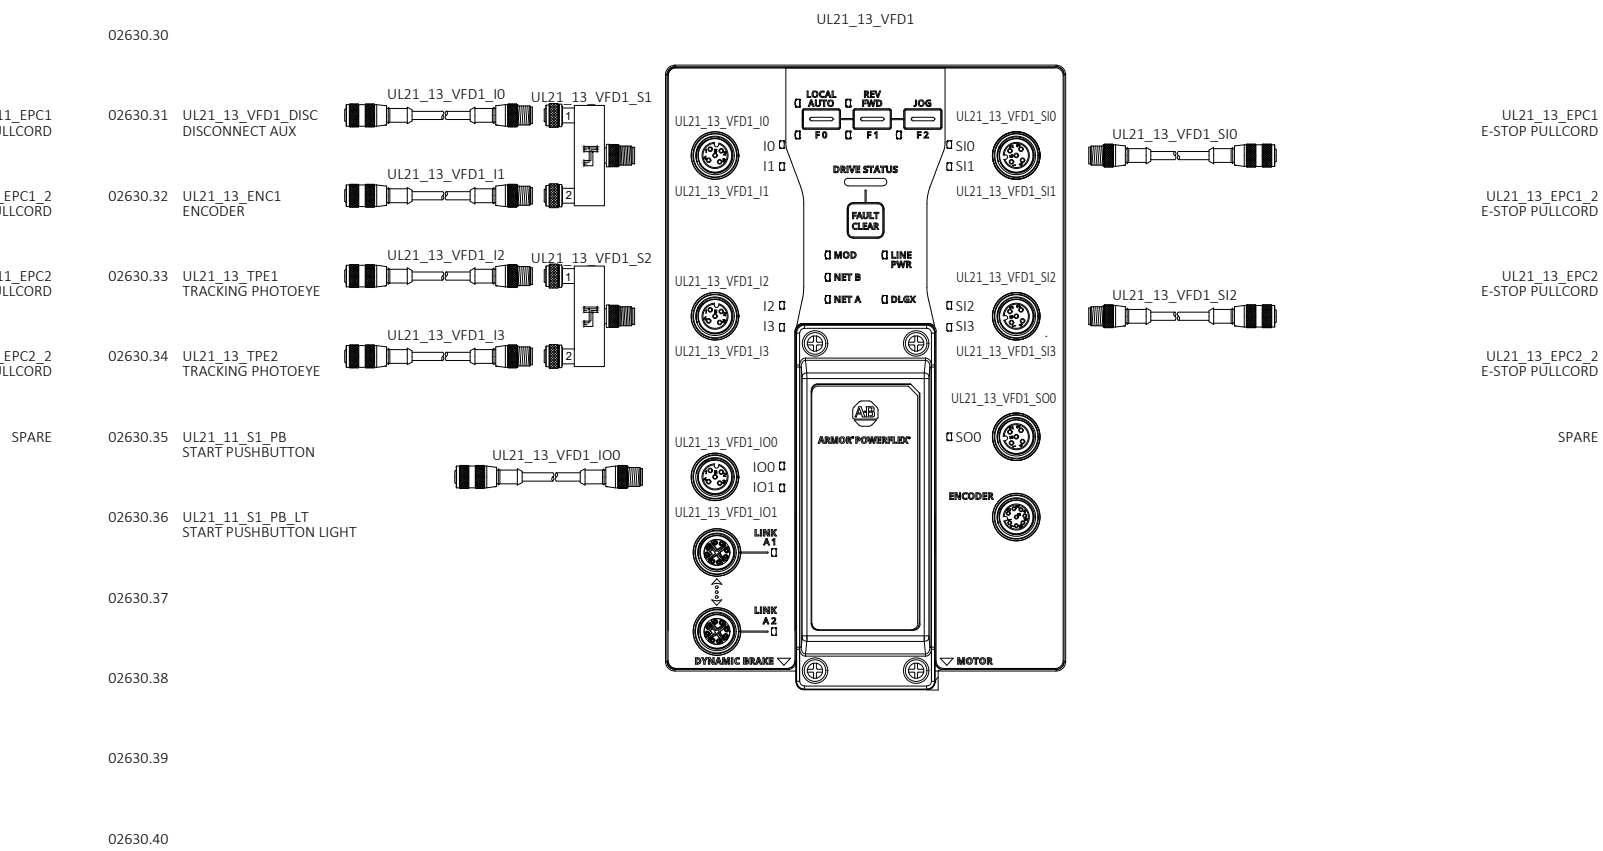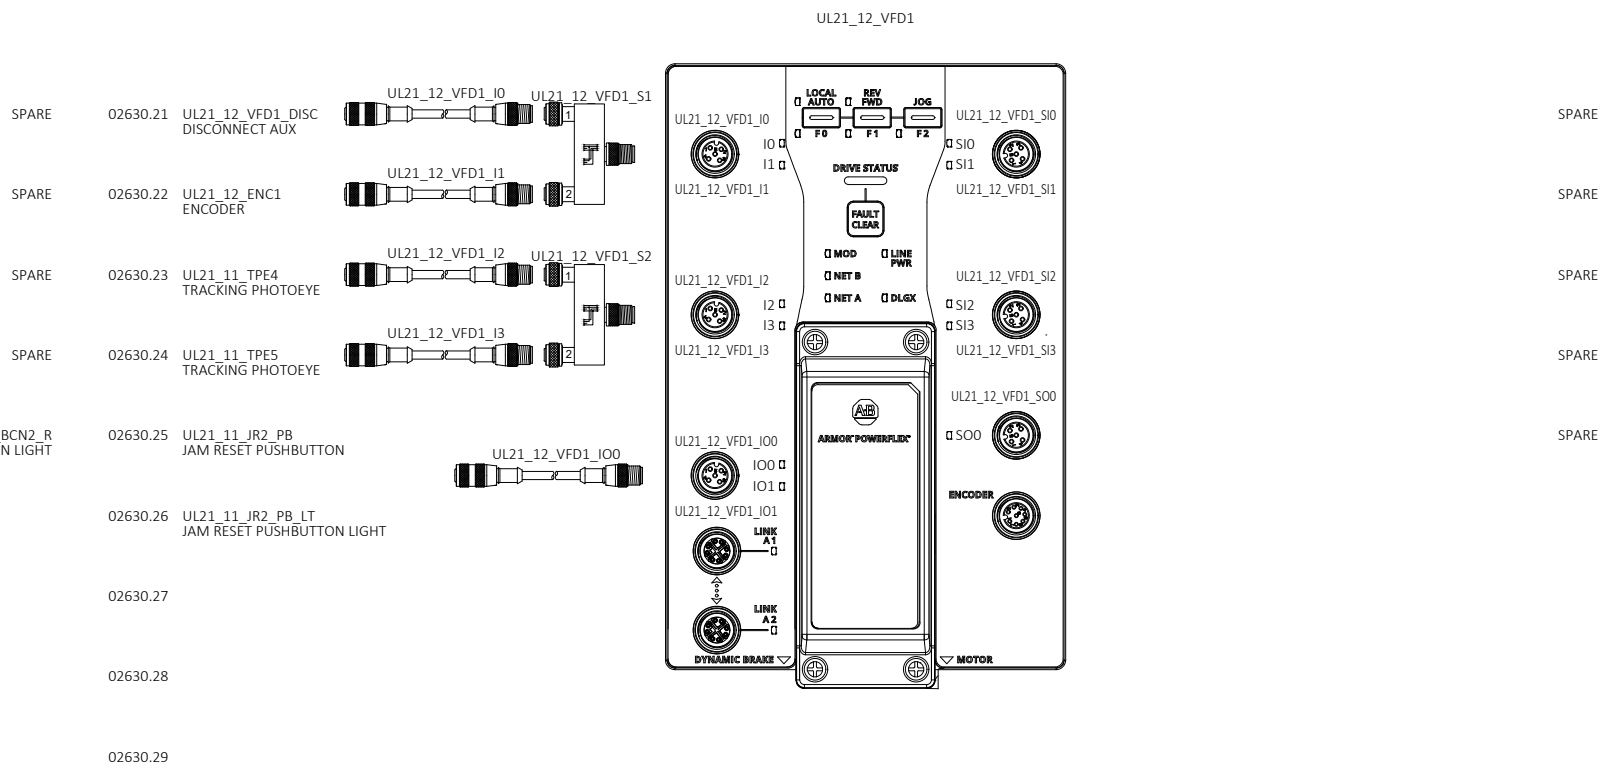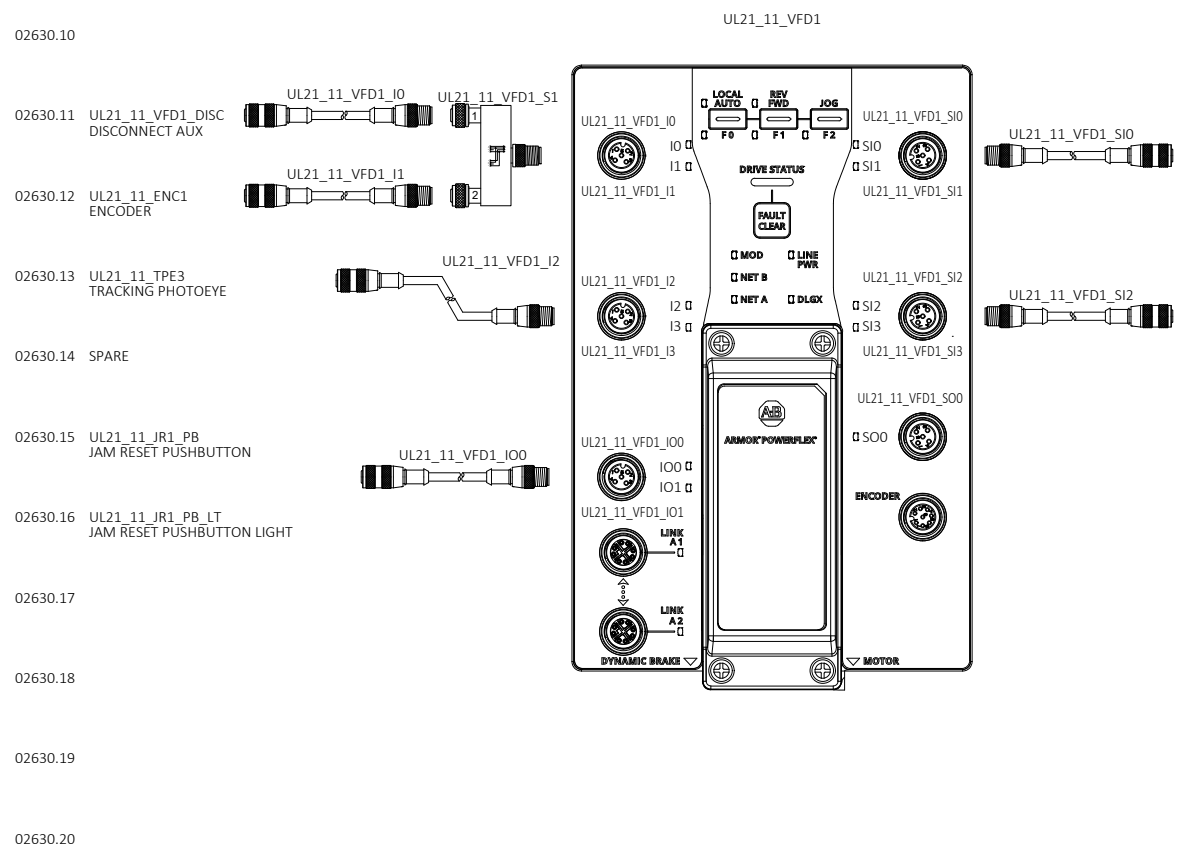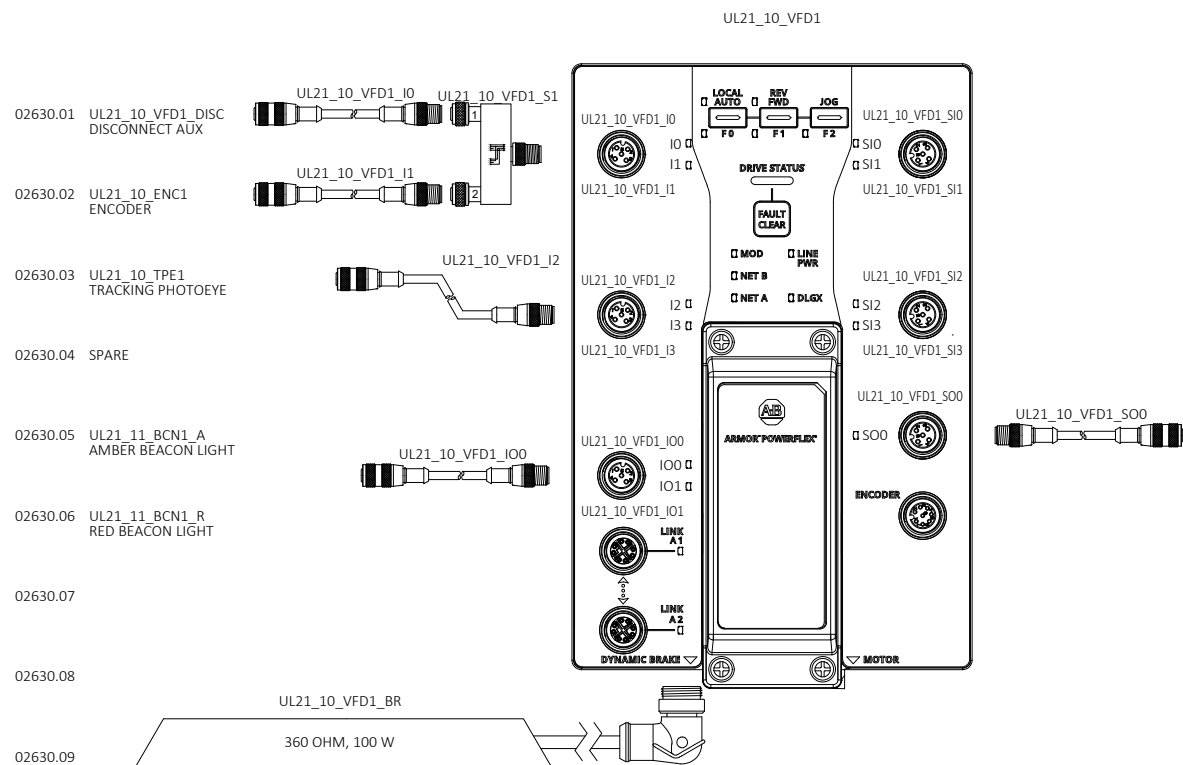


DRAWING REVISIONS			
REV	DESCRIPTION	DATE	BY
00	INITIAL DRAWINGS	05/19/2025	SK
01	ALARM HORN	06/18/2025	SN
A	AS-BUILT	11/13/2025	LB

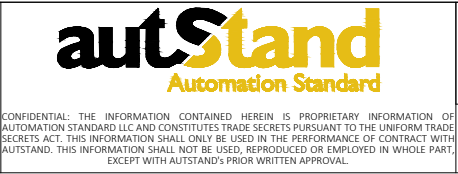

25K Amazon Cross-Belt Sort Center (ACBSC) UL21_10_VFD1/UL21_11_VFD1/ UL21_12_VFD1/UL21_13_VFD1 IO DRAWINGS	FILENAME 2429-AMZ-MTN6-MCM02-630	
	D-SIZE SCALE NTS	JOB NUMBER: 2429
	REVISION A	SHEET 88
	AMAZON MTN6 SPARROWS POINT, MD	

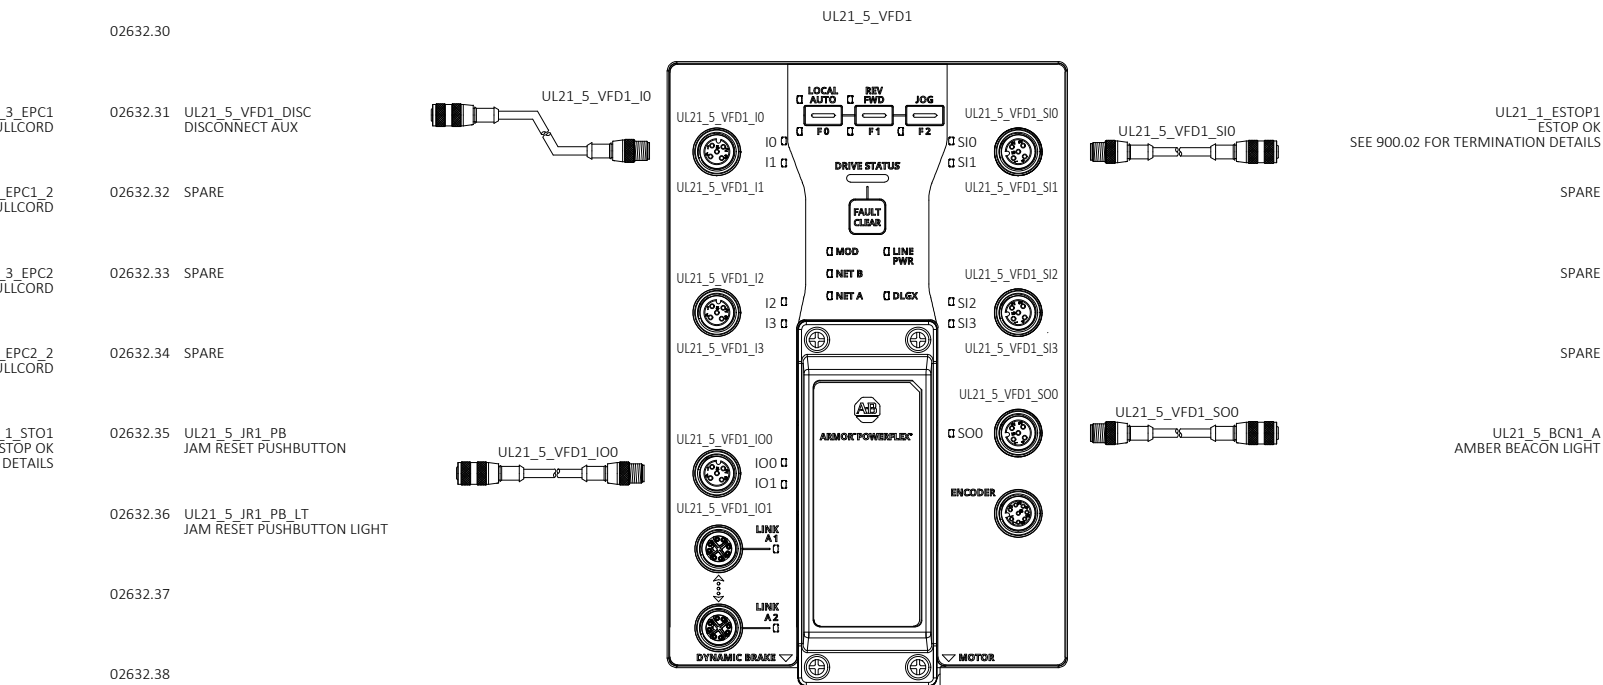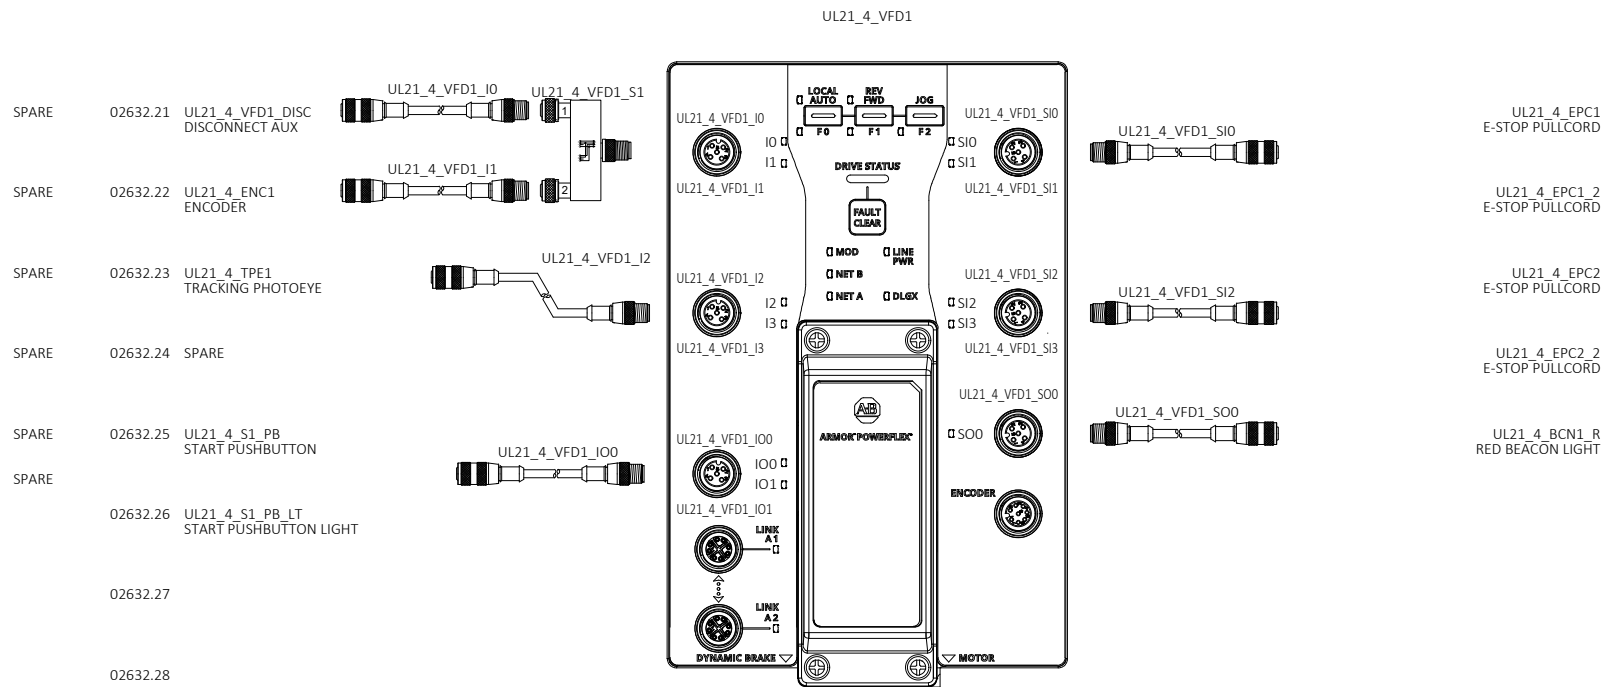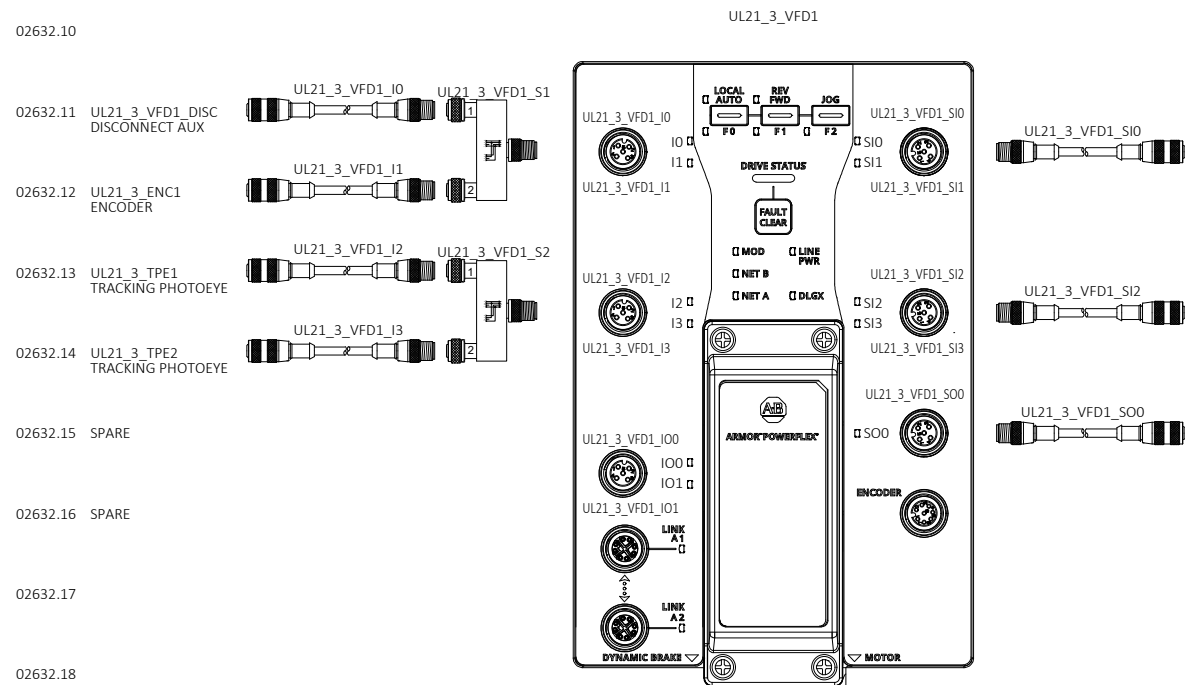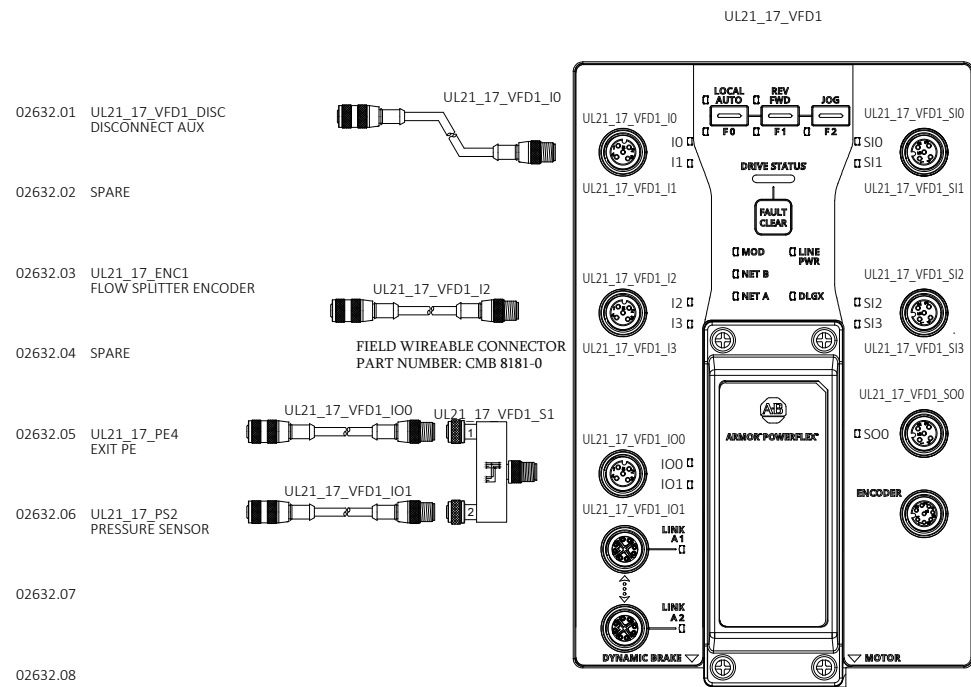


DRAWING REVISIONS			
REV	DESCRIPTION	DATE	BY
00	INITIAL DRAWINGS	05/19/2025	SK
01	ALARM HORN	06/18/2025	SN
A	AS-BUILT	11/13/2025	LB

 

autostand
Automation Standard

CONFIDENTIAL: THE INFORMATION CONTAINED HEREIN IS PROPRIETARY INFORMATION OF AUTOMATION STANDARD LLC AND CONSTITUTES TRADE SECRETS PURSUANT TO THE UNIFORM TRADE SECRETS ACT. THIS INFORMATION SHALL ONLY BE USED IN THE PERFORMANCE OF CONTRACT WITH AUTOSTAND. THIS INFORMATION SHALL NOT BE USED, REPRODUCED OR EMPLOYED IN WHOLE PART EXCEPT WITH AUTOSTAND'S PRIOR WRITTEN APPROVAL.

25K Amazon Cross-Belt Sort Center (ACBSC) UL21_17_VFD1/UL21_3_VFD1/ UL21_4_VFD1/UL21_5_VFD1 IO DRAWINGS AMAZON MTN6 SPARROWS POINT, MD	FILENAME 2429-AMZ-MTN6-MCM02-632	
	D-SIZE SCALE NTS	JOB NUMBER: 2429
	REVISION A	SHEET 90

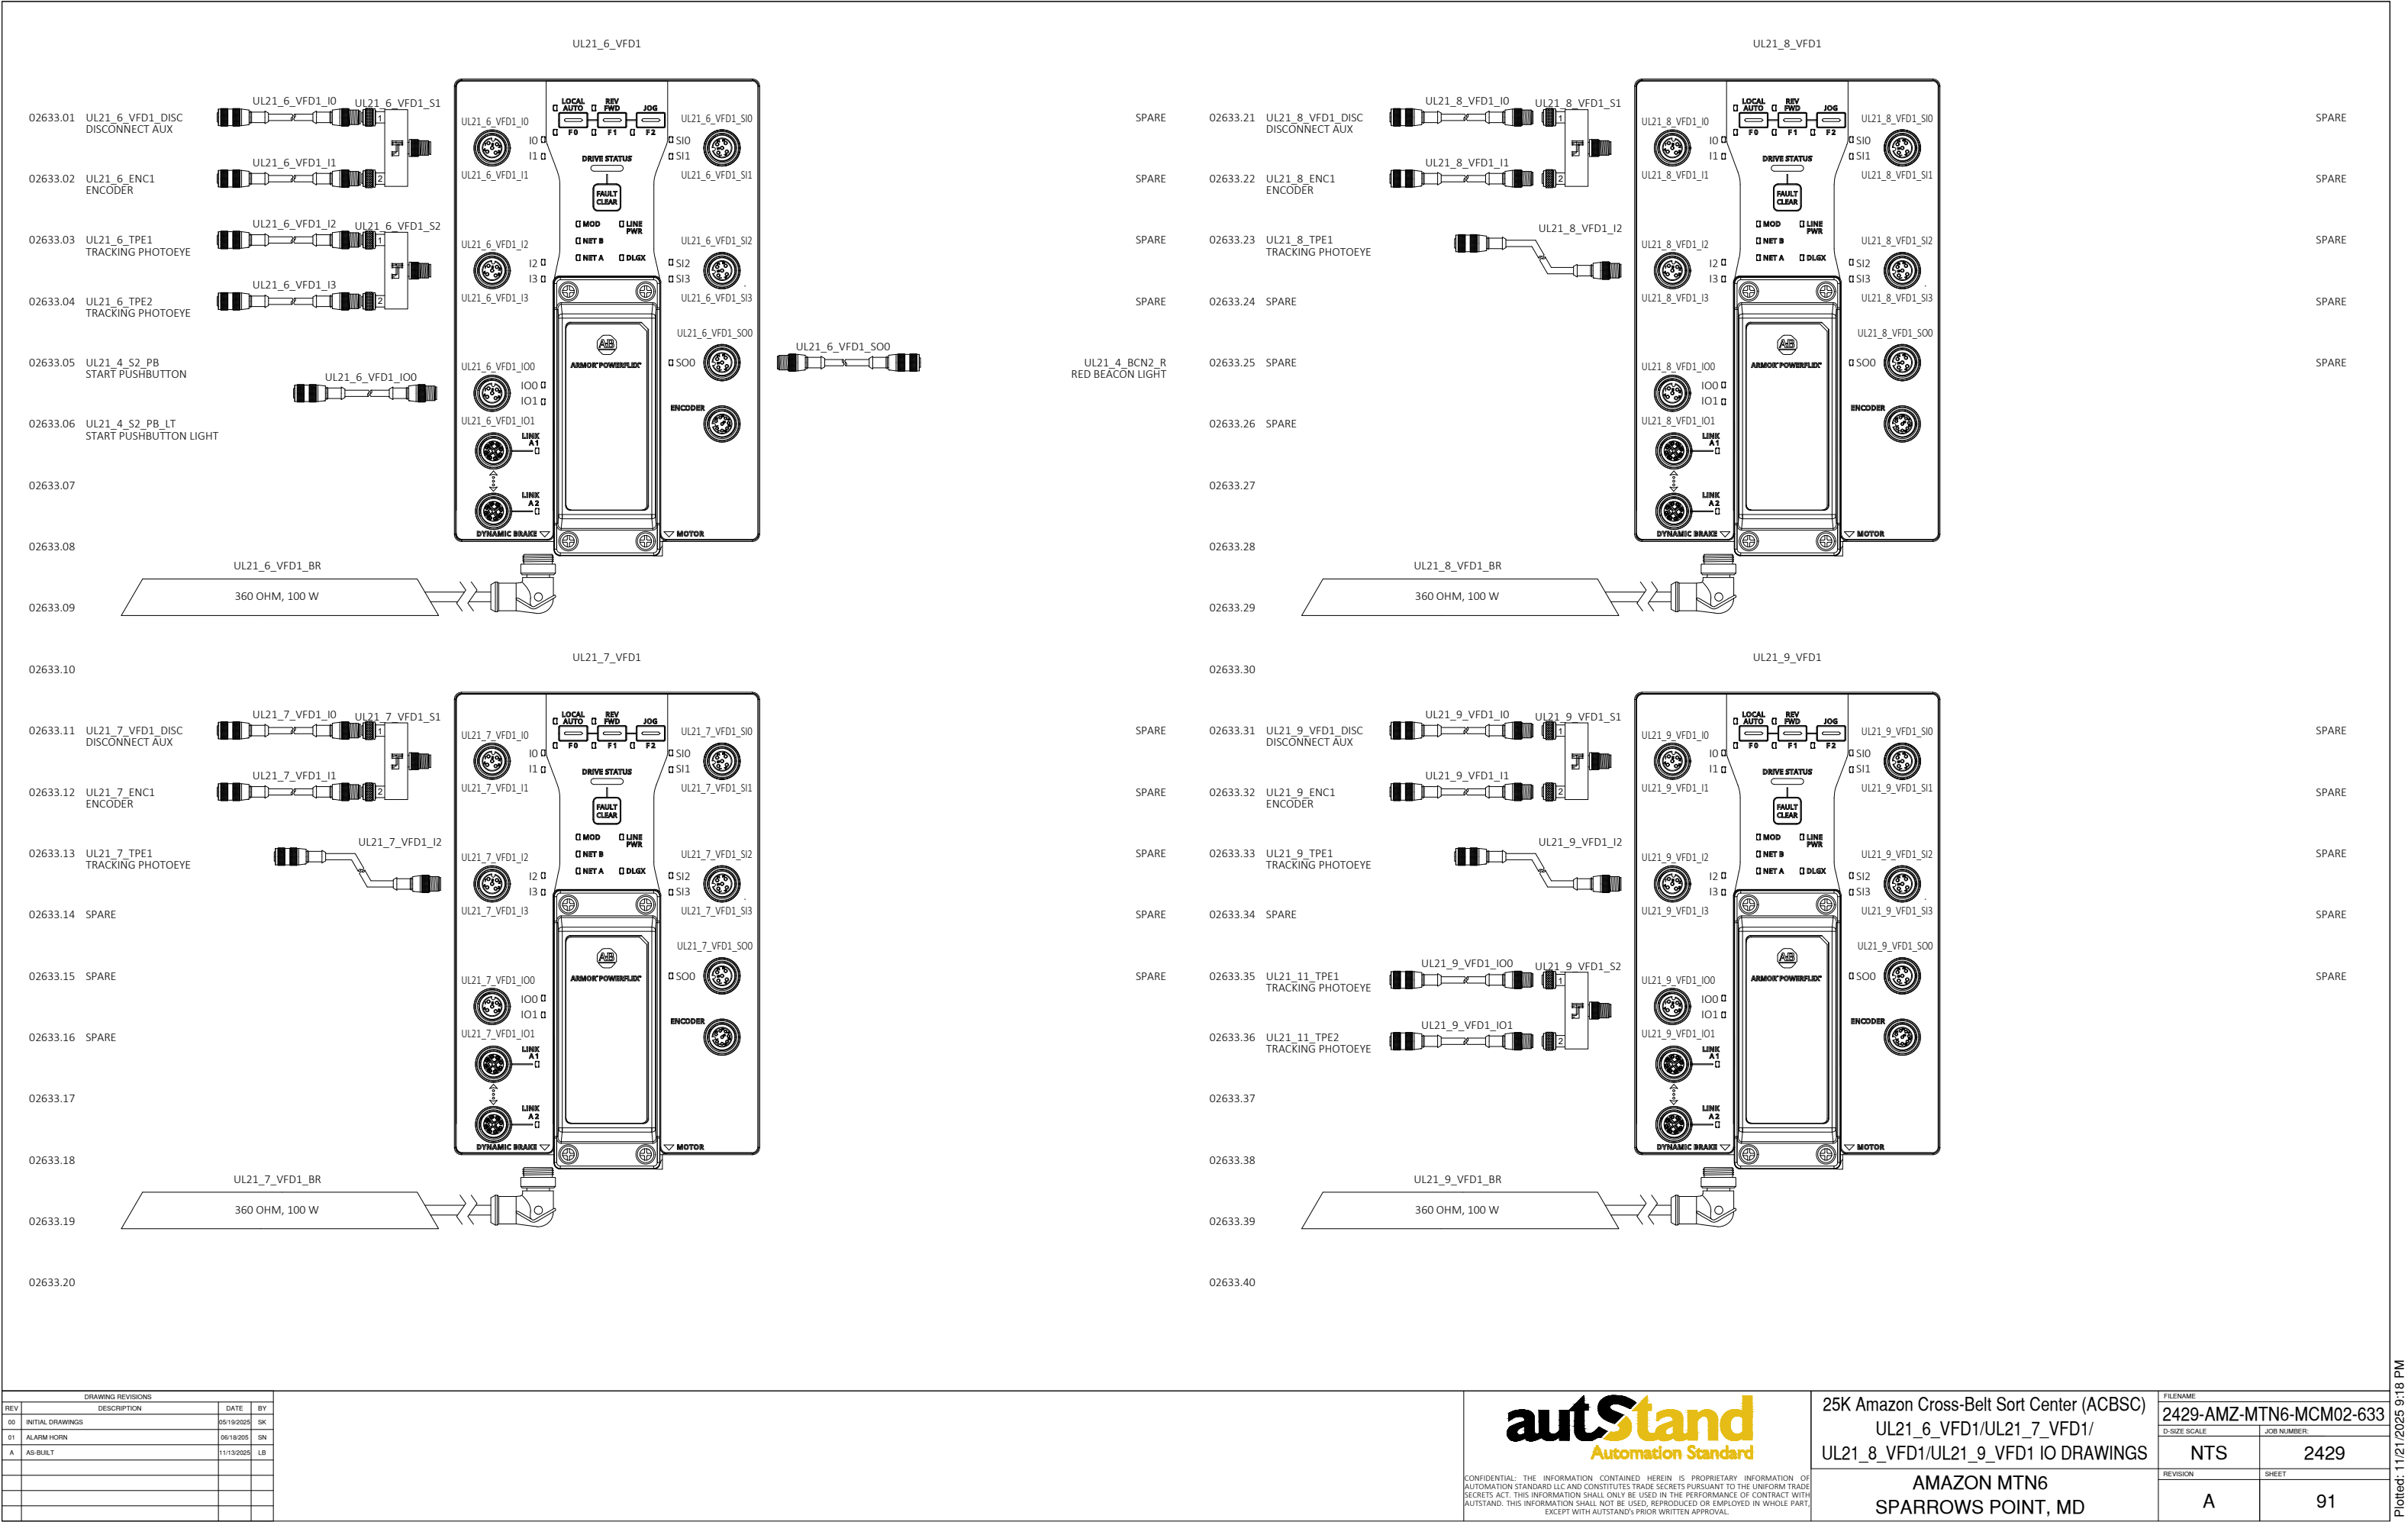

02633.01

UL21_6_VFD1_DISC
DISCONNECT AUX

02633.02

UL21_6_ENC1
ENCODER

02633.03

UL21_6_TPE1
TRACKING PHOTOEYE

02633.04

UL21_6_TPE2
TRACKING PHOTOEYE

02633.05

UL21_4_S2_PB
START PUSHBUTTON

02633.06

UL21_4_S2_PB_LT
START PUSHBUTTON LIGHT

02633.07

02633.08

02633.09

UL21_6_VFD1

UL21_6_VFD1_I0

UL21_6_VFD1_I1

UL21_6_VFD1_I2

UL21_6_VFD1_I3

UL21_6_VFD1_I00

UL21_6_VFD1_S1

UL21_6_VFD1_S2

UL21_6_VFD1_S00

UL21_6_VFD1_I00

UL21_6_VFD1_I01

LINK A1

LINK A2

UL21_6_VFD1_BR

360 OHM, 100 W

UL21_7_VFD1

UL21_7_VFD1_I0

UL21_7_VFD1_I1

UL21_7_VFD1_I2

UL21_7_VFD1_I3

UL21_7_VFD1_I00

UL21_7_VFD1_I01

UL21_7_VFD1_S1

UL21_7_VFD1_S2

UL21_7_VFD1_S00

UL21_7_VFD1_I00

UL21_7_VFD1_I01

LINK A1

LINK A2

UL21_7_VFD1_BR

360 OHM, 100 W

02633.11

UL21_7_VFD1_DISC
DISCONNECT AUX

02633.12

UL21_7_ENC1
ENCODER

02633.13

UL21_7_TPE1
TRACKING PHOTOEYE

02633.14

SPARE

02633.15

SPARE

02633.16

SPARE

02633.17

02633.18

02633.19

02633.20

UL21_7_VFD1

UL21_7_VFD1_I0

UL21_7_VFD1_I1

UL21_7_VFD1_I2

UL21_7_VFD1_I3

UL21_7_VFD1_I00

UL21_7_VFD1_I01

UL21_7_VFD1_S1

UL21_7_VFD1_S2

UL21_7_VFD1_S00

UL21_7_VFD1_I00

UL21_7_VFD1_I01

LINK A1

LINK A2

UL21_7_VFD1_BR

360 OHM, 100 W

02633.21

UL21_8_VFD1_DISC
DISCONNECT AUX

02633.22

UL21_8_ENC1
ENCODER

02633.23

UL21_8_TPE1
TRACKING PHOTOEYE

02633.24

SPARE

02633.25

SPARE

02633.26

SPARE

02633.27

02633.28

02633.29

02633.30

UL21_8_VFD1

UL21_8_VFD1_I0

UL21_8_VFD1_I1

UL21_8_VFD1_I2

UL21_8_VFD1_I3

UL21_8_VFD1_I00

UL21_8_VFD1_I01

UL21_8_VFD1_S1

UL21_8_VFD1_S2

UL21_8_VFD1_S00

UL21_8_VFD1_I00

UL21_8_VFD1_I01

LINK A1

LINK A2

UL21_8_VFD1_BR

360 OHM, 100 W

02633.31

UL21_9_VFD1_DISC
DISCONNECT AUX

02633.32

UL21_9_ENC1
ENCODER

02633.33

UL21_9_TPE1
TRACKING PHOTOEYE

02633.34

SPARE

02633.35

UL21_11_TPE1
TRACKING PHOTOEYE

02633.36

UL21_11_TPE2
TRACKING PHOTOEYE

02633.37

02633.38

02633.39

02633.40

UL21_9_VFD1

UL21_9_VFD1_I0

UL21_9_VFD1_I1

UL21_9_VFD1_I2

UL21_9_VFD1_I3

UL21_9_VFD1_I00

UL21_9_VFD1_I01

UL21_9_VFD1_S1

UL21_9_VFD1_S2

UL21_9_VFD1_S00

UL21_9_VFD1_I00

UL21_9_VFD1_I01

LINK A1

LINK A2

UL21_9_VFD1_BR

360 OHM, 100 W

DRAWING REVISIONS			
REV	DESCRIPTION	DATE	BY
00	INITIAL DRAWINGS	05/19/2025	SK
01	ALARM HORN	06/18/2025	SN
A	AS-BUILT	11/13/2025	LB

FILENAME	
D-SIZE SCALE	JOB NUMBER
NTS	2429
REVISION	SHEET
A	91





autStand

Automation Standard

CONFIDENTIAL: THE INFORMATION CONTAINED HEREIN IS PROPRIETARY INFORMATION OF AUTOMATION STANDARD LLC AND CONSTITUTES TRADE SECRETS PURSUANT TO THE UNIFORM TRADE SECRETS ACT. THIS INFORMATION SHALL ONLY BE USED IN THE PERFORMANCE OF CONTRACT WITH AUTISTAND. THIS INFORMATION SHALL NOT BE USED, REPRODUCED OR EMPLOYED IN WHOLE PART, EXCEPT WITH AUTISTAND'S PRIOR WRITTEN APPROVAL.

25K Amazon Cross-Belt Sort Center (ACBSC)
UL21_6_VFD1/UL21_7_VFD1/
UL21_8_VFD1/UL21_9_VFD1 IO DRAWINGS

AMAZON MTN6
SPARROWS POINT, MD

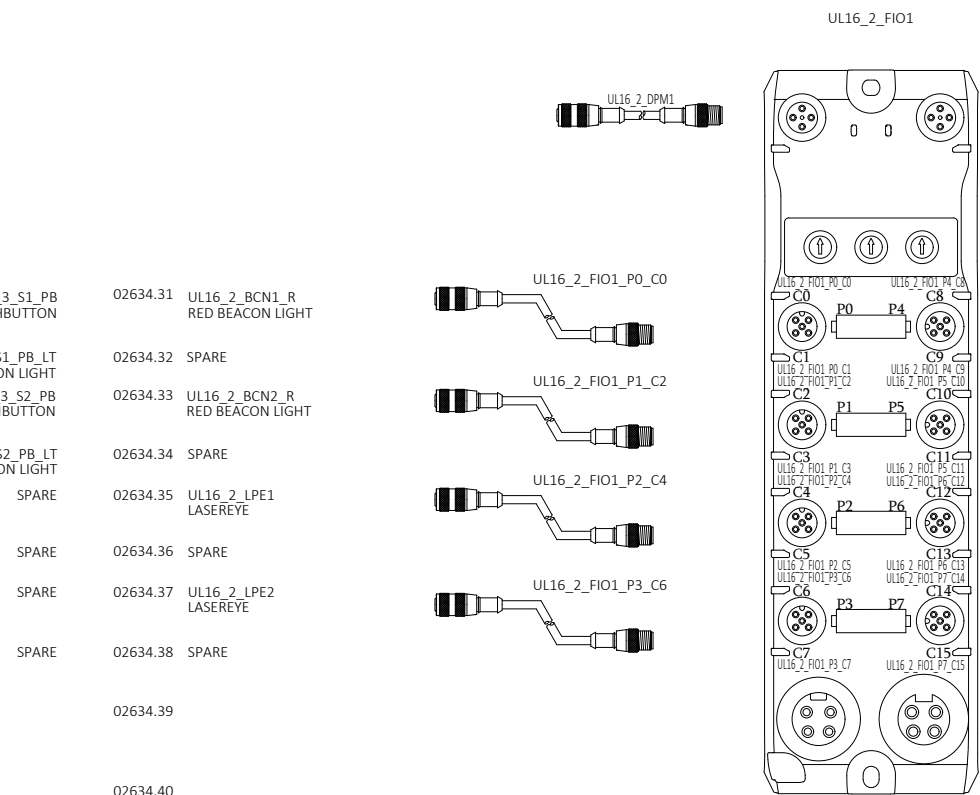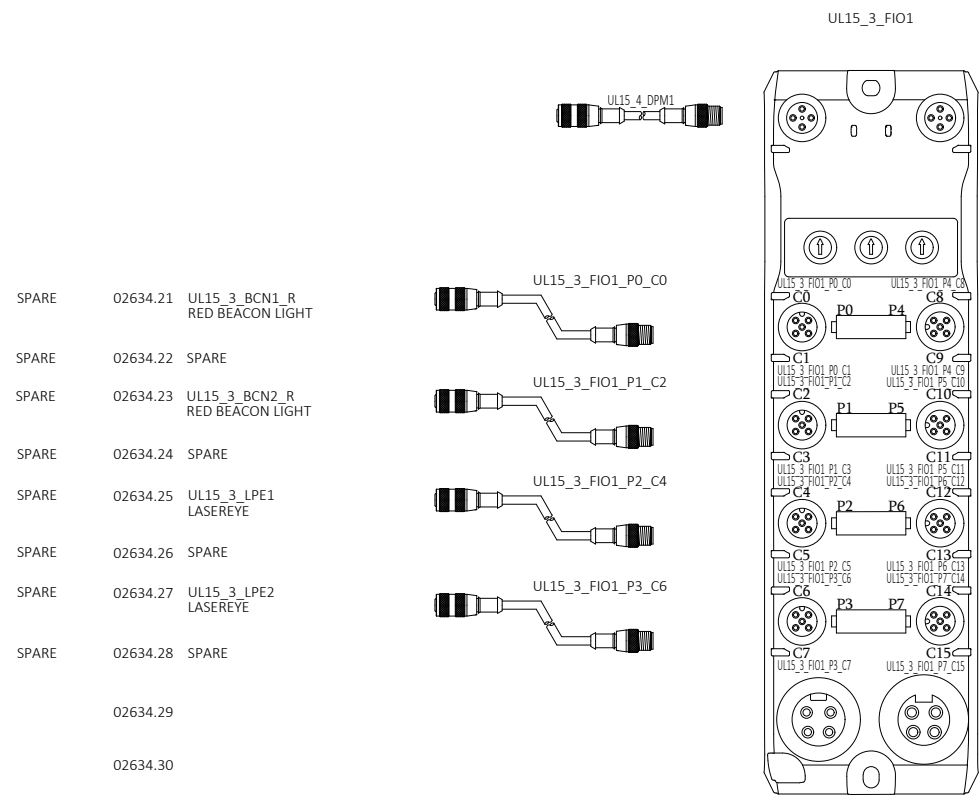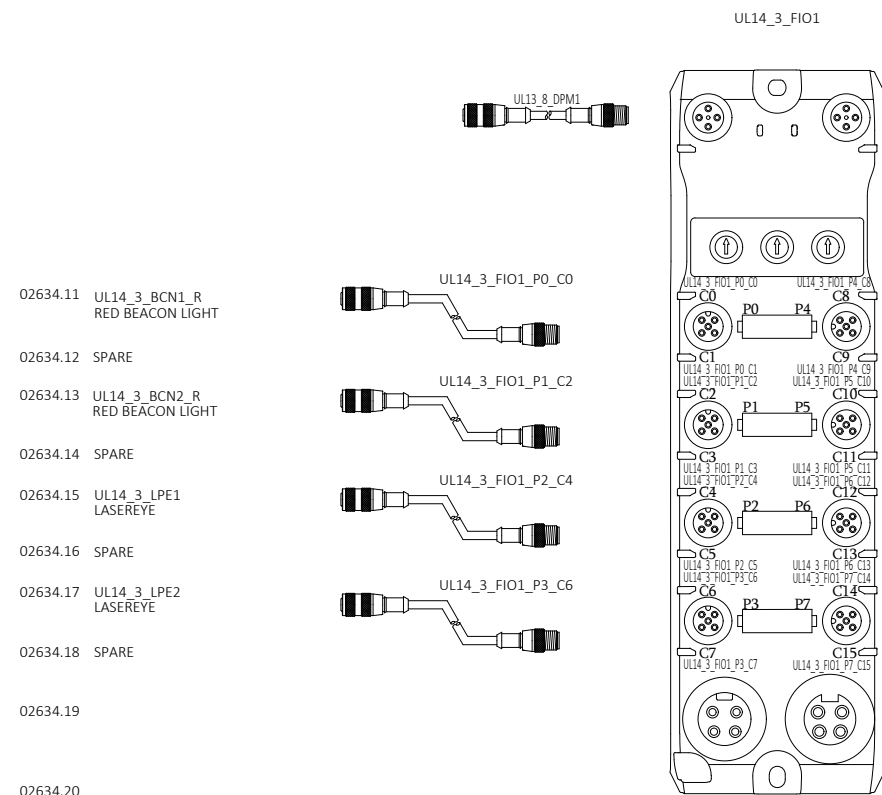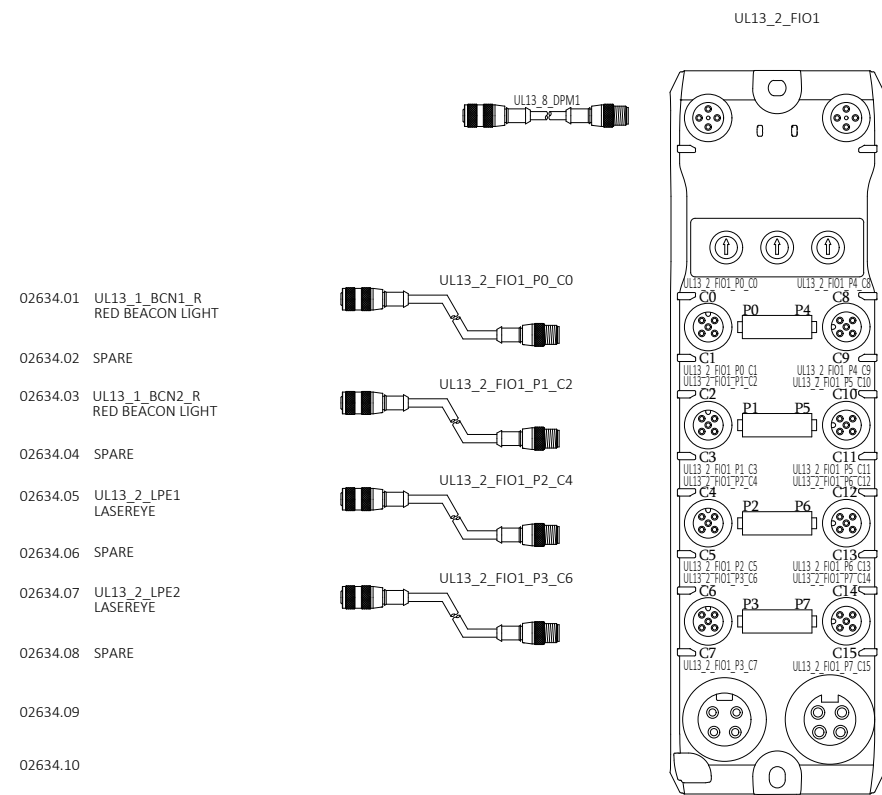





















DRAWING REVISIONS			
REV	DESCRIPTION	DATE	BY
00	INITIAL DRAWINGS	05/19/2025	SK
01	ALARM HORN	06/18/2025	SN
A	AS-BUILT	11/13/2025	LB











autistand
Automation Standard

CONFIDENTIAL: THE INFORMATION CONTAINED HEREIN IS PROPRIETARY INFORMATION OF AUTOMATION STANDARD LLC AND CONSTITUTES TRADE SECRETS PURSUANT TO THE UNIFORM TRADE SECRETS ACT. THIS INFORMATION SHALL ONLY BE USED IN THE PERFORMANCE OF CONTRACT WITH AUTISTAND. THIS INFORMATION SHALL NOT BE USED, REPRODUCED OR EMPLOYED IN WHOLE PART, EXCEPT WITH AUTISTAND'S PRIOR WRITTEN APPROVAL.

25K Amazon Cross-Belt Sort Center (ACBSC) UL13_2_FIO1/UL14_3_FIO1/ UL15_3_FIO1/UL16_2_FIO1 IO DRAWINGS	FILENAME	
	2429-AMZ-MTN6-MCM02-634	
	D-SIZE SCALE	JOB NUMBER:
	NTS	2429
AMAZON MTN6 SPARROWS POINT, MD	REVISION	SHEET
	A	92

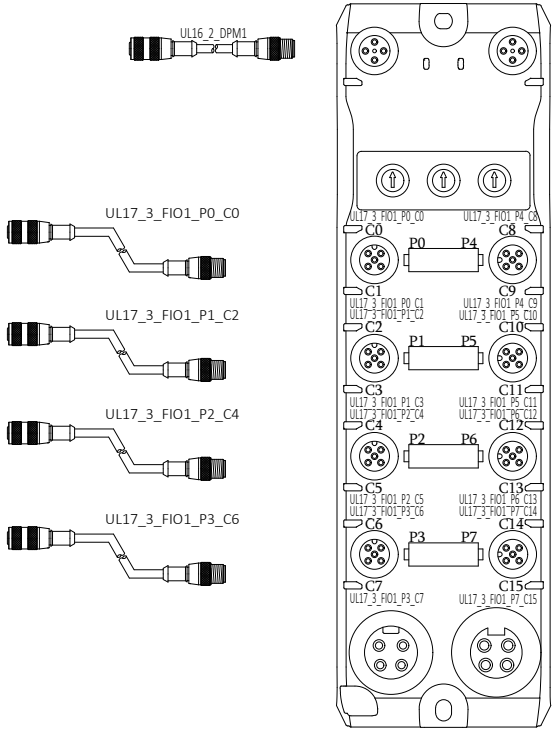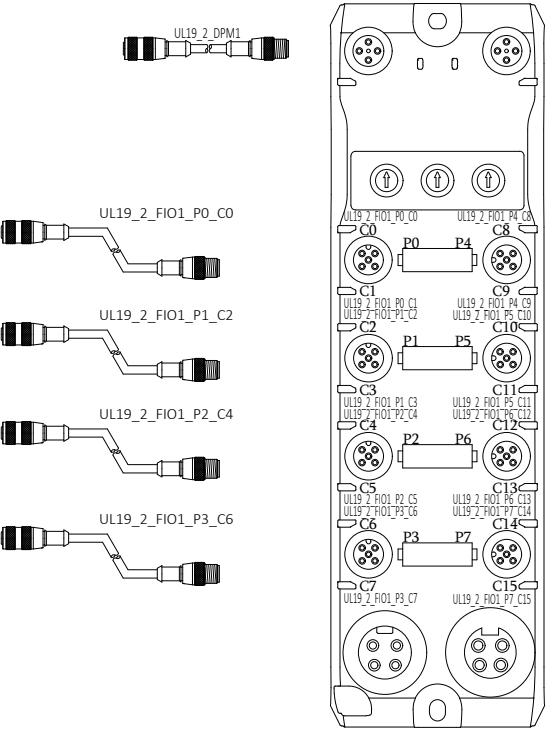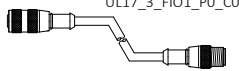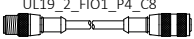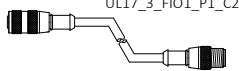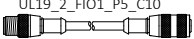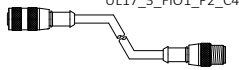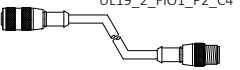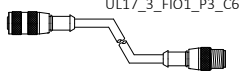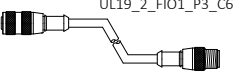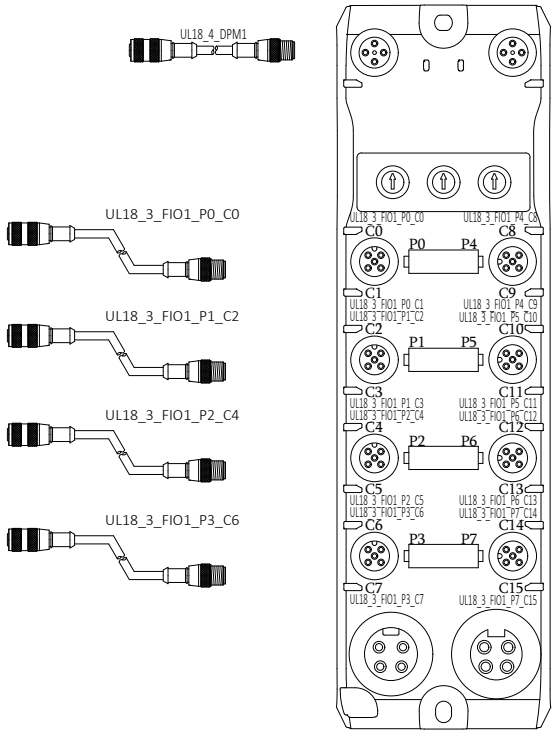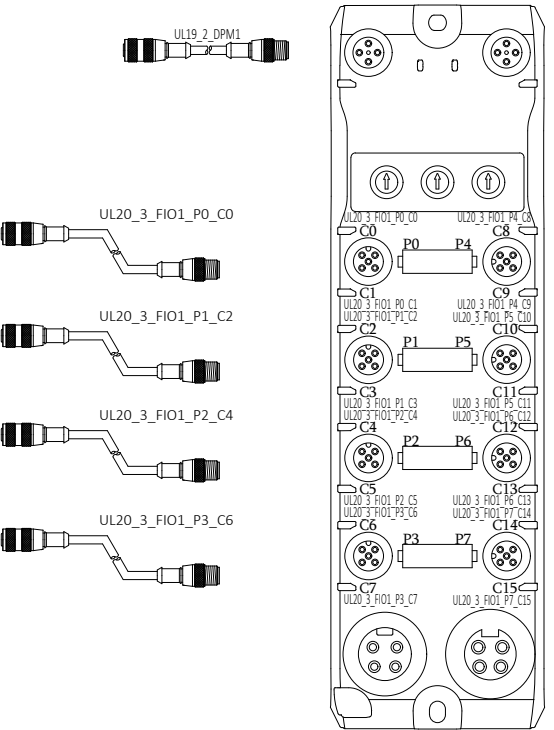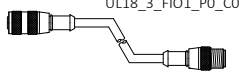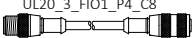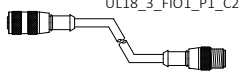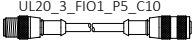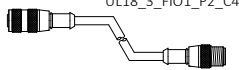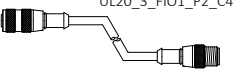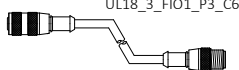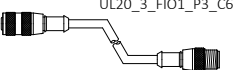				UL17_3_FIO1								UL19_2_FIO1			
															
02635.01	UL17_3_BCN1_R	RED BEACON LIGHT		UL17_3_FIO1_P4_C8				UL17_3_S1_PB				UL19_2_FIO1_P0_C0			
02635.02	SPARE							START PUSHBUTTON							
02635.03	UL17_3_BCN2_R	RED BEACON LIGHT		UL17_3_FIO1_P5_C10				UL17_3_S1_PB_LT				UL19_2_FIO1_P1_C2			
02635.04	SPARE							START PUSHBUTTON LIGHT							
02635.05	UL17_3_LPE1	LASEREYE						UL17_3_S2_PB				UL19_2_FIO1_P2_C4			
02635.06	SPARE							START PUSHBUTTON LIGHT							
02635.07	UL17_3_LPE2	LASEREYE						SPARE				UL19_2_FIO1_P3_C6			
02635.08	SPARE							SPARE							
02635.09								SPARE							
02635.10								SPARE							
				UL18_3_FIO1								UL20_3_FIO1			
															
02635.11	UL18_3_BCN1_R	RED BEACON LIGHT		UL18_3_FIO1_P4_C8				UL18_3_S1_PB				UL20_3_FIO1_P0_C0			
02635.12	SPARE							START PUSHBUTTON							
02635.13	UL18_3_BCN2_R	RED BEACON LIGHT		UL18_3_FIO1_P5_C10				UL18_3_S1_PB_LT				UL20_3_FIO1_P1_C2			
02635.14	SPARE							START PUSHBUTTON LIGHT							
02635.15	UL18_3_LPE1	LASEREYE						UL18_3_S2_PB				UL20_3_FIO1_P2_C4			
02635.16	SPARE							START PUSHBUTTON LIGHT							
02635.17	UL18_3_LPE2	LASEREYE						SPARE				UL20_3_FIO1_P3_C6			
02635.18	SPARE							SPARE							
02635.19								SPARE							
02635.20								SPARE							
								02635.21							
								UL19_2_BCN1_R				02635.22			
								RED BEACON LIGHT				SPARE			
								02635.23				UL19_2_BCN2_R			
								RED BEACON LIGHT				SPARE			
								02635.24				UL19_2_LPE1			
								LASEREYE				SPARE			
								02635.25				UL19_2_LPE1			
								LASEREYE				SPARE			
								02635.26				UL19_2_LPE2			
								LASEREYE				SPARE			
								02635.27				UL19_2_LPE2			
								LASEREYE				SPARE			
								02635.28				SPARE			
								02635.29							
								02635.30							
								02635.31				UL20_3_BCN1_R			
								RED BEACON LIGHT				UL20_3_S1_PB			
								START PUSHBUTTON				START PUSHBUTTON			
								02635.32				SPARE			
								02635.33				UL20_3_BCN2_R			
								RED BEACON LIGHT				UL20_3_S1_PB_LT			
								START PUSHBUTTON LIGHT				START PUSHBUTTON LIGHT			
								02635.34				SPARE			
								02635.35				UL20_3_LPE1			
								LASEREYE				UL20_3_S2_PB			
								SPARE				START PUSHBUTTON LIGHT			
								02635.36				SPARE			
								02635.37				UL20_3_LPE2			
								LASEREYE				SPARE			
								02635.38				SPARE			
								02635.39							
								02635.40							

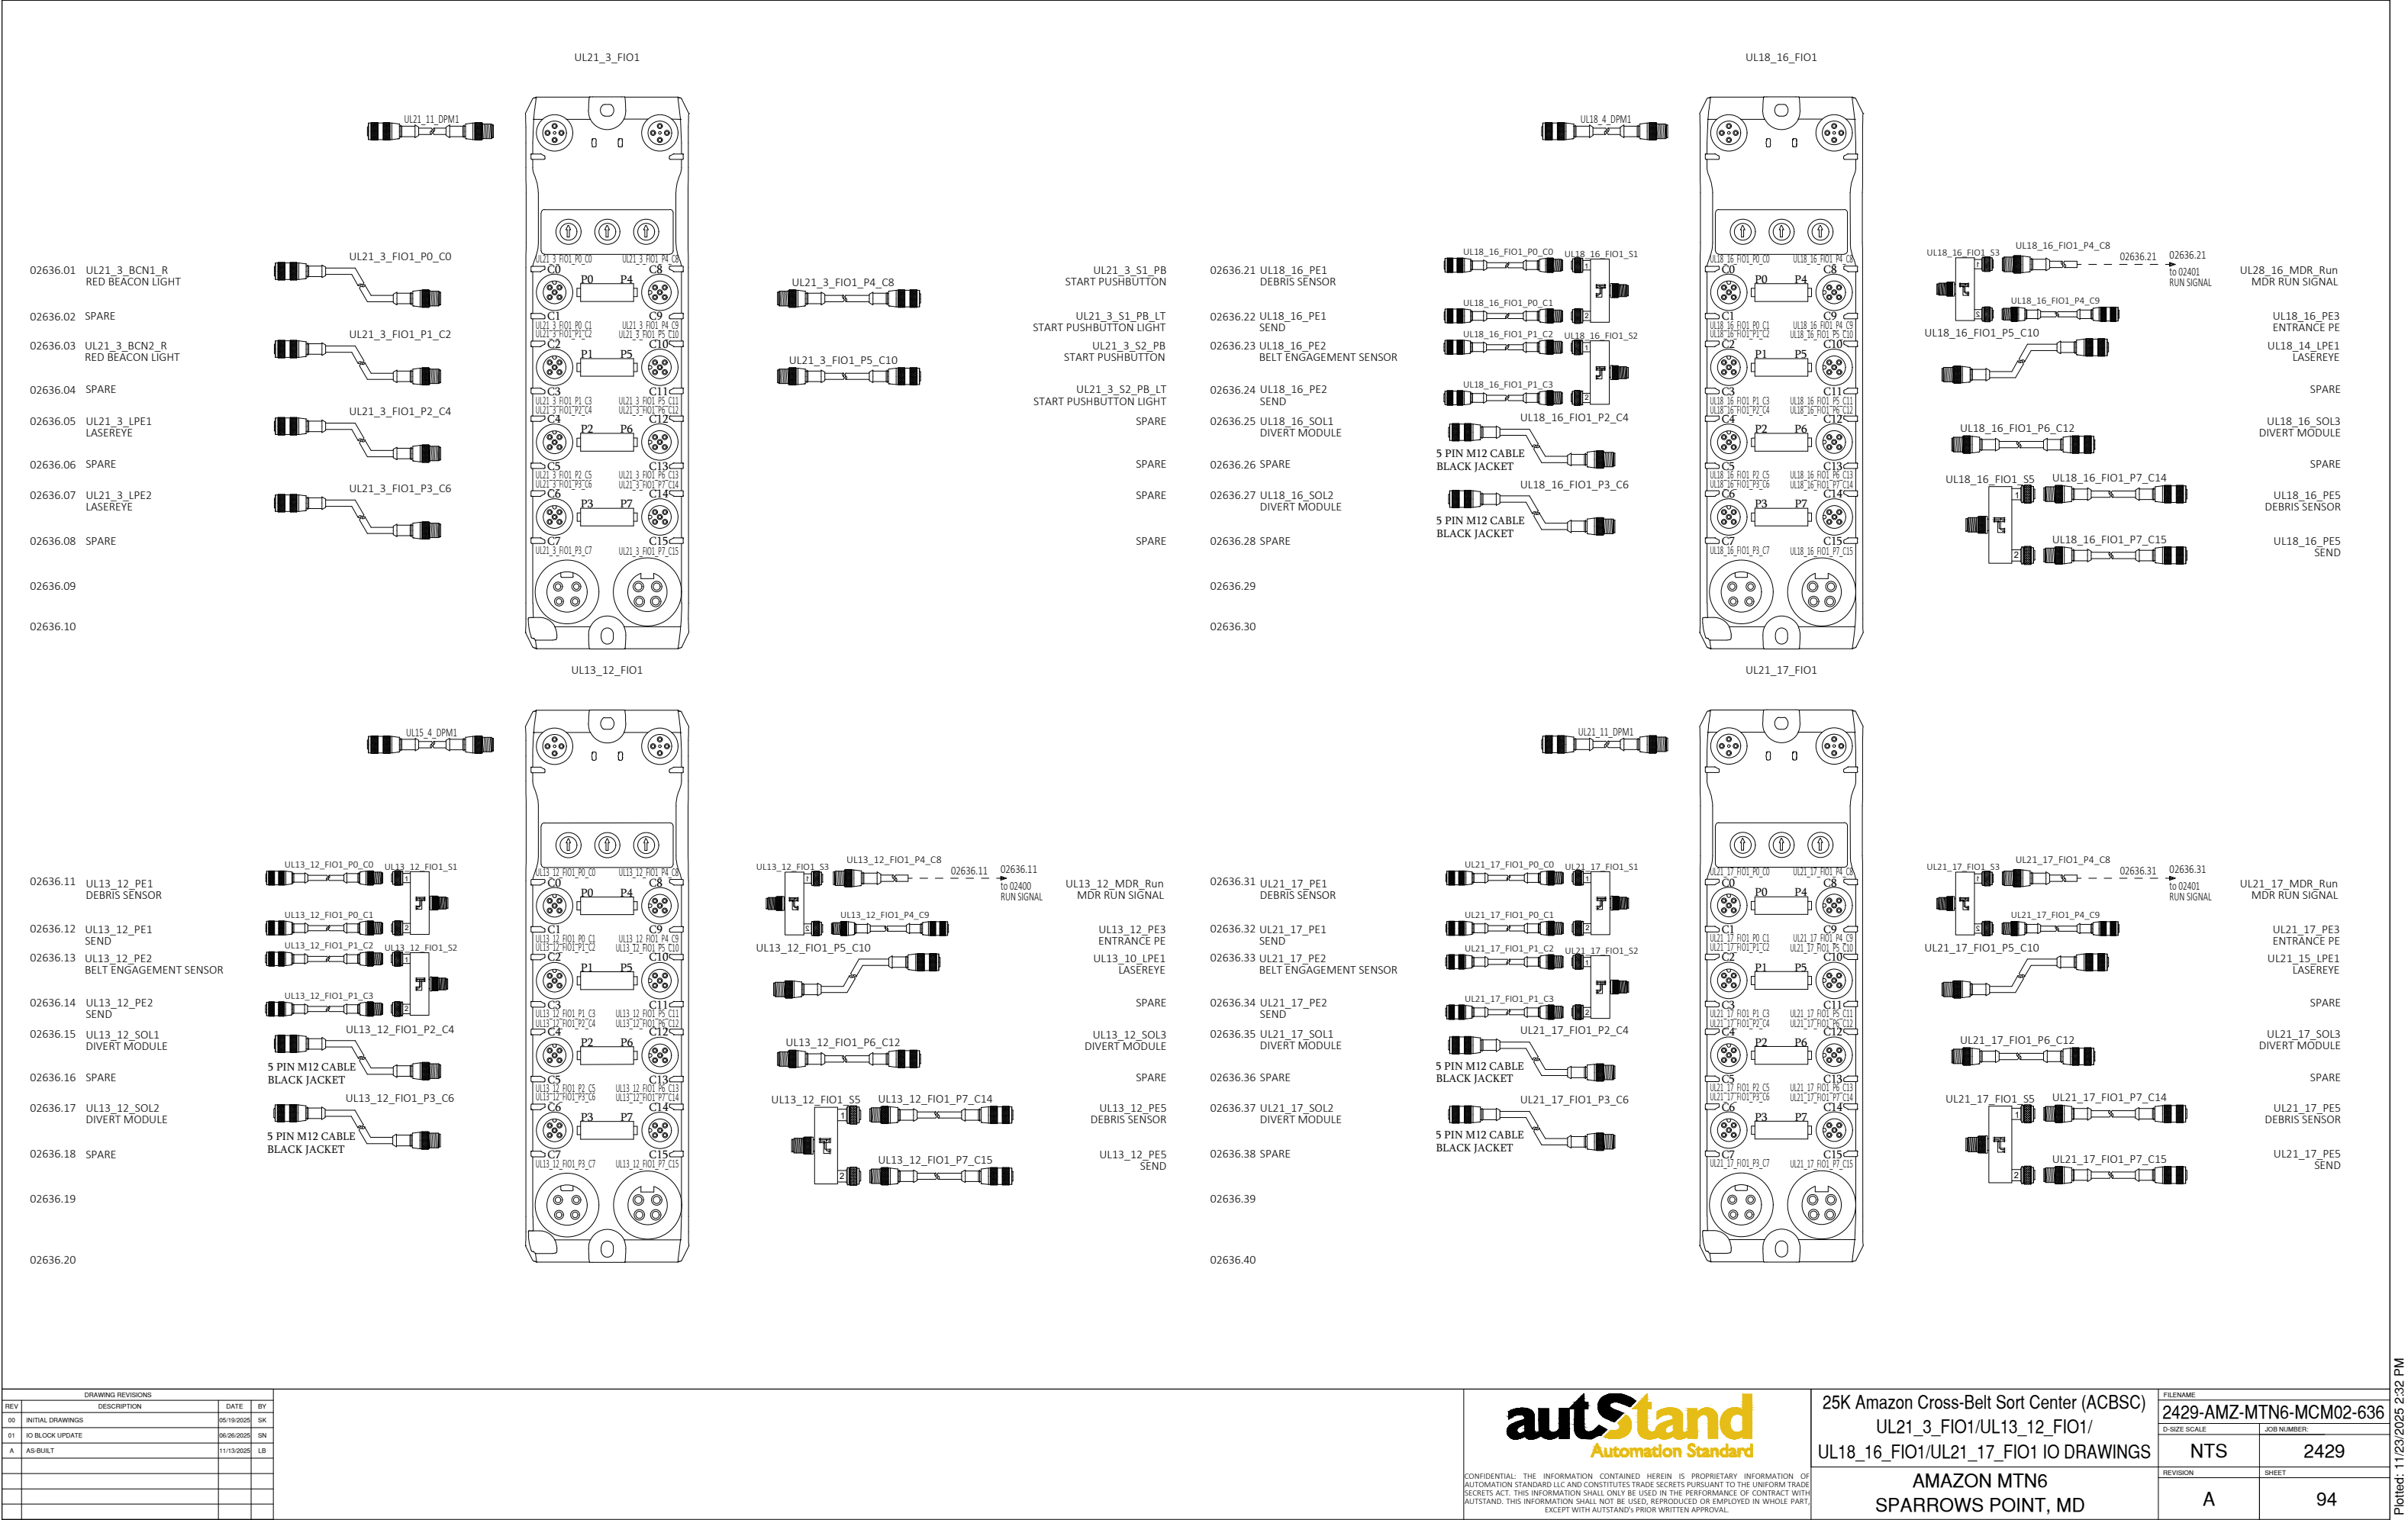

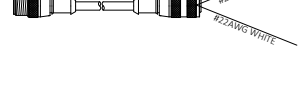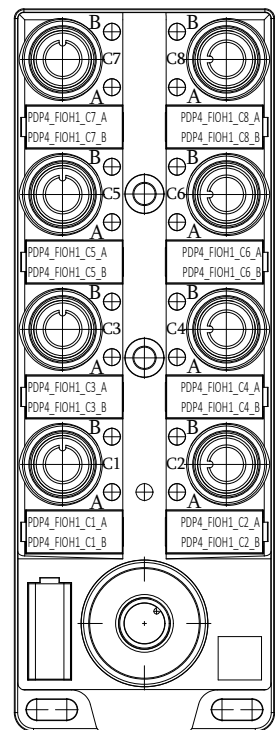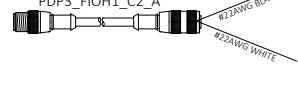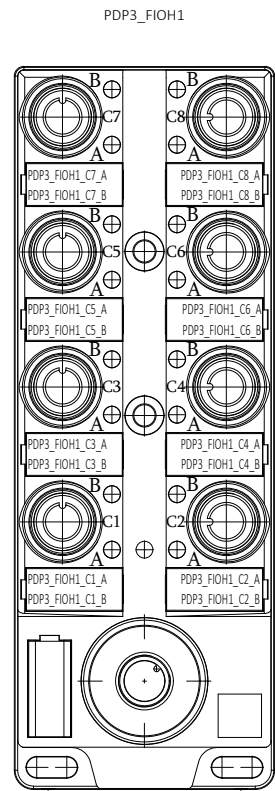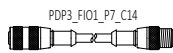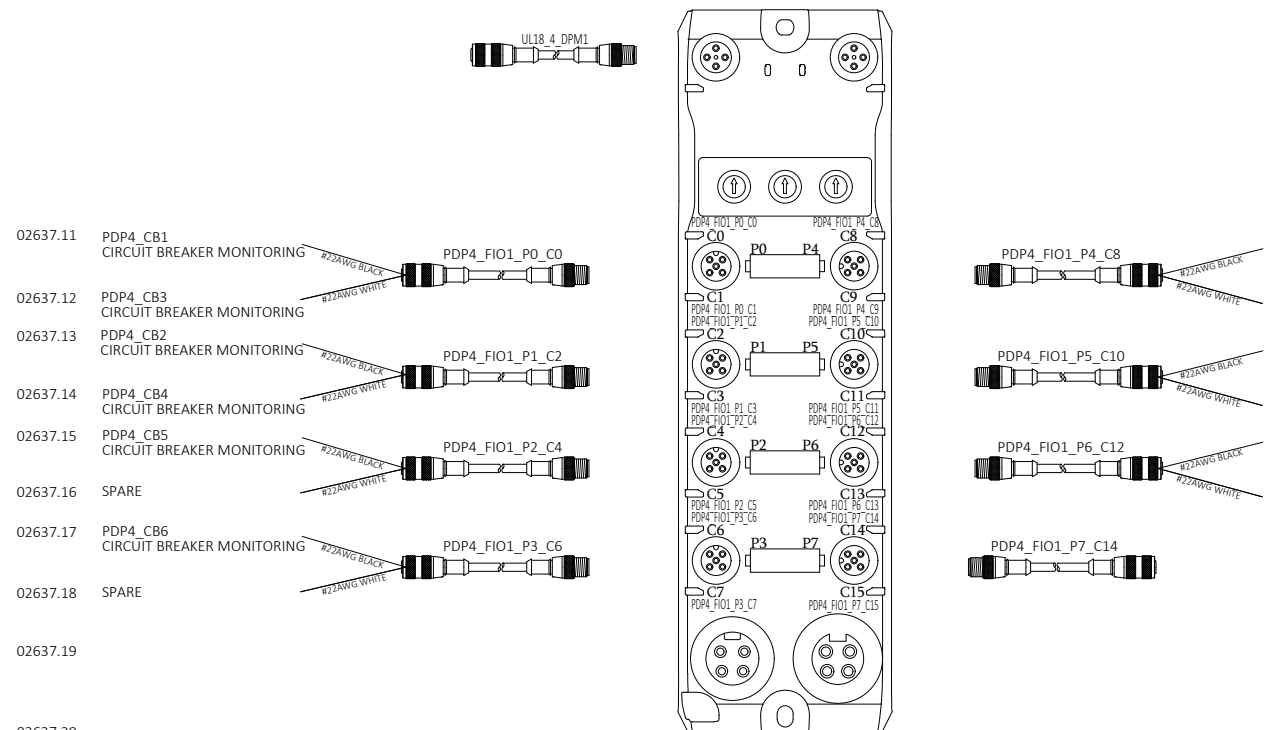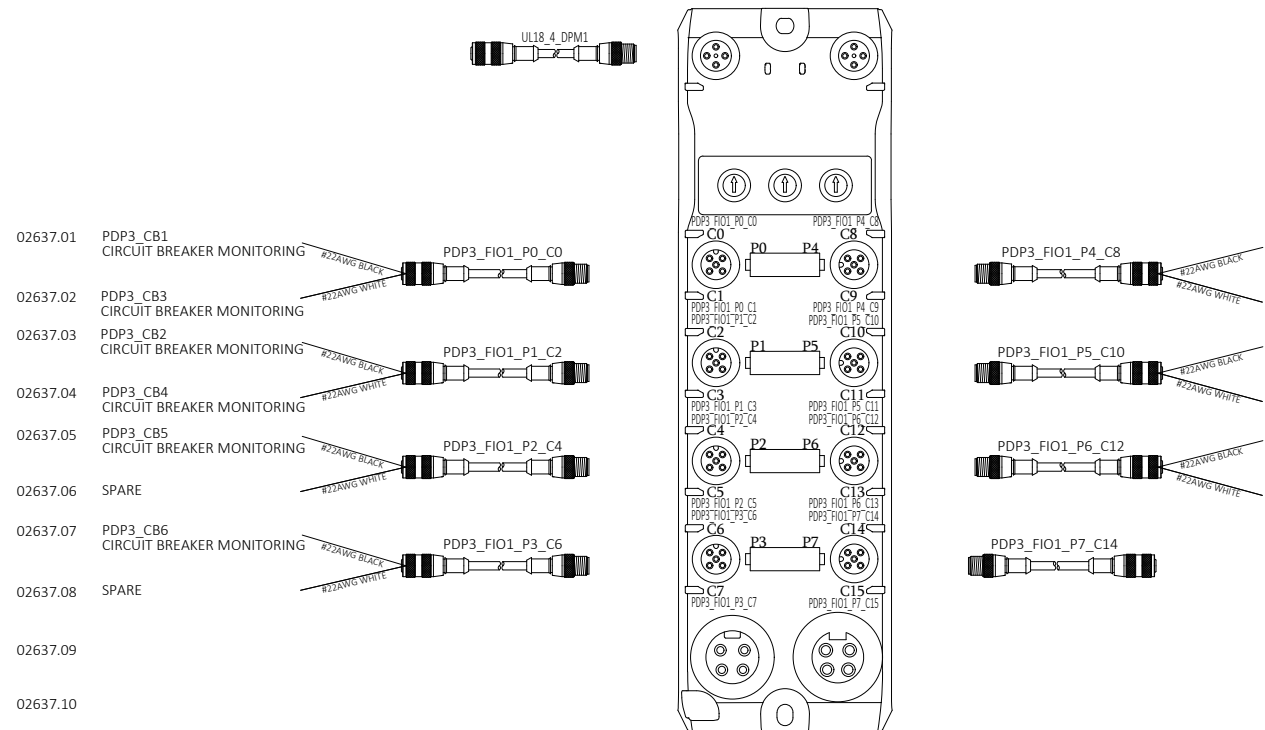

DRAWING REVISIONS			
REV	DESCRIPTION	DATE	BY
00	INITIAL DRAWINGS	05/19/2025	SK
01	ALARM HORN	06/18/2025	SN
A	AS-BUILT	11/13/2025	LB



autostand
Automation Standard

CONFIDENTIAL: THE INFORMATION CONTAINED HEREIN IS PROPRIETARY INFORMATION OF AUTOMATION STANDARD LLC AND CONSTITUTES TRADE SECRETS PURSUANT TO THE UNIFORM TRADE SECRETS ACT. THIS INFORMATION SHALL ONLY BE USED IN THE PERFORMANCE OF CONTRACT WITH AUTOSTAND. THIS INFORMATION SHALL NOT BE USED, REPRODUCED OR EMPLOYED IN WHOLE PART, EXCEPT WITH AUTOSTAND'S PRIOR WRITTEN APPROVAL.

25K Amazon Cross-Belt Sort Center (ACBSC)
FIELD DEVICES
PDP3_FIO1/PDP3_FIOH1/PDP4_FIO1/PDP4_FIOH1

AMAZON MTN6
SPARROWS POINT, MD

FILENAME	
2429-AMZ-MTN6-MCM02-637	
D-SIZE SCALE	JOB NUMBER:
NTS	2429
REVISION	SHEET
A	95



02638.40