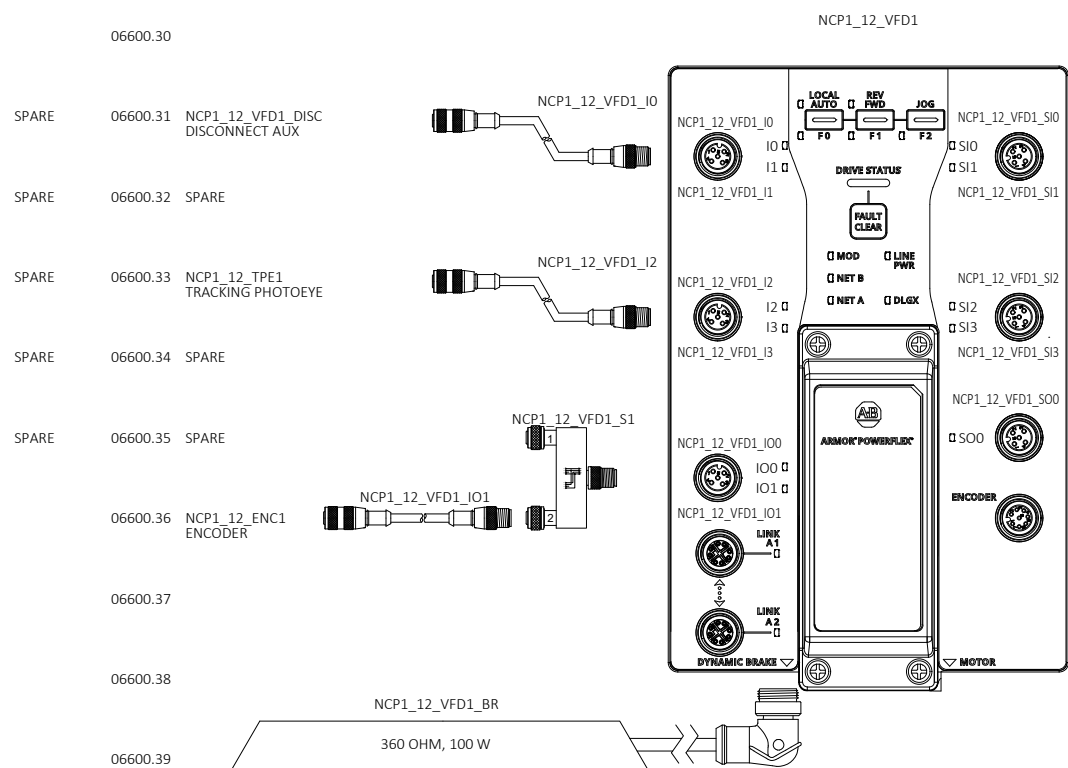
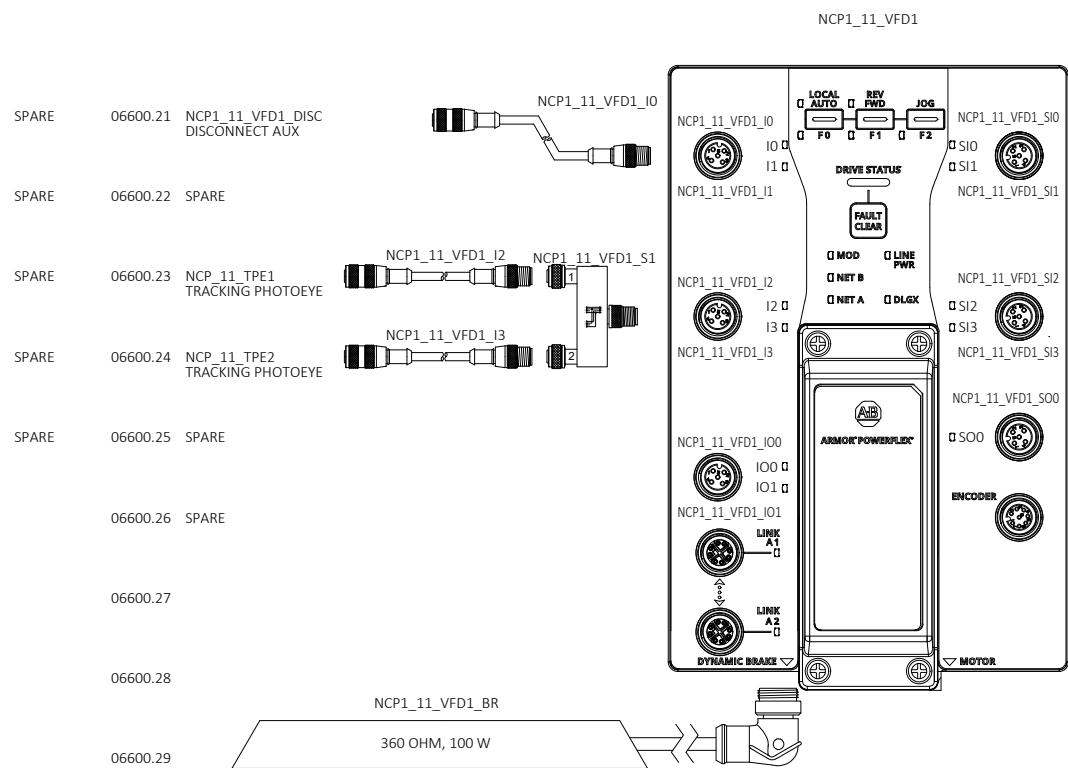
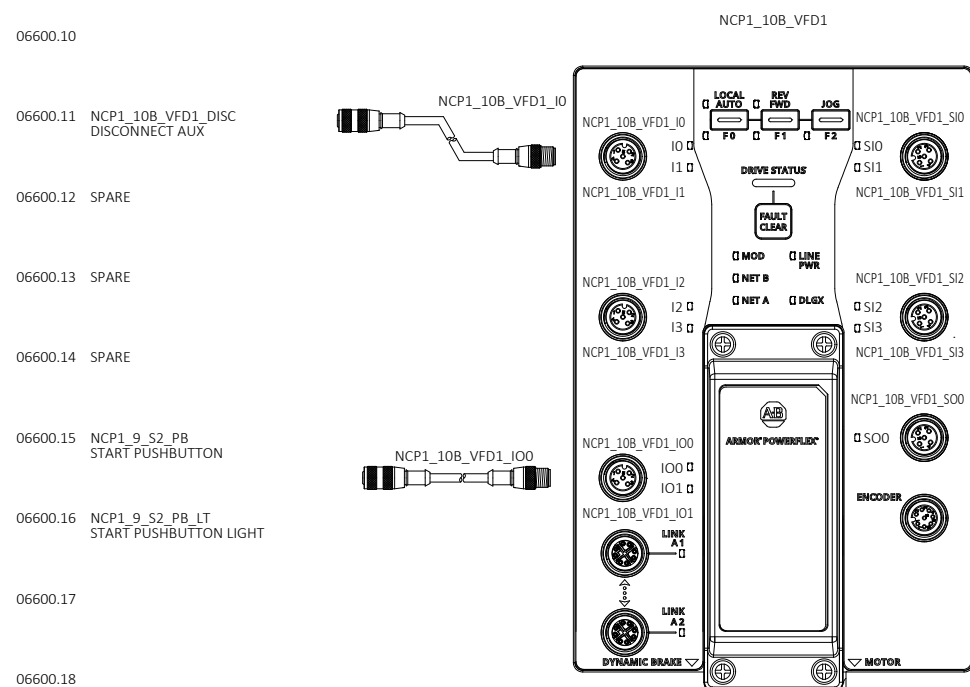
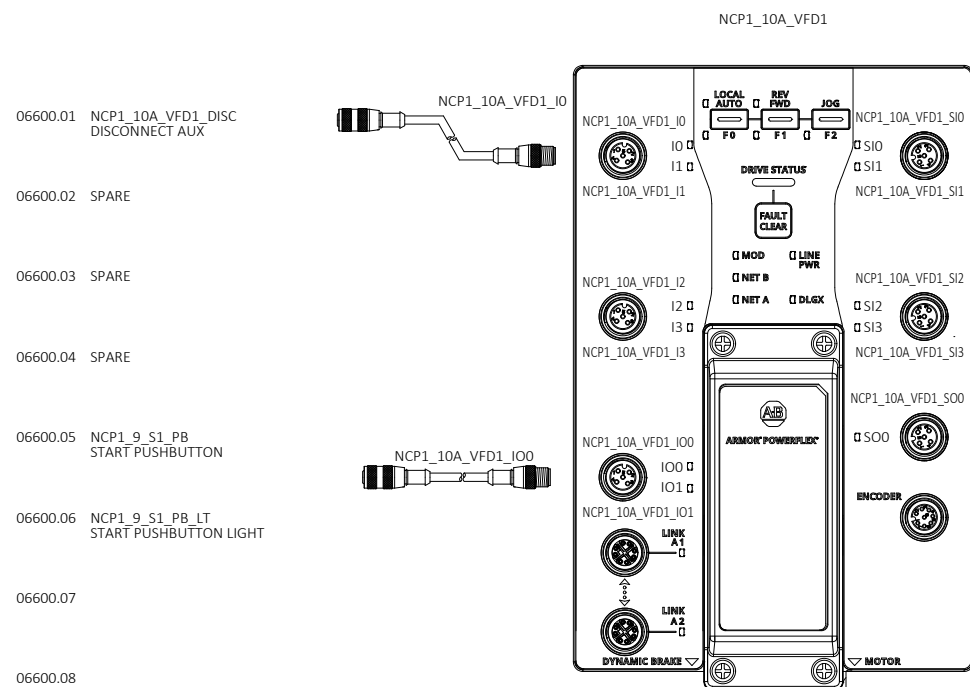

















DRAWING REVISIONS				
REV	DESCRIPTION		DATE	BY
00	INITIAL DRAWINGS		04/25/2025	SK
A	AS-BUILT		11/13/2025	LB







autostand
Automation Standard

CONFIDENTIAL: THE INFORMATION CONTAINED HEREIN IS PROPRIETARY INFORMATION OF AUTOMATION STANDARD LLC AND CONSTITUTES TRADE SECRETS PURSUANT TO THE UNIFORM TRADE SECRETS ACT. THIS INFORMATION SHALL ONLY BE USED IN THE PERFORMANCE OF CONTRACT WITH AUTOSTAND. THIS INFORMATION SHALL NOT BE USED, REPRODUCED OR EMPLOYED IN WHOLE PART, EXCEPT WITH AUTOSTAND'S PRIOR WRITTEN APPROVAL.

25K Amazon Cross-Belt Sort Center (ACBSC) NCP1_10A_VFD1/NCP1_10B_VFD1/ NCP1_11_VFD1/NCP1_12_VFD1 IO DRAWINGS	FILENAME 2429-AMZ-MTN6-MCM06-600	
	D-SIZE SCALE NTS	JOB NUMBER: 2429
	REVISION A	SHEET 45
	AMAZON MTN6 SPARROWS POINT, MD	

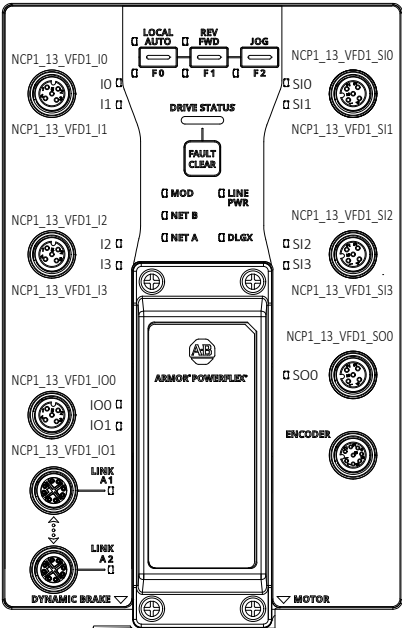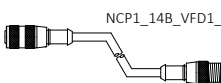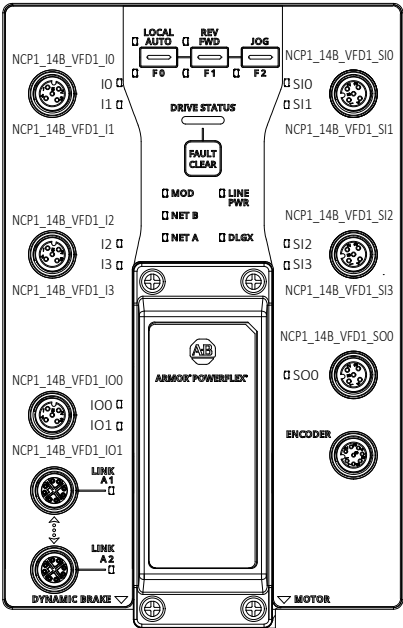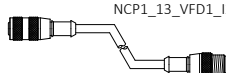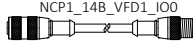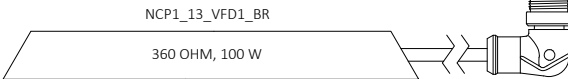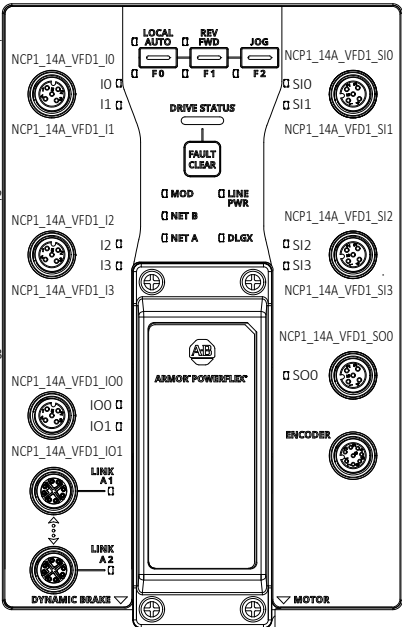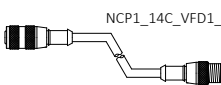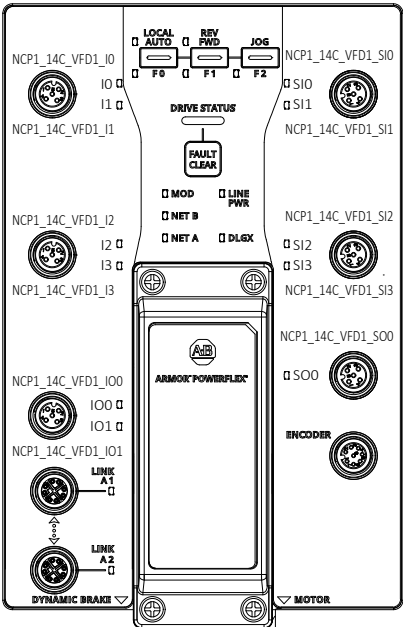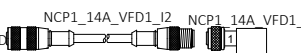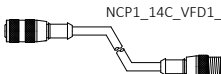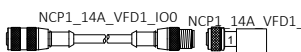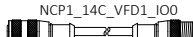		NCP1_13_VFD1				NCP1_14B_VFD1																																			
06601.01	NCP1_13_VFD1_DISC DISCONNECT AUX			SPARE	06601.21	NCP1_14B_VFD1_DISC DISCONNECT AUX			SPARE																																
06601.02	NCP1_13_ENC1 ENCODER				06601.22	SPARE																																			
06601.03	NCP1_13_TPE1 TRACKING PHOTOEYE				06601.23	SPARE																																			
06601.04	SPARE				06601.24	SPARE																																			
06601.05	SPARE				06601.25	NCP1_15_S2_PB START PUSHBUTTON																																			
06601.06	SPARE				06601.26	NCP1_15_S2_PB_LT START PUSHBUTTON LIGHT																																			
06601.07					06601.27																																				
06601.08					06601.28																																				
06601.09					06601.29																																				
06601.10					06601.30																																				
06601.11	NCP1_14A_VFD1_DISC DISCONNECT AUX			SPARE	06601.31	NCP1_14C_VFD1_DISC DISCONNECT AUX			SPARE																																
06601.12	NCP1_14_ENC1 ENCODER				06601.32	SPARE																																			
06601.13	NCP1_14_SCALE_FAULTED SCALE FAULTED				06601.33	NCP1_14_SCALE_OVERWEIGHT OVERWEIGHT DETECTED																																			
06601.14	NCP1_14_SCALE_RUNNING SCALE RUNNING				06601.34	SPARE																																			
06601.15	NCP1_14_SCALE_AUTO SCALE AUTO MODE				06601.35	NCP1_15_S1_PB START PUSHBUTTON																																			
06601.16	NCP1_14_SCALE_FAULT_RESET SCALE FAULT RESET				06601.36	NCP1_15_S1_PB_LT START PUSHBUTTON LIGHT																																			
06601.17					06601.37																																				
06601.18					06601.38																																				
06601.19					06601.39																																				
06601.20					06601.40																																				
<table><tr><th colspan="4">DRAWING REVISIONS</th></tr><tr><th>REV</th><th>DESCRIPTION</th><th>DATE</th><th>BY</th></tr><tr><td>00</td><td>INITIAL DRAWINGS</td><td>04/25/2005</td><td>SK</td></tr><tr><td>A</td><td>AS-BUILT</td><td>11/13/2005</td><td>LB</td></tr><tr><td> </td><td> </td><td> </td><td> </td></tr><tr><td> </td><td> </td><td> </td><td> </td></tr><tr><td> </td><td> </td><td> </td><td> </td></tr><tr><td> </td><td> </td><td> </td><td> </td></tr></table>					DRAWING REVISIONS				REV	DESCRIPTION	DATE	BY	00	INITIAL DRAWINGS	04/25/2005	SK	A	AS-BUILT	11/13/2005	LB																			25K Amazon Cross-Belt Sort Center (ACBSC) NCP1_13_VFD1/NCP1_14A_VFD1/ NCP1_14B_VFD1/NCP1_14C_VFD1 IO DRAWINGS		AMAZON MTN6 SPARROWS POINT, MD
DRAWING REVISIONS																																									
REV	DESCRIPTION	DATE	BY																																						
00	INITIAL DRAWINGS	04/25/2005	SK																																						
A	AS-BUILT	11/13/2005	LB																																						
						CONFIDENTIAL: THE INFORMATION CONTAINED HEREIN IS PROPRIETARY INFORMATION OF AUTOMATION STANDARD LLC AND CONSTITUTES TRADE SECRETS PURSUANT TO THE UNIFORM TRADE SECRETS ACT. THIS INFORMATION SHALL ONLY BE USED IN THE PERFORMANCE OF CONTRACT WITH AUTISTAND. THIS INFORMATION SHALL NOT BE USED, REPRODUCED OR EMPLOYED IN WHOLE PART, EXCEPT WITH AUTISTAND'S PRIOR WRITTEN APPROVAL.																																			
						FILENAME 2429-AMZ-MTN6-MCM06-601		D-SIZE SCALE NTS		JOB NUMBER 2429																															
						REVISION A		SHEET 46																																	

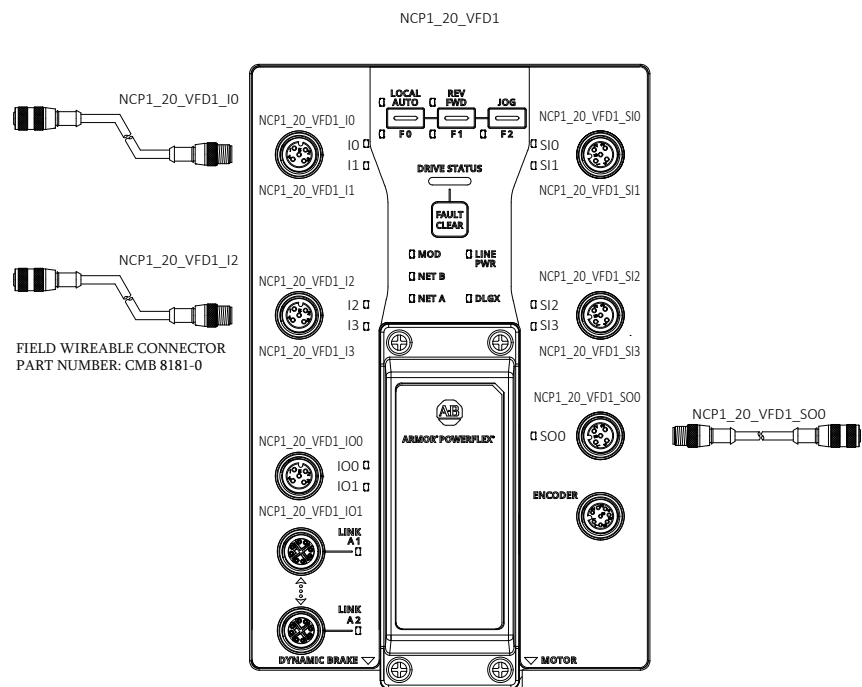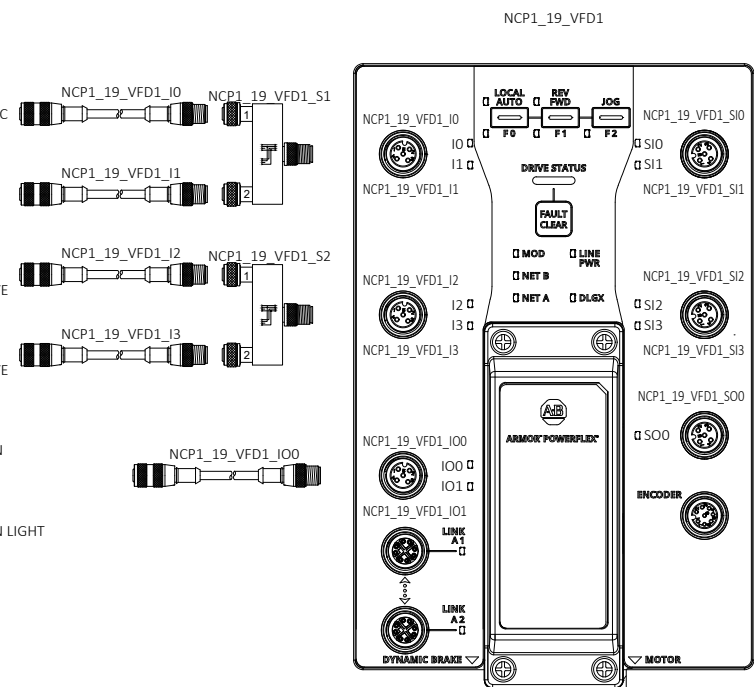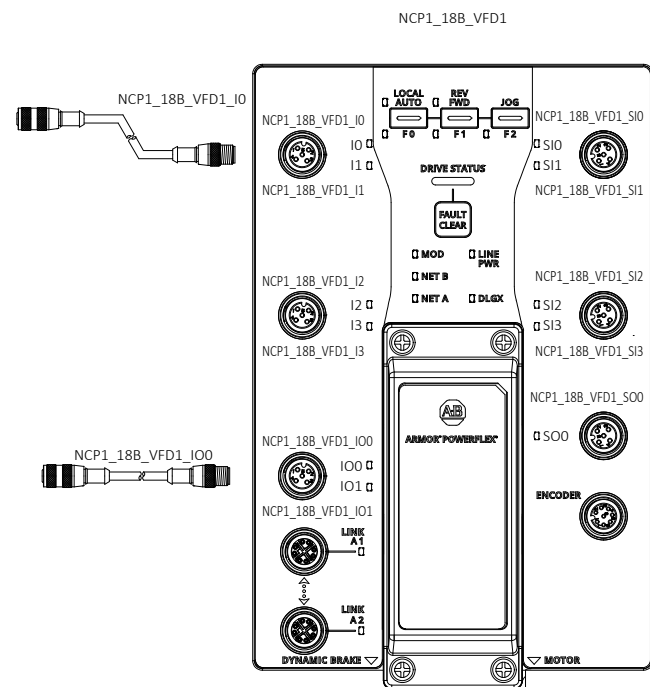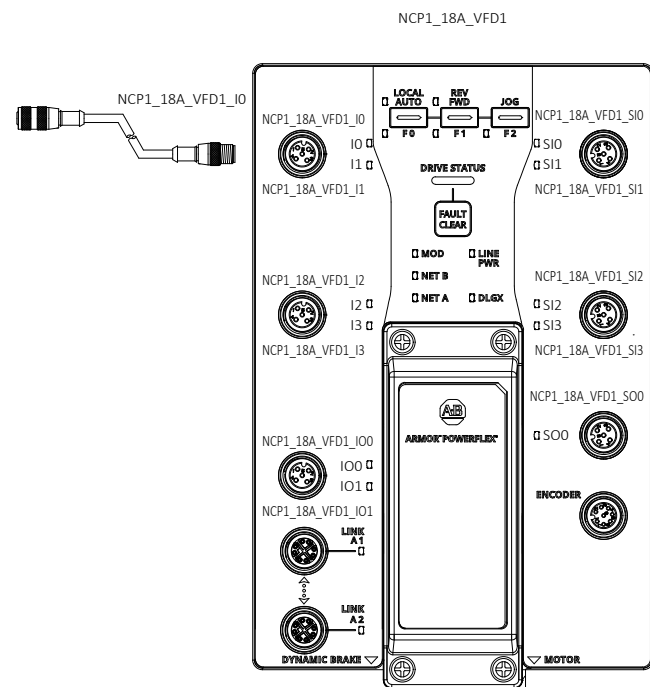11/21/2025 4:43 PM







DRAWING REVISIONS			
REV	DESCRIPTION	DATE	BY
00	INITIAL DRAWINGS	04/25/2025	SK
A	AS-BUILT	11/13/2025	LB



autistand
Automation Standard







CONFIDENTIAL: THE INFORMATION CONTAINED HEREIN IS PROPRIETARY INFORMATION OF AUTOMATION STANDARD LLC AND CONSTITUTES TRADE SECRETS PURSUANT TO THE UNIFORM TRADE SECRETS ACT. THIS INFORMATION SHALL ONLY BE USED IN THE PERFORMANCE OF CONTRACT WITH AUTISTAND. THIS INFORMATION SHALL NOT BE USED, REPRODUCED OR EMPLOYED IN WHOLE PART, EXCEPT WITH AUTISTAND'S PRIOR WRITTEN APPROVAL.

25K Amazon Cross-Belt Sort Center (ACBSC) NCP1_18A_VFD1/NCP1_18B_VFD1/ NCP1_19_VFD1/NCP1_20_VFD1 IO DRAWINGS	FILENAME 2429-AMZ-MTN6-MCM06-603	
	D-SIZE SCALE NTS	JOB NUMBER: 2429
	REVISION A	SHEET 48
	AMAZON MTN6 SPARROWS POINT, MD	

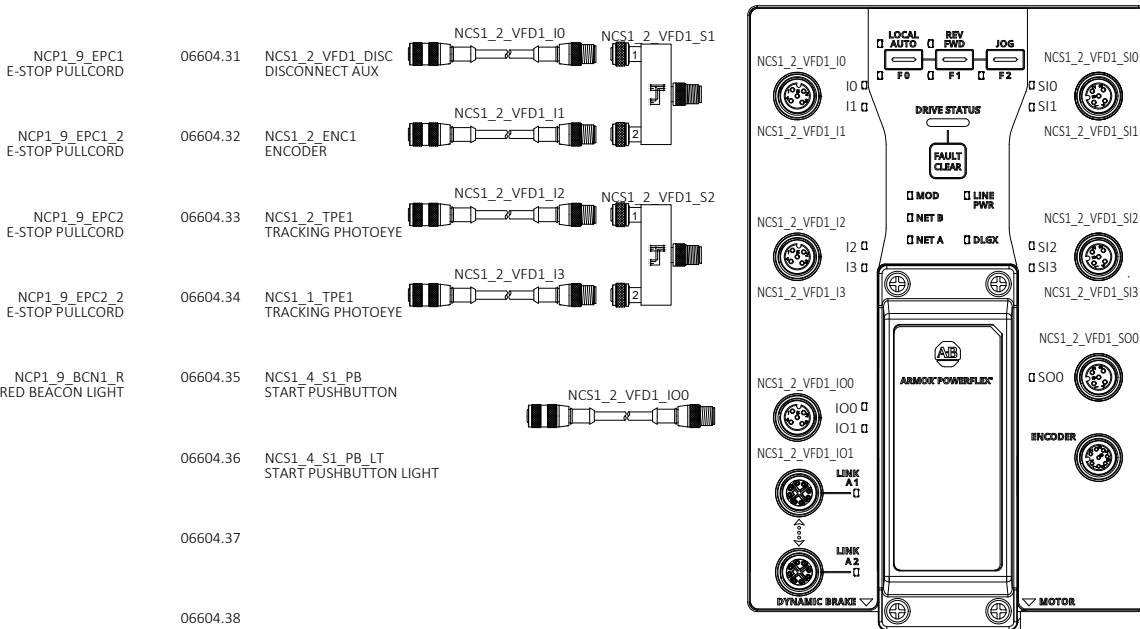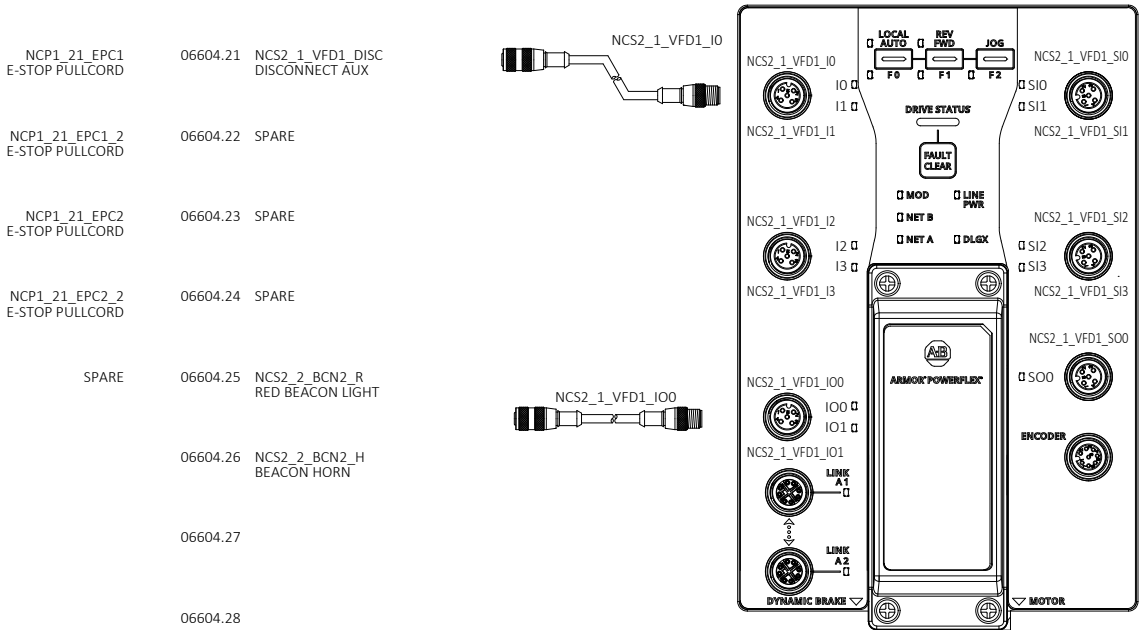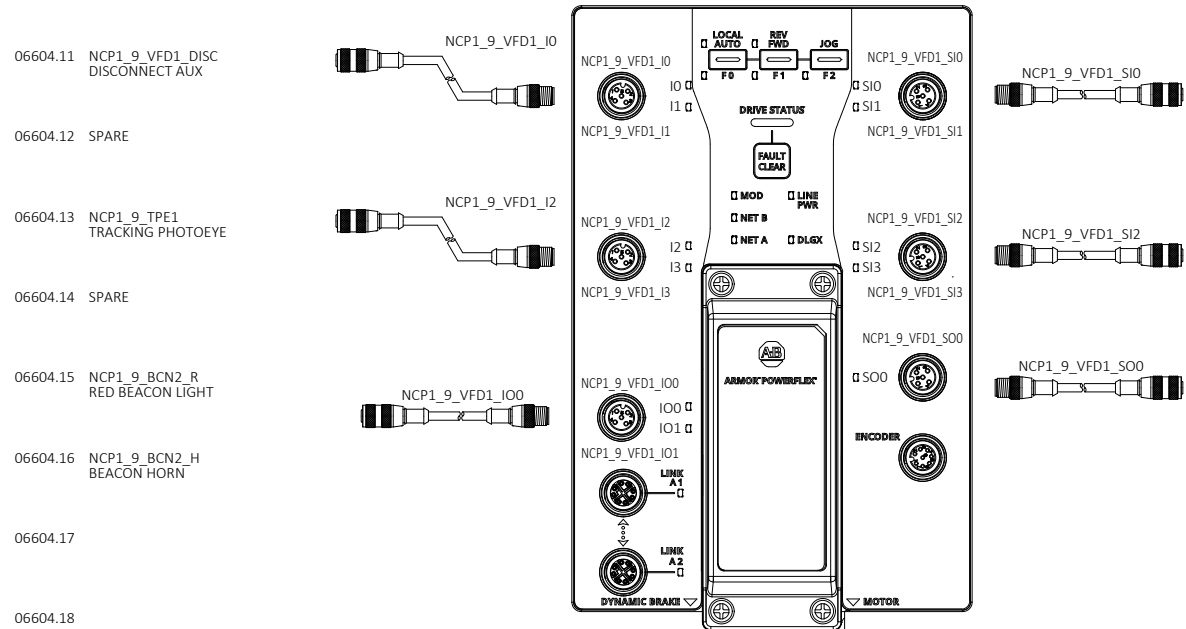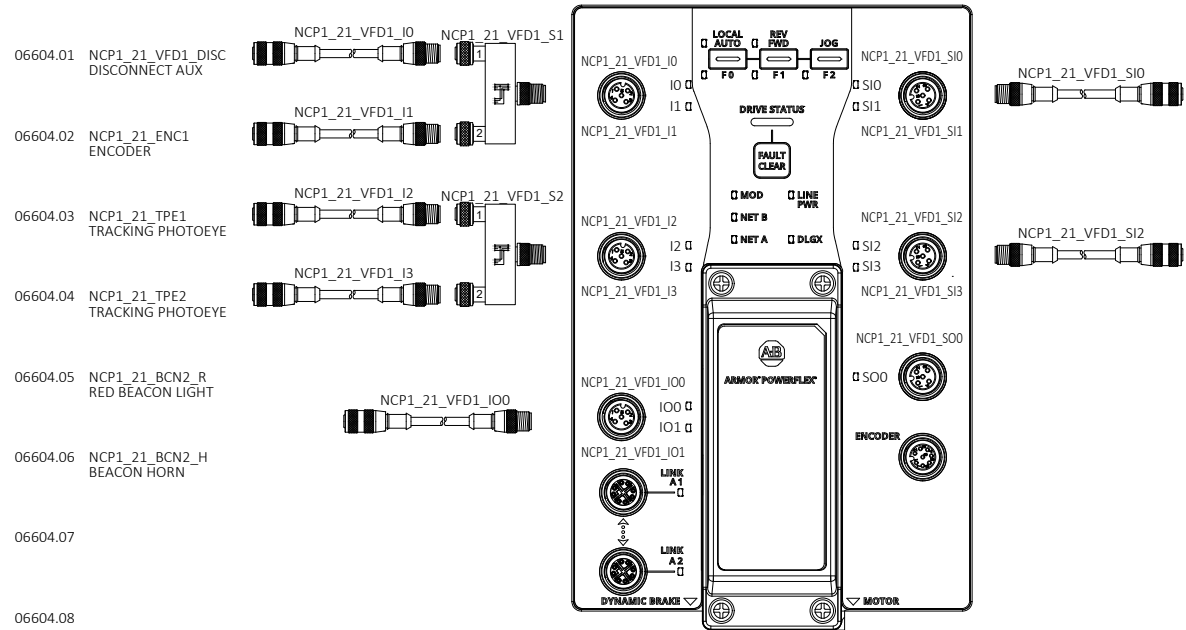

DRAWING REVISIONS			
	DESCRIPTION	DATE	BY
INITIAL DRAWINGS		04/25/2025	SK
AS-BUILT		11/13/2025	LB

 CONFIDENTIAL: THE INFORMATION CONTAINED HEREIN IS PROPRIETARY INFORMATION OF AUTOMATION STANDARD LLC AND CONSTITUTES TRADE SECRETS PURSUANT TO THE UNIFORM TRADE SECRETS ACT. THIS INFORMATION SHALL ONLY BE USED IN THE PERFORMANCE OF CONTRACT WITH AUTOSTAND. THIS INFORMATION SHALL NOT BE USED, REPRODUCED OR EMPLOYED IN WHOLE PART, EXCEPT WITH AUTOSTAND'S PRIOR WRITTEN APPROVAL.	25K Amazon Cross-Belt Sort Center (ACBSC) NCP1_21_VFD1/NCP1_9_VFD1/ NCS2_1_VFD1/NCS1_2_VFD1 IO DRAWINGS		<table><tr><td colspan="2">FILENAME</td></tr><tr><td colspan="2">2429-AMZ-MTN6-MCM06-604</td></tr><tr><td>D-SIZE SCALE</td><td>JOB NUMBER:</td></tr><tr><td>NTS</td><td>2429</td></tr><tr><td>REVISION</td><td>SHEET</td></tr><tr><td></td><td></td></tr></table>		FILENAME		2429-AMZ-MTN6-MCM06-604		D-SIZE SCALE	JOB NUMBER:	NTS	2429	REVISION	SHEET		
	FILENAME															
	2429-AMZ-MTN6-MCM06-604															
	D-SIZE SCALE	JOB NUMBER:														
	NTS	2429														
REVISION	SHEET															
AMAZON MTN6 SPARROWS POINT, MD		A	49													

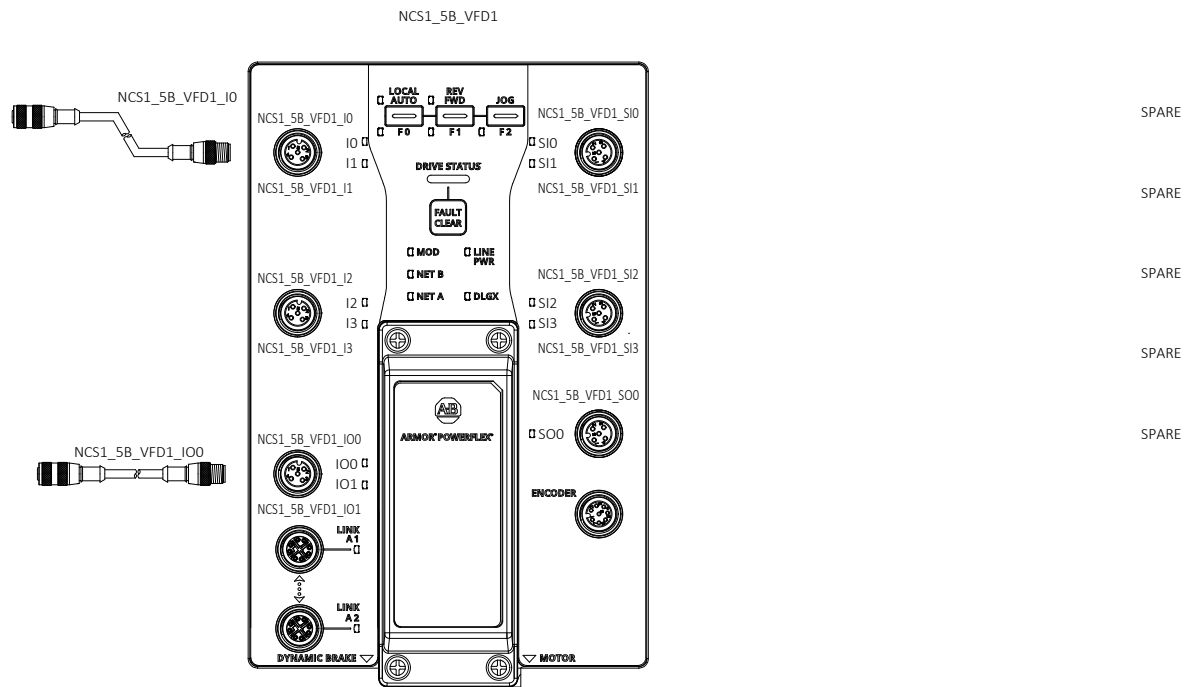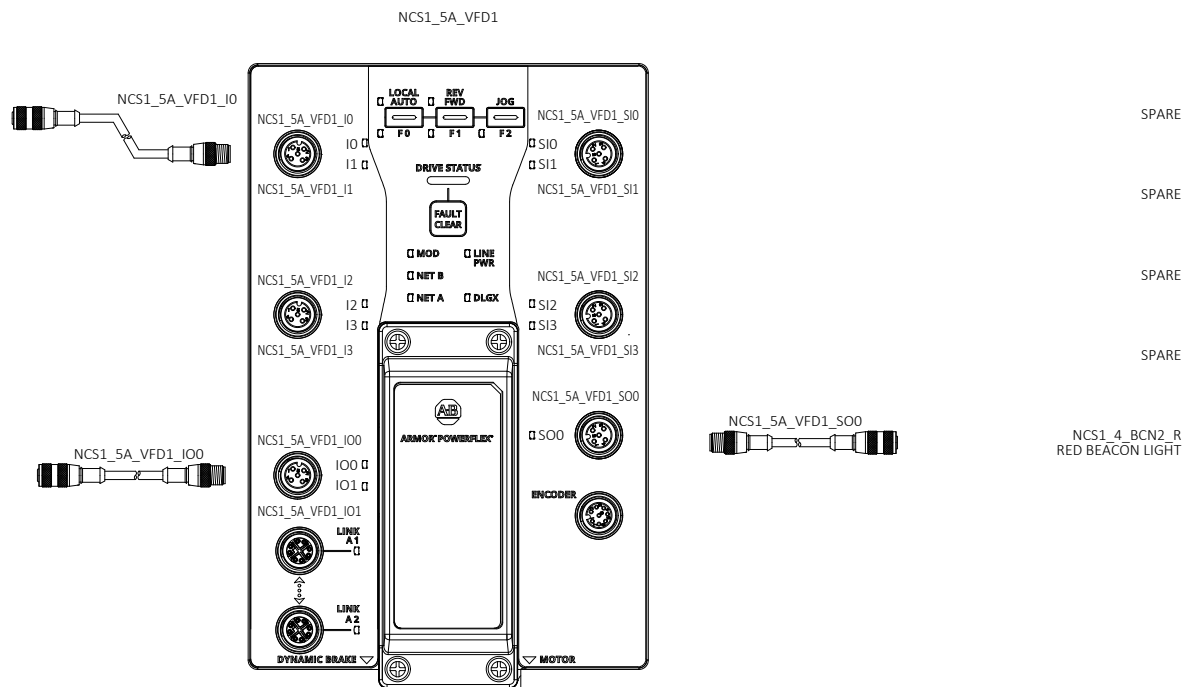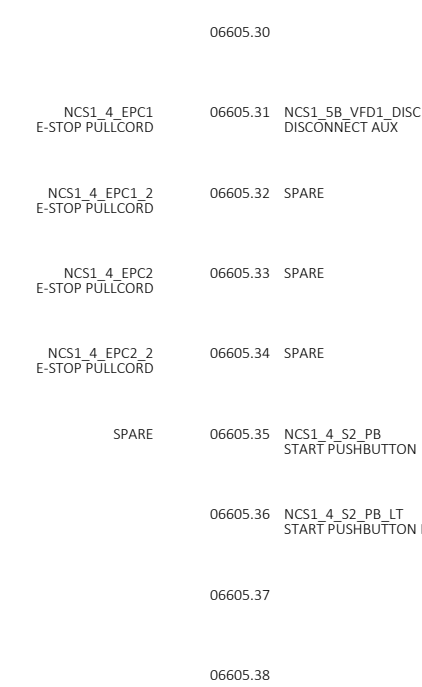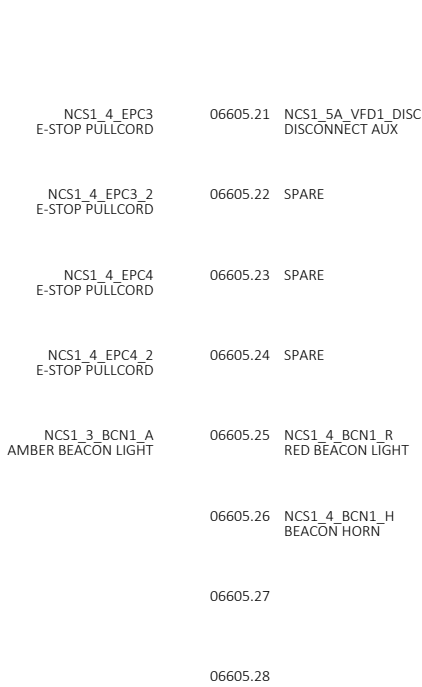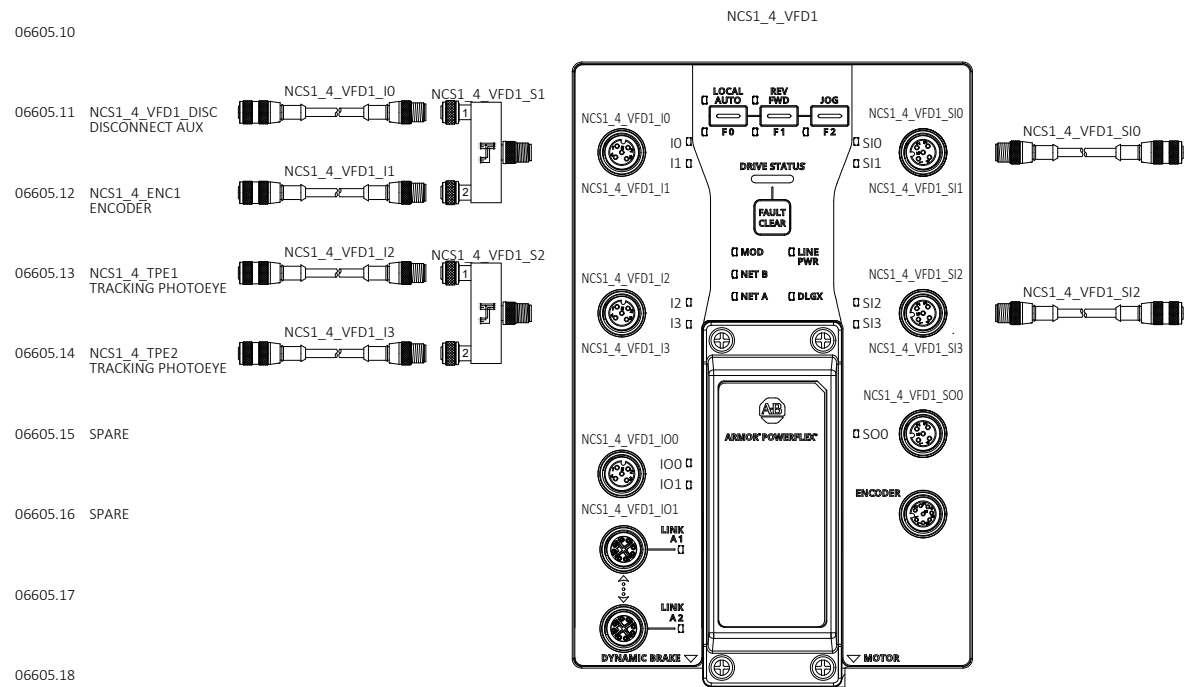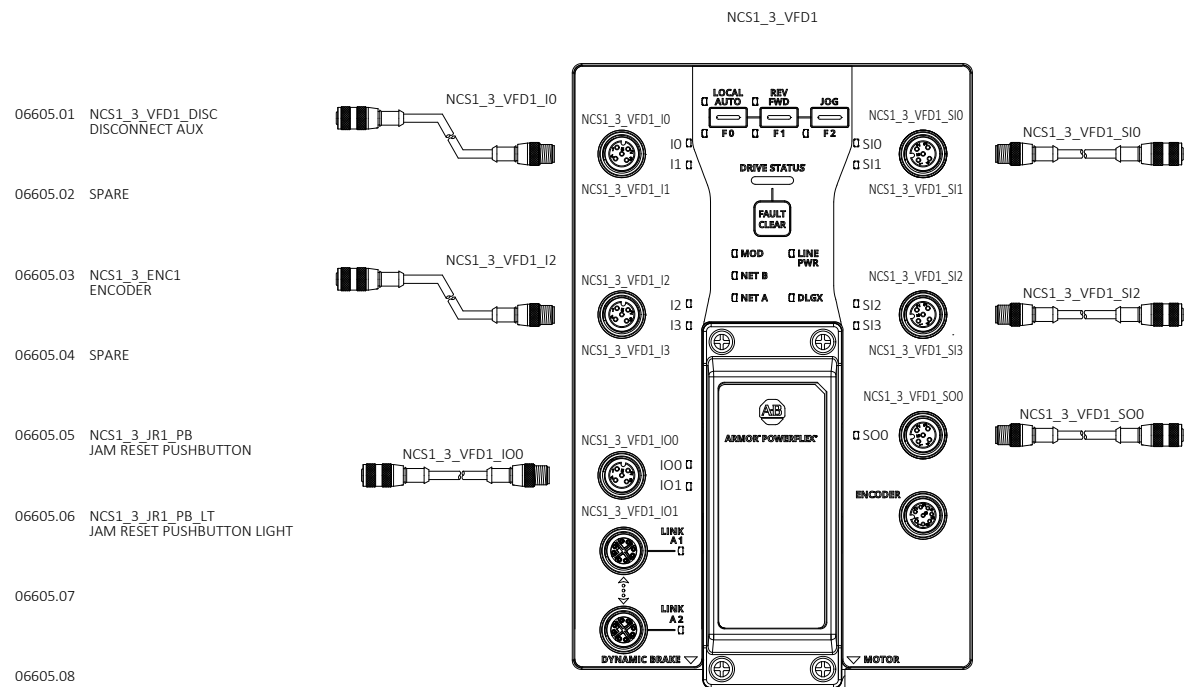



DRAWING REVISIONS			
REV	DESCRIPTION	DATE	BY
00	INITIAL DRAWINGS	04/25/2025	SK
A	AS-BUILT	11/13/2025	LB
























autStand
Automation Standard





CONFIDENTIAL: THE INFORMATION CONTAINED HEREIN IS PROPRIETARY INFORMATION OF AUTOMATION STANDARD LLC AND CONSTITUTES TRADE SECRETS PURSUANT TO THE UNIFORM TRADE SECRETS ACT. THIS INFORMATION SHALL ONLY BE USED IN THE PERFORMANCE OF CONTRACT WITH AUTOSTAND. THIS INFORMATION SHALL NOT BE USED, REPRODUCED OR EMPLOYED IN WHOLE PART EXCEPT WITH AUTOSTAND'S PRIOR WRITTEN APPROVAL.

25K Amazon Cross-Belt Sort Center (ACBSC) NCS1_3_VFD1/NCS1_4_VFD1/ NCS1_5A_VFD1/NCS1_5B_VFD1 IO DRAWINGS AMAZON MTN6 SPARROWS POINT, MD	FILENAME 2429-AMZ-MTN6-MCM06-605	
	D-SIZE SCALE NTS	JOB NUMBER: 2429
	REVISION A	SHEET 50

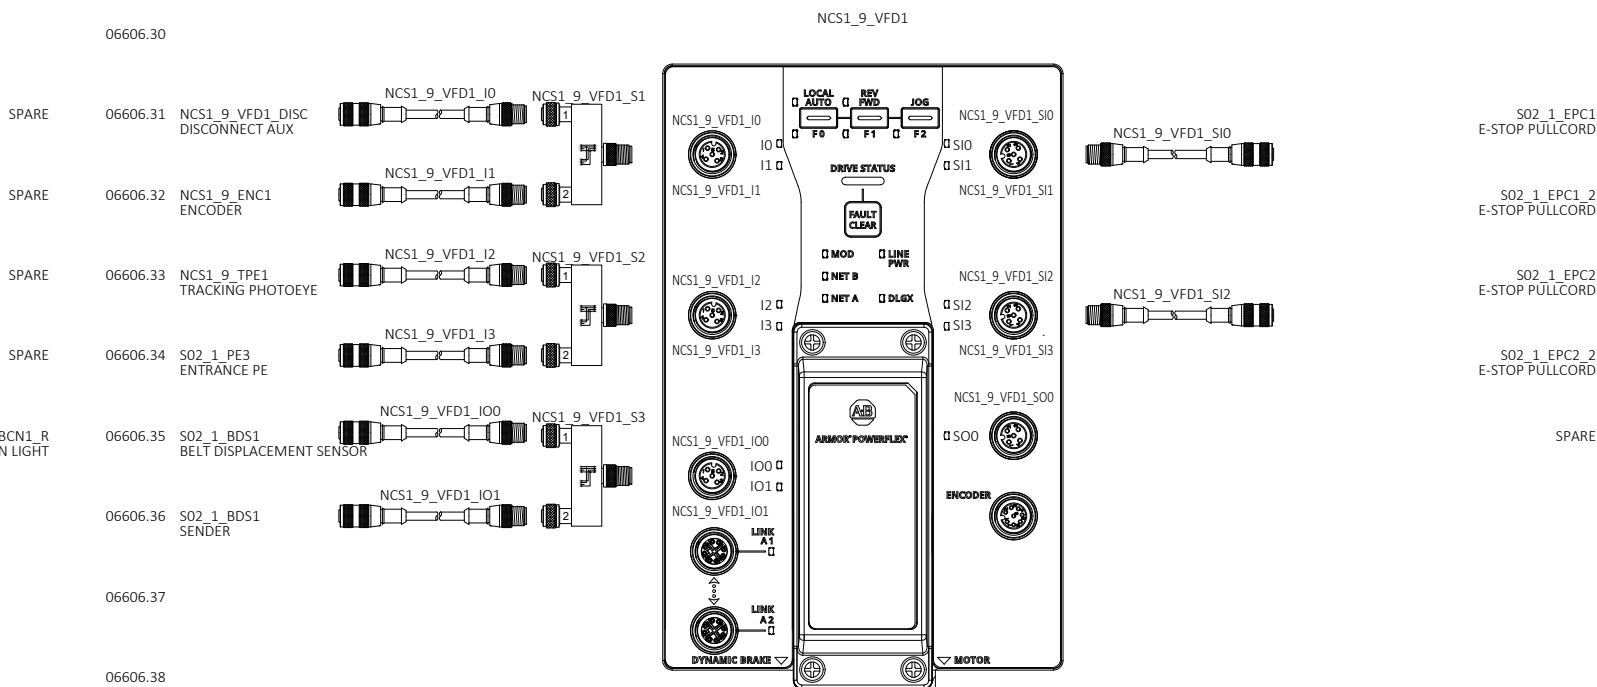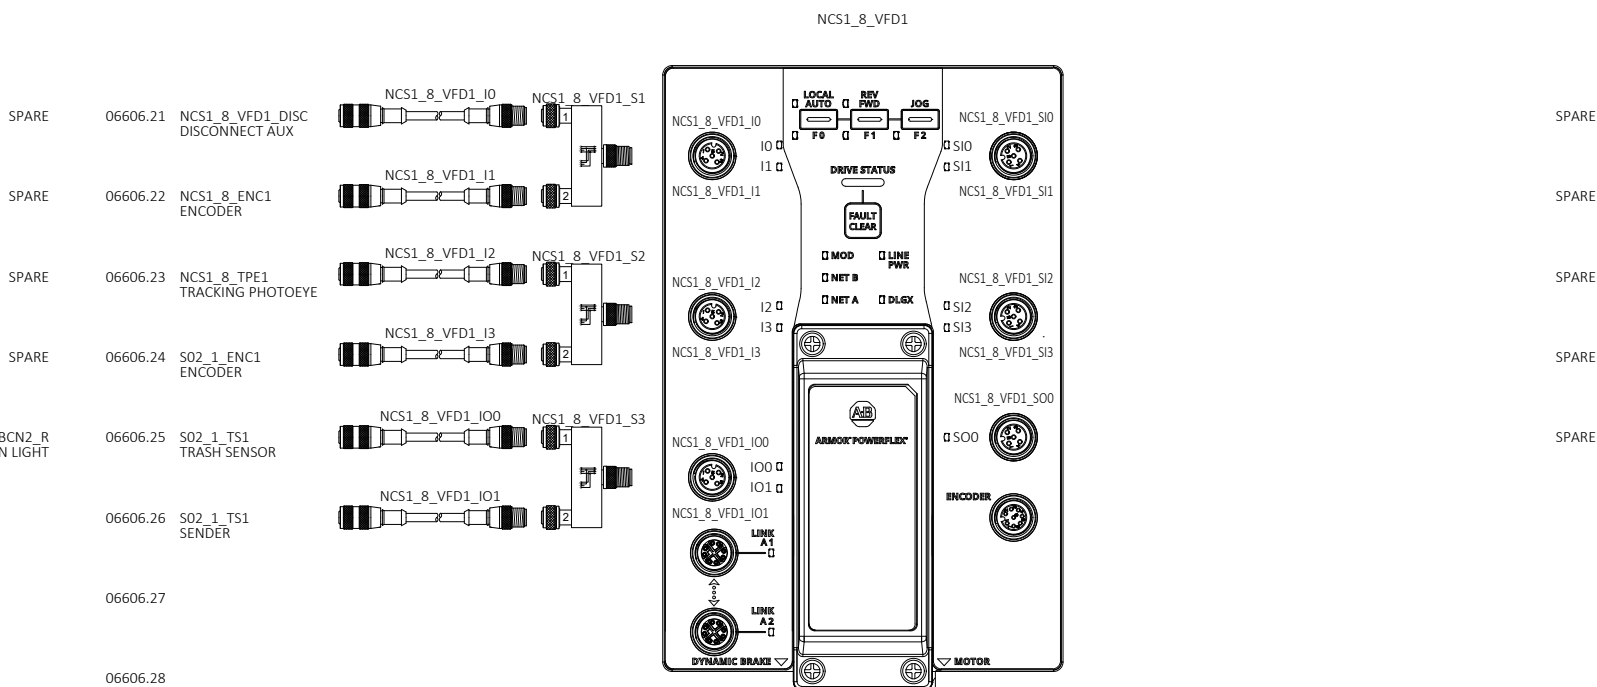

25K Amazon Cross-Belt Sort Center (ACBSC) NCS1_6_VFD1/NCS1_7_VFD1/ NCS1_8_VFD1/NCS1_9_VFD1 IO DRAWINGS AMAZON MTN6 SPARROWS POINT, MD	FILENAME 2429-AMZ-MTN6-MCM06-606	
	D-SIZE SCALE NTS	JOB NUMBER: 2429
	REVISION A	SHEET 51

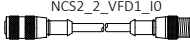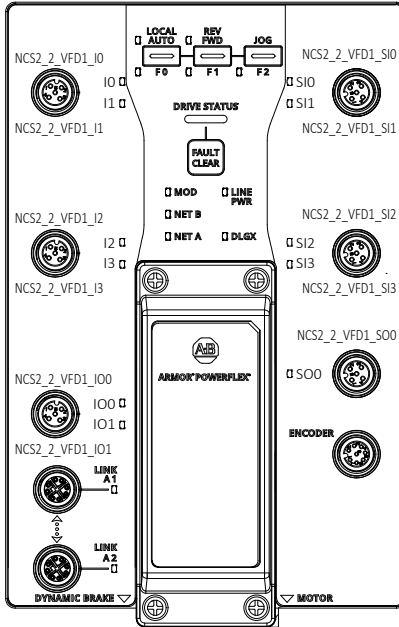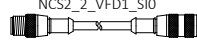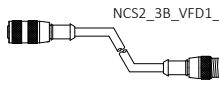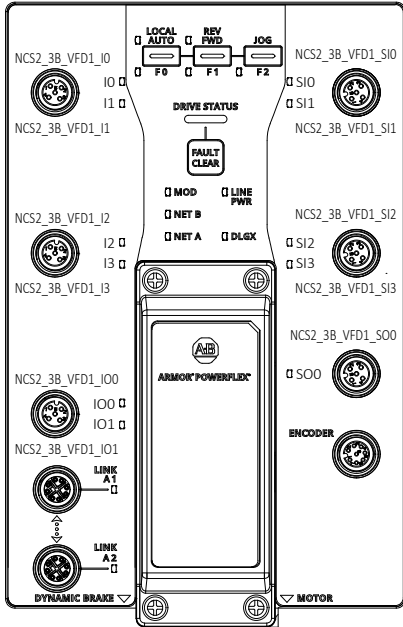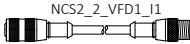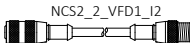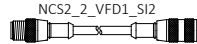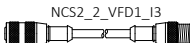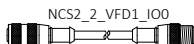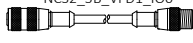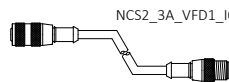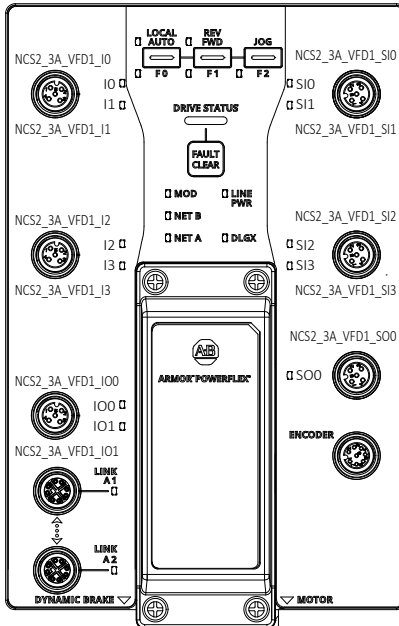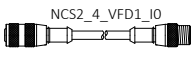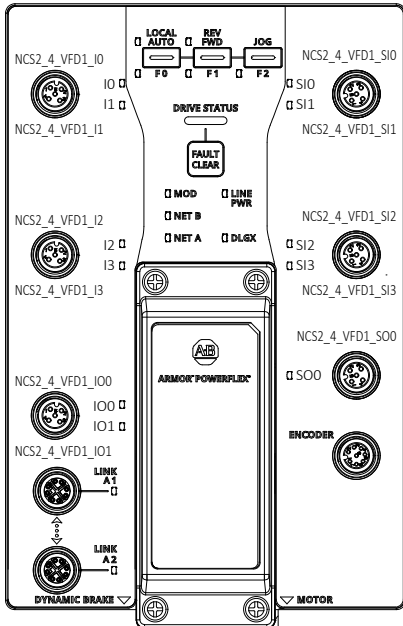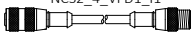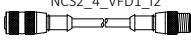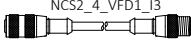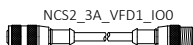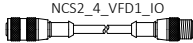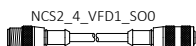		NCS2_2_VFD1				NCS2_3B_VFD1																																																													
06607.01	NCS2_2_VFD1_DISC DISCONNECT AUX		NCS2_2_VFD1_S1					NCS2_2_EPC1 E-STOP PULLCORD	06607.21	NCS2_3B_VFD1_DISC DISCONNECT AUX									SPARE																																																
06607.02	NCS2_2_ENC1 ENCODER							NCS2_2_EPC1_2 E-STOP PULLCORD	06607.22	SPARE									SPARE																																																
06607.03	NCS2_2_TPE1 TRACKING PHOTOEYE		NCS2_2_VFD1_S2					NCS2_2_EPC2 E-STOP PULLCORD	06607.23	SPARE									SPARE																																																
06607.04	NCS2_2_TPE2 TRACKING PHOTOEYE							NCS2_2_EPC2_2 E-STOP PULLCORD	06607.24	SPARE									SPARE																																																
06607.05	NCS2_2_S1_PB START PUSHBUTTON							SPARE	06607.25	NCS2_2_BCN1_A AMBER BEACON LIGHT									SPARE																																																
06607.06	NCS2_2_S1_PB_LT START PUSHBUTTON LIGHT								06607.26	NCS2_2_BCN1_R RED BEACON LIGHT																																																									
06607.07									06607.27																																																										
06607.08									06607.28																																																										
06607.09									06607.29																																																										
06607.10				NCS2_3A_VFD1					06607.30			NCS2_4_VFD1																																																							
06607.11	NCS2_3A_VFD1_DISC DISCONNECT AUX							SPARE	06607.31	NCS2_4_VFD1_DISC DISCONNECT AUX		NCS2_4_VFD1_S1							SPARE																																																
06607.12	SPARE							SPARE	06607.32	NCS2_4_ENC1 ENCODER								SPARE																																																	
06607.13	SPARE							SPARE	06607.33	NCS2_4_TPE1 TRACKING PHOTOEYE		NCS2_4_VFD1_S2						SPARE																																																	
06607.14	SPARE							SPARE	06607.34	NCS2_4_TPE2 TRACKING PHOTOEYE								SPARE																																																	
06607.15	NCS2_2_S2_PB START PUSHBUTTON							SPARE	06607.35	S02_2_S2_PB START PUSHBUTTON								S02_2_BCN2_R RED BEACON LIGHT																																																	
06607.16	NCS2_2_S2_PB_LT START PUSHBUTTON LIGHT								06607.36	S02_2_S2_PB_LT START PUSHBUTTON LIGHT																																																									
06607.17									06607.37																																																										
06607.18									06607.38																																																										
06607.19									06607.39																																																										
06607.20									06607.40																																																										
<table><tr><th colspan="4">DRAWING REVISIONS</th></tr><tr><th>REV</th><th>DESCRIPTION</th><th>DATE</th><th>BY</th></tr><tr><td>00</td><td>INITIAL DRAWINGS</td><td>04/25/2005</td><td>SK</td></tr><tr><td>A</td><td>AS-BUILT</td><td>11/13/2005</td><td>LB</td></tr><tr><td> </td><td> </td><td> </td><td> </td></tr><tr><td> </td><td> </td><td> </td><td> </td></tr><tr><td> </td><td> </td><td> </td><td> </td></tr><tr><td> </td><td> </td><td> </td><td> </td></tr><tr><td> </td><td> </td><td> </td><td> </td></tr></table>				DRAWING REVISIONS				REV	DESCRIPTION	DATE	BY	00	INITIAL DRAWINGS	04/25/2005	SK	A	AS-BUILT	11/13/2005	LB																													25K Amazon Cross-Belt Sort Center (ACBSC) NCS2_2_VFD1/NCS2_3A_VFD1/ NCS2_3B_VFD1/NCS2_4_VFD1 IO DRAWINGS				<table><tr><th colspan="2">FILENAME</th></tr><tr><td>2429-AMZ-MTN6-MCM06-607</td><td></td></tr><tr><th>D-SIZE SCALE</th><th>JOB NUMBER</th></tr><tr><td>NTS</td><td>2429</td></tr><tr><th>REVISION</th><th>SHEET</th></tr><tr><td>A</td><td>52</td></tr></table>				FILENAME		2429-AMZ-MTN6-MCM06-607		D-SIZE SCALE	JOB NUMBER	NTS	2429	REVISION	SHEET	A	52
DRAWING REVISIONS																																																																			
REV	DESCRIPTION	DATE	BY																																																																
00	INITIAL DRAWINGS	04/25/2005	SK																																																																
A	AS-BUILT	11/13/2005	LB																																																																
FILENAME																																																																			
2429-AMZ-MTN6-MCM06-607																																																																			
D-SIZE SCALE	JOB NUMBER																																																																		
NTS	2429																																																																		
REVISION	SHEET																																																																		
A	52																																																																		

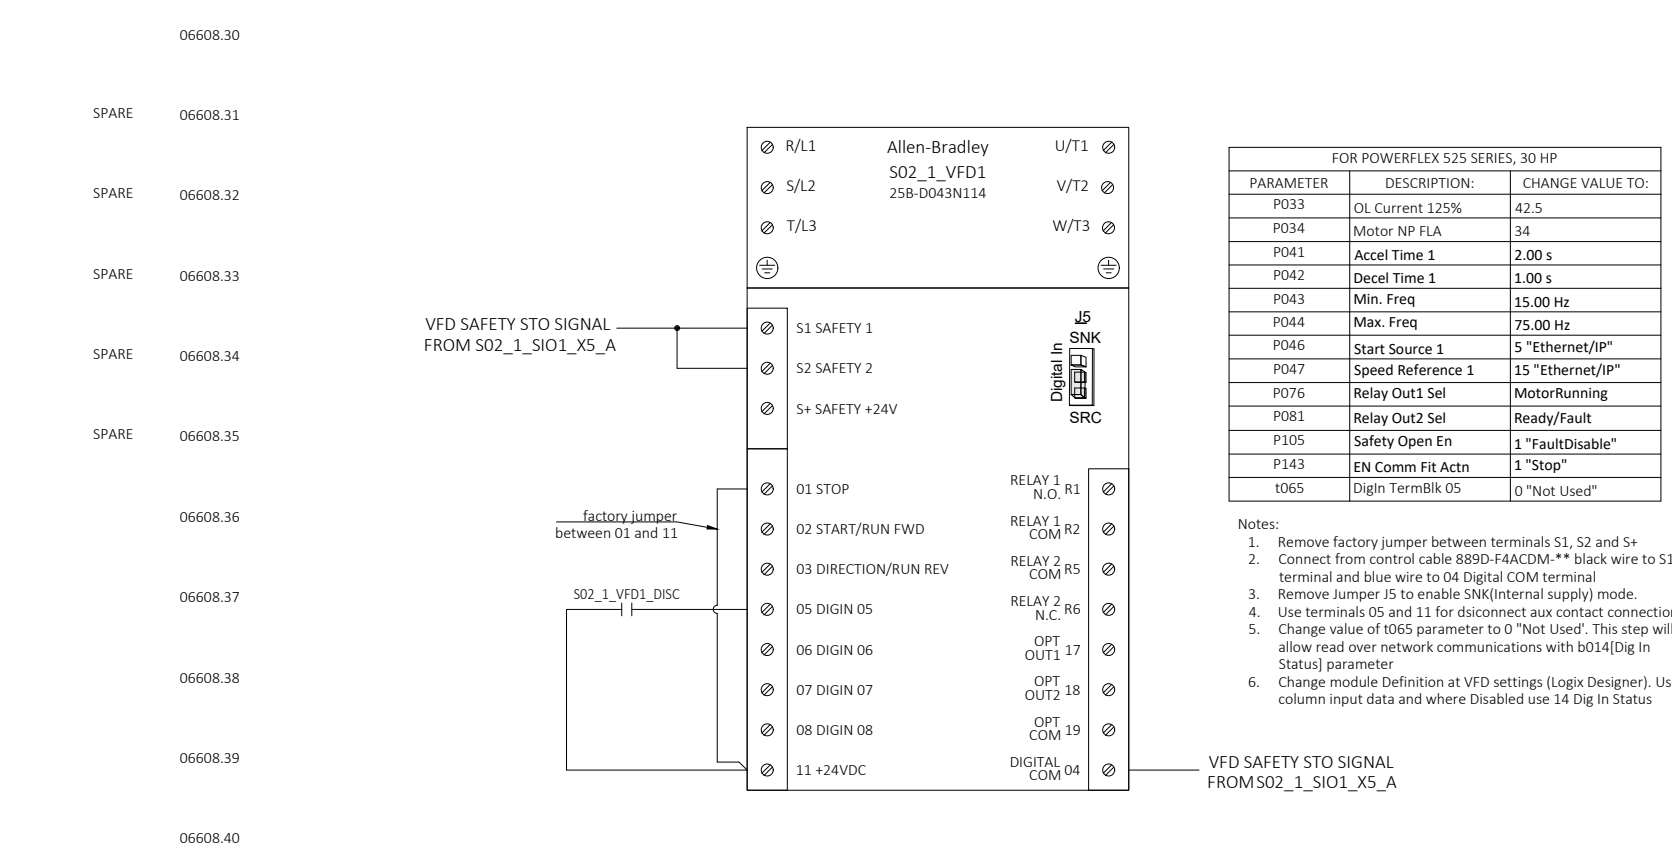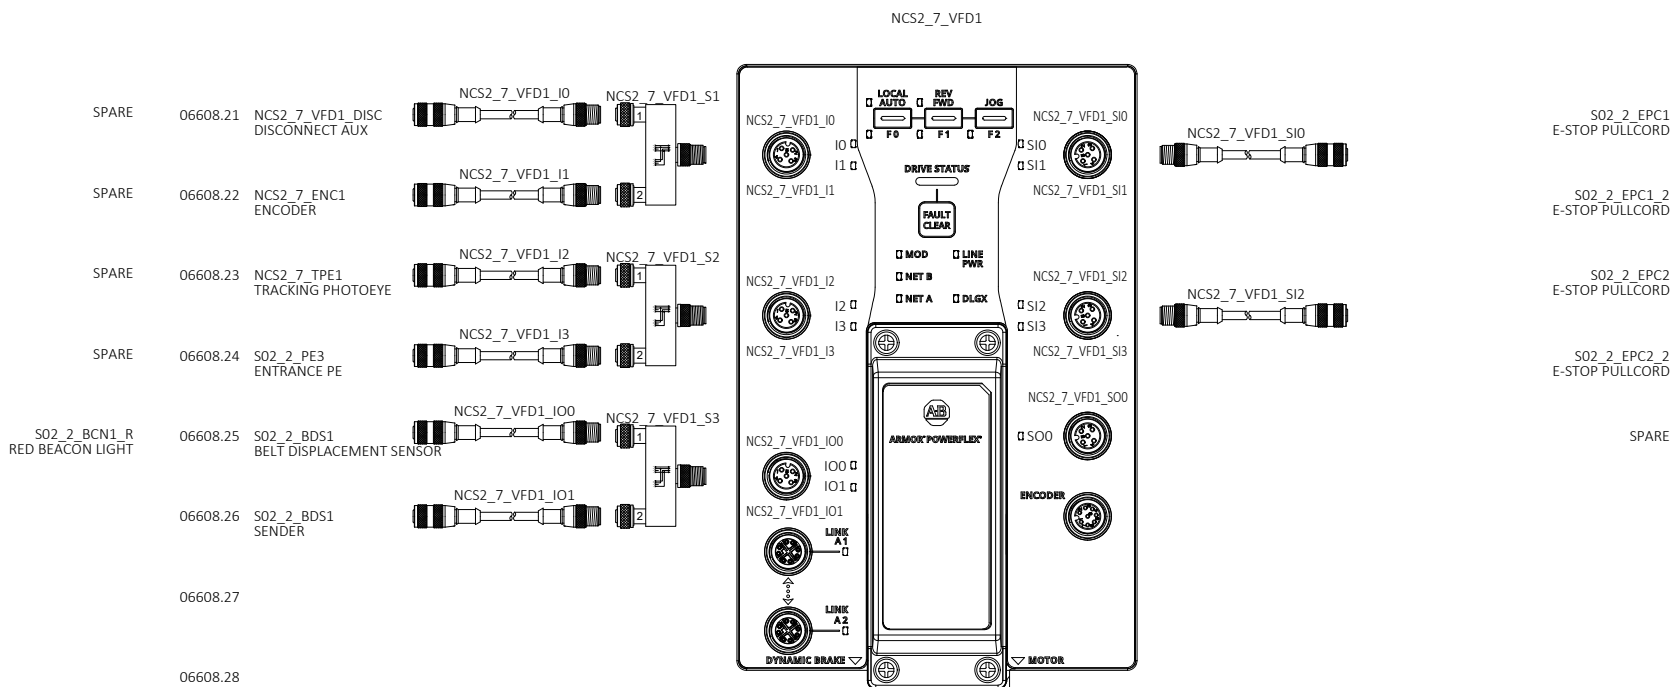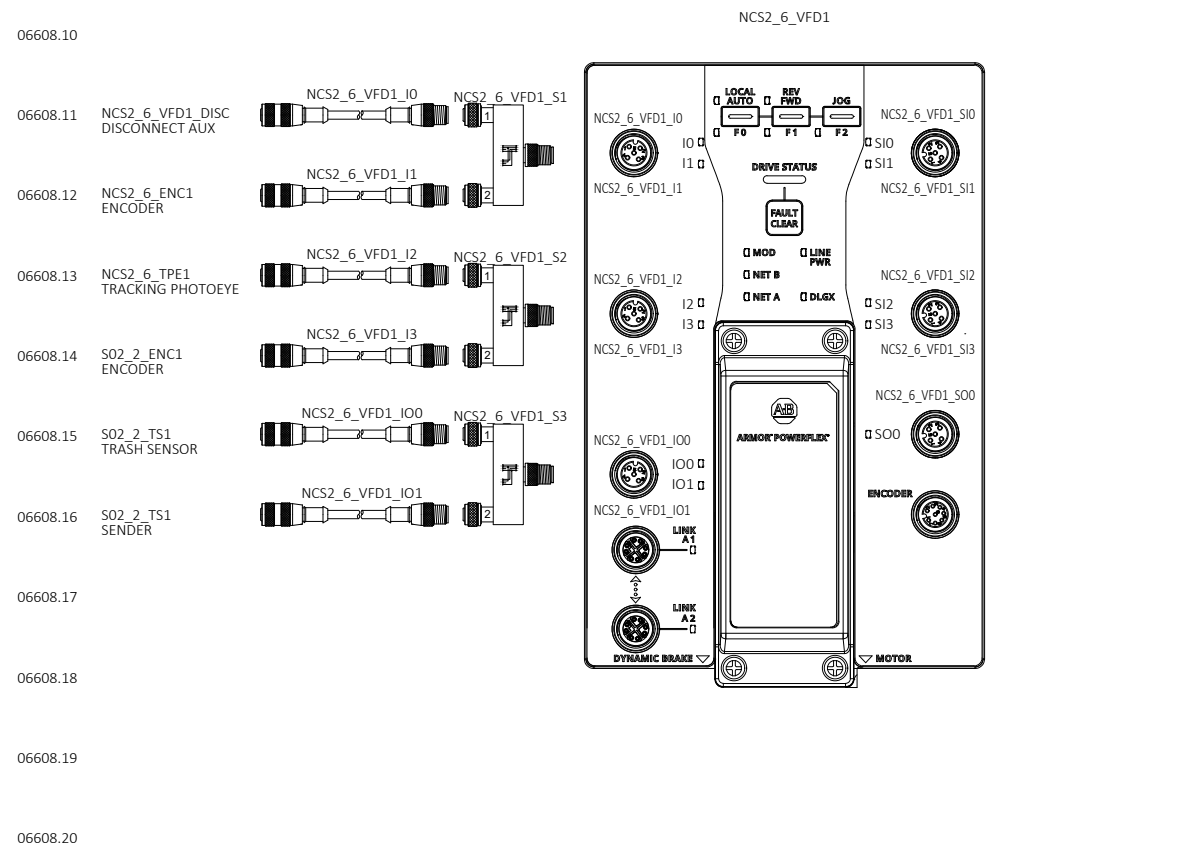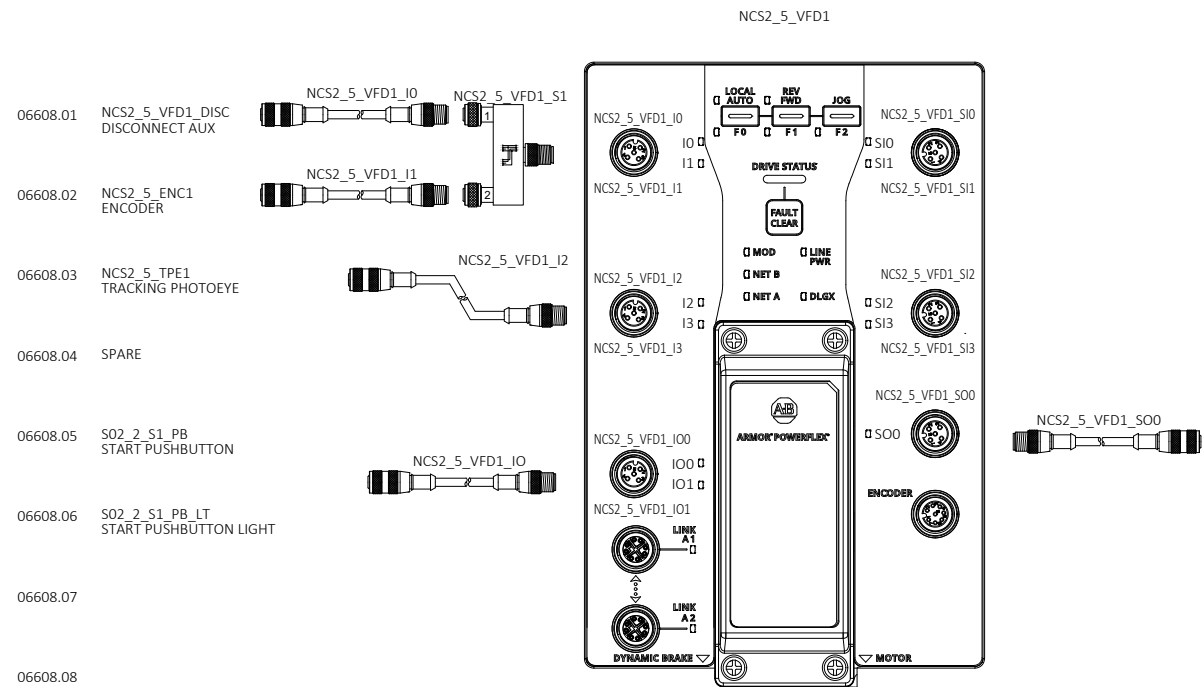

DRAWING REVISIONS				
REV	DESCRIPTION		DATE	BY
00	INITIAL DRAWINGS		04/25/2025	SK
A	AS-BUILT		11/13/2025	LB



autostand
Automation Standard




































CONFIDENTIAL: THE INFORMATION CONTAINED HEREIN IS PROPRIETARY INFORMATION OF AUTOMATION STANDARD LLC AND CONSTITUTES TRADE SECRETS PURSUANT TO THE UNIFORM TRADE SECRETS ACT. THIS INFORMATION SHALL ONLY BE USED IN THE PERFORMANCE OF CONTRACT WITH AUTOSTAND. THIS INFORMATION SHALL NOT BE USED, REPRODUCED OR EMPLOYED IN WHOLE PART EXCEPT WITH AUTOSTAND'S PRIOR WRITTEN APPROVAL.


25K Amazon Cross-Belt Sort Center (ACBSC)
NCS2_5_VFD1/NCS2_6_VFD1/
NCS2_7_VFD1/S02_1_VFD1 IO DRAWINGS

AMAZON MTN6
SPARROWS POINT, MD

















FILENAME	
2429-AMZ-MTN6-MCM06-608	
D-SIZE SCALE	JOB NUMBER:
NTS	2429
REVISION	SHEET
A	53

		S02_1_FIO9				S02_1_FIO11					
06610.01	S02_1_SOL1 DIVERT MODULE				S02_1_SOL5 DIVERT MODULE	06610.21	S02_1_SOL17 DIVERT MODULE				S02_1_SOL21 DIVERT MODULE
06610.02	SPARE				SPARE	06610.22	SPARE				SPARE
06610.03	S02_1_SOL2 DIVERT MODULE				S02_1_SOL6 DIVERT MODULE	06610.23	S02_1_SOL18 DIVERT MODULE				S02_1_SOL22 DIVERT MODULE
06610.04	SPARE				SPARE	06610.24	SPARE				SPARE
06610.05	S02_1_SOL3 DIVERT MODULE				S02_1_SOL7 DIVERT MODULE	06610.25	S02_1_SOL19 DIVERT MODULE				S02_1_SOL23 DIVERT MODULE
06610.06	SPARE				SPARE	06610.26	SPARE				SPARE
06610.07	S02_1_SOL4 DIVERT MODULE				S02_1_SOL8 DIVERT MODULE	06610.27	S02_1_SOL20 DIVERT MODULE				S02_1_SOL24 DIVERT MODULE
06610.08	SPARE				SPARE	06610.28	SPARE				SPARE
06610.09						06610.29					
06610.10						06610.30					
		S02_1_FIO10						S02_1_FIO12			
06610.11	S02_1_SOL9 DIVERT MODULE				S02_1_SOL13 DIVERT MODULE	06610.31	S02_1_SOL25 DIVERT MODULE				S02_1_SOL29 DIVERT MODULE
06610.12	SPARE				SPARE	06610.32	SPARE				SPARE
06610.13	S02_1_SOL10 DIVERT MODULE				S02_1_SOL14 DIVERT MODULE	06610.33	S02_1_SOL26 DIVERT MODULE				S02_1_SOL30 DIVERT MODULE
06610.14	SPARE				SPARE	06610.34	SPARE				SPARE
06610.15	S02_1_SOL11 DIVERT MODULE				S02_1_SOL15 DIVERT MODULE	06610.35	S02_1_SOL27 DIVERT MODULE				S02_1_SOL31 DIVERT MODULE
06610.16	SPARE				SPARE	06610.36	SPARE				SPARE
06610.17	S02_1_SOL12 DIVERT MODULE				S02_1_SOL16 DIVERT MODULE	06610.37	S02_1_SOL28 DIVERT MODULE				S02_1_SOL32 DIVERT MODULE
06610.18	SPARE				SPARE	06610.38	SPARE				SPARE
06610.19						06610.39					
06610.20						06610.40					
REV 00 INITIAL DRAWINGS 04/25/2025 SK REV A AS-BUILT 11/13/2025 LB autStand Automation Standard CONFIDENTIAL: THE INFORMATION CONTAINED HEREIN IS PROPRIETARY INFORMATION OF AUTOMATION STANDARD LLC AND CONSTITUTES TRADE SECRETS PURSUANT TO THE UNIFORM TRADE SECRETS ACT. THIS INFORMATION SHALL ONLY BE USED IN THE PERFORMANCE OF CONTRACT WITH AUTOSTAND. THIS INFORMATION SHALL NOT BE USED, REPRODUCED OR EMPLOYED IN WHOLE PART, EXCEPT WITH AUTOSTAND'S PRIOR WRITTEN APPROVAL. 25K Amazon Cross-Belt Sort Center (ACBSC) S02_1_FIO9/S02_1_FIO10/ S02_1_FIO11/S02_1_FIO12 IO DRAWINGS AMAZON MTN6 SPARROWS POINT, MD FILENAME 2429-AMZ-MTN6-MCM06-610 D-SIZE SCALE NTS JOB NUMBER: 2429 REVISION A SHEET 55 11/21/2025 4:43 PM											

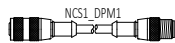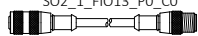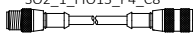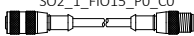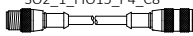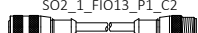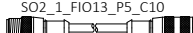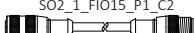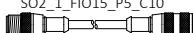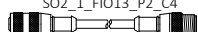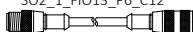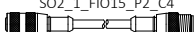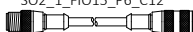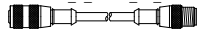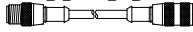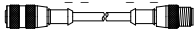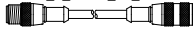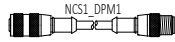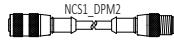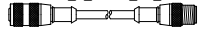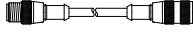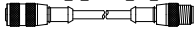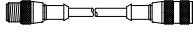            				SO2_1_FIO13								SO2_1_FIO15			
															
06611.01	SO2_1_SOL33	DIVERT MODULE													
06611.02	SPARE														
06611.03	SO2_1_SOL34	DIVERT MODULE													
06611.04	SPARE														
06611.05	SO2_1_SOL35	DIVERT MODULE													
06611.06	SPARE														
06611.07	SO2_1_SOL36	DIVERT MODULE													
06611.08	SPARE														
06611.09															
06611.10															
				SO2_1_FIO14								SO2_1_FIO16			
															
06611.11	SO2_1_SOL41	DIVERT MODULE													
06611.12	SPARE														
06611.13	SO2_1_SOL42	DIVERT MODULE													
06611.14	SPARE														
06611.15	SO2_1_SOL43	DIVERT MODULE													
06611.16	SPARE														
06611.17	SO2_1_SOL44	DIVERT MODULE													
06611.18	SPARE														
06611.19															
06611.20															

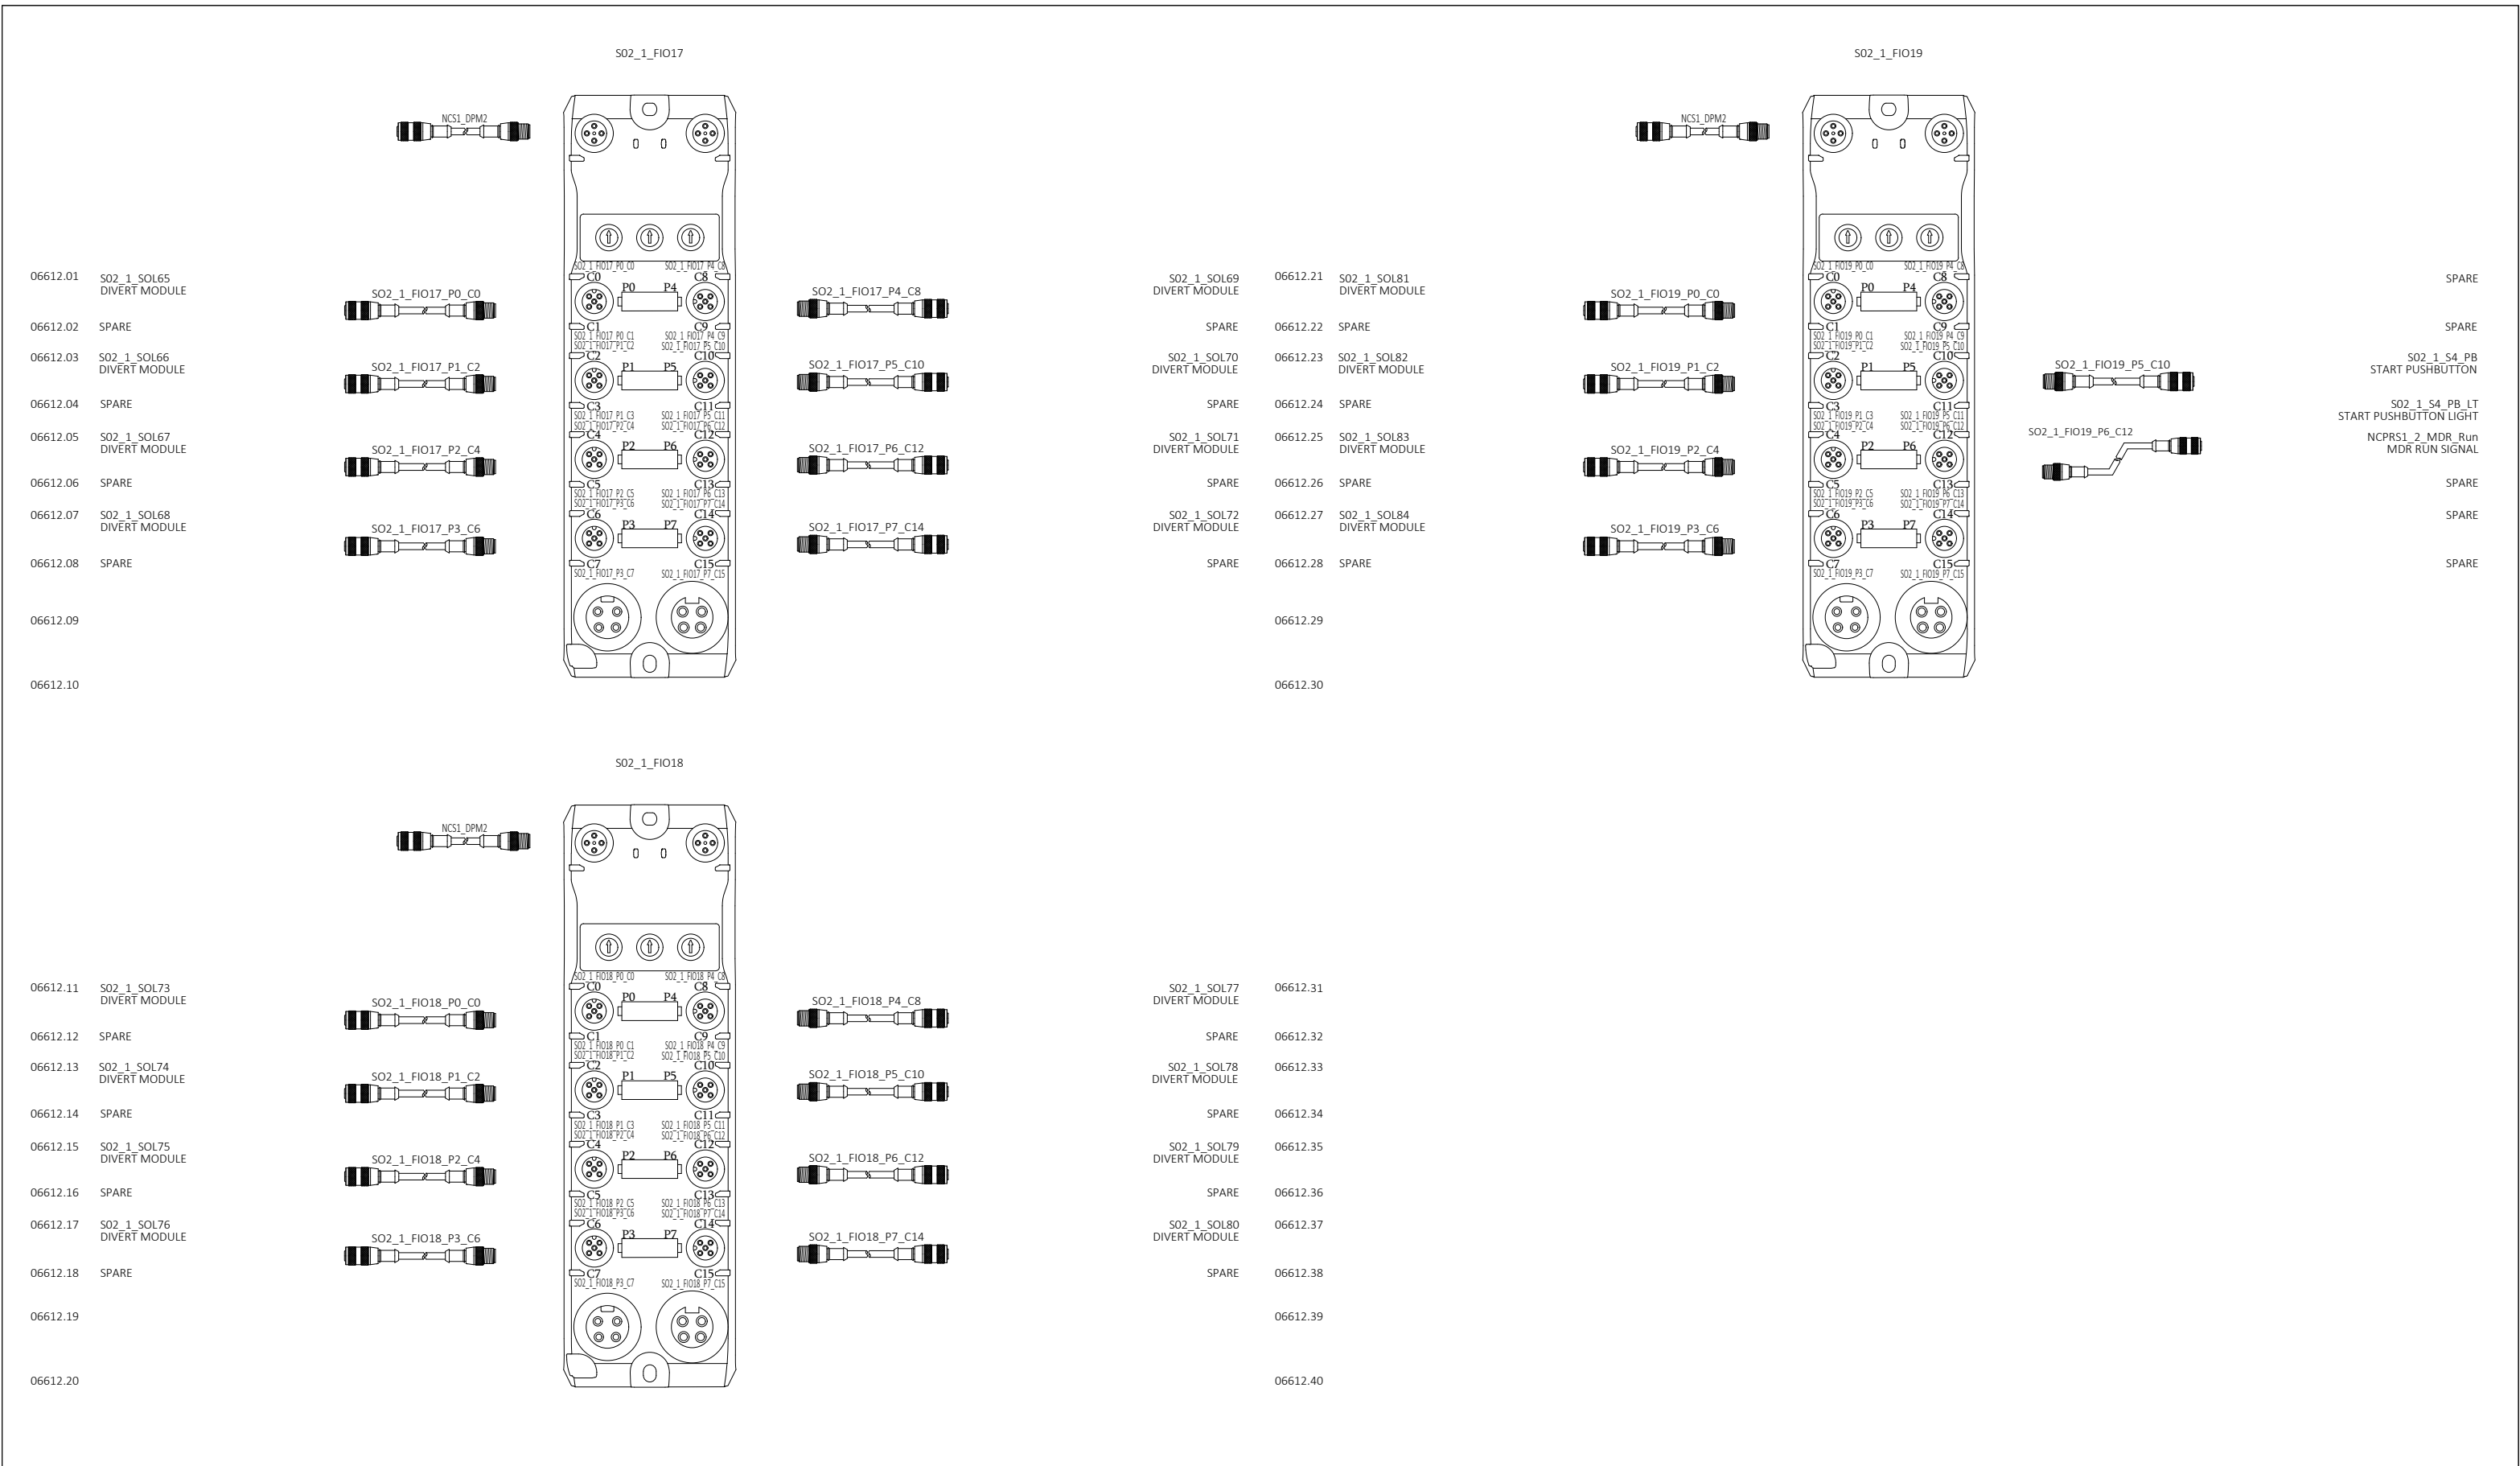

DRAWING REVISIONS				 25K Amazon Cross-Belt Sort Center (ACBSC) S02_1_FIO17/S02_1_FIO18 S02_1_FIO13 IO DRAWINGS AMAZON MTN6 SPARROWS POINT, MD CONFIDENTIAL: THE INFORMATION CONTAINED HEREIN IS PROPRIETARY INFORMATION OF AUTOMATION STANDARD LLC AND CONSTITUTES TRADE SECRETS PURSUANT TO THE UNIFORM TRADE SECRETS ACT. THIS INFORMATION SHALL ONLY BE USED IN THE PERFORMANCE OF CONTRACT WITH AUTOSTAND. THIS INFORMATION SHALL NOT BE USED, REPRODUCED OR EMPLOYED IN WHOLE PART, EXCEPT WITH AUTOSTAND'S PRIOR WRITTEN APPROVAL.	FILENAME 2429-AMZ-MTN6-MCM06-612	
REV	DESCRIPTION	DATE	BY		D-SIZE SCALE	JOB NUMBER
00	INITIAL DRAWINGS	04/25/2025	SK		NTS	2429
A	AS-BUILT	11/13/2025	LB			
					REVISION	SHEET
					A	57

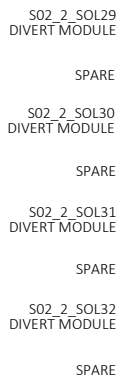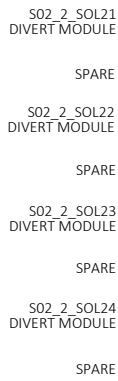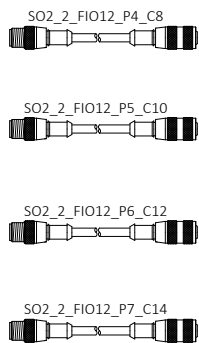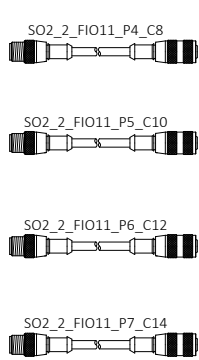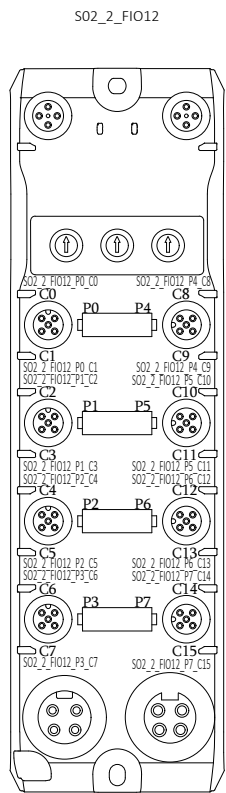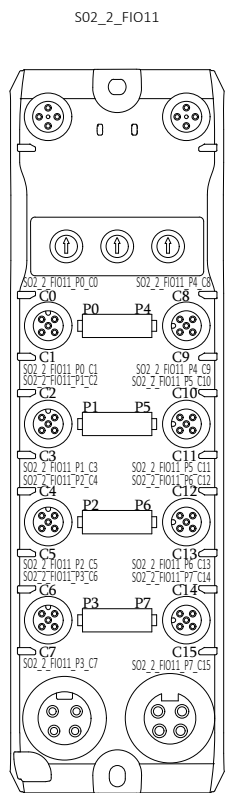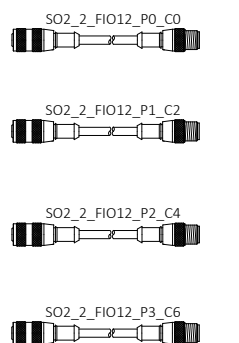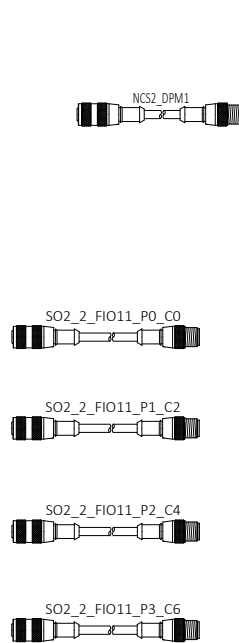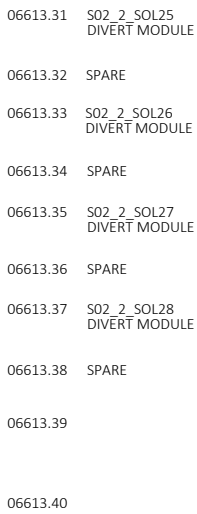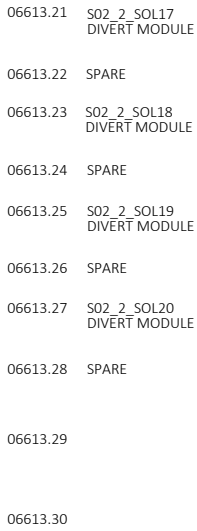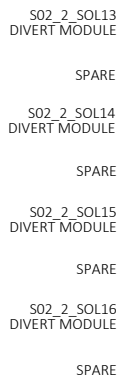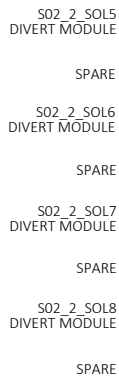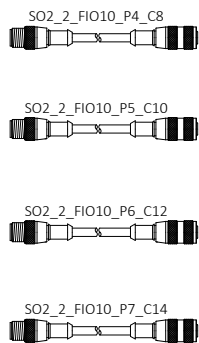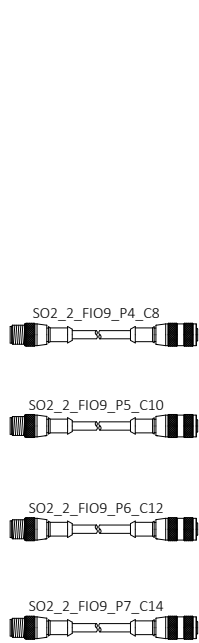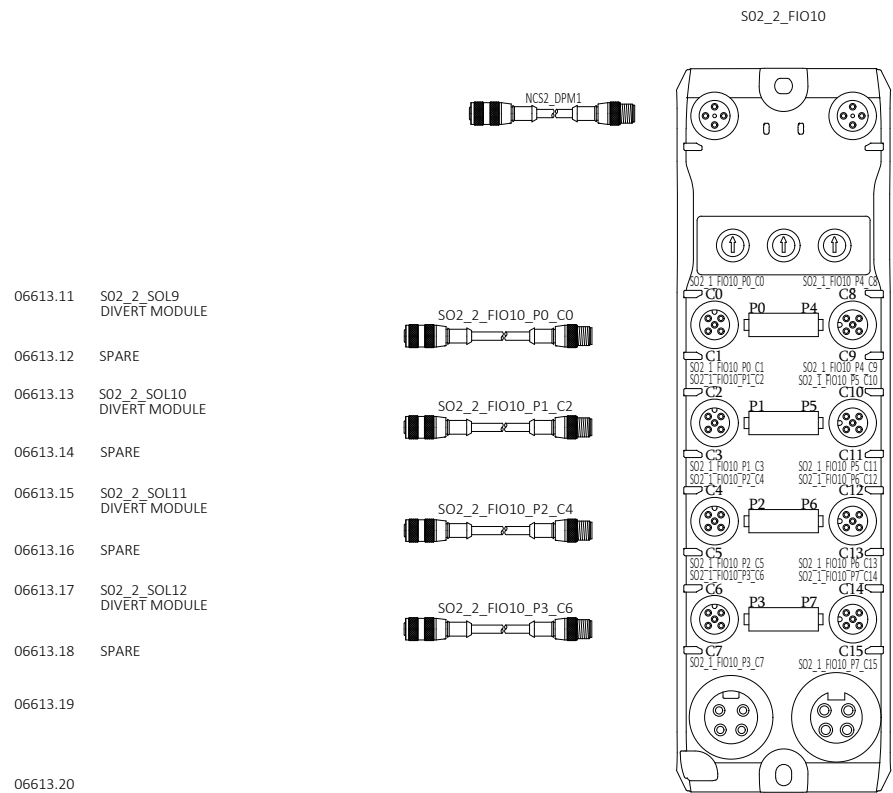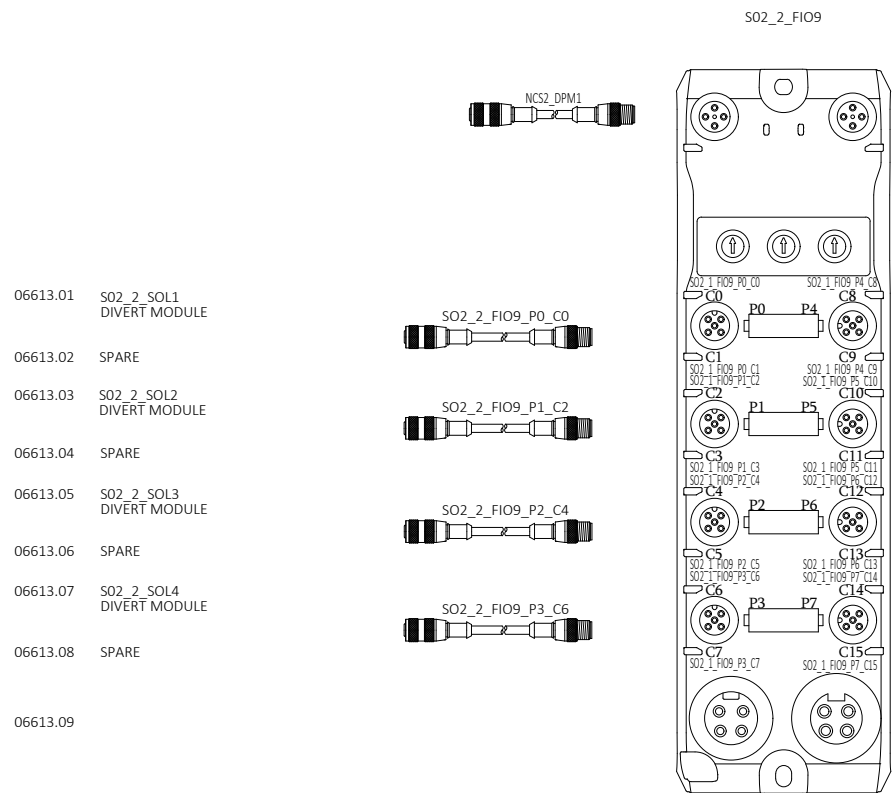

DRAWING REVISIONS				
REV	DESCRIPTION		DATE	BY
00	INITIAL DRAWINGS		04/25/2025	SK
A	AS-BUILT		11/13/2025	LB

autStand
Automation Standard

CONFIDENTIAL: THE INFORMATION CONTAINED HEREIN IS PROPRIETARY INFORMATION OF AUTOSTAND INFORMATION STANDARD LLC AND CONSTITUTES TRADE SECRETS PURSUANT TO THE UNIFORM TRADE SECRETS ACT. THIS INFORMATION SHALL ONLY BE USED IN THE PERFORMANCE OF CONTRACT WITH AUTOSTAND. THIS INFORMATION SHALL NOT BE USED, REPRODUCED OR EMPLOYED IN WHOLE PART, EXCEPT WITH AUTOSTAND'S PRIOR WRITTEN APPROVAL.

25K Amazon Cross-Belt Sort Center (ACBSC)
S02_2_FIO9/S02_2_FIO10/
S02_2_FIO11/S02_2_FIO12 IO DRAWINGS

AMAZON MTN6
SPARROWS POINT, MD

FILENAME	
2429-AMZ-MTN6-MCM06-613	
D-SIZE SCALE	JOB NUMBER:
NTS	2429
REVISION	SHEET
A	58


		S02_2_FIO13				S02_2_FIO15				
06614.01	S02_2_SOL33 DIVERT MODULE				S02_2_SOL37 DIVERT MODULE	06614.21	S02_2_SOL49 DIVERT MODULE			S02_2_SOL53 DIVERT MODULE
06614.02	SPARE				SPARE	06614.22	SPARE			SPARE
06614.03	S02_2_SOL34 DIVERT MODULE				S02_2_SOL38 DIVERT MODULE	06614.23	S02_2_SOL50 DIVERT MODULE			S02_2_SOL54 DIVERT MODULE
06614.04	SPARE				SPARE	06614.24	SPARE			SPARE
06614.05	S02_2_SOL35 DIVERT MODULE				S02_2_SOL39 DIVERT MODULE	06614.25	S02_2_SOL51 DIVERT MODULE			S02_2_SOL55 DIVERT MODULE
06614.06	SPARE				SPARE	06614.26	SPARE			SPARE
06614.07	S02_2_SOL36 DIVERT MODULE				S02_2_SOL40 DIVERT MODULE	06614.27	S02_2_SOL52 DIVERT MODULE			S02_2_SOL56 DIVERT MODULE
06614.08	SPARE				SPARE	06614.28	SPARE			SPARE
06614.09						06614.29				
06614.10						06614.30				
		S02_2_FIO14				S02_2_FIO16				
06614.11	S02_2_SOL41 DIVERT MODULE				S02_2_SOL45 DIVERT MODULE	06614.31	S02_2_SOL57 DIVERT MODULE			S02_2_SOL61 DIVERT MODULE
06614.12	SPARE				SPARE	06614.32	SPARE			SPARE
06614.13	S02_2_SOL42 DIVERT MODULE				S02_2_SOL46 DIVERT MODULE	06614.33	S02_2_SOL58 DIVERT MODULE			S02_2_SOL62 DIVERT MODULE
06614.14	SPARE				SPARE	06614.34	SPARE			SPARE
06614.15	S02_2_SOL43 DIVERT MODULE				S02_2_SOL47 DIVERT MODULE	06614.35	S02_2_SOL59 DIVERT MODULE			S02_2_SOL63 DIVERT MODULE
06614.16	SPARE				SPARE	06614.36	SPARE			SPARE
06614.17	S02_2_SOL44 DIVERT MODULE				S02_2_SOL48 DIVERT MODULE	06614.37	S02_2_SOL60 DIVERT MODULE			S02_2_SOL64 DIVERT MODULE
06614.18	SPARE				SPARE	06614.38	SPARE			SPARE
06614.19						06614.39				
06614.20						06614.40				

DRAWING REVISIONS			
REV	DESCRIPTION	DATE	BY
00	INITIAL DRAWINGS	04/25/2025	SK
A	AS-BUILT	11/13/2025	LB










































CONFIDENTIAL: THE INFORMATION CONTAINED HEREIN IS PROPRIETARY INFORMATION OF AUTOMATION STANDARD LLC AND CONSTITUTES TRADE SECRETS PURSUANT TO THE UNIFORM TRADE SECRETS ACT. THIS INFORMATION SHALL ONLY BE USED IN THE PERFORMANCE OF CONTRACT WITH AUTOSTAND. THIS INFORMATION SHALL NOT BE USED, REPRODUCED OR EMPLOYED IN WHOLE PART, EXCEPT WITH AUTOSTAND'S PRIOR WRITTEN APPROVAL.	


























25K Amazon Cross-Belt Sort Center (ACBSC)	
S02_2_FIO13/S02_2_FIO14/ S02_2_FIO15/S02_2_FIO16	
AMAZON MTN6 SPARROWS POINT, MD	





FILENAME 2429-AMZ-MTN6-MCM06-614	
D-SIZE SCALE NTS	JOB NUMBER: 2429
REVISION A	SHEET 59






























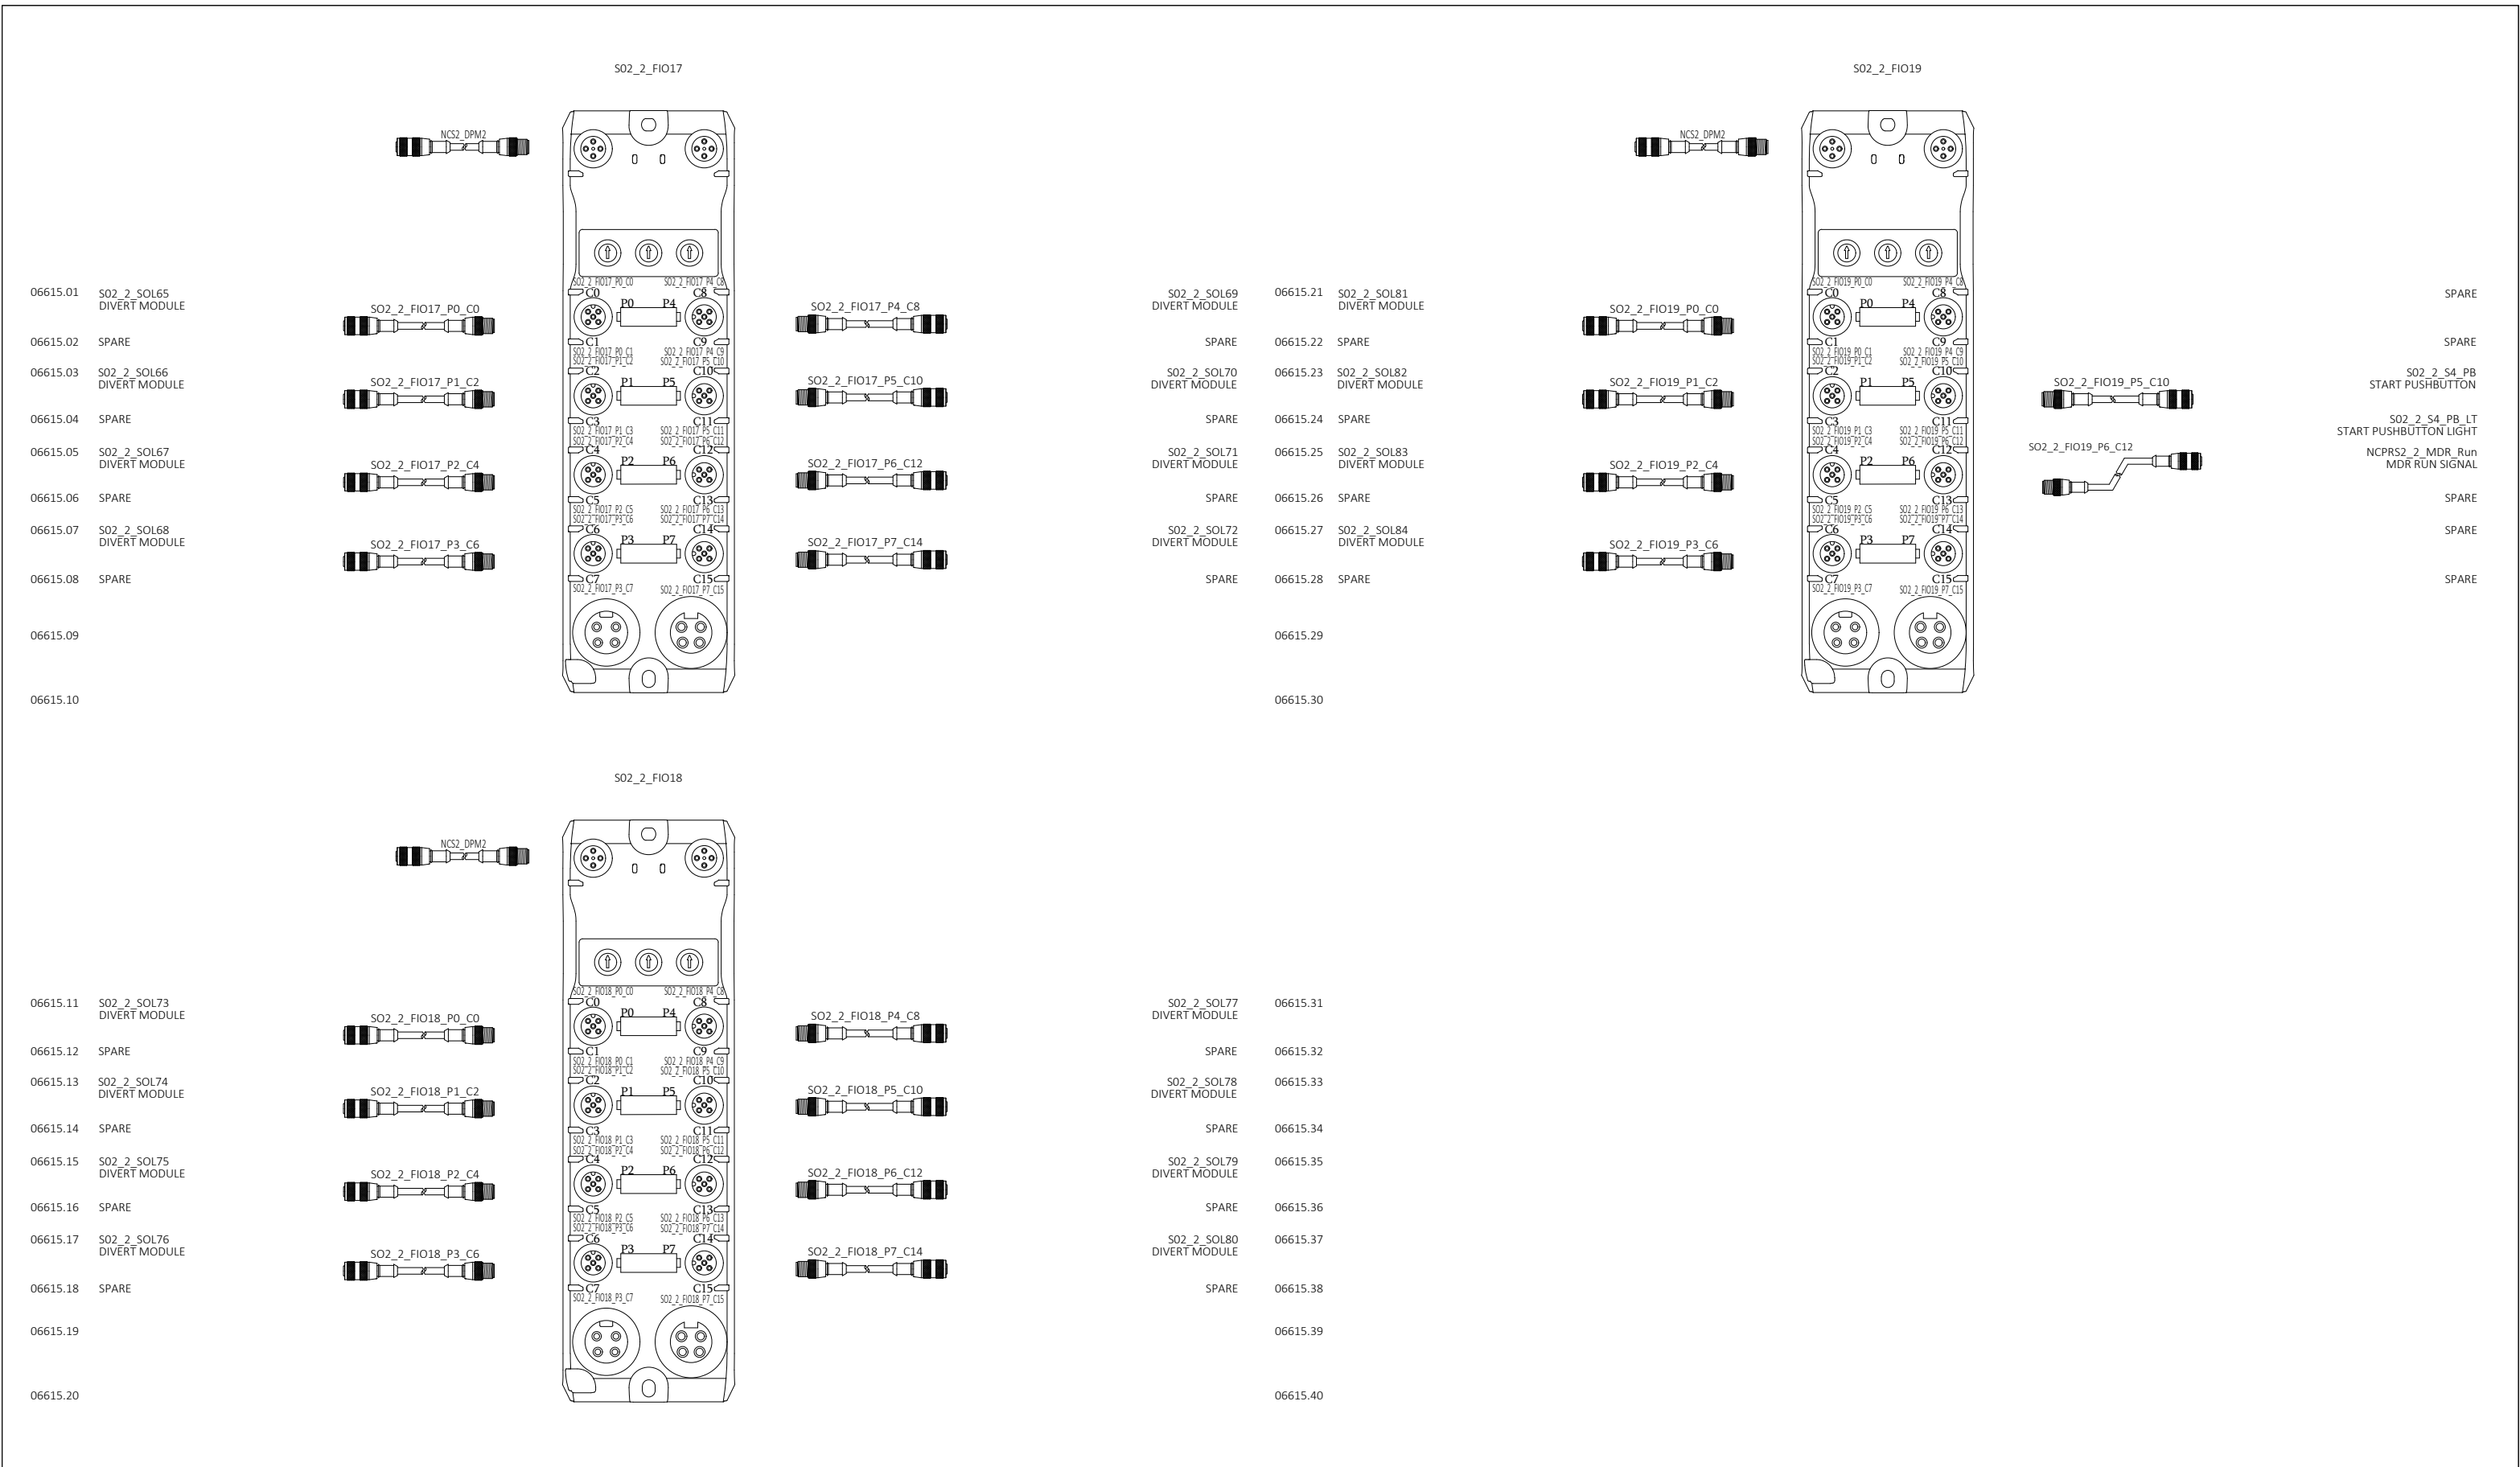
















DRAWING REVISIONS				 25K Amazon Cross-Belt Sort Center (ACBSC) S02_2_FIO17/S02_2_FIO18 S02_2_FIO19 IO DRAWINGS AMAZON MTN6 SPARROWS POINT, MD CONFIDENTIAL: THE INFORMATION CONTAINED HEREIN IS PROPRIETARY INFORMATION OF AUTOMATION STANDARD LLC AND CONSTITUTES TRADE SECRETS PURSUANT TO THE UNIFORM TRADE SECRETS ACT. THIS INFORMATION SHALL ONLY BE USED IN THE PERFORMANCE OF CONTRACT WITH AUTOSTAND. THIS INFORMATION SHALL NOT BE USED, REPRODUCED OR EMPLOYED IN WHOLE PART, EXCEPT WITH AUTOSTAND'S PRIOR WRITTEN APPROVAL.	FILENAME 2429-AMZ-MTN6-MCM06-615	
REV	DESCRIPTION	DATE	BY		D-SIZE SCALE	JOB NUMBER
00	INITIAL DRAWINGS	04/25/2025	SK		NTS	2429
A	AS-BUILT	11/13/2025	LB			
					REVISION	SHEET
					A	60

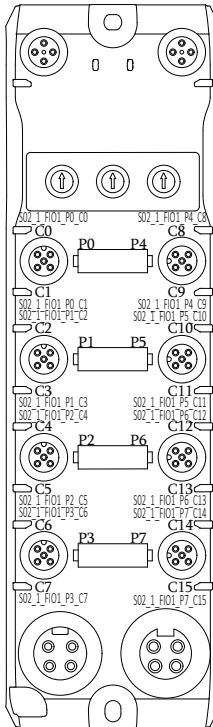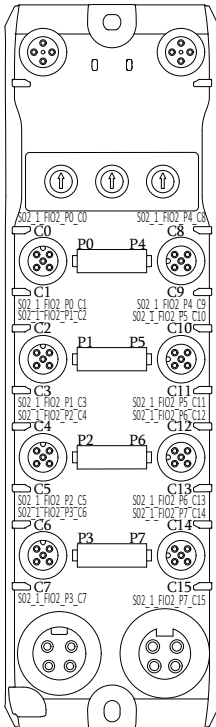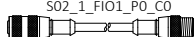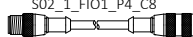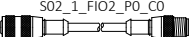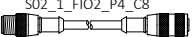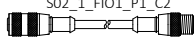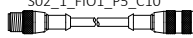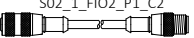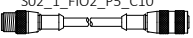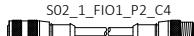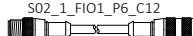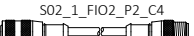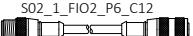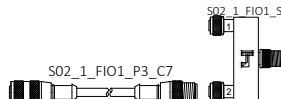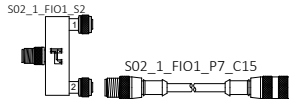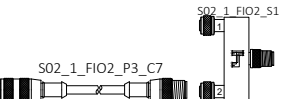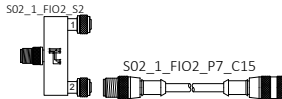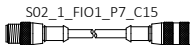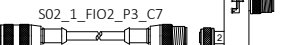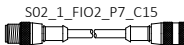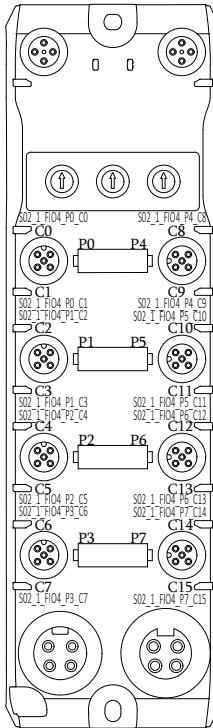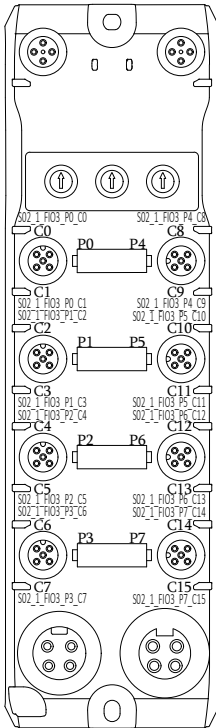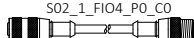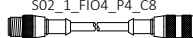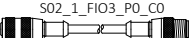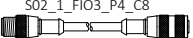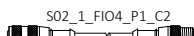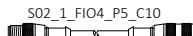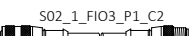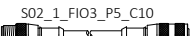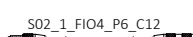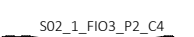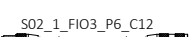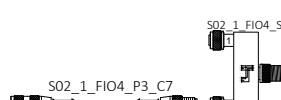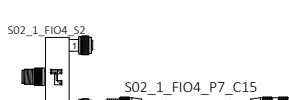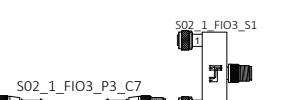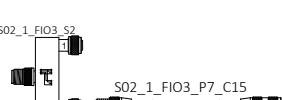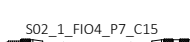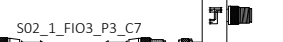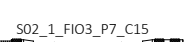				S02_1_FIO1								S02_1_FIO2											
																							
06617.01	S02_101CH_BCN1_G GREEN BEACON LIGHT					S02_105CH_BCN1_G GREEN BEACON LIGHT		06617.21	S02_108CH_BCN1_G GREEN BEACON LIGHT					S02_104CH_BCN1_G GREEN BEACON LIGHT									
06617.02	S02_101CH_BCN1_B BLUE BEACON LIGHT					S02_105CH_BCN1_B BLUE BEACON LIGHT		06617.22	S02_108CH_BCN1_B BLUE BEACON LIGHT					S02_104CH_BCN1_B BLUE BEACON LIGHT									
06617.03	S02_103CH_BCN1_G GREEN BEACON LIGHT					S02_107CH_BCN1_G GREEN BEACON LIGHT		06617.23	S02_106CH_BCN1_G GREEN BEACON LIGHT					S02_102CH_BCN1_G GREEN BEACON LIGHT									
06617.04	S02_103CH_BCN1_B BLUE BEACON LIGHT					S02_107CH_BCN1_B BLUE BEACON LIGHT		06617.24	S02_106CH_BCN1_B BLUE BEACON LIGHT					S02_102CH_BCN1_B BLUE BEACON LIGHT									
06617.05	S02_1_FIO1H1 HUB ARMOR BLOCK					S02_1_FIO1H2 HUB ARMOR BLOCK		06617.25	S02_1_FIO2H2 HUB ARMOR BLOCK					S02_1_FIO2H1 HUB ARMOR BLOCK									
06617.06	SPARE					SPARE		06617.26	SPARE					SPARE									
06617.07	SPARE					SPARE		06617.27	SPARE					SPARE									
06617.08	S02_101CH_BCN1_A AMBER BEACON LIGHT					S02_107CH_BCN1_A AMBER BEACON LIGHT		06617.28	S02_108CH_BCN1_A AMBER BEACON LIGHT					S02_102CH_BCN1_A AMBER BEACON LIGHT									
06617.09								06617.29															
06617.10								06617.30															
				S02_1_FIO4								S02_1_FIO3											
																							
06617.11	S02_116CH_BCN1_G GREEN BEACON LIGHT					S02_112CH_BCN1_G GREEN BEACON LIGHT		06617.31	S02_109CH_BCN1_G GREEN BEACON LIGHT					S02_113CH_BCN1_G GREEN BEACON LIGHT									
06617.12	S02_116CH_BCN1_B BLUE BEACON LIGHT					S02_112CH_BCN1_B BLUE BEACON LIGHT		06617.32	S02_109CH_BCN1_B BLUE BEACON LIGHT					S02_113CH_BCN1_B BLUE BEACON LIGHT									
06617.13	S02_114CH_BCN1_G GREEN BEACON LIGHT					S02_110CH_BCN1_G GREEN BEACON LIGHT		06617.33	S02_111CH_BCN1_G GREEN BEACON LIGHT					S02_115CH_BCN1_G GREEN BEACON LIGHT									
06617.14	S02_114CH_BCN1_B BLUE BEACON LIGHT					S02_110CH_BCN1_B BLUE BEACON LIGHT		06617.34	S02_111CH_BCN1_B BLUE BEACON LIGHT					S02_115CH_BCN1_B BLUE BEACON LIGHT									
06617.15	S02_1_FIO4H2 HUB ARMOR BLOCK					S02_1_FIO4H1 HUB ARMOR BLOCK		06617.35	S02_1_FIO3H1 HUB ARMOR BLOCK					S02_1_FIO3H2 HUB ARMOR BLOCK									
06617.16	SPARE					SPARE		06617.36	SPARE					SPARE									
06617.17	SPARE					SPARE		06617.37	SPARE					SPARE									
06617.18	S02_116CH_BCN1_A AMBER BEACON LIGHT					S02_112CH_BCN1_A AMBER BEACON LIGHT		06617.38	S02_111CH_BCN1_A AMBER BEACON LIGHT					S02_115CH_BCN1_A AMBER BEACON LIGHT									
06617.19								06617.39															
06617.20								06617.40															
				S02_1_FIO1/S02_1_FIO2 S02_1_FIO3/S02_1_FIO4 IO DRAWINGS																			
												25K Amazon Cross-Belt Sort Center (ACBSC)											
								CONFIDENTIAL: THE INFORMATION CONTAINED HEREIN IS PROPRIETARY INFORMATION OF AUTOMATION STANDARD LLC AND CONSTITUTES TRADE SECRETS PURSUANT TO THE UNIFORM TRADE SECRETS ACT. THIS INFORMATION SHALL ONLY BE USED IN THE PERFORMANCE OF CONTRACT WITH AUTSTAND. THIS INFORMATION SHALL NOT BE USED, REPRODUCED OR EMPLOYED IN WHOLE PART, EXCEPT WITH AUTSTAND'S PRIOR WRITTEN APPROVAL.				AMAZON MTN6 SPARROWS POINT, MD											
								FILENAME 2429-AMZ-MTN6-MCM06-617				D-SIZE SCALE NTS											
								JOB NUMBER 2429				REVISION A											
								SHEET 62															

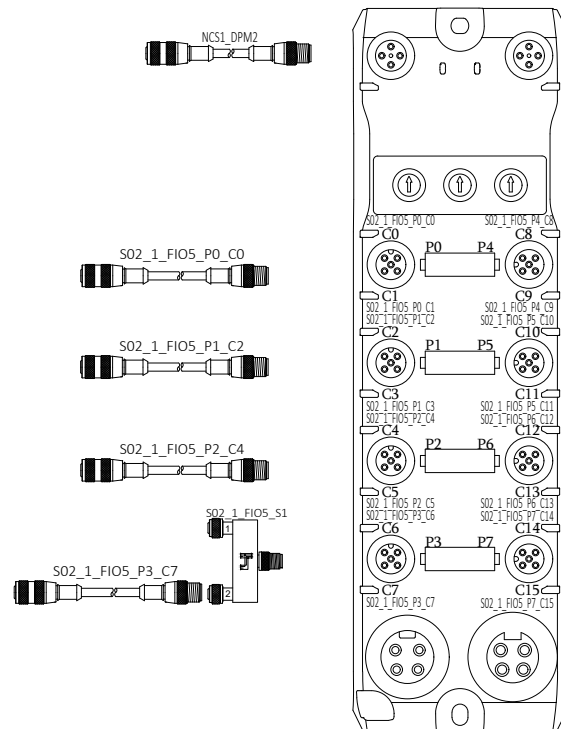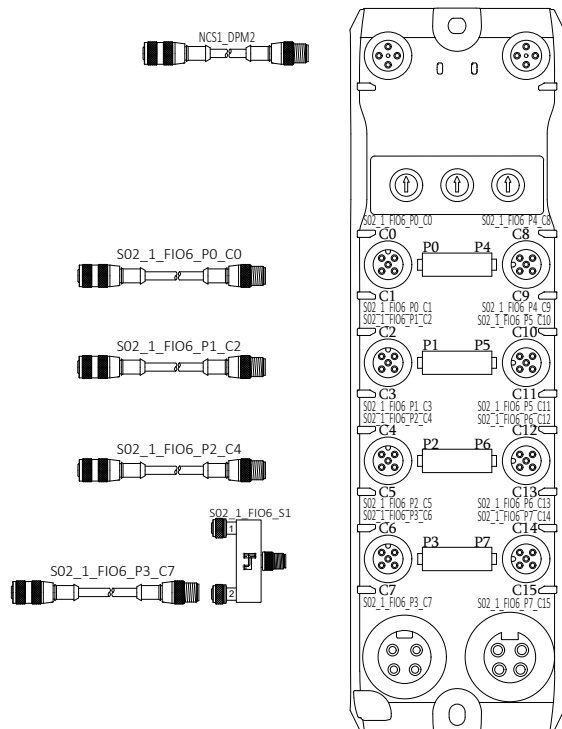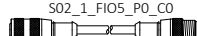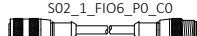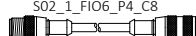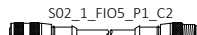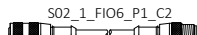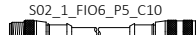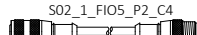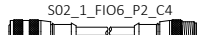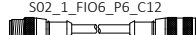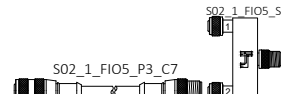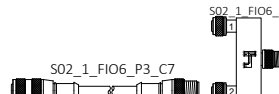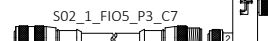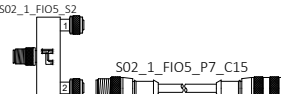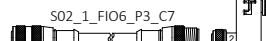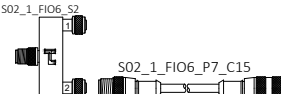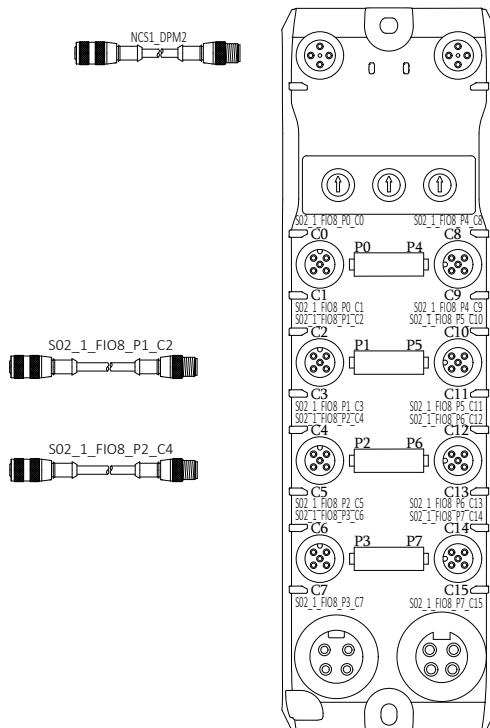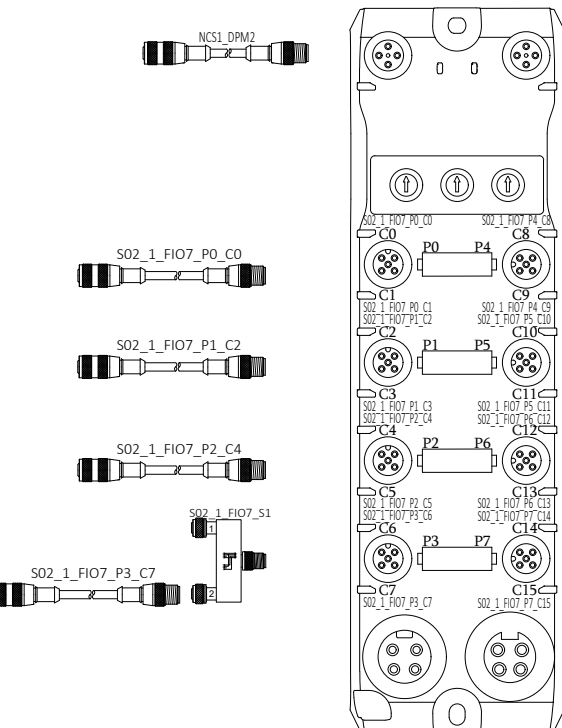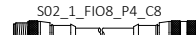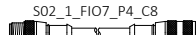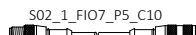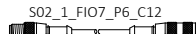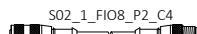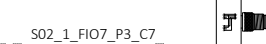				S02_1_FIO5								S02_1_FIO6											
																							
06618.01	S02_117CH_BCN1_G GREEN BEACON LIGHT																						
06618.02	S02_117CH_BCN1_B BLUE BEACON LIGHT															S02_120CH_BCN1_G GREEN BEACON LIGHT							
06618.03	S02_119CH_BCN1_G GREEN BEACON LIGHT															S02_120CH_BCN1_B BLUE BEACON LIGHT							
06618.04	S02_119CH_BCN1_B BLUE BEACON LIGHT															S02_118CH_BCN1_G GREEN BEACON LIGHT							
06618.05	S02_1_FIO5H1 HUB ARMOR BLOCK															S02_118CH_BCN1_B BLUE BEACON LIGHT							
06618.06	SPARE															S02_1_FIO6H1 HUB ARMOR BLOCK							
06618.07	SPARE															SPARE							
06618.08	S02_117CH_BCN1_A AMBER BEACON LIGHT																						
06618.09																S02_118CH_BCN1_A AMBER BEACON LIGHT							
06618.10								S02_1_FIO8								S02_1_FIO7							
																							
																S02_129CH_BCN1_G GREEN BEACON LIGHT							
06618.11	SPARE															S02_129CH_BCN1_B BLUE BEACON LIGHT							
06618.12	SPARE															SPARE							
06618.13	S02_130CH_BCN1_G GREEN BEACON LIGHT															SPARE							
06618.14	S02_130CH_BCN1_B BLUE BEACON LIGHT															SPARE							
06618.15	S02_1_FIO8H2 HUB ARMOR BLOCK															S02_1_FIO7H2 HUB ARMOR BLOCK							
06618.16	SPARE															SPARE							
06618.17	SPARE															SPARE							
06618.18	SPARE															SPARE							
06618.19																							
06618.20																							

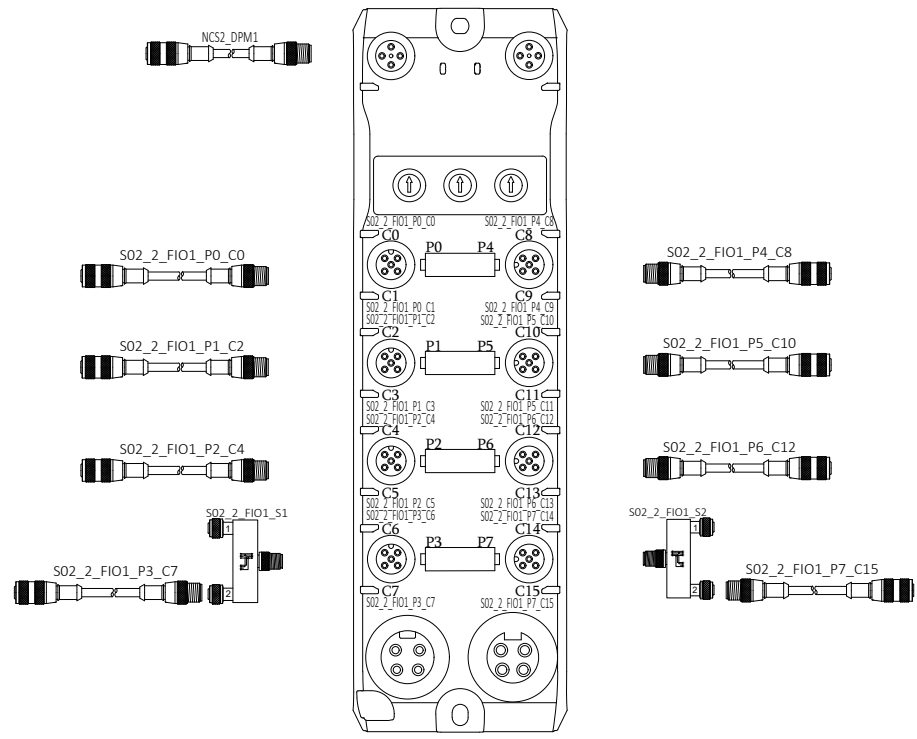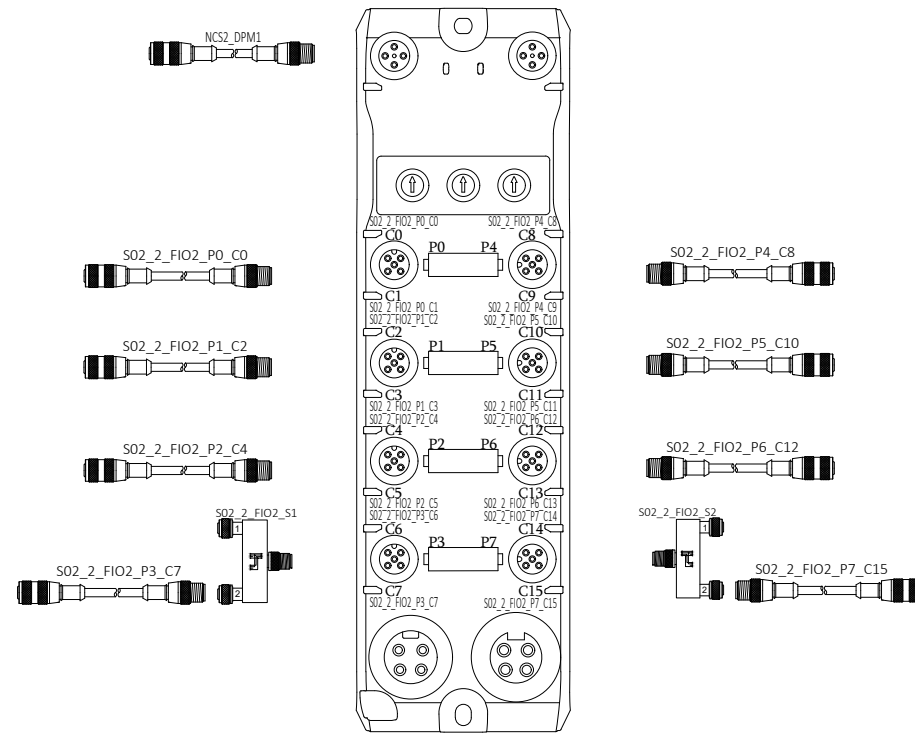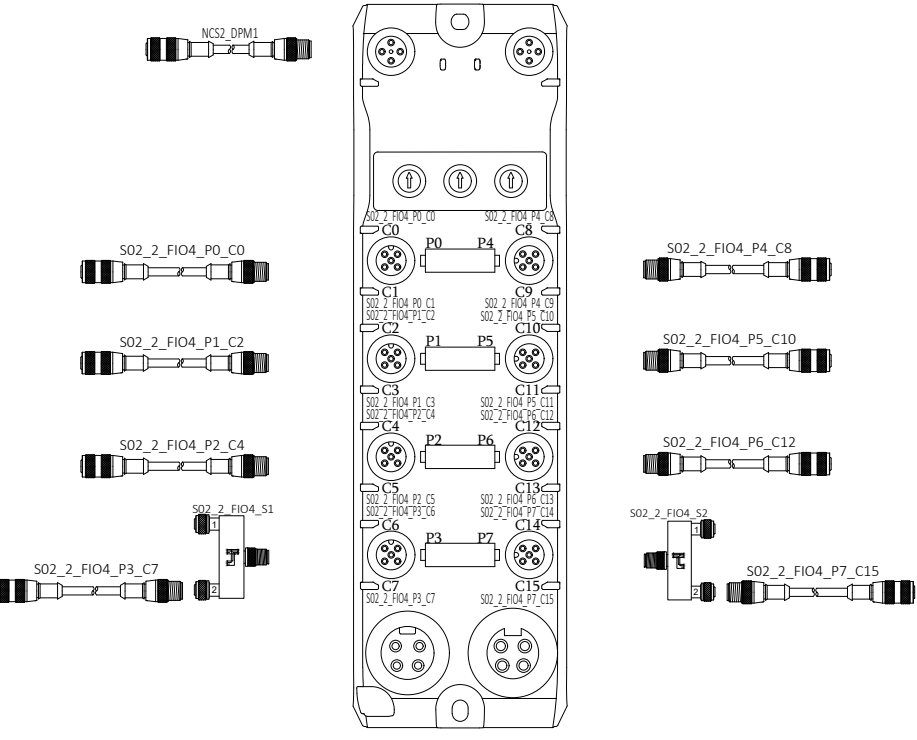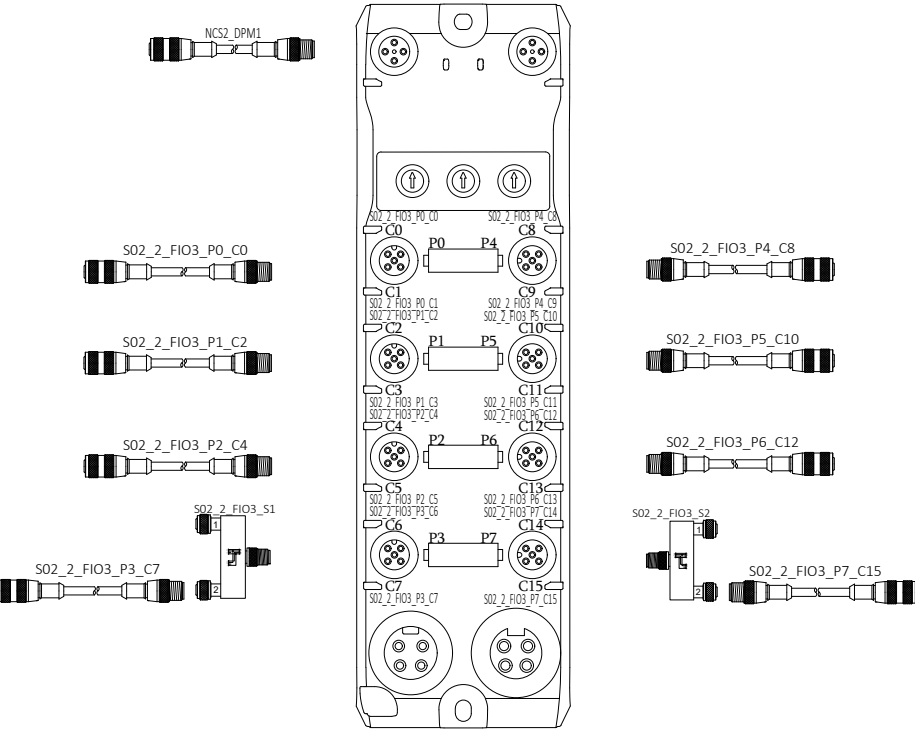				S02_2_FIO1								S02_2_FIO2							
																			
06601.01	S02_201CH_BCN1_G	GREEN BEACON LIGHT																	
06601.02	S02_201CH_BCN1_B	BLUE BEACON LIGHT																	
06601.03	S02_203CH_BCN1_G	GREEN BEACON LIGHT																	
06601.04	S02_203CH_BCN1_B	BLUE BEACON LIGHT																	
06601.05	S02_2_FIO1H1	HUB ARMOR BLOCK																	
06601.06	SPARE																		
06601.07	SPARE																		
06601.08	S02_201CH_BCN1_A	AMBER BEACON LIGHT																	
06601.09																			
06601.10																			
				S02_2_FIO4								S02_2_FIO3							
																			
06601.11	S02_216CH_BCN1_G	GREEN BEACON LIGHT																	
06601.12	S02_216CH_BCN1_B	BLUE BEACON LIGHT																	
06601.13	S02_214CH_BCN1_G	GREEN BEACON LIGHT																	
06601.14	S02_214CH_BCN1_B	BLUE BEACON LIGHT																	
06601.15	S02_2_FIO4H2	HUB ARMOR BLOCK																	
06601.16	SPARE																		
06601.17	SPARE																		
06601.18	S02_216CH_BCN1_A	AMBER BEACON LIGHT																	
06601.19																			
06601.20																			
06601.21	S02_208CH_BCN1_G	GREEN BEACON LIGHT																	
06601.22	S02_208CH_BCN1_B	BLUE BEACON LIGHT																	
06601.23	S02_207CH_BCN1_G	GREEN BEACON LIGHT																	
06601.24	S02_207CH_BCN1_B	BLUE BEACON LIGHT																	
06601.25	S02_2_FIO1H2	HUB ARMOR BLOCK																	
06601.26	SPARE																		
06601.27	SPARE																		
06601.28	S02_207CH_BCN1_A	AMBER BEACON LIGHT																	
06601.29																			
06601.30																			
06601.31	S02_208CH_BCN1_G	GREEN BEACON LIGHT																	
06601.32	S02_208CH_BCN1_B	BLUE BEACON LIGHT																	
06601.33	S02_206CH_BCN1_G	GREEN BEACON LIGHT																	
06601.34	S02_206CH_BCN1_B	BLUE BEACON LIGHT																	
06601.35	S02_2_FIO2H1	HUB ARMOR BLOCK																	
06601.36	SPARE																		
06601.37	SPARE																		
06601.38	S02_208CH_BCN1_A	AMBER BEACON LIGHT																	
06601.39																			
06601.40																			

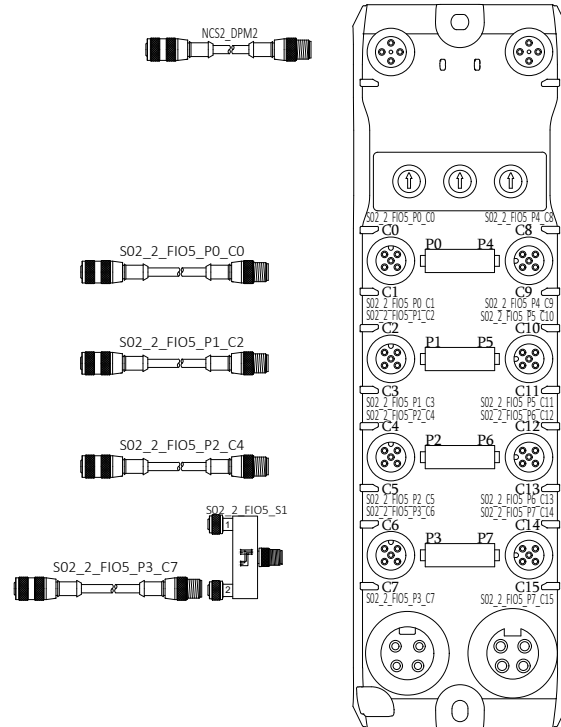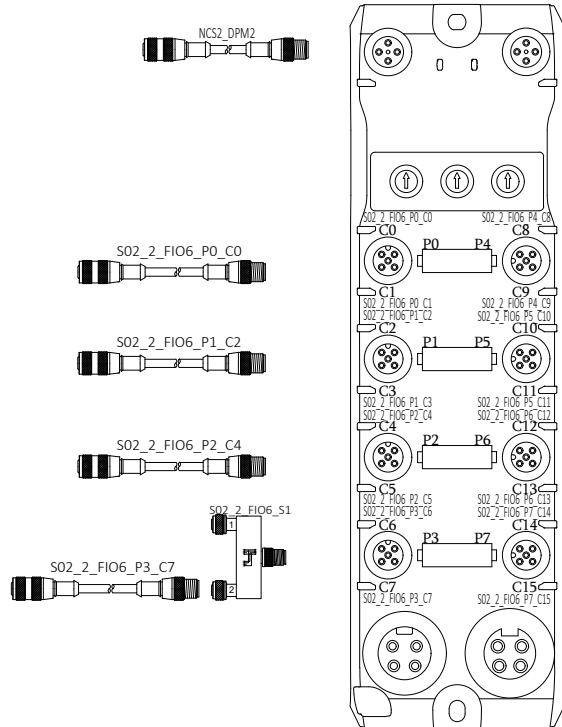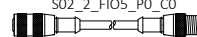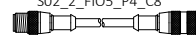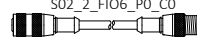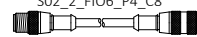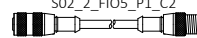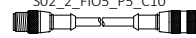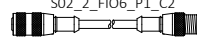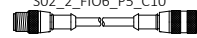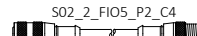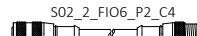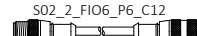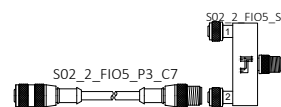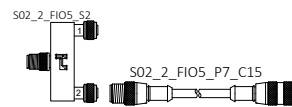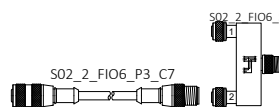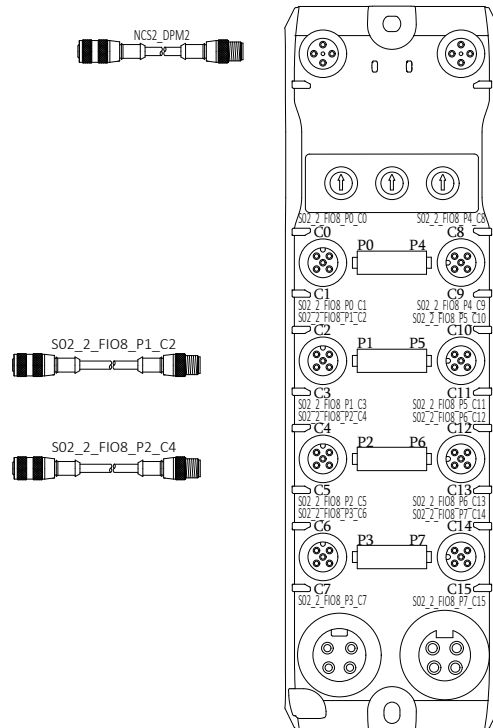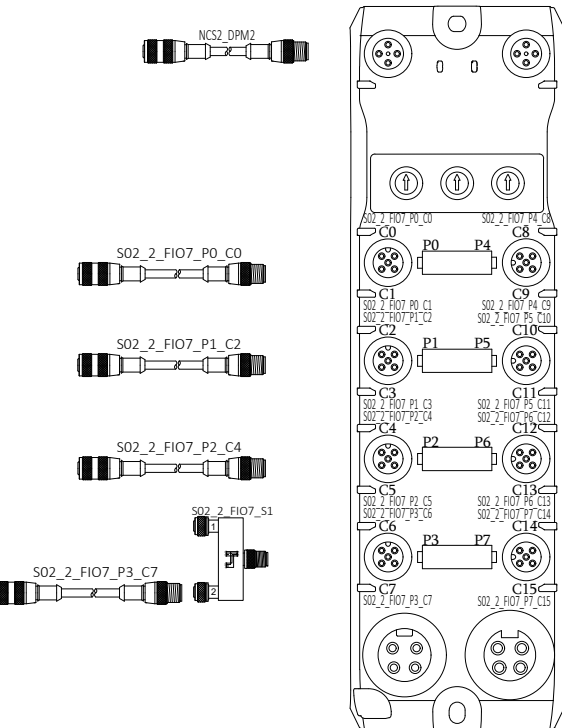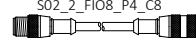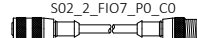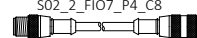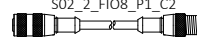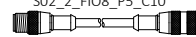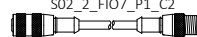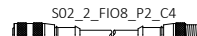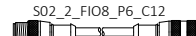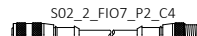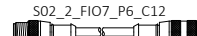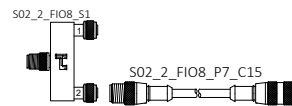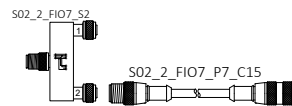				S02_2_FIO5								S02_2_FIO6			
															
06620.01	S02_217CH_BCN1_G	GREEN BEACON LIGHT													
06620.02	S02_217CH_BCN1_B	BLUE BEACON LIGHT													
06620.03	S02_219CH_BCN1_G	GREEN BEACON LIGHT													
06620.04	S02_219CH_BCN1_B	BLUE BEACON LIGHT													
06620.05	S02_2_FIO5H1	HUB ARMOR BLOCK													
06620.06	SPARE														
06620.07	SPARE														
06620.08	S02_217CH_BCN1_A	AMBER BEACON LIGHT													
06620.09															
06620.10															
				S02_2_FIO8								S02_2_FIO7			
															
06620.11	SPARE														
06620.12	SPARE														
06620.13	S02_230CH_BCN1_G	GREEN BEACON LIGHT													
06620.14	S02_230CH_BCN1_B	BLUE BEACON LIGHT													
06620.15	S02_2_FIO8H2	HUB ARMOR BLOCK													
06620.16	SPARE														
06620.17	SPARE														
06620.18	SPARE														
06620.19															
06620.20															

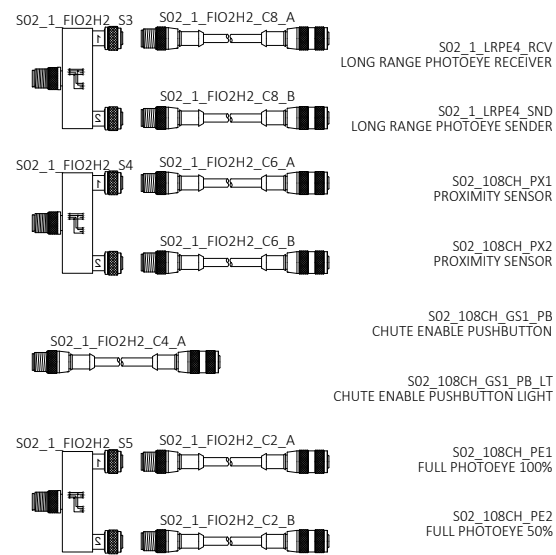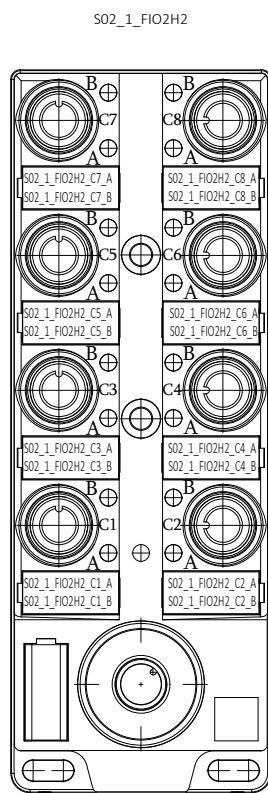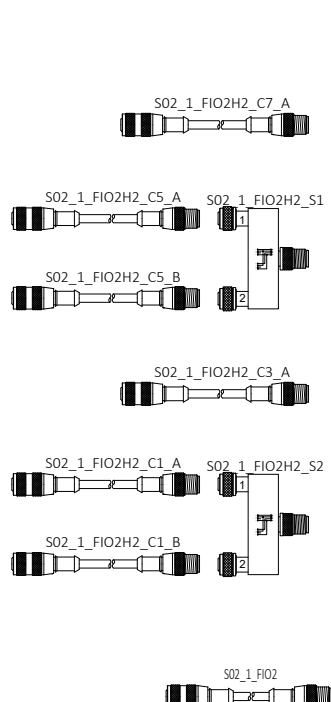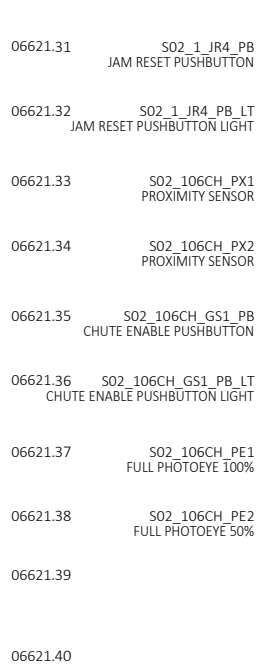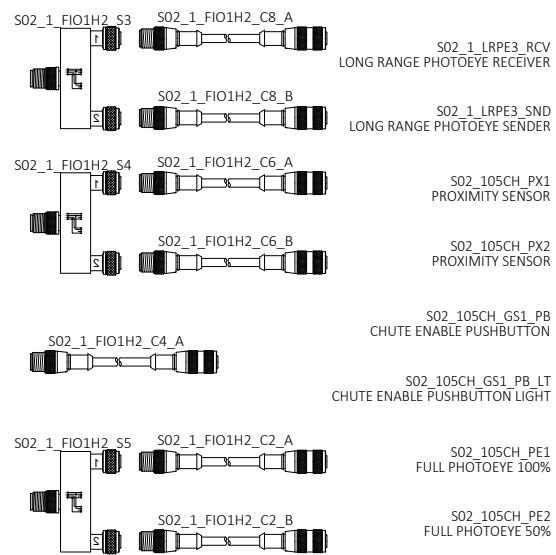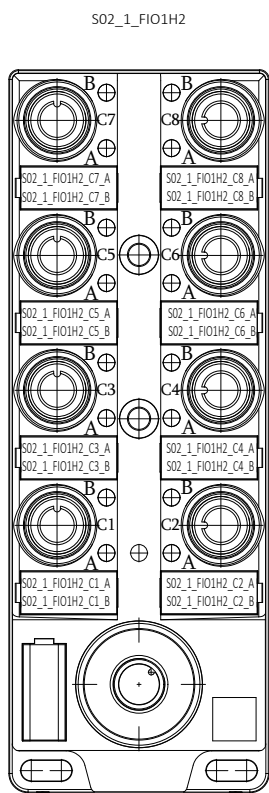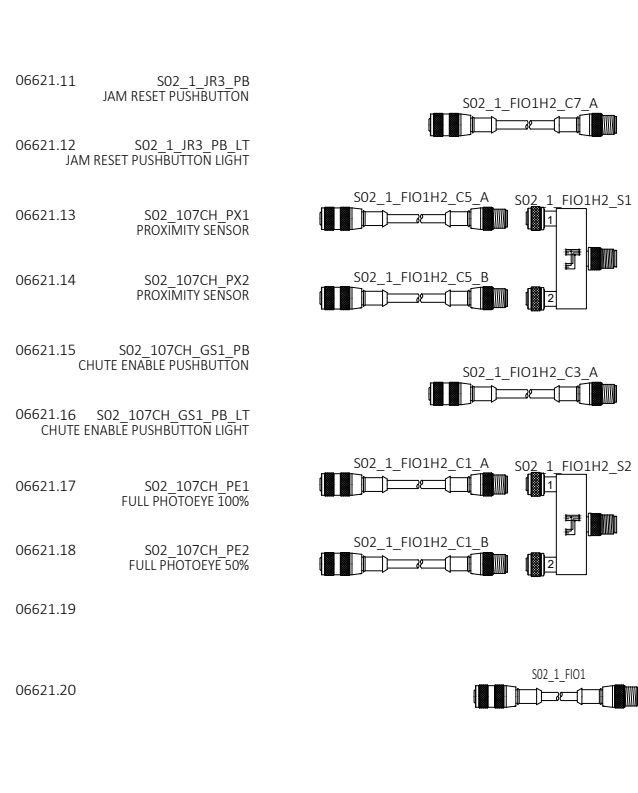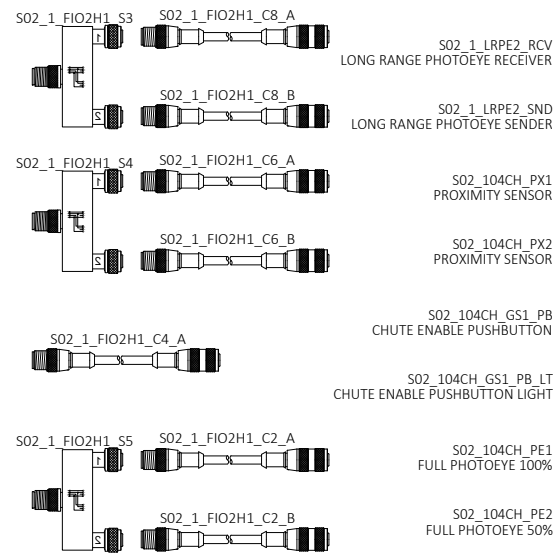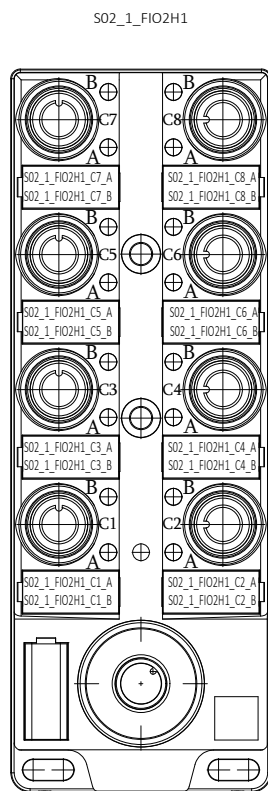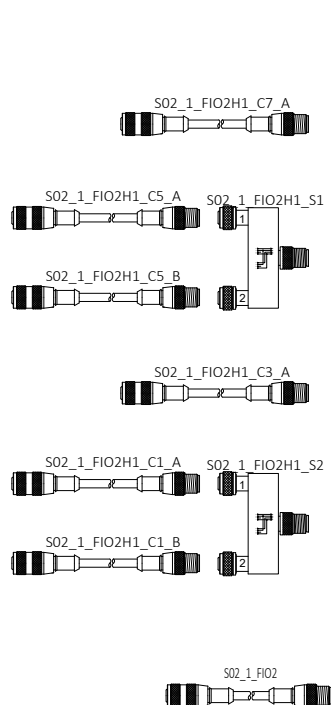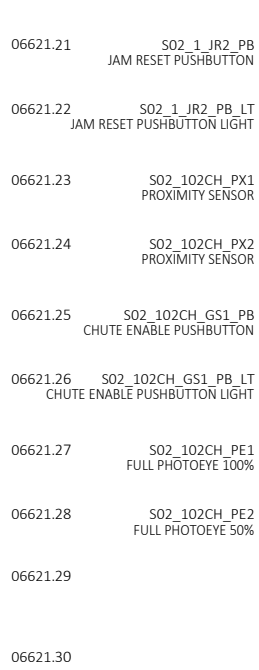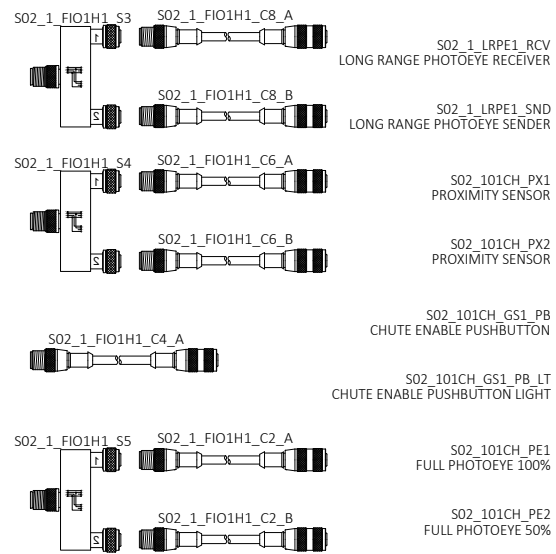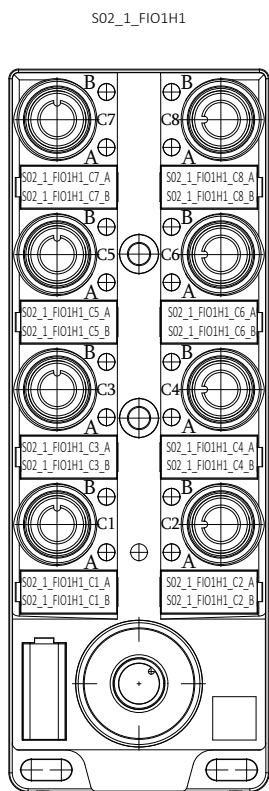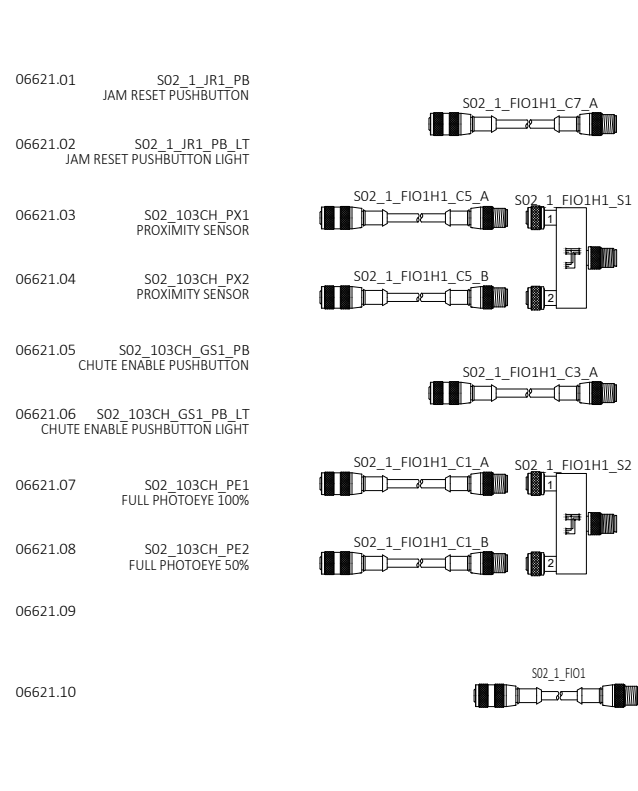

DRAWING REVISIONS			
REV	DESCRIPTION	DATE	BY
00	INITIAL DRAWINGS	04/25/2025	SK
A	AS-BUILT	11/13/2025	LB









CONFIDENTIAL: THE INFORMATION CONTAINED HEREIN IS PROPRIETARY INFORMATION OF AUTOMATION STANDARD LLC AND CONSTITUTES TRADE SECRETS PURSUANT TO THE UNIFORM TRADE SECRETS ACT. THIS INFORMATION SHALL ONLY BE USED IN THE PERFORMANCE OF CONTRACT WITH AUTSTAND. THIS INFORMATION SHALL NOT BE USED, REPRODUCED OR EMPLOYED IN WHOLE PART, EXCEPT WITH AUTSTAND'S PRIOR WRITTEN APPROVAL.

25K Amazon Cross-Belt Sort Center (ACBSC)
S02_1_FIO1H1/S02_1_FIO1H2
S02_1_FIO2H1/S02_1_FIO2H2 IO DRAWINGS

AMAZON MTN6
SPARROWS POINT, MD







FILENAME	
2429-AMZ-MTN6-MCM06-621	
D-SIZE SCALE	JOB NUMBER:
NTS	2429
REVISION	SHEET
A	66

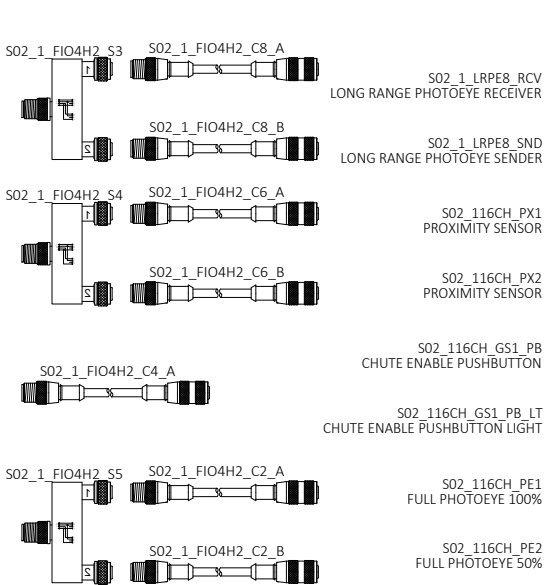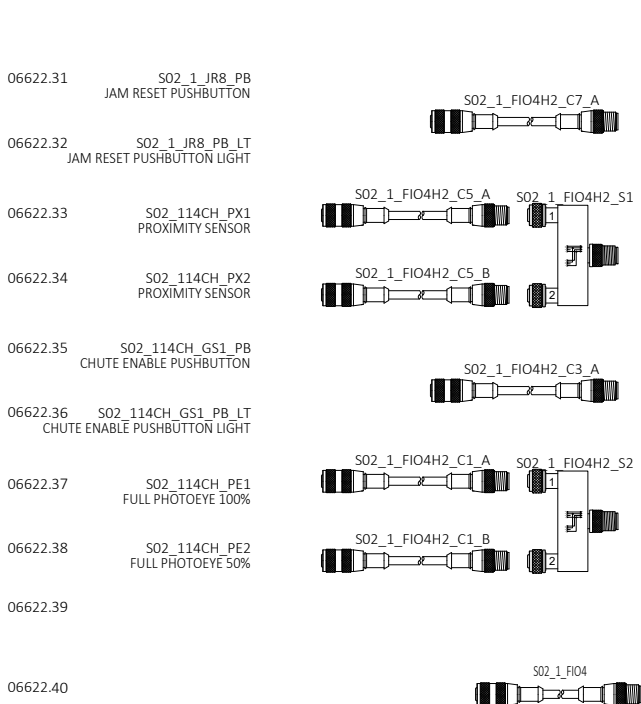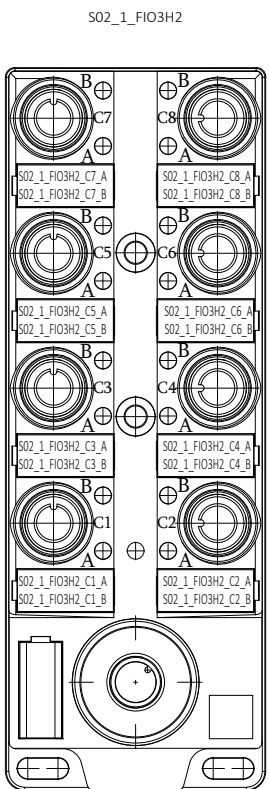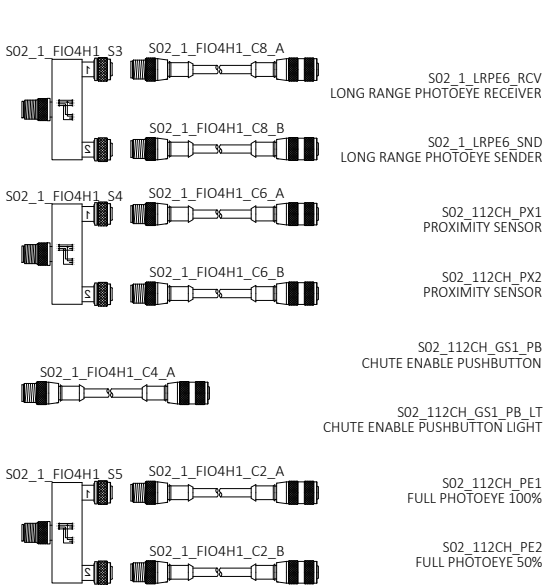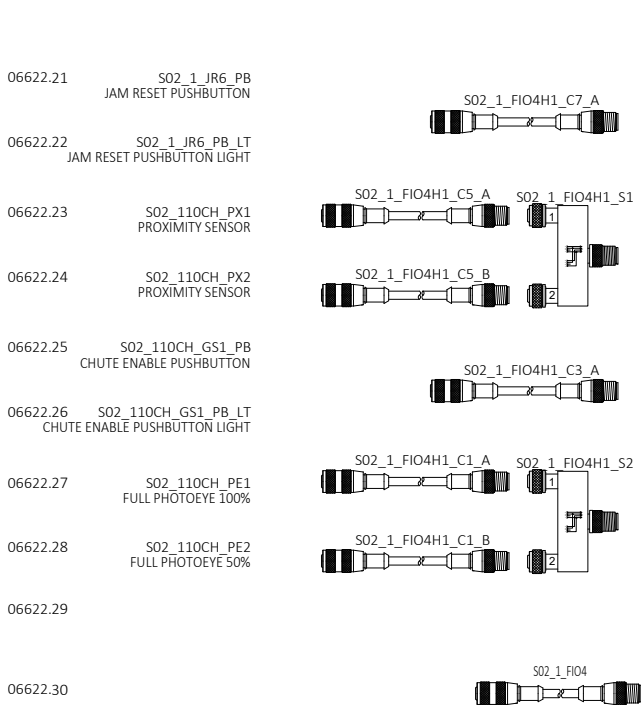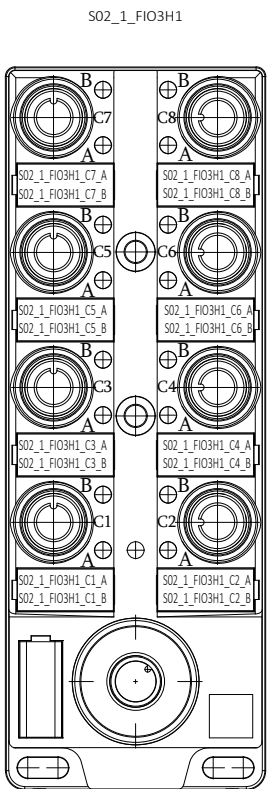
















autStand
Automation Standard

CONFIDENTIAL: THE INFORMATION CONTAINED HEREIN IS PROPRIETARY INFORMATION OF AUTOMATION STANDARD LLC AND CONSTITUTES TRADE SECRETS PURSUANT TO THE UNIFORM TRADE SECRETS ACT. THIS INFORMATION SHALL ONLY BE USED IN THE PERFORMANCE OF CONTRACT WITH AUTOSTAND. THIS INFORMATION SHALL NOT BE USED, REPRODUCED OR EMPLOYED IN WHOLE PART EXCEPT WITH AUTOSTAND'S PRIOR WRITTEN APPROVAL.






FILENAME	
2429-AMZ-MTN6-MCM06-622	
D-SIZE SCALE	JOB NUMBER:
NTS	2429
REVISION	SHEET
A	67

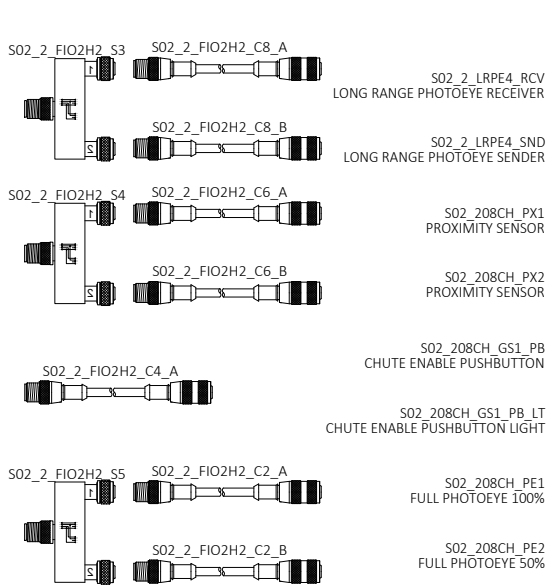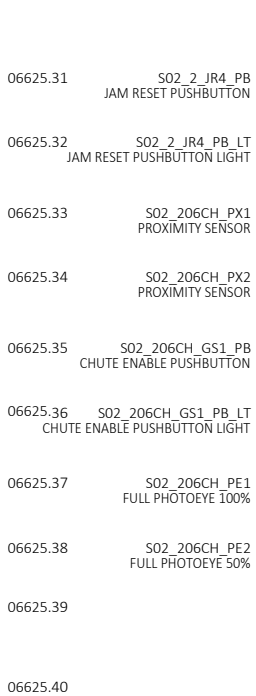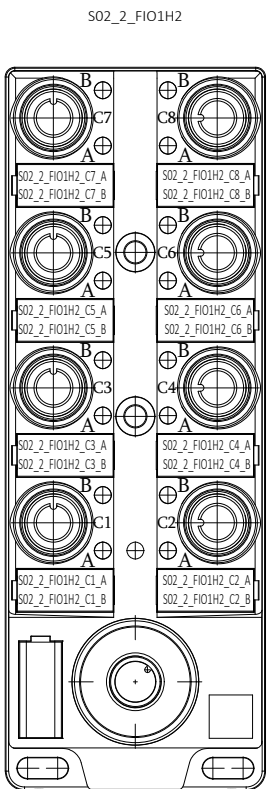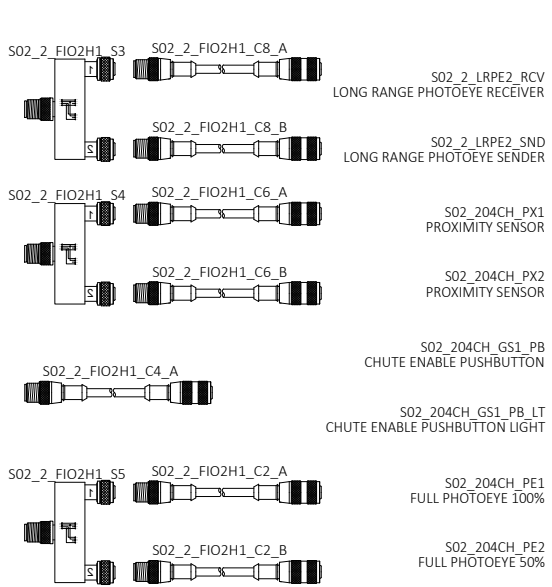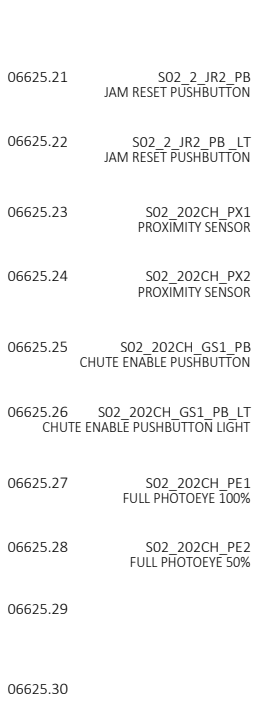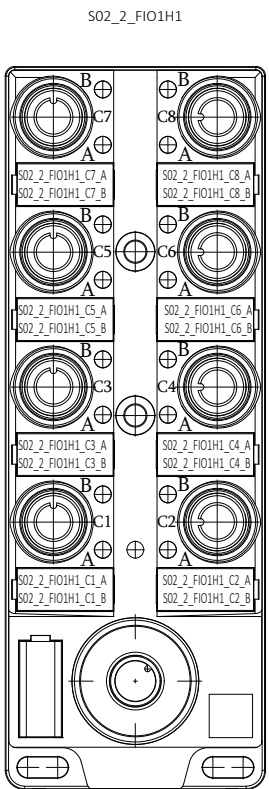

FILENAME	
2429-AMZ-MTN6-MCM06-625	
D-SIZE SCALE	JOB NUMBER:
NTS	2429
REVISION	SHEET
A	70

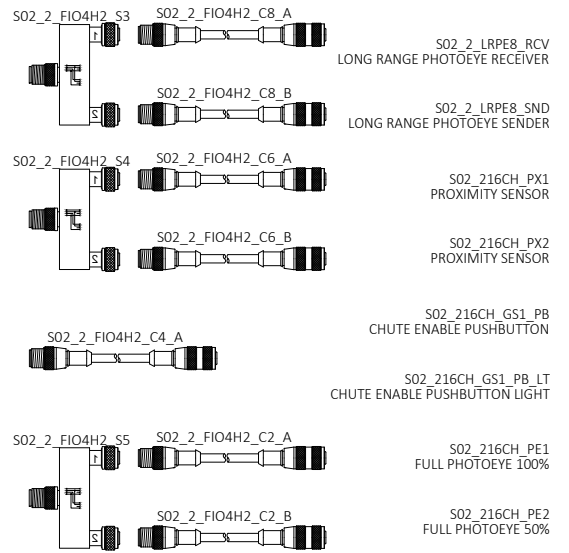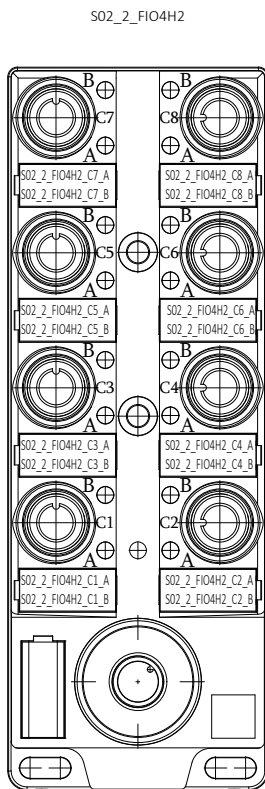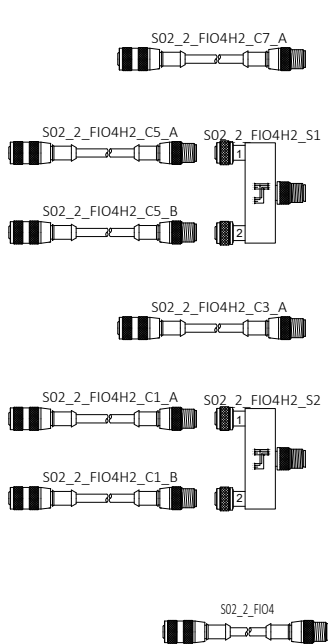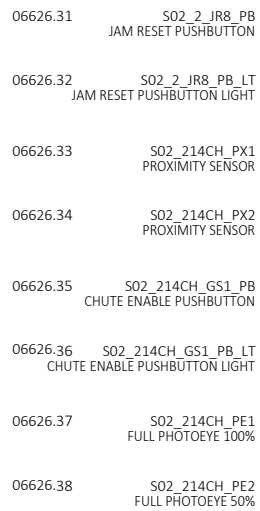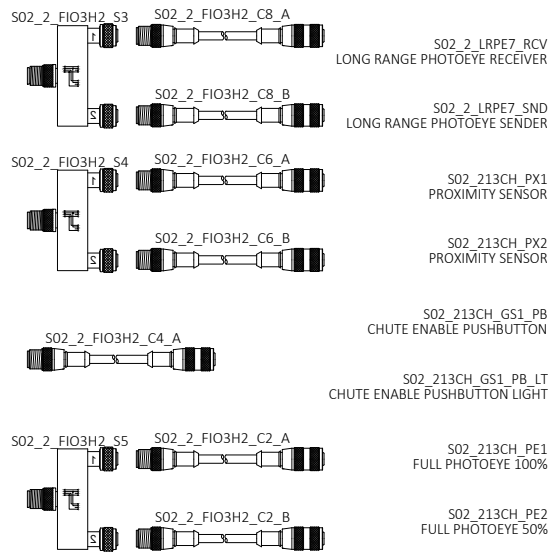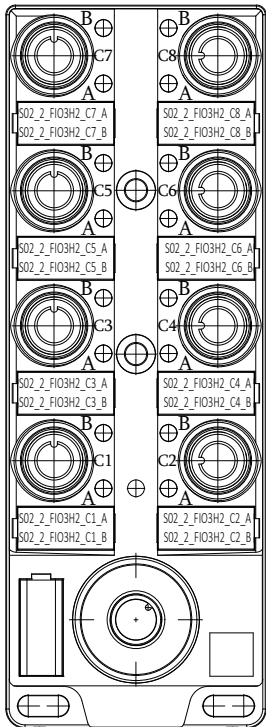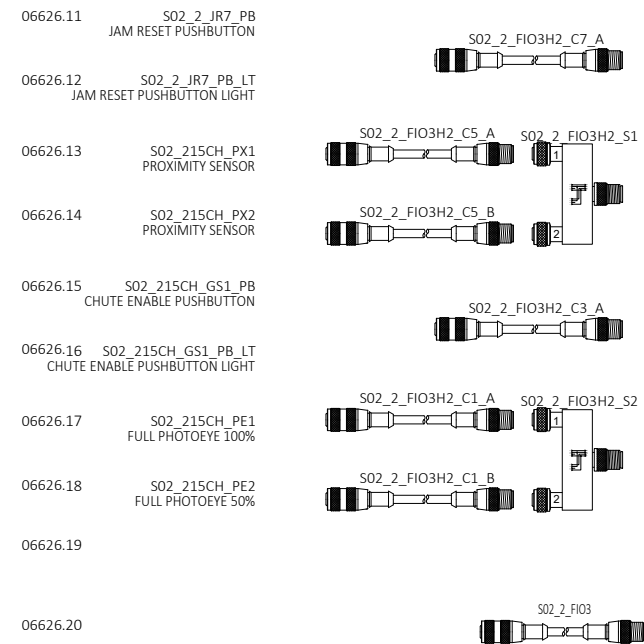 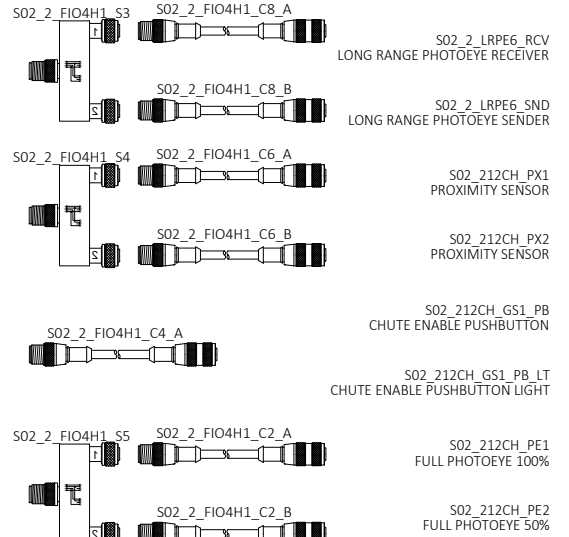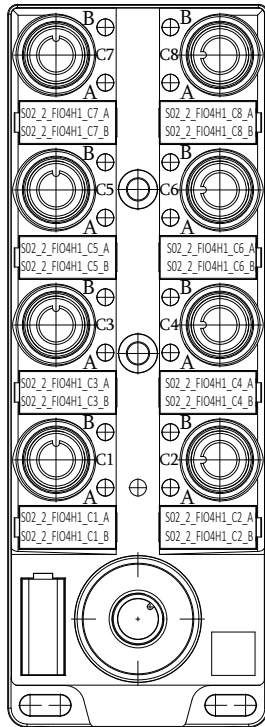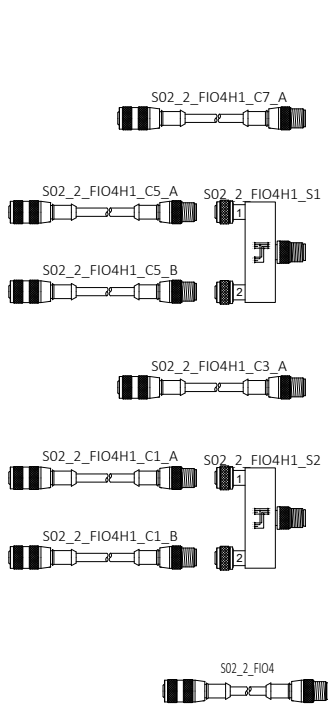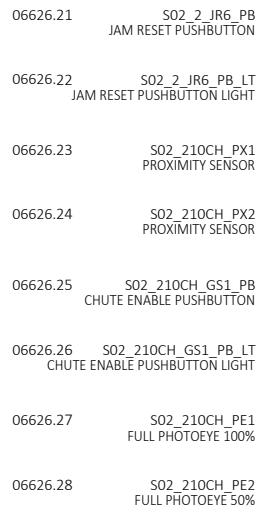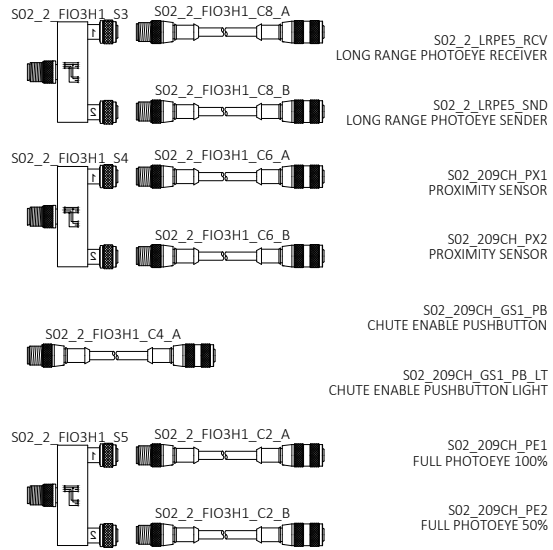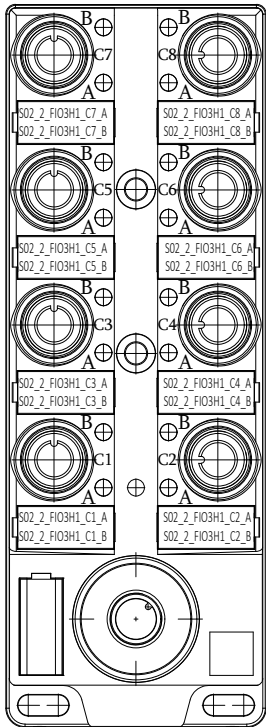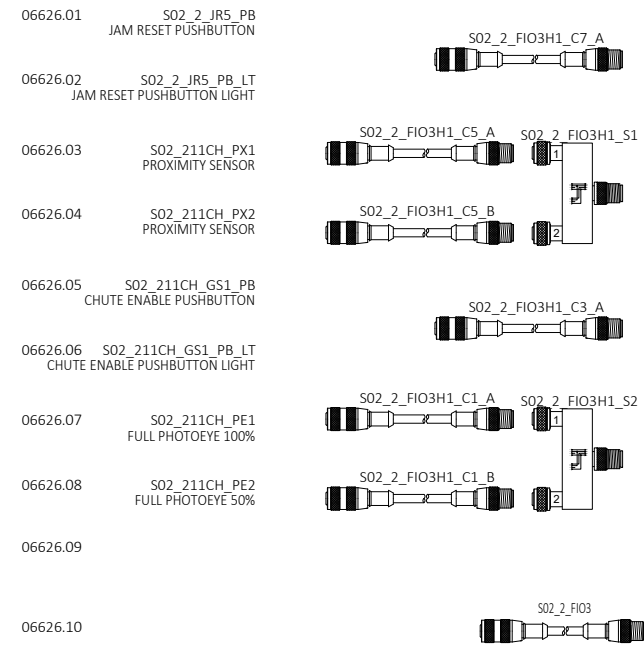

DRAWING REVISIONS			
REV	DESCRIPTION	DATE	BY
00	INITIAL DRAWINGS	04/25/2025	SK
A	AS-BUILT	11/13/2025	LB

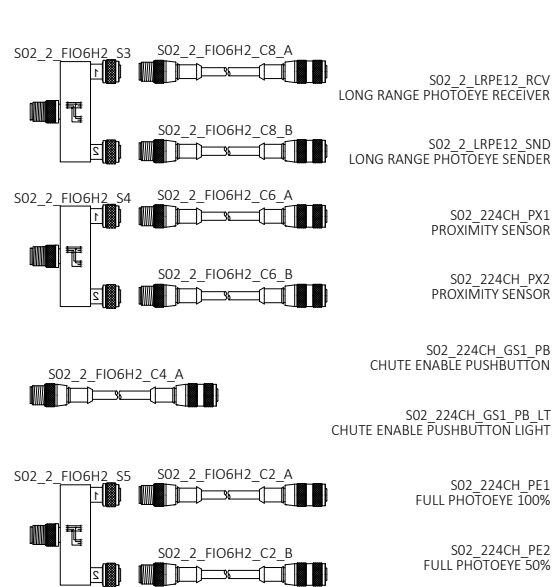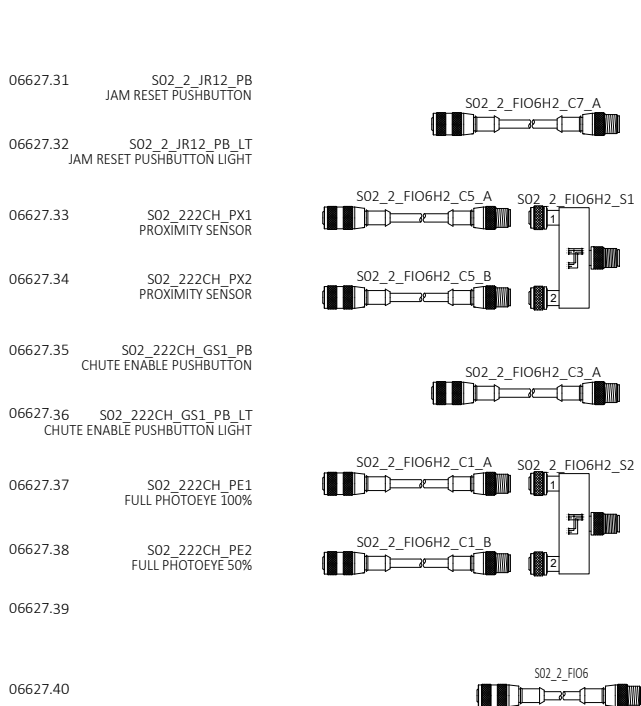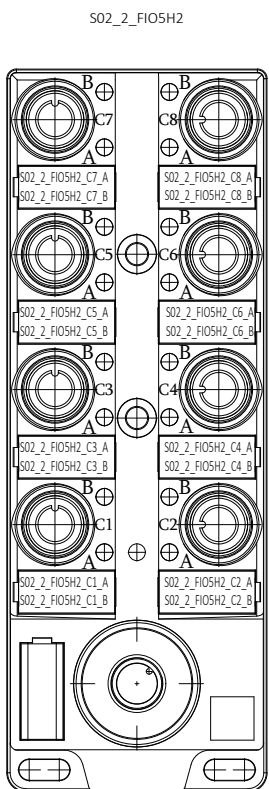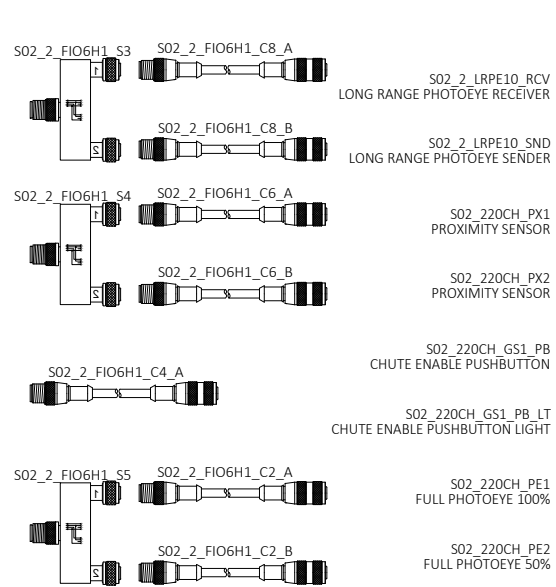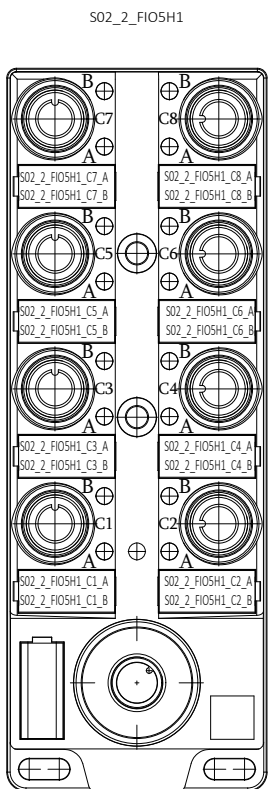

autostand
Automation Standard

CONFIDENTIAL: THE INFORMATION CONTAINED HEREIN IS PROPRIETARY INFORMATION OF AUTOMATION STANDARD LLC AND CONSTITUTES TRADE SECRETS PURSUANT TO THE UNIFORM TRADE SECRETS ACT. THIS INFORMATION SHALL ONLY BE USED IN THE PERFORMANCE OF CONTRACT WITH AUTOSTAND. THIS INFORMATION SHALL NOT BE USED, REPRODUCED OR EMPLOYED IN WHOLE PART EXCEPT WITH AUTOSTAND'S PRIOR WRITTEN APPROVAL.

FILE NAME	
2429-AMZ-MTN6-MCM06-627	
D-SIZE SCALE	JOB NUMBER:
NTS	2429
REVISION	SHEET
A	72

