
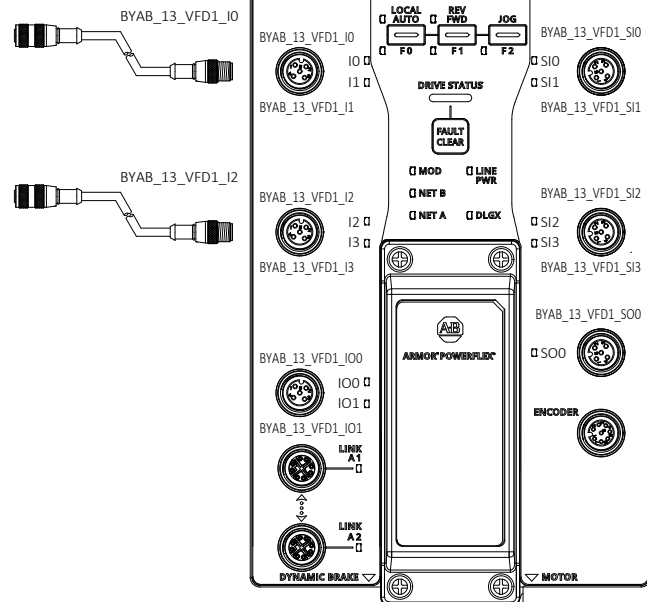 

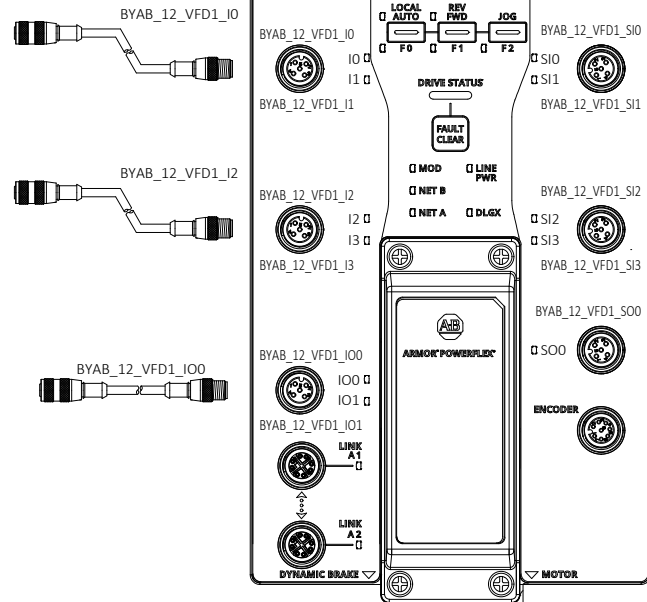 

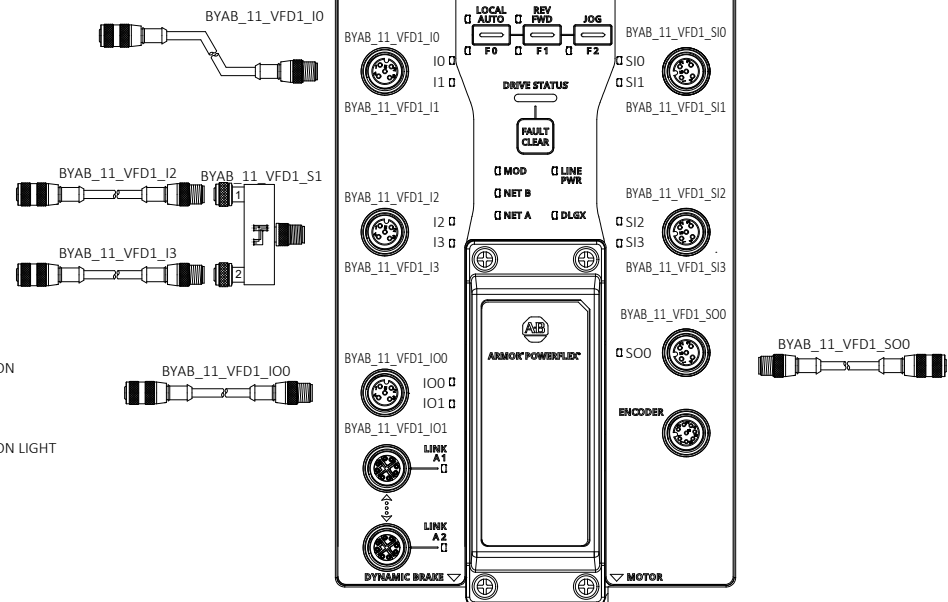 

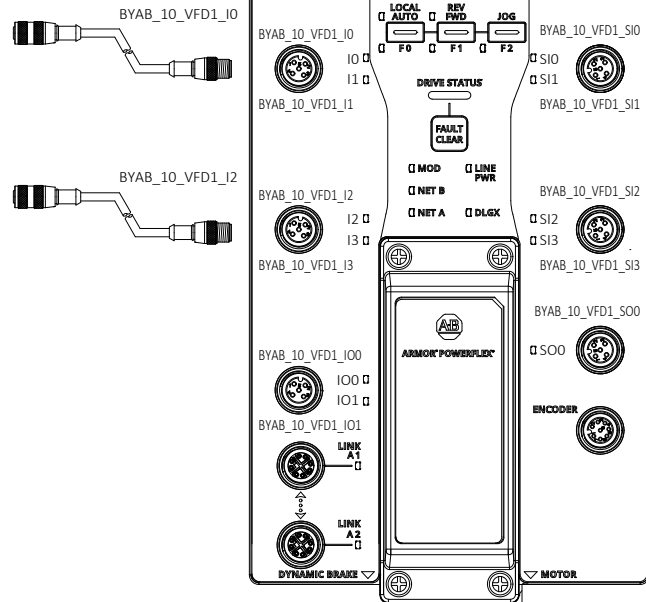 




DRAWING REVISIONS				
REV	DESCRIPTION	DATE	BY	
00	INITIAL DRAWINGS	04/25/2025	SK	
01	ALARM HORN	06/23/2025	SN	
A	AS-BUILT	11/13/2025	LB	





autStand
Automation Standard

CONFIDENTIAL: THE INFORMATION CONTAINED HEREIN IS PROPRIETARY INFORMATION OF AUTOMATION STANDARD LLC AND CONSTITUTES TRADE SECRETS PURSUANT TO THE UNIFORM TRADE SECRETS ACT. THIS INFORMATION SHALL ONLY BE USED IN THE PERFORMANCE OF CONTRACT WITH AUTSTAND. THIS INFORMATION SHALL NOT BE USED, REPRODUCED OR EMPLOYED IN WHOLE PART, EXCEPT WITH AUTSTAND'S PRIOR WRITTEN APPROVAL.

25K Amazon Cross-Belt Sort Center (ACBSC)
BYAB_10_VFD1/BYAB_11_VFD1
BYAB_12_VFD1/BYAB_13_VFD1 IO DRAWINGS

AMAZON MTN6
SPARROWS POINT, MD

FILENAME	
2429-AMZ-MTN6-MCM07-600	
D-SIZE SCALE	JOB NUMBER:
NTS	2429
REVISION	SHEET
A	52

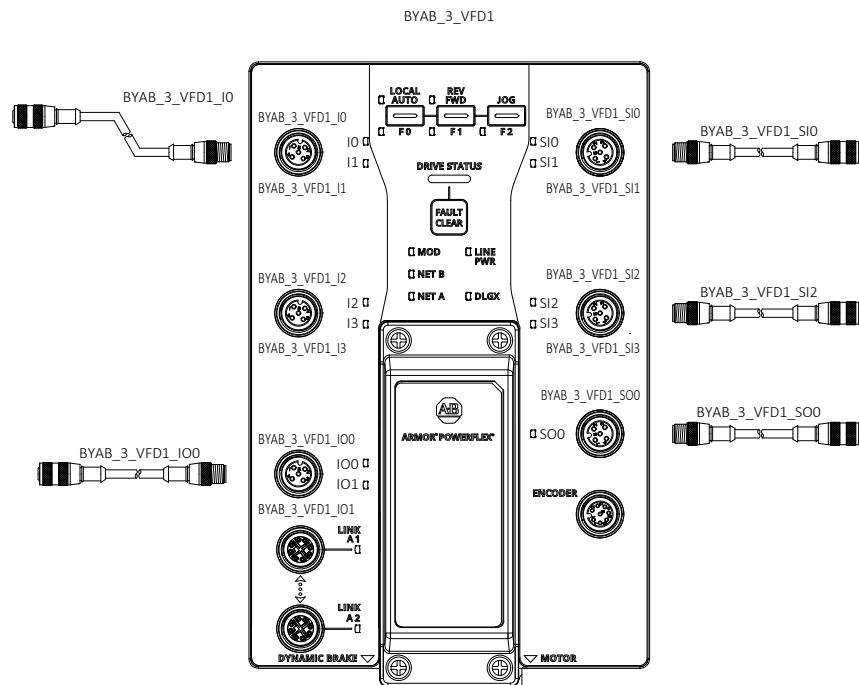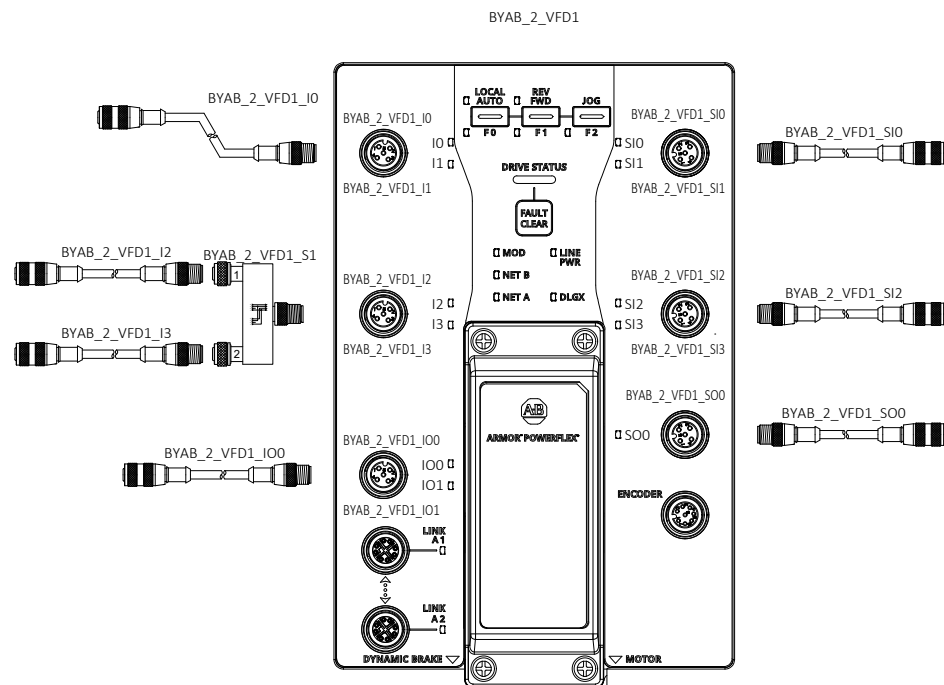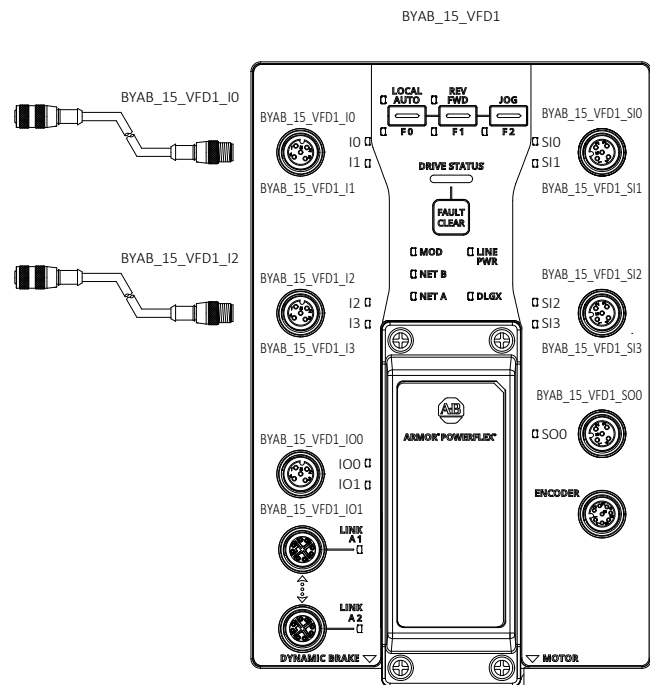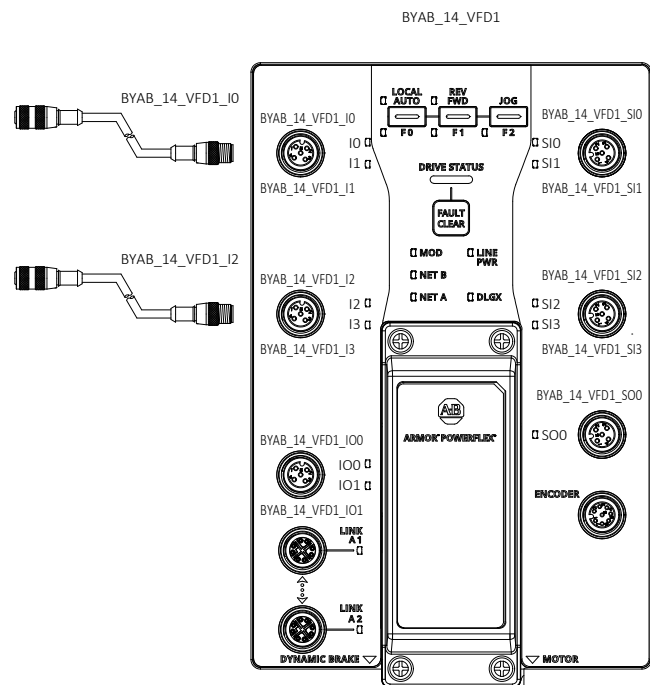





DRAWING REVISIONS			
REV	DESCRIPTION	DATE	BY
00	INITIAL DRAWINGS	04/25/2025	SK
01	ALARM HORN	06/23/2025	SN
A	AS-BUILT	11/13/2025	LB



autStandard
Automation Standard

CONFIDENTIAL: THE INFORMATION CONTAINED HEREIN IS PROPRIETARY INFORMATION OF AUTOMATION STANDARD LLC AND CONSTITUTES TRADE SECRETS PURSUANT TO THE UNIFORM TRADE SECRETS ACT. THIS INFORMATION SHALL ONLY BE USED IN THE PERFORMANCE OF CONTRACT WITH AUTOSTAND. THIS INFORMATION SHALL NOT BE USED, REPRODUCED OR EMPLOYED IN WHOLE PART EXCEPT WITH AUTOSTAND'S PRIOR WRITTEN APPROVAL.

25K Amazon Cross-Belt Sort Center (ACBSC) BYAB_14_VFD1/BYAB_15_VFD1 BYAB_2_VFD1/BYAB_3_VFD1 IO DRAWINGS	FILENAME	
	2429-AMZ-MTN6-MCM07-601	
	D-SIZE SCALE	JOB NUMBER
	NTS	2429
AMAZON MTN6 SPARROWS POINT, MD	REVISION	SHEET
	A	53

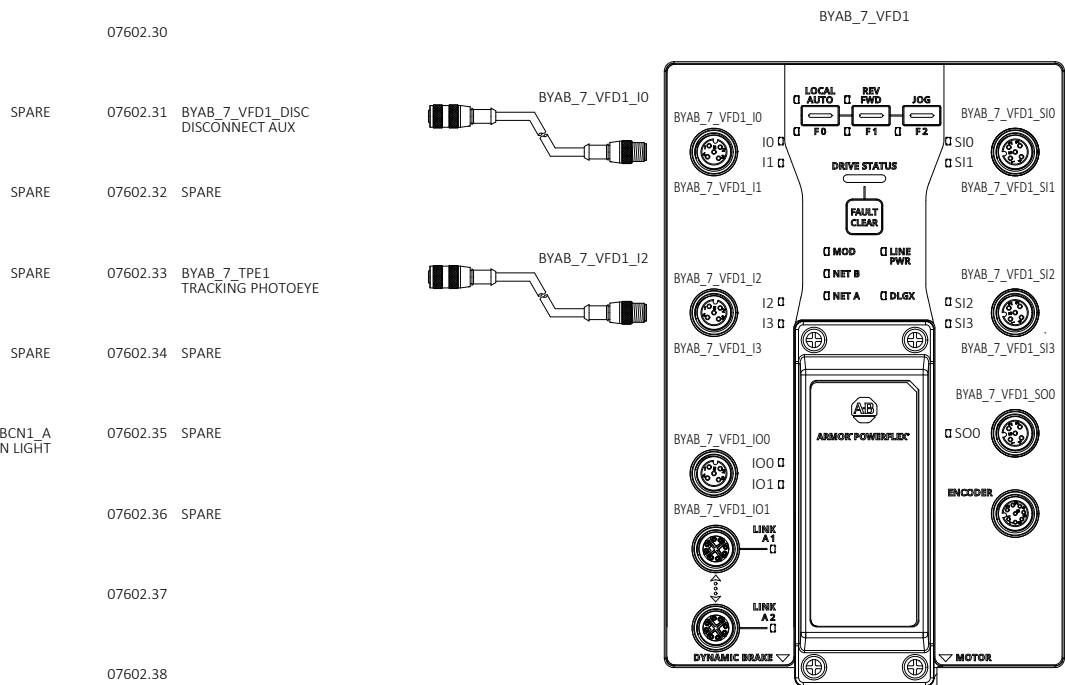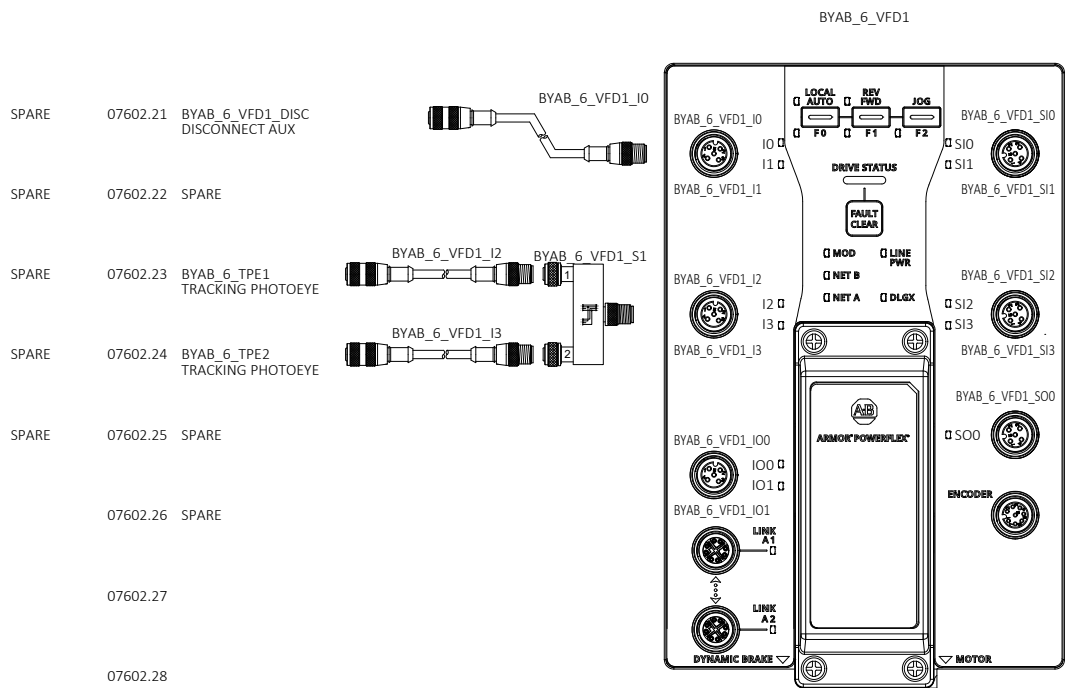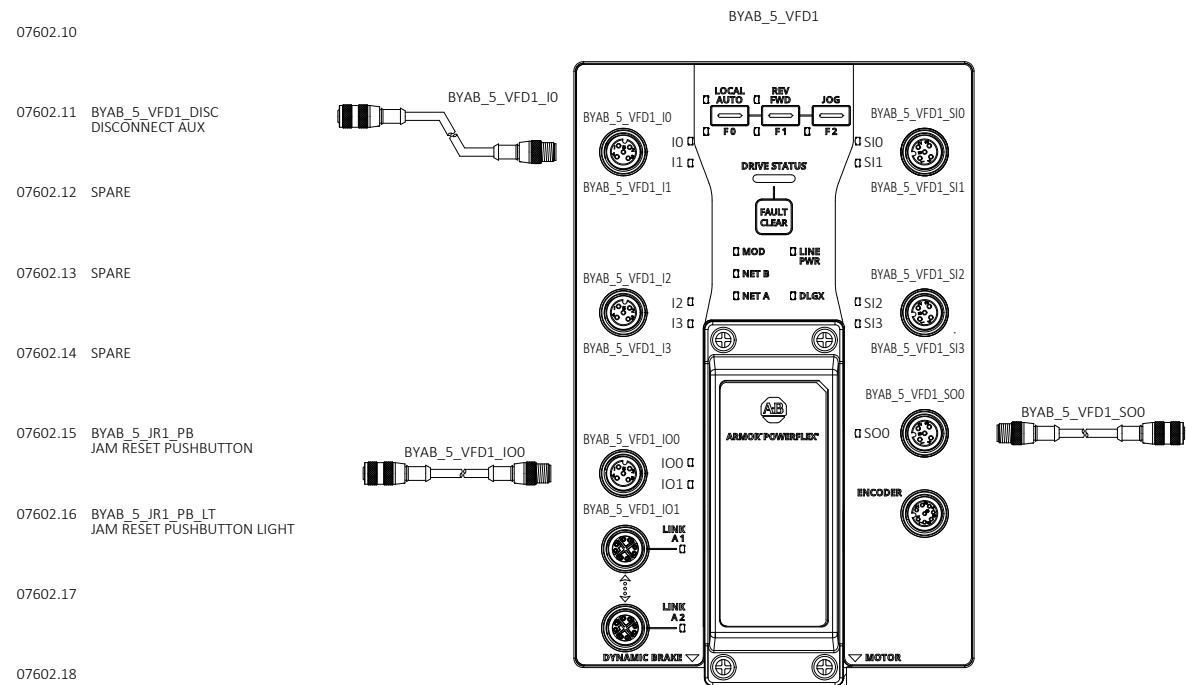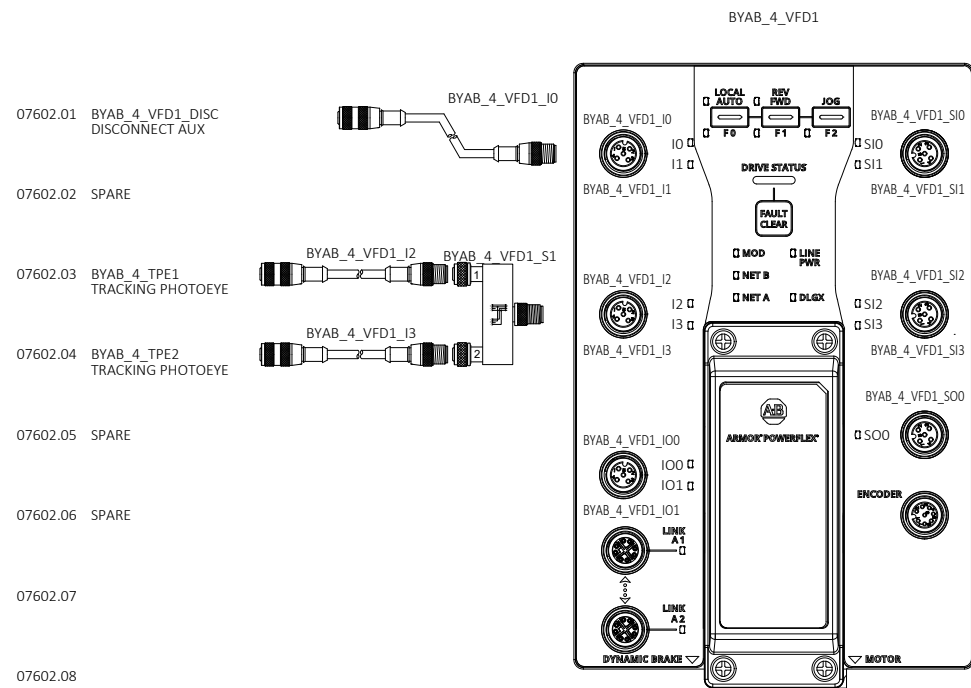





DRAWING REVISIONS			
REV	DESCRIPTION	DATE	BY
00	INITIAL DRAWINGS	04/25/2025	SK
01	ALARM HORN	06/23/2025	SN
A	AS-BUILT	11/13/2025	LB



autostand
Automation Standard

CONFIDENTIAL: THE INFORMATION CONTAINED HEREIN IS PROPRIETARY INFORMATION OF AUTOMATION STANDARD LLC AND CONSTITUTES TRADE SECRETS PURSUANT TO THE UNIFORM TRADE SECRETS ACT. THIS INFORMATION SHALL ONLY BE USED IN THE PERFORMANCE OF CONTRACT WITH AUTOSTAND. THIS INFORMATION SHALL NOT BE USED, REPRODUCED OR EMPLOYED IN WHOLE PART, EXCEPT WITH AUTOSTAND'S PRIOR WRITTEN APPROVAL.

25K Amazon Cross-Belt Sort Center (ACBSC) BYAB_4_VFD1/BYAB_5_VFD1 BYAB_6_VFD1/BYAB_7_VFD1 IO DRAWINGS AMAZON MTN6 SPARROWS POINT, MD	FILENAME 2429-AMZ-MTN6-MCM07-602	
	D-SIZE SCALE NTS	JOB NUMBER: 2429
	REVISION A	SHEET 54

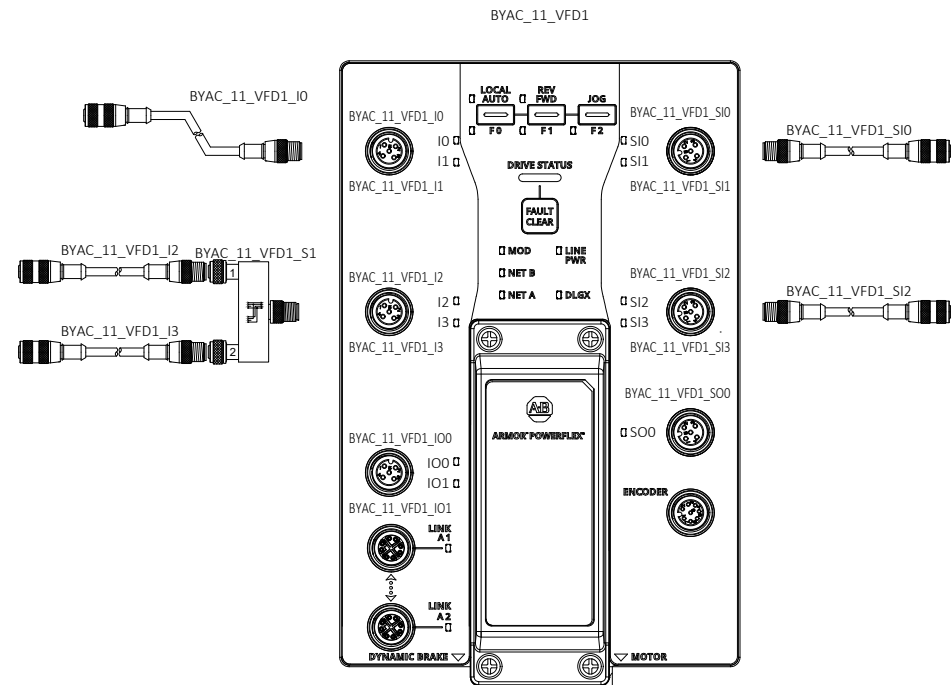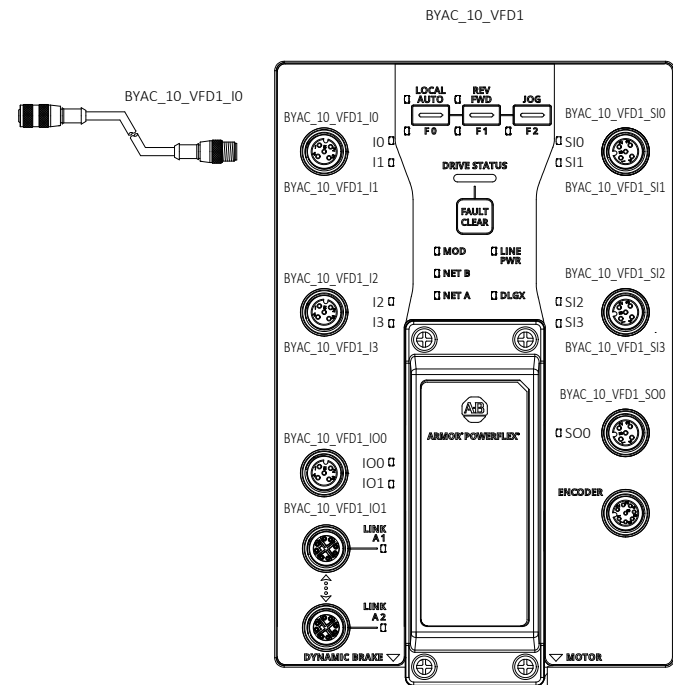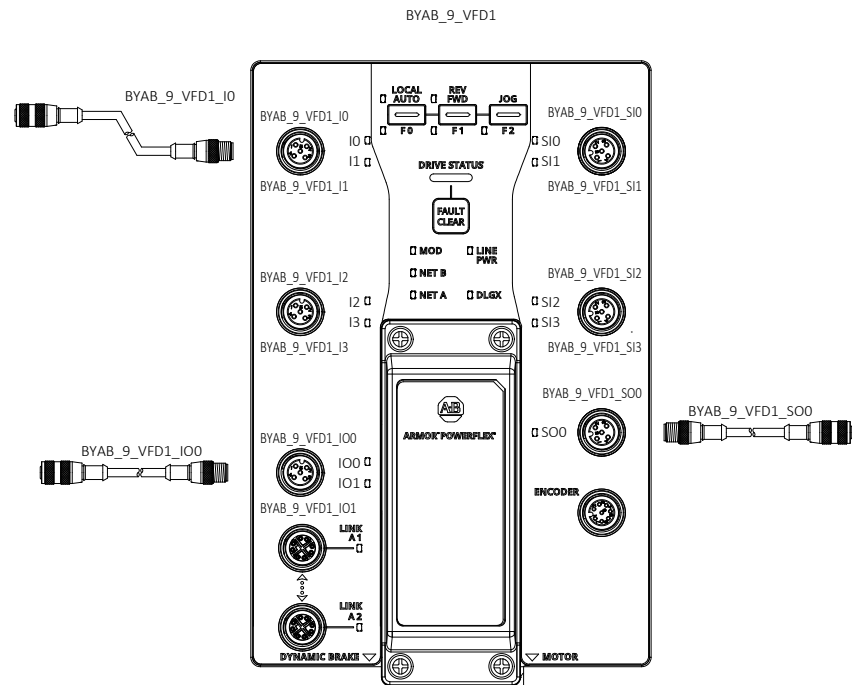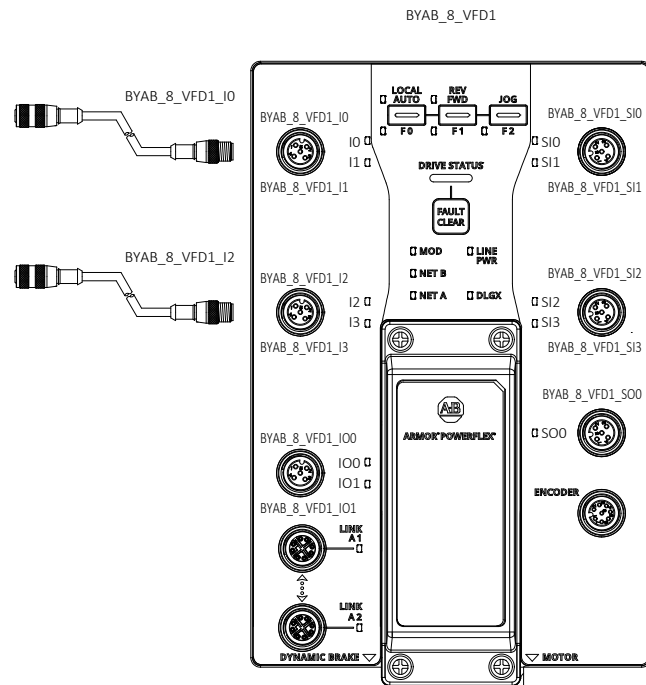

DRAWING REVISIONS			
REV	DESCRIPTION	DATE	BY
00	INITIAL DRAWINGS	04/25/2025	SK
01	ALARM HORN	06/23/2025	SN
A	AS-BUILT	11/13/2025	LB



autostand
Automation Standard

25K Amazon Cross-Belt Sort Center (ACBSC) BYAB_8_VFD1/BYAB_9_VFD1 BYAC_10_VFD1/BYAC_11_VFD1 IO DRAWINGS	FILENAME 2429-AMZ-MTN6-MCM07-603	
	D-SIZE SCALE NTS	JOB NUMBER: 2429
	REVISION A	SHEET 55
	AMAZON MTN6 SPARROWS POINT, MD	

		BYAC_2_VFD1				BYAC_4_VFD1																																																	
07604.01	BYAC_2_VFD1_DISC DISCONNECT AUX			BYAC_2_EPC1 E-STOP PULLCORD	07604.21	BYAC_4_VFD1_DISC DISCONNECT AUX			SPARE																																														
07604.02	SPARE			BYAC_2_EPC1_2 E-STOP PULLCORD	07604.22	SPARE			SPARE																																														
07604.03	BYAC_2_TPE1 TRACKING PHOTOEYE			BYAC_2_EPC2 E-STOP PULLCORD	07604.23	BYAC_5_TPE1 TRACKING PHOTOEYE			SPARE																																														
07604.04	BYAC_2_TPE2 TRACKING PHOTOEYE			BYAC_2_EPC2_2 E-STOP PULLCORD	07604.24	SPARE			SPARE																																														
07604.05	BYAC_2_BCN1_A AMBER BEACON LIGHT			BYAC_2_BCN2_R RED BEACON LIGHT	07604.25	BYAC_4_JR1_PB JAM RESET PUSHBUTTON			BYAC_4_BCN1_A AMBER BEACON LIGHT																																														
07604.06	BYAC_2_BCN1_R RED BEACON LIGHT				07604.26	BYAC_4_JR1_PB_LT JAM RESET PUSHBUTTON LIGHT																																																	
07604.07					07604.27																																																		
07604.08					07604.28																																																		
07604.09					07604.29																																																		
07604.10		BYAC_3_VFD1			07604.30		BYAC_5_VFD1																																																
07604.11	BYAC_3_VFD1_DISC DISCONNECT AUX			SPARE	07604.31	BYAC_5_VFD1_DISC DISCONNECT AUX			SPARE																																														
07604.12	SPARE			SPARE	07604.32	SPARE			SPARE																																														
07604.13	BYAC_3_TPE1 TRACKING PHOTOEYE			SPARE	07604.33	BYAC_5_TPE2 TRACKING PHOTOEYE			SPARE																																														
07604.14	SPARE			SPARE	07604.34	SPARE			SPARE																																														
07604.15	SPARE			SPARE	07604.35	SPARE			SPARE																																														
07604.16	SPARE				07604.36	SPARE																																																	
07604.17					07604.37																																																		
07604.18					07604.38																																																		
07604.19					07604.39																																																		
07604.20					07604.40																																																		
<table><tr><th colspan="4">DRAWING REVISIONS</th></tr><tr><th>REV</th><th>DESCRIPTION</th><th>DATE</th><th>BY</th></tr><tr><td>00</td><td>INITIAL DRAWINGS</td><td>04/25/2005</td><td>SK</td></tr><tr><td>01</td><td>ALARM HORN</td><td>06/23/2005</td><td>SN</td></tr><tr><td>A</td><td>AS-BUILT</td><td>11/13/2005</td><td>LB</td></tr><tr><td></td><td></td><td></td><td></td></tr><tr><td></td><td></td><td></td><td></td></tr><tr><td></td><td></td><td></td><td></td></tr></table>				DRAWING REVISIONS				REV	DESCRIPTION	DATE	BY	00	INITIAL DRAWINGS	04/25/2005	SK	01	ALARM HORN	06/23/2005	SN	A	AS-BUILT	11/13/2005	LB															25K Amazon Cross-Belt Sort Center (ACBSC) BYAC_2_VFD1/BYAC_3_VFD1 BYAC_4_VFD1/BYAC_5_VFD1 IO DRAWINGS		<table><tr><th colspan="2">FILENAME</th></tr><tr><td colspan="2">2429-AMZ-MTN6-MCM07-604</td></tr><tr><th>D-SIZE SCALE</th><th>JOB NUMBER</th></tr><tr><td>NTS</td><td>2429</td></tr><tr><th>REVISION</th><th>SHEET</th></tr><tr><td>A</td><td>56</td></tr></table>		FILENAME		2429-AMZ-MTN6-MCM07-604		D-SIZE SCALE	JOB NUMBER	NTS	2429	REVISION	SHEET	A	56		
DRAWING REVISIONS																																																							
REV	DESCRIPTION	DATE	BY																																																				
00	INITIAL DRAWINGS	04/25/2005	SK																																																				
01	ALARM HORN	06/23/2005	SN																																																				
A	AS-BUILT	11/13/2005	LB																																																				
FILENAME																																																							
2429-AMZ-MTN6-MCM07-604																																																							
D-SIZE SCALE	JOB NUMBER																																																						
NTS	2429																																																						
REVISION	SHEET																																																						
A	56																																																						
CONFIDENTIAL: THE INFORMATION CONTAINED HEREIN IS PROPRIETARY INFORMATION OF AUTOMATION STANDARD LLC AND CONSTITUTES TRADE SECRETS PURSUANT TO THE UNIFORM TRADE SECRETS ACT. THIS INFORMATION SHALL ONLY BE USED IN THE PERFORMANCE OF CONTRACT WITH AUTISTAND. THIS INFORMATION SHALL NOT BE USED, REPRODUCED OR EMPLOYED IN WHOLE PART, EXCEPT WITH AUTISTAND'S PRIOR WRITTEN APPROVAL.				AMAZON MTN6 SPARROWS POINT, MD																																																			

BYAC_6_VFD1		BYAC_8_VFD1			
07605.01	BYAC_6_VFD1_DISC DISCONNECT AUX	SPARE	07605.21	BYAC_8_VFD1_DISC DISCONNECT AUX	SPARE
07605.02	SPARE	SPARE	07605.22	SPARE	SPARE
07605.03	BYAC_7_TPE1 TRACKING PHOTOEYE	SPARE	07605.23	BYAC_8_TPE1 TRACKING PHOTOEYE	SPARE
07605.04	SPARE	SPARE	07605.24	SPARE	SPARE
07605.05	BYAC_6_JR1_PB JAM RESET PUSHBUTTON	BYAC_6_BCN1_A AMBER BEACON LIGHT	07605.25	SPARE	SPARE
07605.06	BYAC_6_JR1_PB_LT JAM RESET PUSHBUTTON LIGHT		07605.26	SPARE	
07605.07			07605.27		
07605.08			07605.28		
07605.09			07605.29		
07605.10			07605.30		
07605.11	BYAC_7_VFD1_DISC DISCONNECT AUX	SPARE	07605.31	BYAC_9_VFD1_DISC DISCONNECT AUX	SPARE
07605.12	SPARE	SPARE	07605.32	SPARE	SPARE
07605.13	BYAC_7_TPE2 TRACKING PHOTOEYE	SPARE	07605.33	BYAC_9_TPE1 TRACKING PHOTOEYE	SPARE
07605.14	SPARE	SPARE	07605.34	SPARE	SPARE
07605.15	SPARE	SPARE	07605.35	SPARE	SPARE
07605.16	SPARE		07605.36	SPARE	
07605.17			07605.37		
07605.18			07605.38		
07605.19			07605.39		
07605.20			07605.40		

DRAWING REVISIONS				2429-AMZ-MTN6-MCM07-605	
REV	DESCRIPTION	DATE	BY	D-SIZE SCALE	JOB NUMBER
00	INITIAL DRAWINGS	04/25/2025	SK	NTS	2429
01	ALARM HORN	06/23/2025	SN		
A	AS-BUILT	11/13/2025	LB	REVISION	SHEET
				A	57




















autStand

Automation Standard

CONFIDENTIAL: THE INFORMATION CONTAINED HEREIN IS PROPRIETARY INFORMATION OF AUTOMATION STANDARD LLC AND CONSTITUTES TRADE SECRETS PURSUANT TO THE UNIFORM TRADE SECRETS ACT. THIS INFORMATION SHALL ONLY BE USED IN THE PERFORMANCE OF CONTRACT WITH AUTSTAND. THIS INFORMATION SHALL NOT BE USED, REPRODUCED OR EMPLOYED IN WHOLE PART, EXCEPT WITH AUTSTAND'S PRIOR WRITTEN APPROVAL.

25K Amazon Cross-Belt Sort Center (ACBSC)
BYAC_6_VFD1/BYAC_7_VFD1
BYAC_8_VFD1/BYAC_9_VFD1 IO DRAWINGS

AMAZON MTN6
SPARROWS POINT, MD

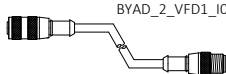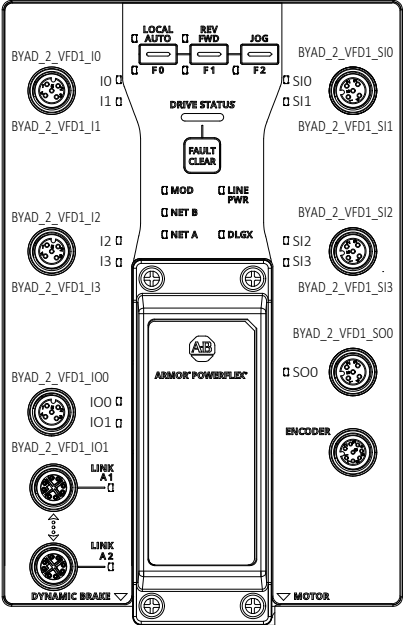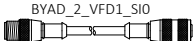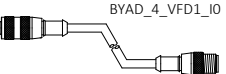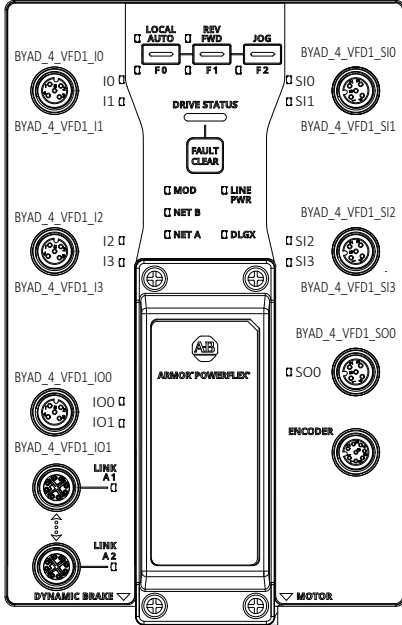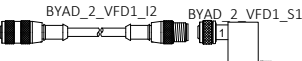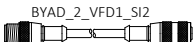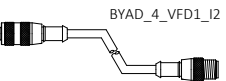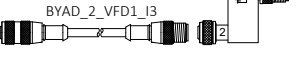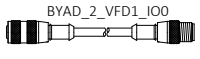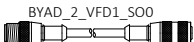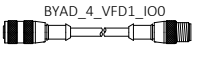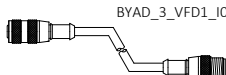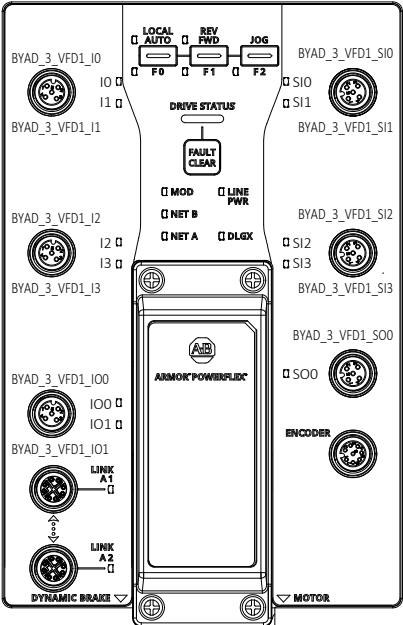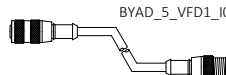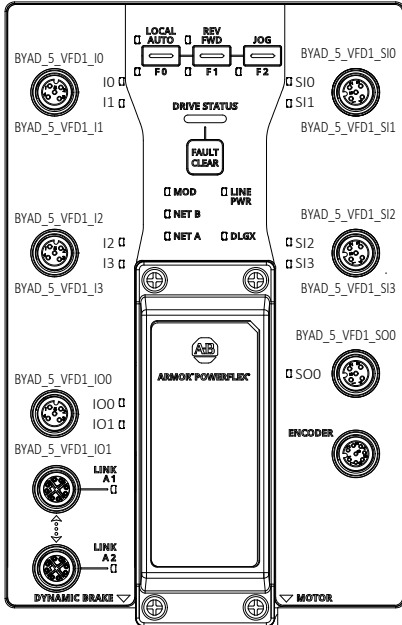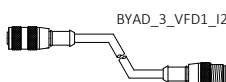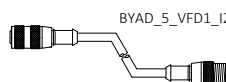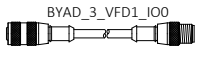07606.01		BYAD_2_VFD1_DISC DISCONNECT AUX				BYAD_2_EPC1 E-STOP PULLCORD	07606.21	BYAD_4_VFD1_DISC DISCONNECT AUX			SPARE
07606.02		SPARE				BYAD_2_EPC1_2 E-STOP PULLCORD	07606.22	SPARE			SPARE
07606.03		BYAD_2_TPE1 TRACKING PHOTOEYE				BYAD_2_EPC2 E-STOP PULLCORD	07606.23	BYAD_5_TPE1 TRACKING PHOTOEYE			SPARE
07606.04		BYAD_2_TPE2 TRACKING PHOTOEYE				BYAD_2_EPC2_2 E-STOP PULLCORD	07606.24	SPARE			SPARE
07606.05		BYAD_2_BCN1_A AMBER BEACON LIGHT				BYAD_2_BCN2_R RED BEACON LIGHT	07606.25	BYAD_4_JR1_PB JAM RESET PUSHBUTTON			SPARE
07606.06		BYAD_2_BCN1_R RED BEACON LIGHT					07606.26	BYAD_4_JR1_PB_LT JAM RESET PUSHBUTTON LIGHT			
07606.07							07606.27				
07606.08							07606.28				
07606.09							07606.29				
07606.10							07606.30				
07606.11		BYAD_3_VFD1_DISC DISCONNECT AUX				SPARE	07606.31	BYAD_5_VFD1_DISC DISCONNECT AUX			SPARE
07606.12		SPARE				SPARE	07606.32	SPARE			SPARE
07606.13		BYAD_3_TPE1 TRACKING PHOTOEYE				SPARE	07606.33	BYAD_5_TPE2 TRACKING PHOTOEYE			SPARE
07606.14		SPARE				SPARE	07606.34	SPARE			SPARE
07606.15		BYAD_4_BCN1_A AMBER BEACON LIGHT				SPARE	07606.35	SPARE			SPARE
07606.16		BYAD_4_BCN1_H ALARM HORN					07606.36	SPARE			
07606.17							07606.37				
07606.18							07606.38				
07606.19							07606.39				
07606.20							07606.40				

DRAWING REVISIONS				FILENAME	
REV	DESCRIPTION	DATE	BY	2429-AMZ-MTN6-MCM07-606	
00	INITIAL DRAWINGS	04/25/2025	SK	D-SIZE SCALE	JOB NUMBER:
01	ALARM HORN	06/23/2025	SN	NTS	2429
A	AS-BUILT	11/13/2025	LB	REVISION	SHEET
				A	58







CONFIDENTIAL: THE INFORMATION CONTAINED HEREIN IS PROPRIETARY INFORMATION OF AUTOMATION STANDARD LLC AND CONSTITUTES TRADE SECRETS PURSUANT TO THE UNIFORM TRADE SECRETS ACT. THIS INFORMATION SHALL ONLY BE USED IN THE PERFORMANCE OF CONTRACT WITH AUTSTAND. THIS INFORMATION SHALL NOT BE USED, REPRODUCED OR EMPLOYED IN WHOLE PART, EXCEPT WITH AUTSTAND'S PRIOR WRITTEN APPROVAL.

25K Amazon Cross-Belt Sort Center (ACBSC)
BYAD_2_VFD1/BYAD_3_VFD1
BYAD_4_VFD1/BYAD_5_VFD1 IO DRAWINGS

AMAZON MTN6
SPARROWS POINT, MD

		BYAD_6_VFD1				BYAD_8_VFD1																																																		
07607.01	BYAD_6_VFD1_DISC DISCONNECT AUX			SPARE		07607.21	BYAD_8_VFD1_DISC DISCONNECT AUX			SPARE																																														
07607.02	SPARE			SPARE		07607.22	SPARE			SPARE																																														
07607.03	SPARE			SPARE		07607.23	BYAD_8_TPE1 TRACKING PHOTOEYE			SPARE																																														
07607.04	SPARE			SPARE		07607.24	SPARE			SPARE																																														
07607.05	BYAD_6_JR1_PB JAM RESET PUSHBUTTON			BYAD_6_VFD1_I00		07607.25	SPARE			SPARE																																														
07607.06	BYAD_6_JR1_PB_LT JAM RESET PUSHBUTTON LIGHT			BYAD_6_VFD1_I01		07607.26	SPARE																																																	
07607.07						07607.27																																																		
07607.08						07607.28																																																		
07607.09						07607.29																																																		
07607.10						07607.30																																																		
07607.11	BYAD_7_VFD1_DISC DISCONNECT AUX			BYAD_7_VFD1_I0		07607.31	BYAD_9_VFD1_DISC DISCONNECT AUX			SPARE																																														
07607.12	SPARE					07607.32	SPARE			SPARE																																														
07607.13	BYAD_7_TPE1 TRACKING PHOTOEYE			BYAD_7_VFD1_I2	BYAD_7_VFD1_S1	07607.33	BYAD_9_TPE1 TRACKING PHOTOEYE			SPARE																																														
07607.14	BYAD_7_TPE2 TRACKING PHOTOEYE			BYAD_7_VFD1_I3		07607.34	SPARE			SPARE																																														
07607.15	SPARE					07607.35	SPARE			SPARE																																														
07607.16	SPARE					07607.36	SPARE																																																	
07607.17						07607.37																																																		
07607.18						07607.38																																																		
07607.19						07607.39																																																		
07607.20						07607.40																																																		
<table><tr><th colspan="4">DRAWING REVISIONS</th></tr><tr><th>REV</th><th>DESCRIPTION</th><th>DATE</th><th>BY</th></tr><tr><td>00</td><td>INITIAL DRAWINGS</td><td>04/25/2025</td><td>SK</td></tr><tr><td>01</td><td>ALARM HORN</td><td>06/23/2025</td><td>SN</td></tr><tr><td>A</td><td>AS-BUILT</td><td>11/13/2025</td><td>LB</td></tr><tr><td> </td><td> </td><td> </td><td> </td></tr><tr><td> </td><td> </td><td> </td><td> </td></tr><tr><td> </td><td> </td><td> </td><td> </td></tr><tr><td> </td><td> </td><td> </td><td> </td></tr></table>		DRAWING REVISIONS				REV	DESCRIPTION	DATE	BY	00	INITIAL DRAWINGS	04/25/2025	SK	01	ALARM HORN	06/23/2025	SN	A	AS-BUILT	11/13/2025	LB																			25K Amazon Cross-Belt Sort Center (ACBSC) BYAD_6_VFD1/BYAD_7_VFD1 BYAD_8_VFD1/BYAD_9_VFD1 IO DRAWINGS AMAZON MTN6 SPARROWS POINT, MD		<table><tr><th colspan="2">FILENAME</th></tr><tr><td>2429-AMZ-MTN6-MCM07-607</td><td></td></tr><tr><th>D-SIZE SCALE</th><th>JOB NUMBER</th></tr><tr><td>NTS</td><td>2429</td></tr><tr><th>REVISION</th><th>SHEET</th></tr><tr><td>A</td><td>59</td></tr></table>		FILENAME		2429-AMZ-MTN6-MCM07-607		D-SIZE SCALE	JOB NUMBER	NTS	2429	REVISION	SHEET	A	59	
DRAWING REVISIONS																																																								
REV	DESCRIPTION	DATE	BY																																																					
00	INITIAL DRAWINGS	04/25/2025	SK																																																					
01	ALARM HORN	06/23/2025	SN																																																					
A	AS-BUILT	11/13/2025	LB																																																					
FILENAME																																																								
2429-AMZ-MTN6-MCM07-607																																																								
D-SIZE SCALE	JOB NUMBER																																																							
NTS	2429																																																							
REVISION	SHEET																																																							
A	59																																																							

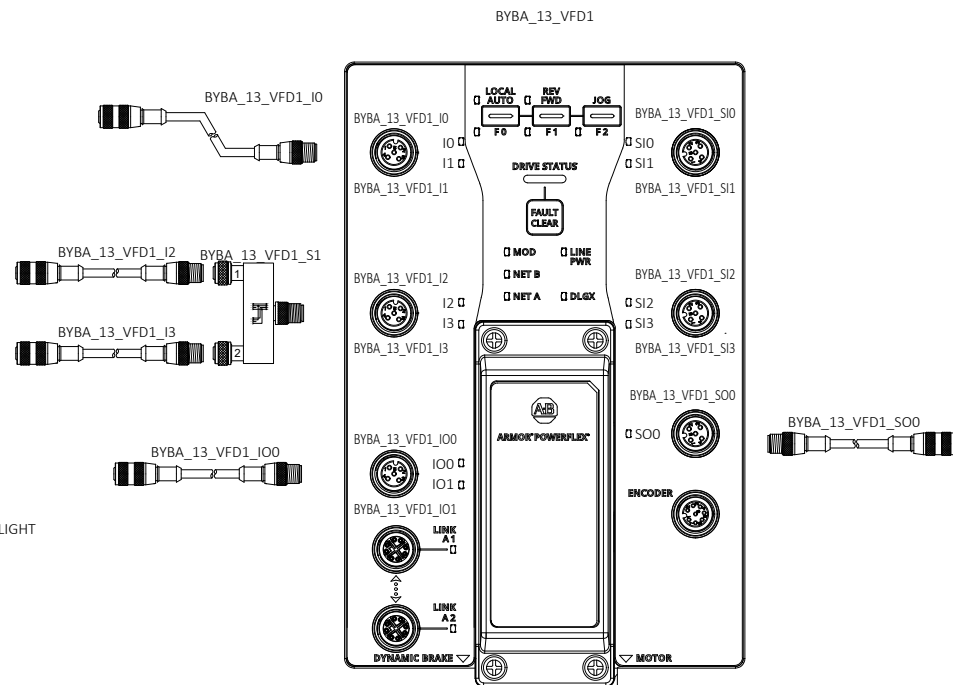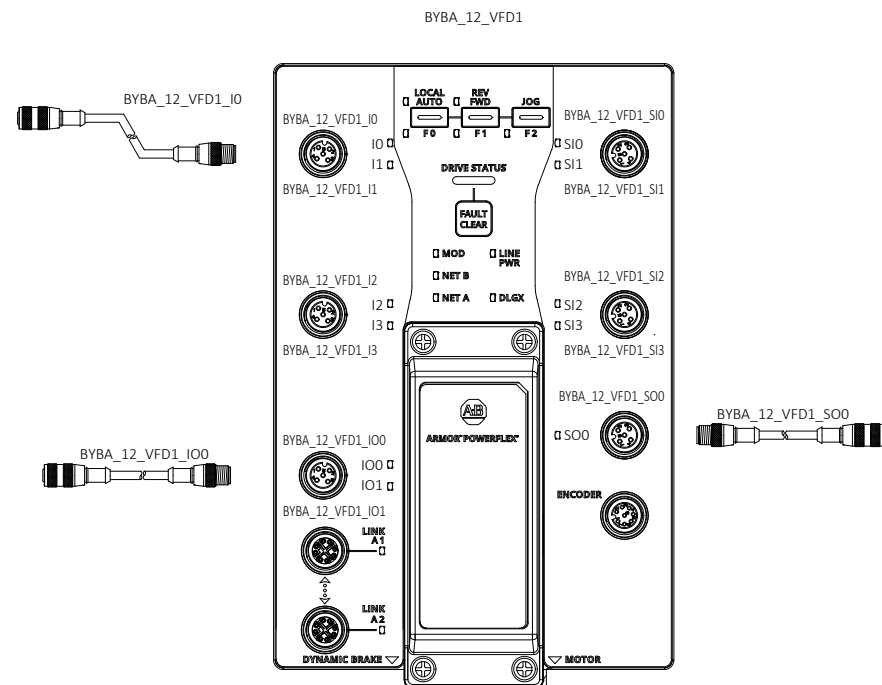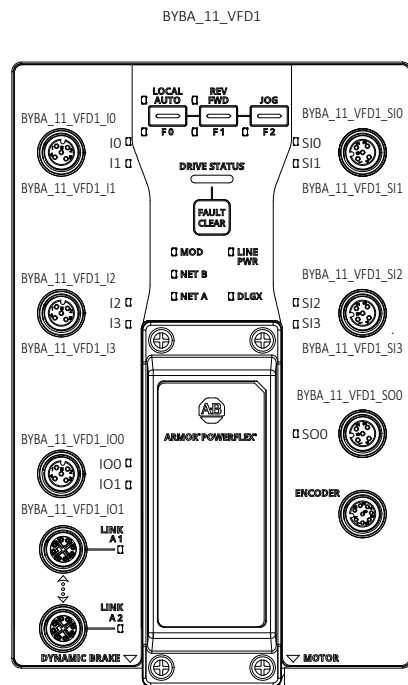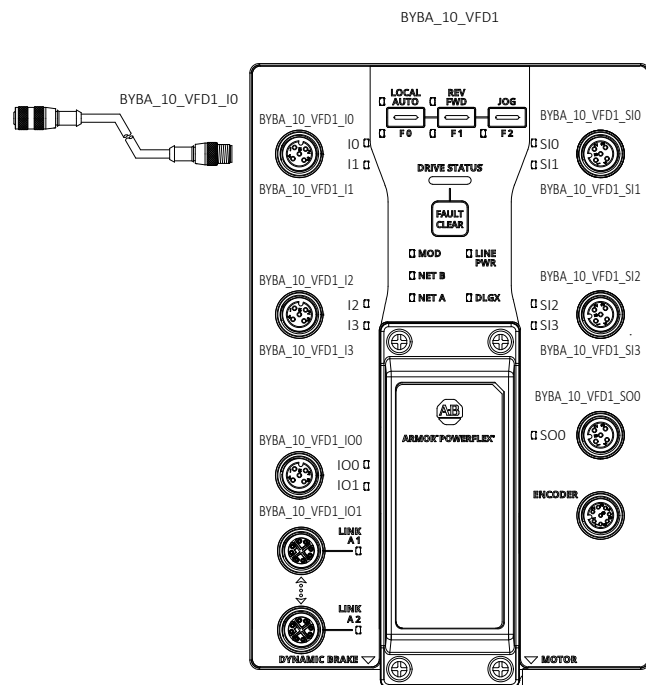





DRAWING REVISIONS			
REV	DESCRIPTION	DATE	BY
00	INITIAL DRAWINGS	04/25/2025	SK
01	ALARM HORN	06/23/2025	SN
A	AS-BUILT	11/13/2025	LB



autostand
Automation Standard

CONFIDENTIAL: THE INFORMATION CONTAINED HEREIN IS PROPRIETARY INFORMATION OF AUTOMATION STANDARD LLC AND CONSTITUTES TRADE SECRETS PURSUANT TO THE UNIFORM TRADE SECRETS ACT. THIS INFORMATION SHALL ONLY BE USED IN THE PERFORMANCE OF CONTRACT WITH AUTOSTAND. THIS INFORMATION SHALL NOT BE USED, REPRODUCED OR EMPLOYED IN WHOLE PART EXCEPT WITH AUTOSTAND'S PRIOR WRITTEN APPROVAL.

25K Amazon Cross-Belt Sort Center (ACBSC) BYBA_10_VFD1/BYBA_11_VFD1 BYBA_12_VFD1/BYBA_13_VFD1 IO DRAWINGS	FILENAME 2429-AMZ-MTN6-MCM07-608	
	D-SIZE SCALE NTS	JOB NUMBER: 2429
	REVISION A	SHEET 60
	AMAZON MTN6 SPARROWS POINT, MD	

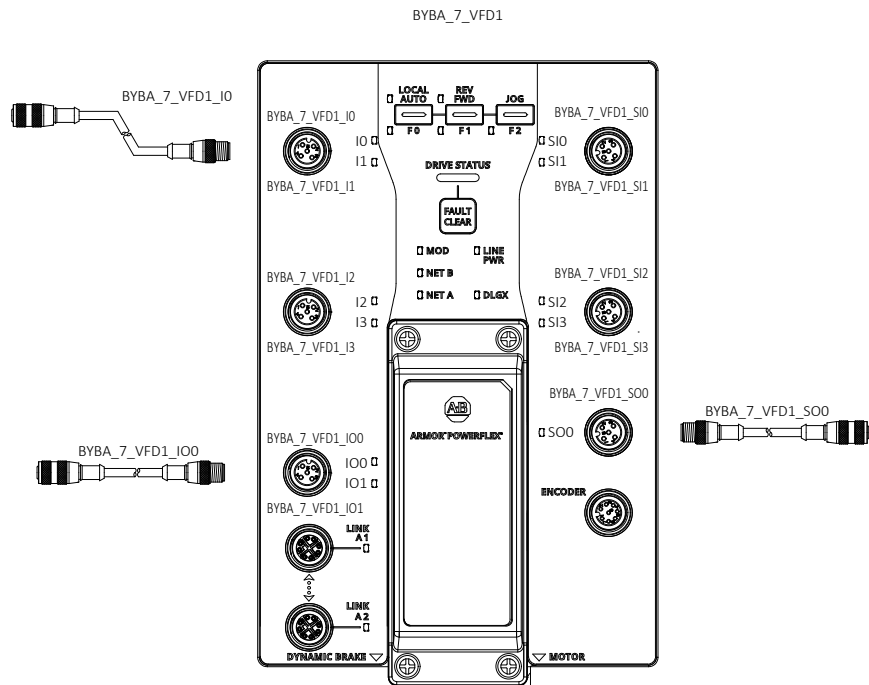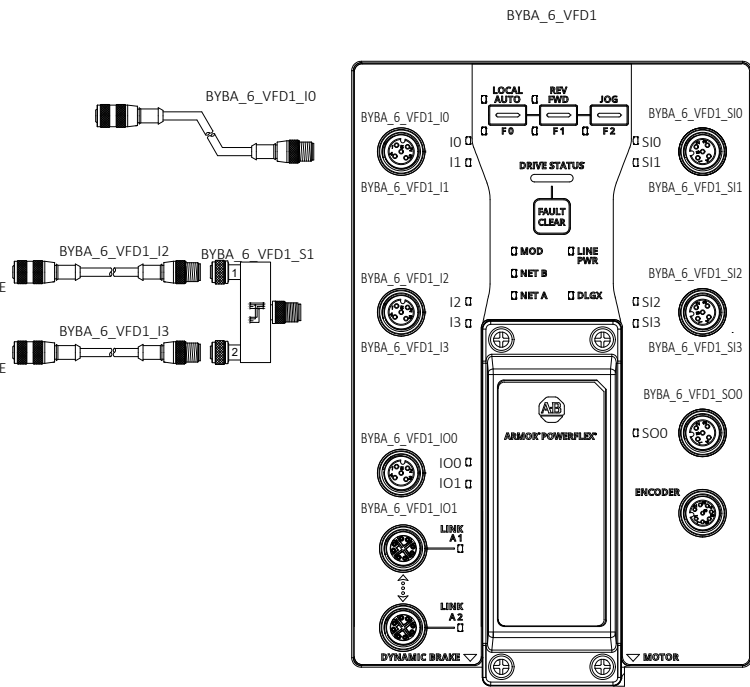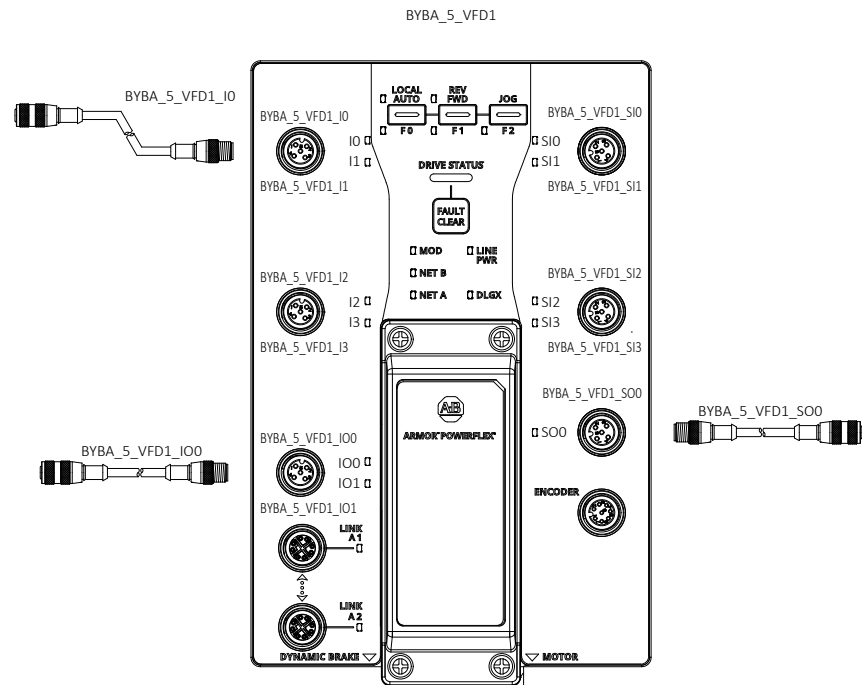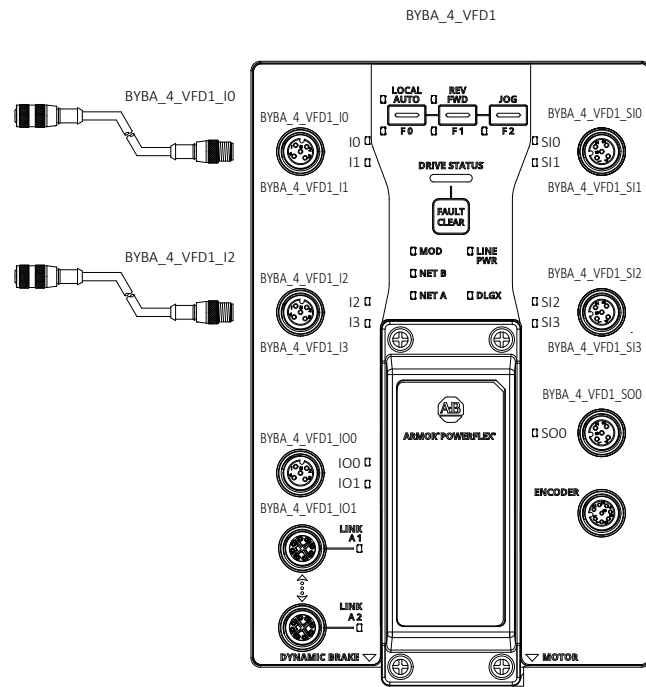

DRAWING REVISIONS			
REV	DESCRIPTION	DATE	BY
00	INITIAL DRAWINGS	04/25/2025	SK
01	ALARM HORN	06/23/2025	SN
A	AS-BUILT	11/13/2025	LB







CONFIDENTIAL: THE INFORMATION CONTAINED HEREIN IS PROPRIETARY INFORMATION OF AUTOSTAND INFORMATION STANDARD LLC AND CONSTITUTES TRADE SECRETS PURSUANT TO THE UNIFORM TRADE SECRETS ACT. THIS INFORMATION SHALL ONLY BE USED IN THE PERFORMANCE OF CONTRACT WITH AUTOSTAND. THIS INFORMATION SHALL NOT BE USED, REPRODUCED OR EMPLOYED IN WHOLE PART, EXCEPT WITH AUTOSTAND'S PRIOR WRITTEN APPROVAL.

25K Amazon Cross-Belt Sort Center (ACBSC)
BYBA_4_VFD1/BYBA_5_VFD1
BYBA_6_VFD1/BYBA_7_VFD1 IO DRAWINGS

AMAZON MTN6
SPARROWS POINT, MD



FILENAME	
2429-AMZ-MTN6-MCM07-610	
D-SIZE SCALE	JOB NUMBER:
NTS	2429
REVISION	SHEET
A	62

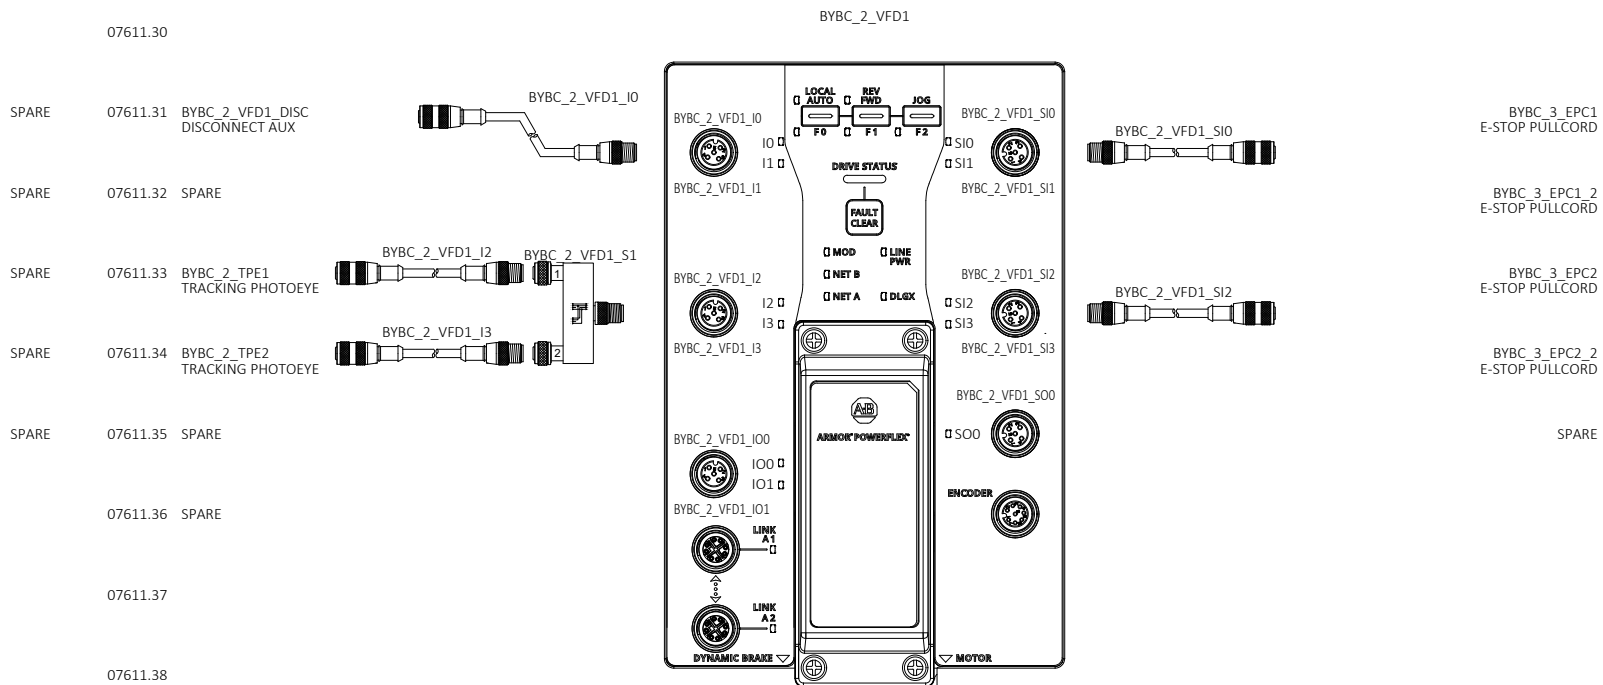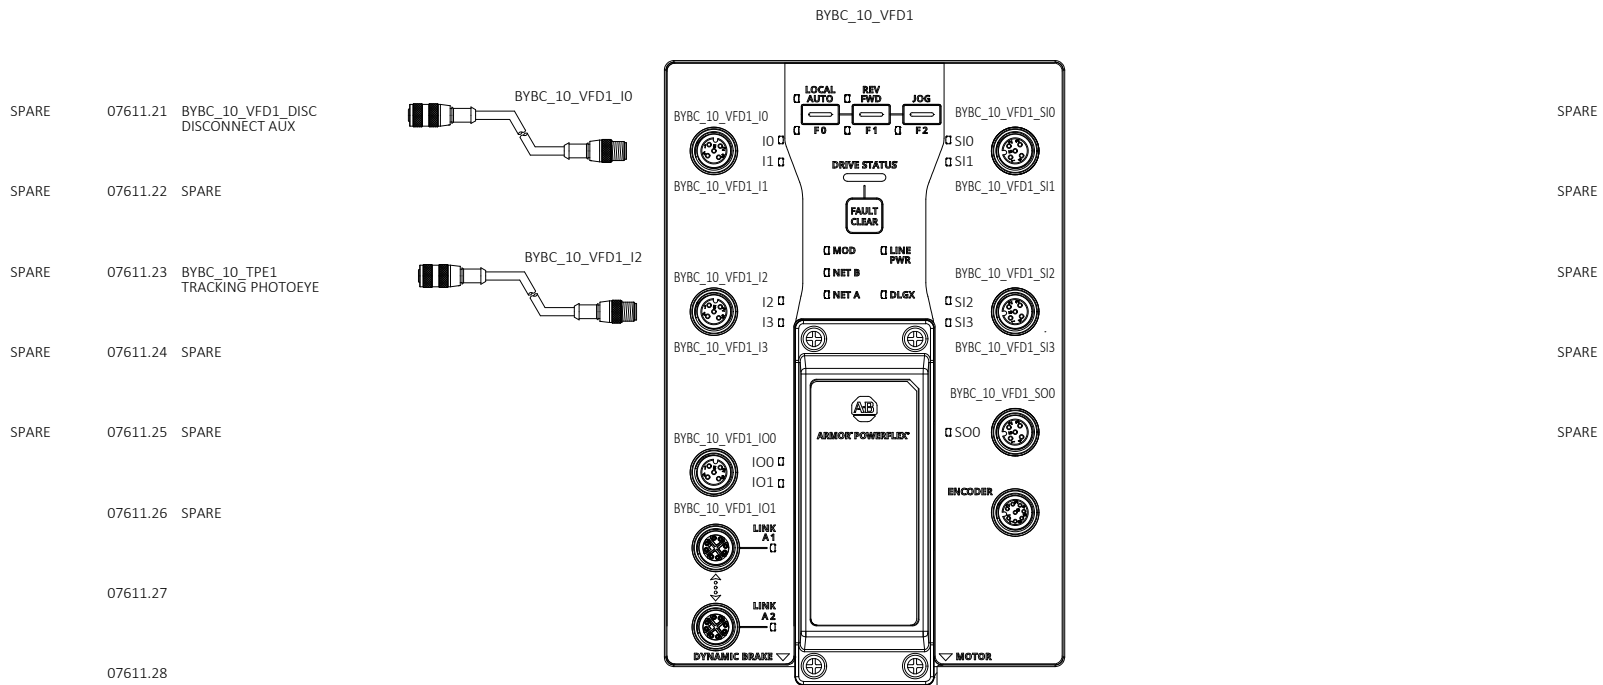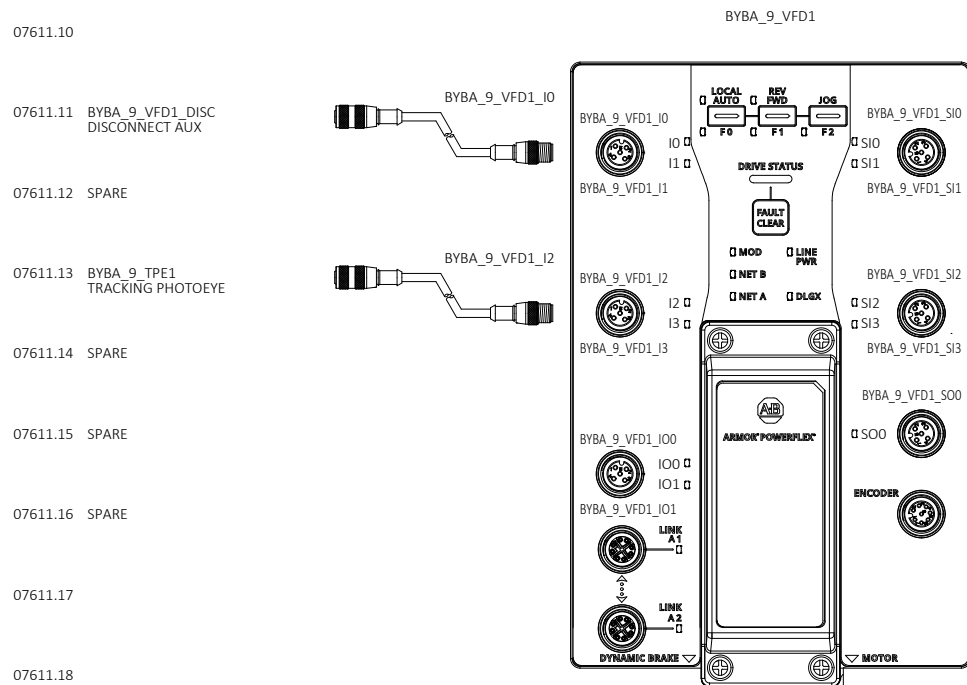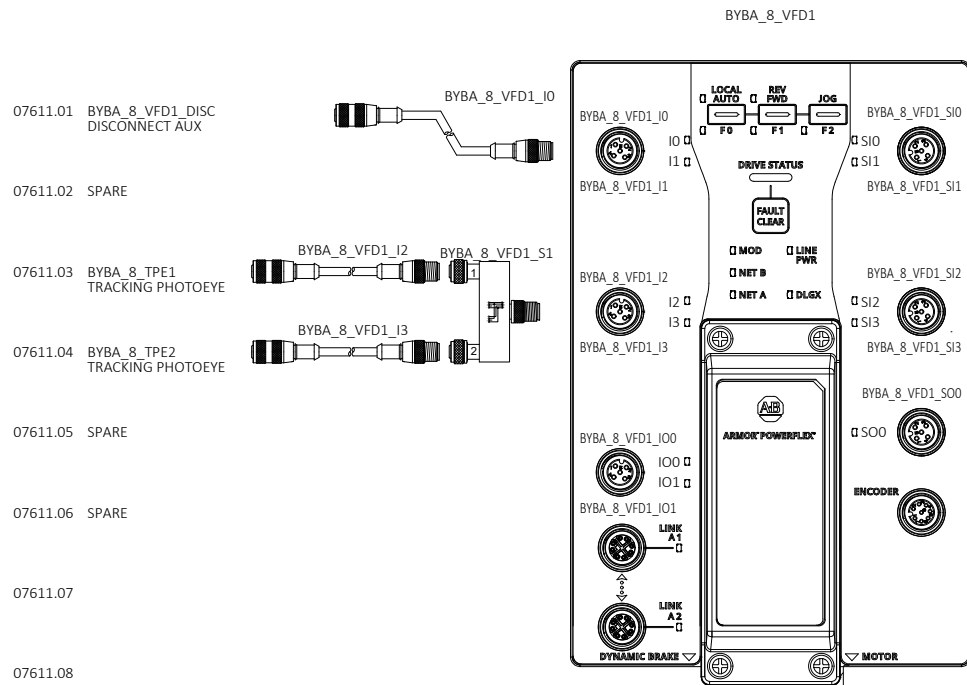

DRAWING REVISIONS			
REV	DESCRIPTION	DATE	BY
00	INITIAL DRAWINGS	04/25/2025	SK
01	ALARM HORN	06/23/2025	SN
A	AS-BUILT	11/13/2025	LB









25K Amazon Cross-Belt Sort Center (ACBSC) BYBA_8_VFD1/BYBA_9_VFD1 BYBC_10_VFD1/BYBC_2_VFD1 IO DRAWINGS AMAZON MTN6 SPARROWS POINT, MD	FILENAME	
	2429-AMZ-MTN6-MCM07-611	
	D-SIZE SCALE	JOB NUMBER:
	NTS	2429
	REVISION	SHEET
	A	63

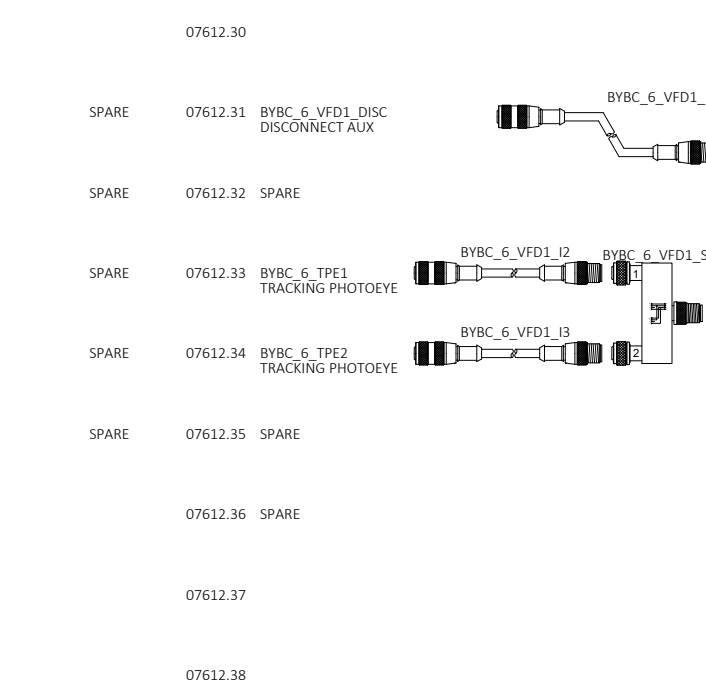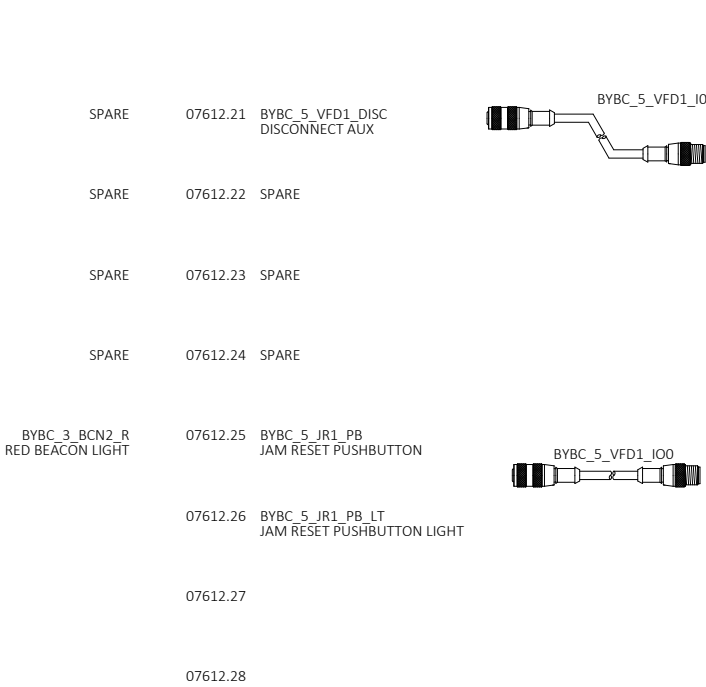


autStand
Automation Standard

CONFIDENTIAL: THE INFORMATION CONTAINED HEREIN IS PROPRIETARY INFORMATION OF AUTOMATION STANDARD LLC AND CONSTITUTES TRADE SECRETS PURSUANT TO THE UNIFORM TRADE SECRETS ACT. THIS INFORMATION SHALL ONLY BE USED IN THE PERFORMANCE OF CONTRACT WITH AUTOSTAND. THIS INFORMATION SHALL NOT BE USED, REPRODUCED OR EMPLOYED IN WHOLE PART EXCEPT WITH AUTOSTAND'S PRIOR WRITTEN APPROVAL.

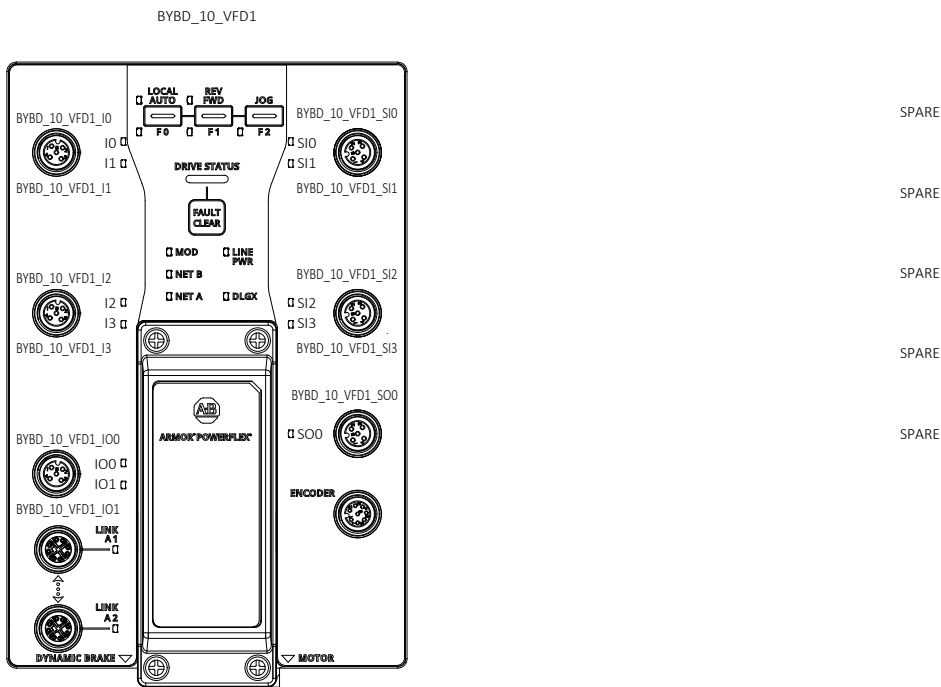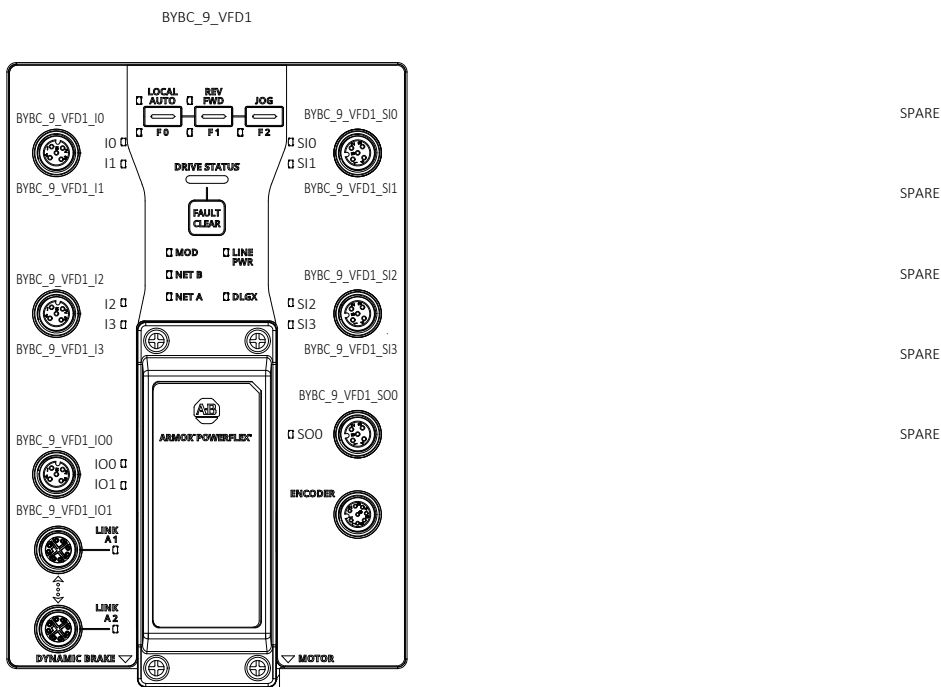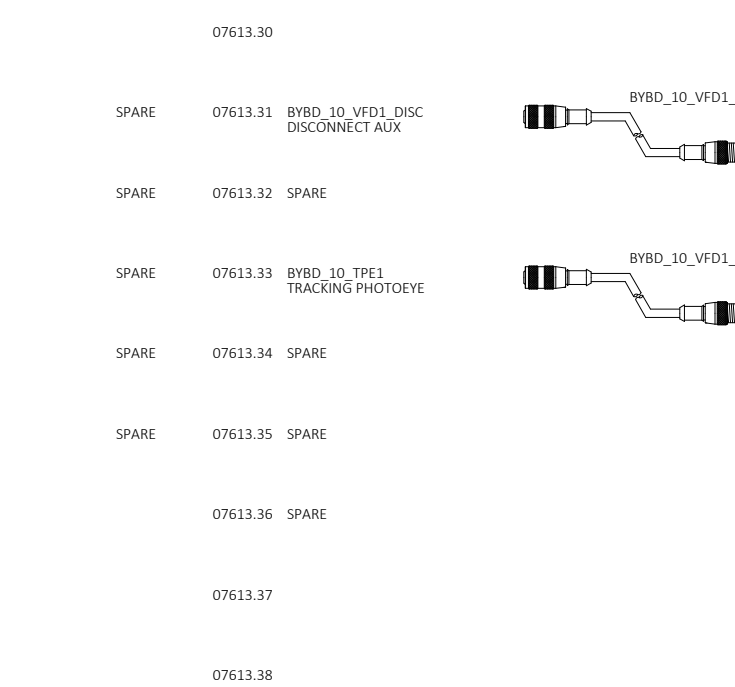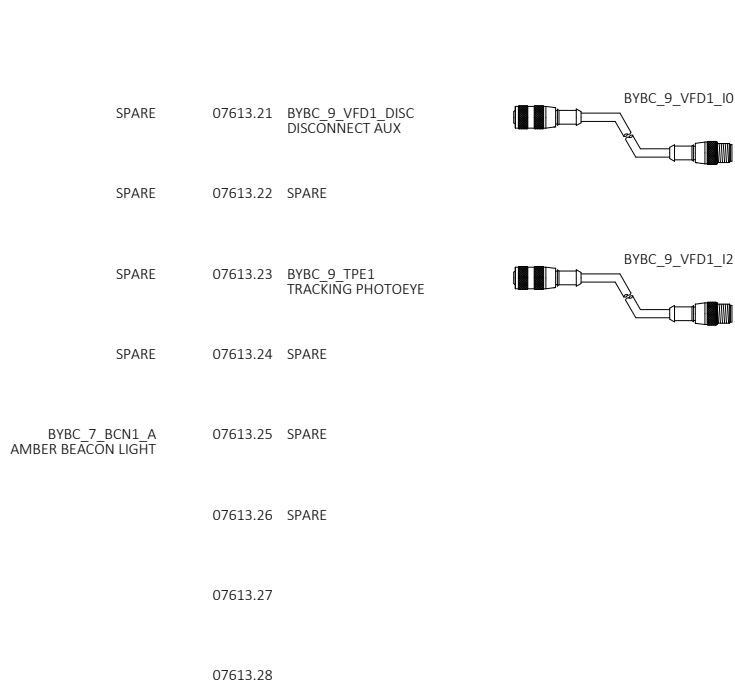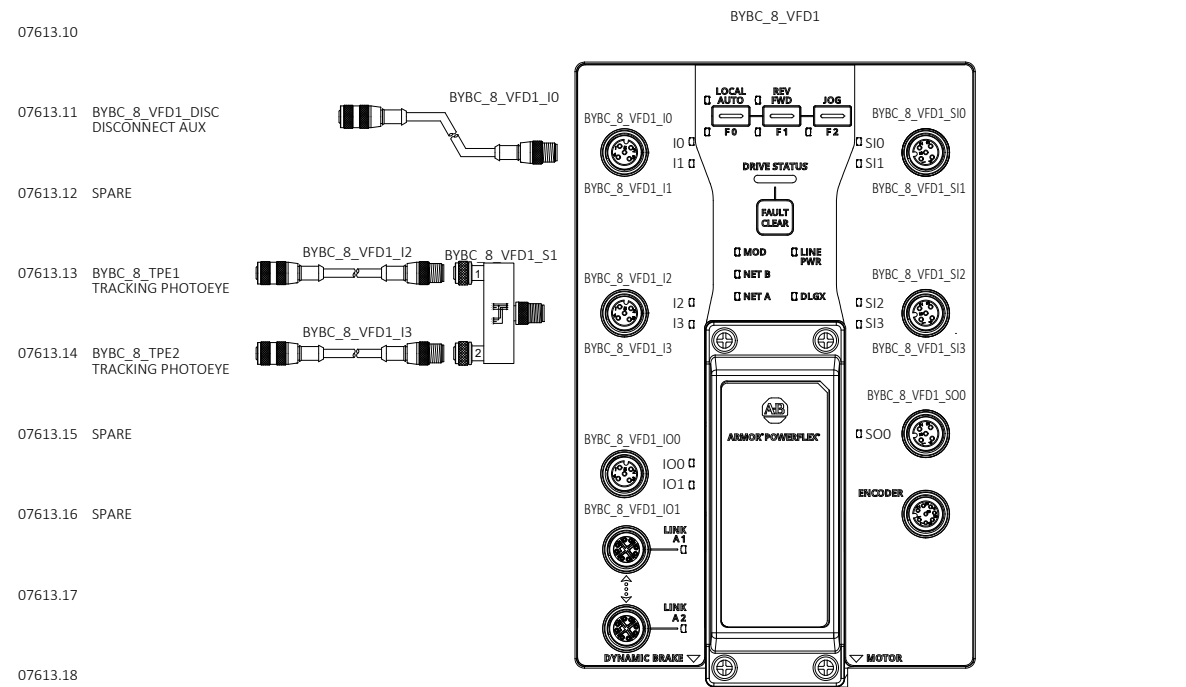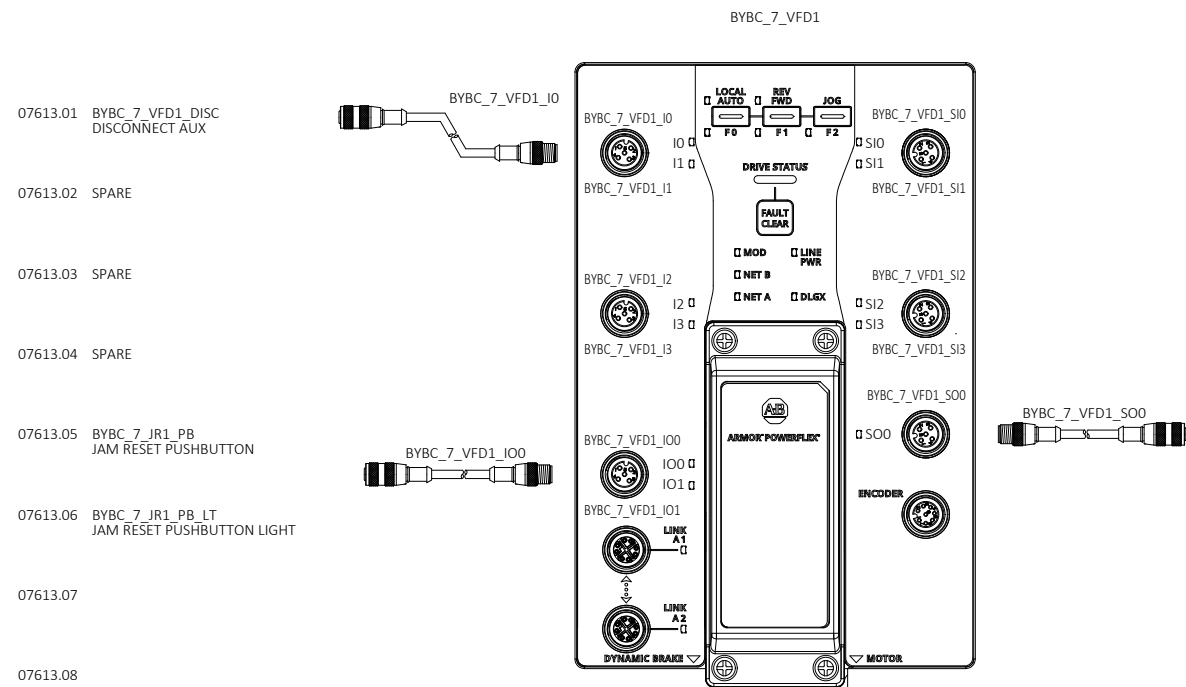

DRAWING REVISIONS			
REV	DESCRIPTION	DATE	BY
00	INITIAL DRAWINGS	04/25/2025	SK
01	ALARM HORN	06/23/2025	SN
A	AS-BUILT	11/13/2025	LB






 


autStand
Automation Standard

CONFIDENTIAL: THE INFORMATION CONTAINED HEREIN IS PROPRIETARY INFORMATION OF AUTOMATION STANDARD LLC AND CONSTITUTES TRADE SECRETS PURSUANT TO THE UNIFORM TRADE SECRETS ACT. THIS INFORMATION SHALL ONLY BE USED IN THE PERFORMANCE OF CONTRACT WITH AUTOSTAND. THIS INFORMATION SHALL NOT BE USED, REPRODUCED OR EMPLOYED IN WHOLE PART EXCEPT WITH AUTOSTAND'S PRIOR WRITTEN APPROVAL.

25K Amazon Cross-Belt Sort Center (ACBSC) BYBC_7_VFD1/BYBC_8_VFD1 BYBC_9_VFD1/BYBD_10_VFD1 IO DRAWINGS AMAZON MTN6 SPARROWS POINT, MD	FILENAME 2429-AMZ-MTN6-MCM07-613	
	D-SIZE SCALE NTS	JOB NUMBER: 2429
	REVISION A	SHEET 65

		BYBD_11_VFD1				BYBD_13_VFD1																																																		
07614.01	BYBD_11_VFD1_DISC DISCONNECT AUX			SPARE	07614.21	BYBD_13_VFD1_DISC DISCONNECT AUX			SPARE																																															
07614.02	SPARE			SPARE	07614.22	SPARE			SPARE																																															
07614.03	BYBD_12_TPE1 TRACKING PHOTOEYE			SPARE	07614.23	BYBD_13_TPE1 TRACKING PHOTOEYE			SPARE																																															
07614.04	SPARE			SPARE	07614.24	SPARE			SPARE																																															
07614.05	BYBD_11_JR1_PB JAM RESET PUSHBUTTON			BYBD_11_BCN1_A AMBER BEACON LIGHT	07614.25	SPARE			SPARE																																															
07614.06	BYBD_11_JR1_PB_LT JAM RESET PUSHBUTTON LIGHT				07614.26	SPARE																																																		
07614.07					07614.27																																																			
07614.08					07614.28																																																			
07614.09					07614.29																																																			
07614.10					07614.30																																																			
07614.11	BYBD_12_VFD1_DISC DISCONNECT AUX			SPARE	07614.31	BYBD_14_VFD1_DISC DISCONNECT AUX			SPARE																																															
07614.12	SPARE			SPARE	07614.32	SPARE			SPARE																																															
07614.13	BYBD_12_TPE2 TRACKING PHOTOEYE			SPARE	07614.33	BYBD_14_TPE1 TRACKING PHOTOEYE			SPARE																																															
07614.14	SPARE			SPARE	07614.34	SPARE			SPARE																																															
07614.15	SPARE			SPARE	07614.35	SPARE			SPARE																																															
07614.16	SPARE				07614.36	SPARE																																																		
07614.17					07614.37																																																			
07614.18					07614.38																																																			
07614.19					07614.39																																																			
07614.20					07614.40																																																			
<table><tr><th colspan="4">DRAWING REVISIONS</th></tr><tr><th>REV</th><th>DESCRIPTION</th><th>DATE</th><th>BY</th></tr><tr><td>00</td><td>INITIAL DRAWINGS</td><td>04/25/2025</td><td>SK</td></tr><tr><td>01</td><td>ALARM HORN</td><td>06/23/2025</td><td>SN</td></tr><tr><td>A</td><td>AS-BUILT</td><td>11/13/2025</td><td>LB</td></tr><tr><td> </td><td> </td><td> </td><td> </td></tr><tr><td> </td><td> </td><td> </td><td> </td></tr><tr><td> </td><td> </td><td> </td><td> </td></tr><tr><td> </td><td> </td><td> </td><td> </td></tr></table>		DRAWING REVISIONS				REV		DESCRIPTION	DATE	BY	00	INITIAL DRAWINGS	04/25/2025	SK	01	ALARM HORN	06/23/2025	SN	A	AS-BUILT	11/13/2025	LB																			25K Amazon Cross-Belt Sort Center (ACBSC) BYBD_11_VFD1/BYBD_12_VFD1 BYBD_13_VFD1/BYBD_14_VFD1 IO DRAWINGS AMAZON MTN6 SPARROWS POINT, MD		<table><tr><th colspan="2">FILENAME</th></tr><tr><td>2429-AMZ-MTN6-MCM07-614</td><td></td></tr><tr><th>D-SIZE SCALE</th><th>JOB NUMBER</th></tr><tr><td>NTS</td><td>2429</td></tr><tr><th>REVISION</th><th>SHEET</th></tr><tr><td>A</td><td>66</td></tr></table>		FILENAME		2429-AMZ-MTN6-MCM07-614		D-SIZE SCALE	JOB NUMBER	NTS	2429	REVISION	SHEET	A	66
DRAWING REVISIONS																																																								
REV	DESCRIPTION	DATE	BY																																																					
00	INITIAL DRAWINGS	04/25/2025	SK																																																					
01	ALARM HORN	06/23/2025	SN																																																					
A	AS-BUILT	11/13/2025	LB																																																					
FILENAME																																																								
2429-AMZ-MTN6-MCM07-614																																																								
D-SIZE SCALE	JOB NUMBER																																																							
NTS	2429																																																							
REVISION	SHEET																																																							
A	66																																																							

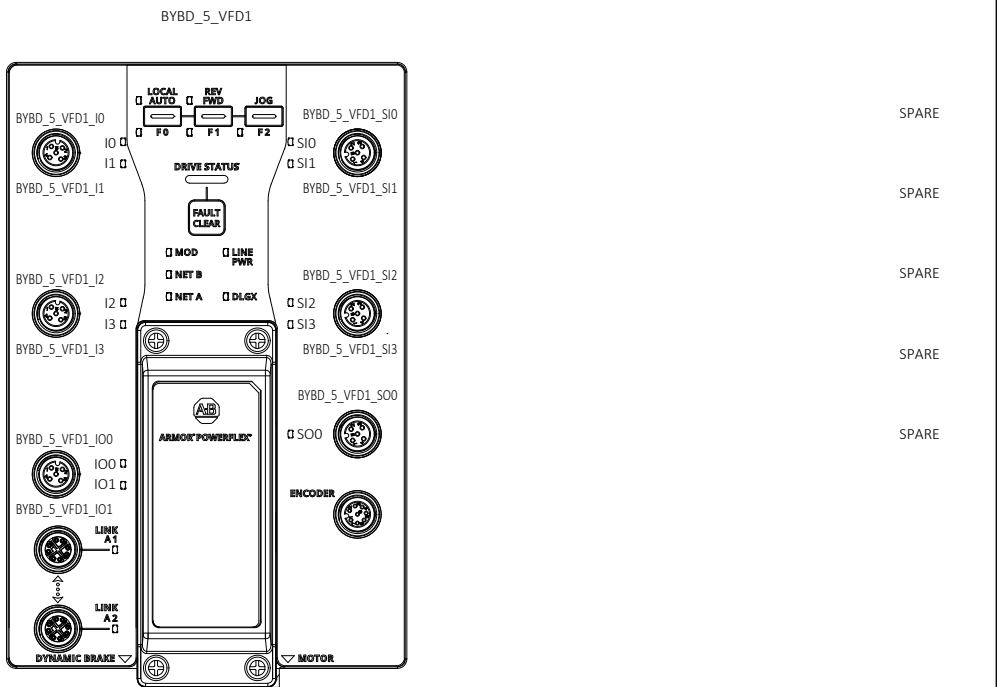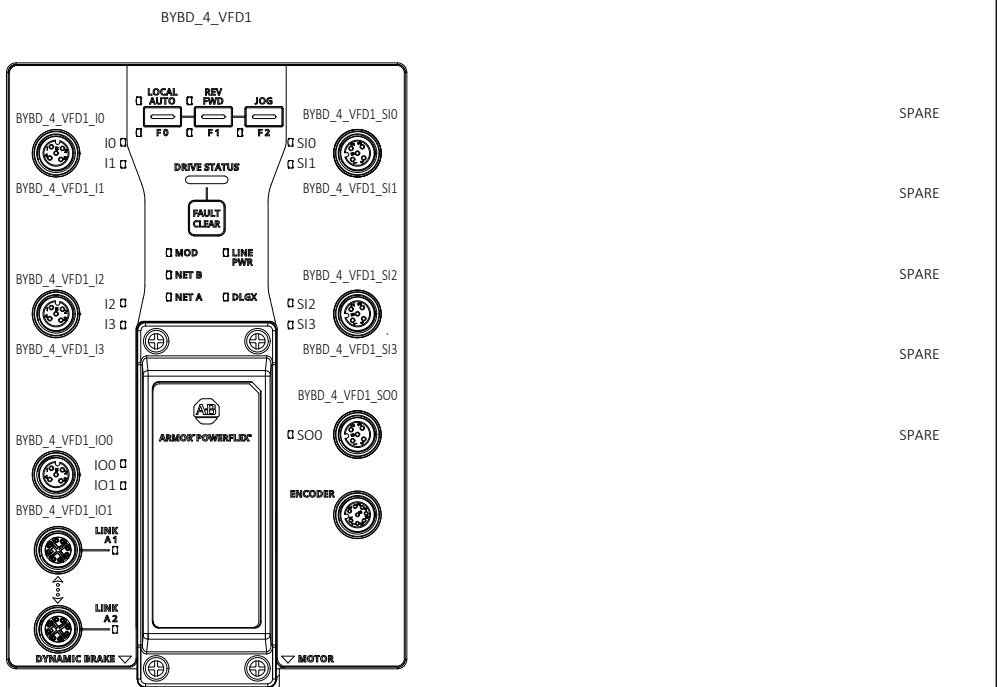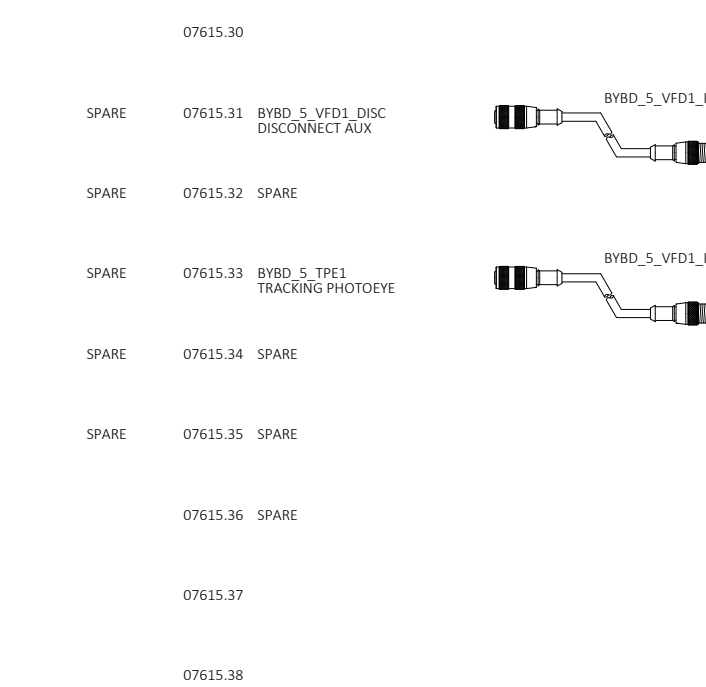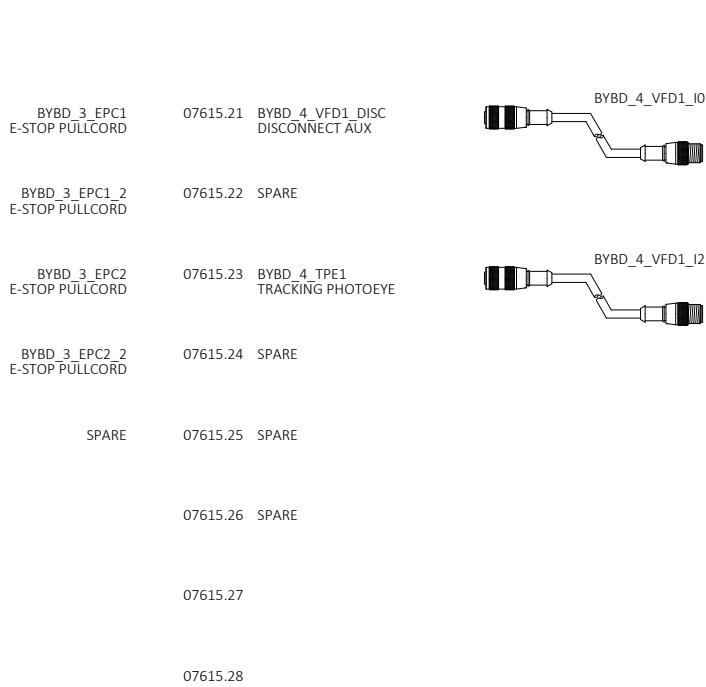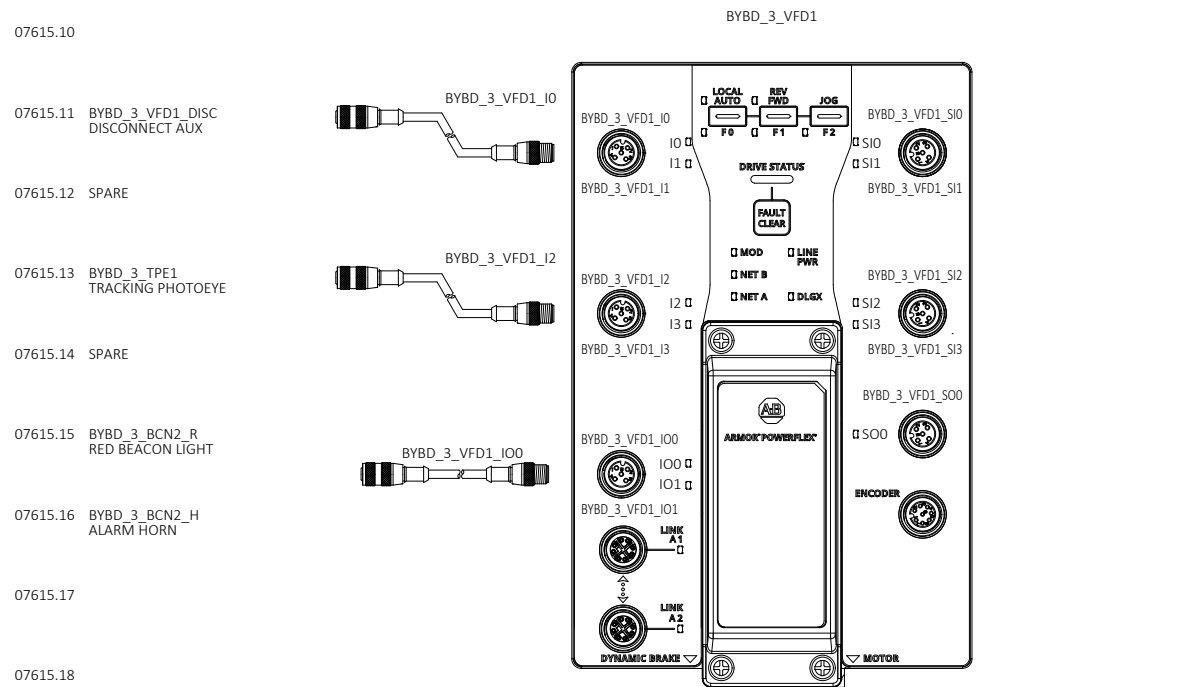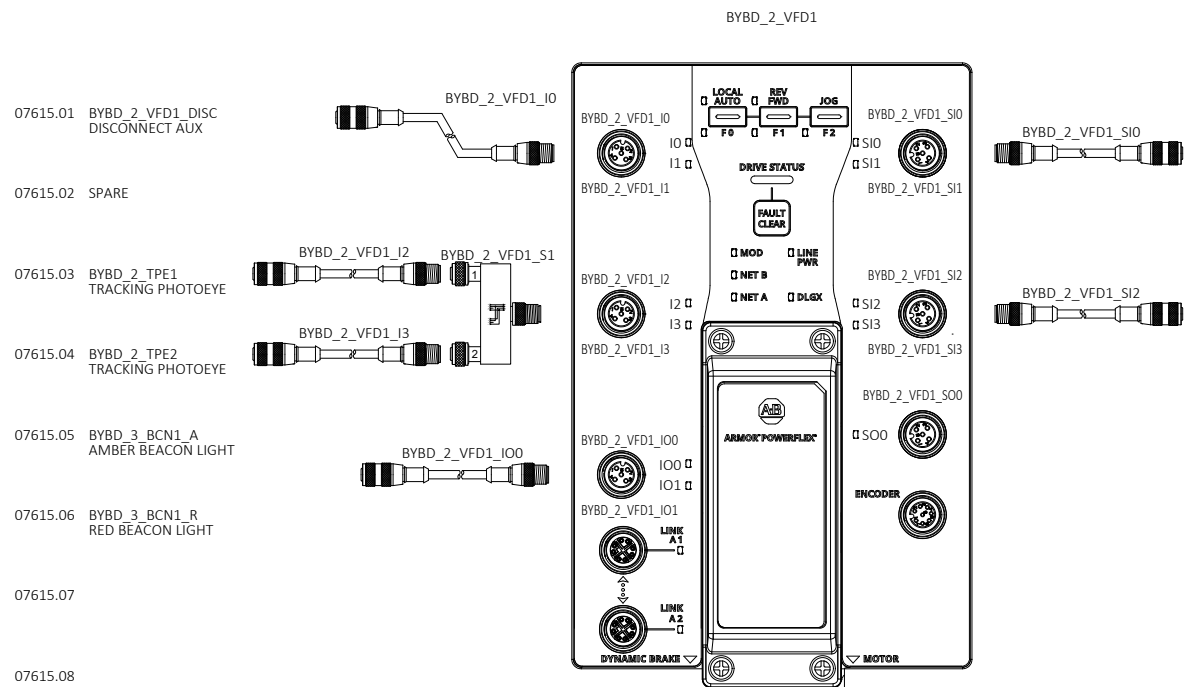





DRAWING REVISIONS			
REV	DESCRIPTION	DATE	BY
00	INITIAL DRAWINGS	04/25/2025	SK
01	ALARM HORN	06/23/2025	SN
A	AS-BUILT	11/13/2025	LB



autStand
Automation Standard

CONFIDENTIAL: THE INFORMATION CONTAINED HEREIN IS PROPRIETARY INFORMATION OF AUTOMATION STANDARD LLC AND CONSTITUTES TRADE SECRETS PURSUANT TO THE UNIFORM TRADE SECRETS ACT. THIS INFORMATION SHALL ONLY BE USED IN THE PERFORMANCE OF CONTRACT WITH AUTOSTAND. THIS INFORMATION SHALL NOT BE USED, REPRODUCED OR EMPLOYED IN WHOLE PART EXCEPT WITH AUTOSTAND'S PRIOR WRITTEN APPROVAL.

25K Amazon Cross-Belt Sort Center (ACBSC) BYBD_2_VFD1/BYBD_3_VFD1 BYBD_4_VFD1/BYBD_5_VFD1 IO DRAWINGS AMAZON MTN6 SPARROWS POINT, MD	FILENAME 2429-AMZ-MTN6-MCM07-615	
	D-SIZE SCALE NTS	JOB NUMBER: 2429
	REVISION A	SHEET 67

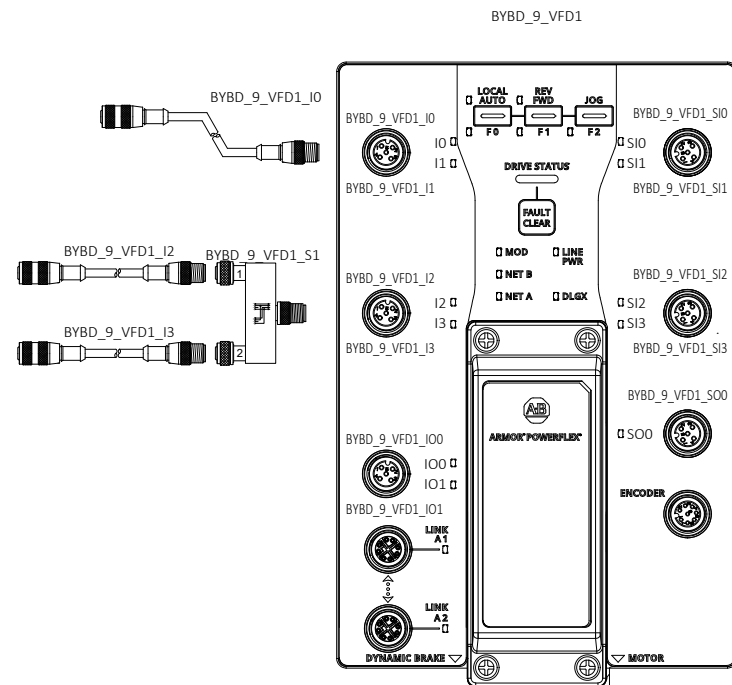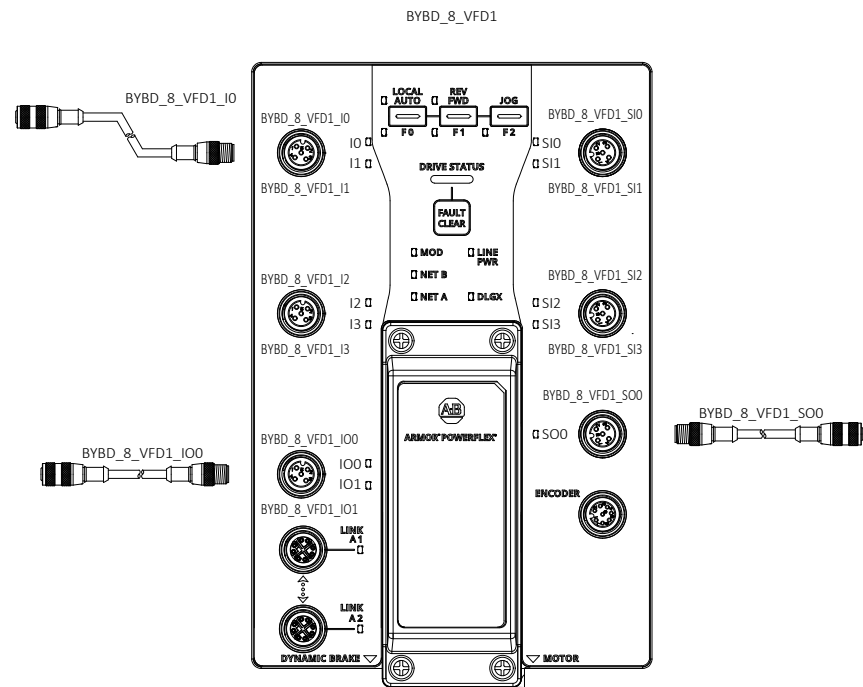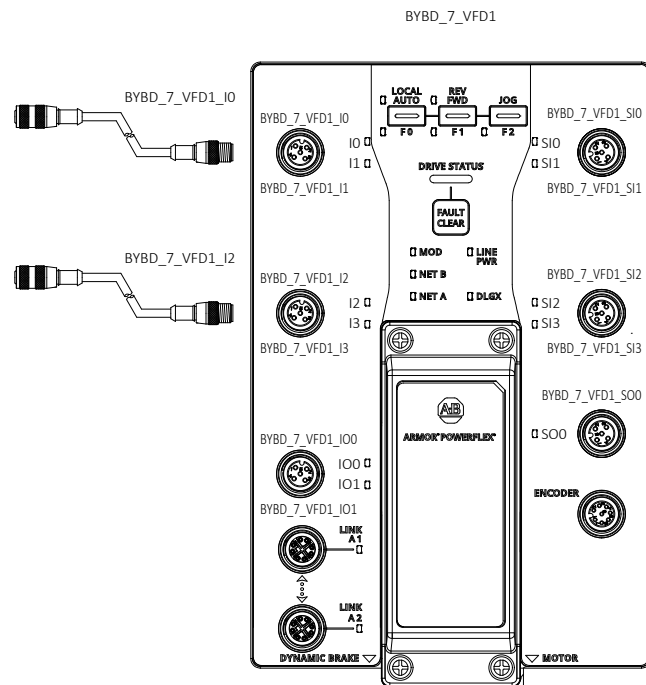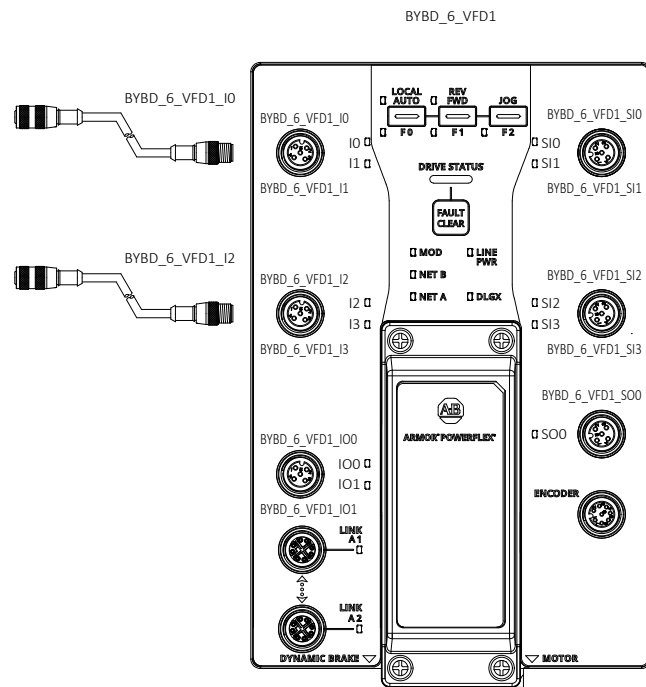





DRAWING REVISIONS			
REV	DESCRIPTION	DATE	BY
00	INITIAL DRAWINGS	04/25/2025	SK
01	ALARM HORN	06/23/2025	SN
A	AS-BUILT	11/13/2025	LB




Autostand
Automation Standard

CONFIDENTIAL: THE INFORMATION CONTAINED HEREIN IS PROPRIETARY INFORMATION OF AUTOMATION STANDARD LLC AND CONSTITUTES TRADE SECRETS PURSUANT TO THE UNIFORM TRADE SECRETS ACT. THIS INFORMATION SHALL ONLY BE USED IN THE PERFORMANCE OF CONTRACT WITH AUTOSTAND. THIS INFORMATION SHALL NOT BE USED, REPRODUCED OR EMPLOYED IN WHOLE PART EXCEPT WITH AUTOSTAND'S PRIOR WRITTEN APPROVAL.

25K Amazon Cross-Belt Sort Center (ACBSC) BYBD_6_VFD1/BYBD_7_VFD1 BYBD_8_VFD1/BYBD_9_VFD1 IO DRAWINGS	FILENAME 2429-AMZ-MTN6-MCM07-616	
	D-SIZE SCALE NTS	JOB NUMBER: 2429
	REVISION A	SHEET 68
	AMAZON MTN6 SPARROWS POINT, MD	

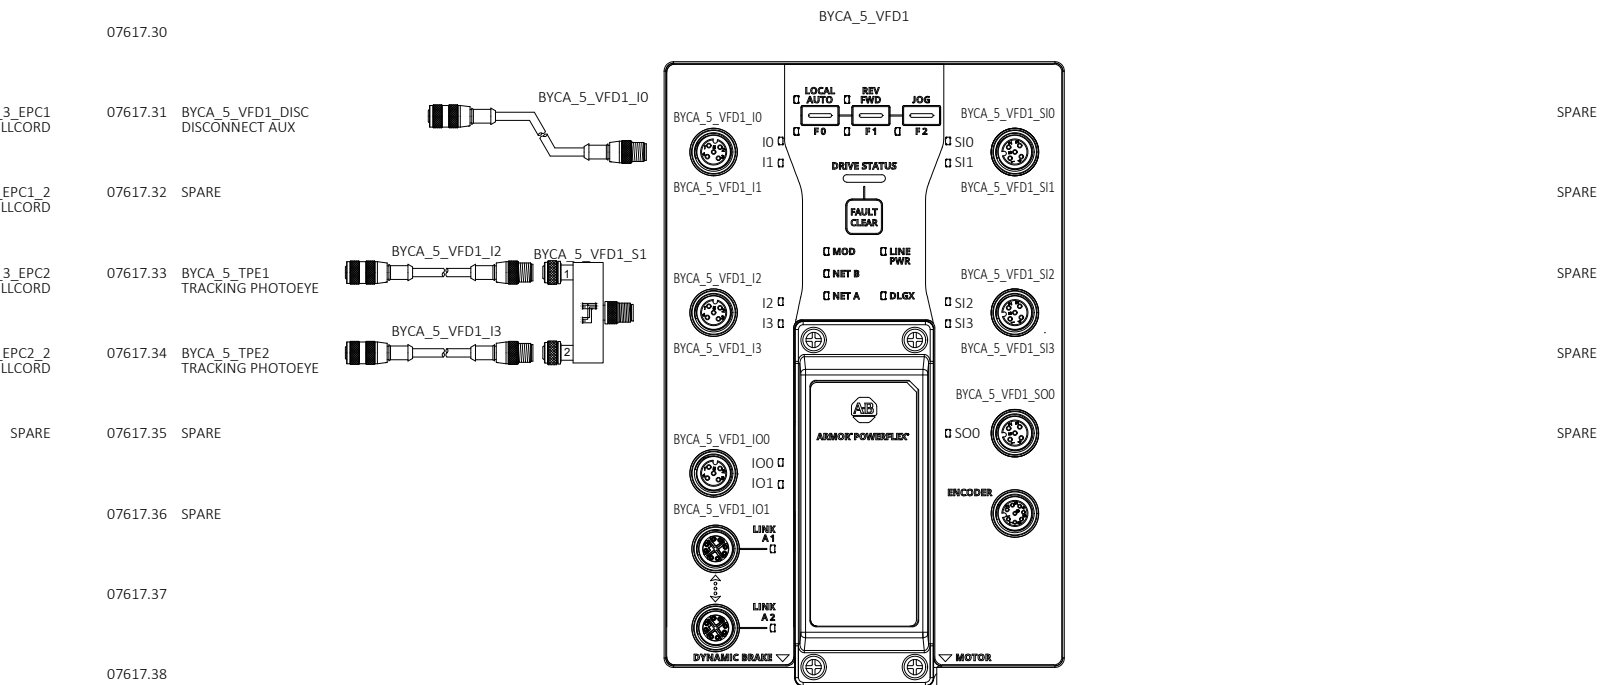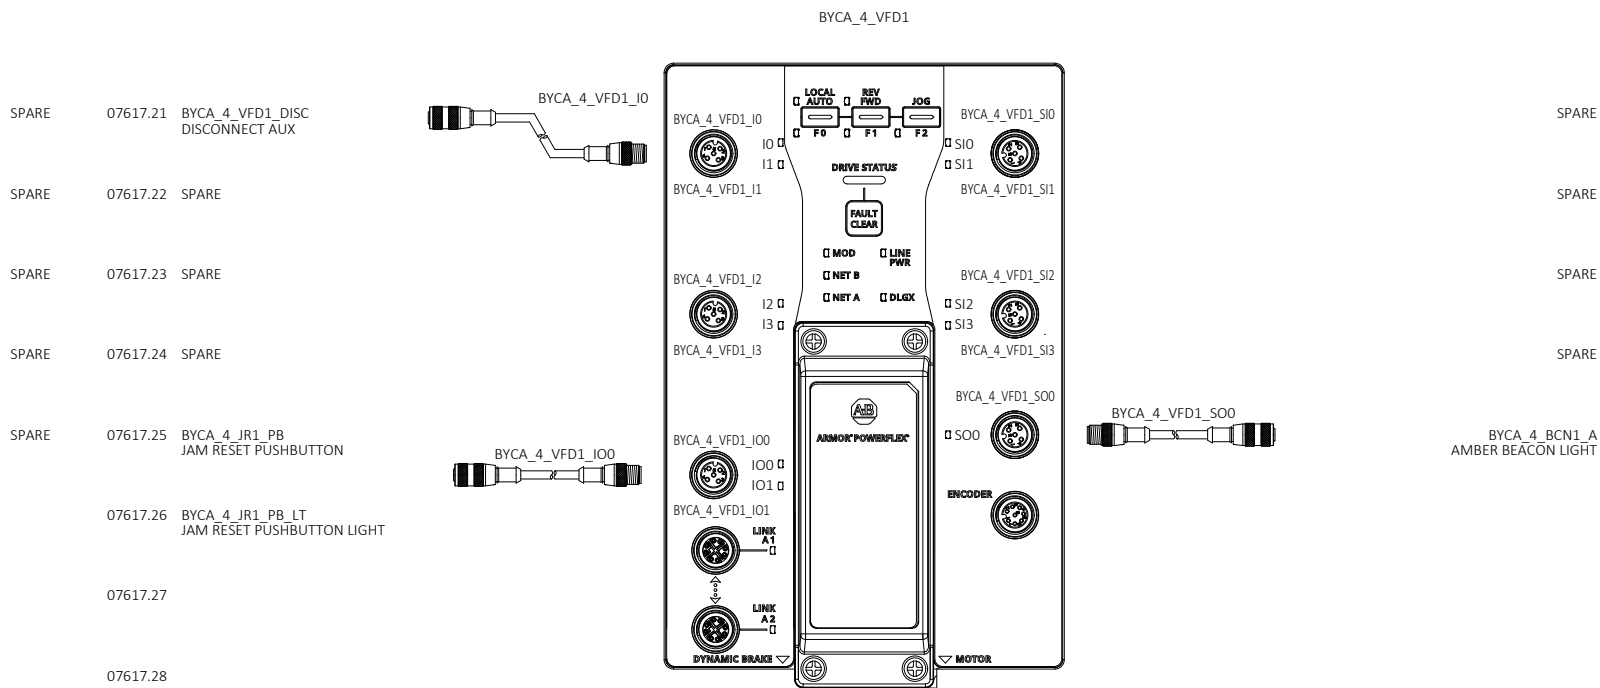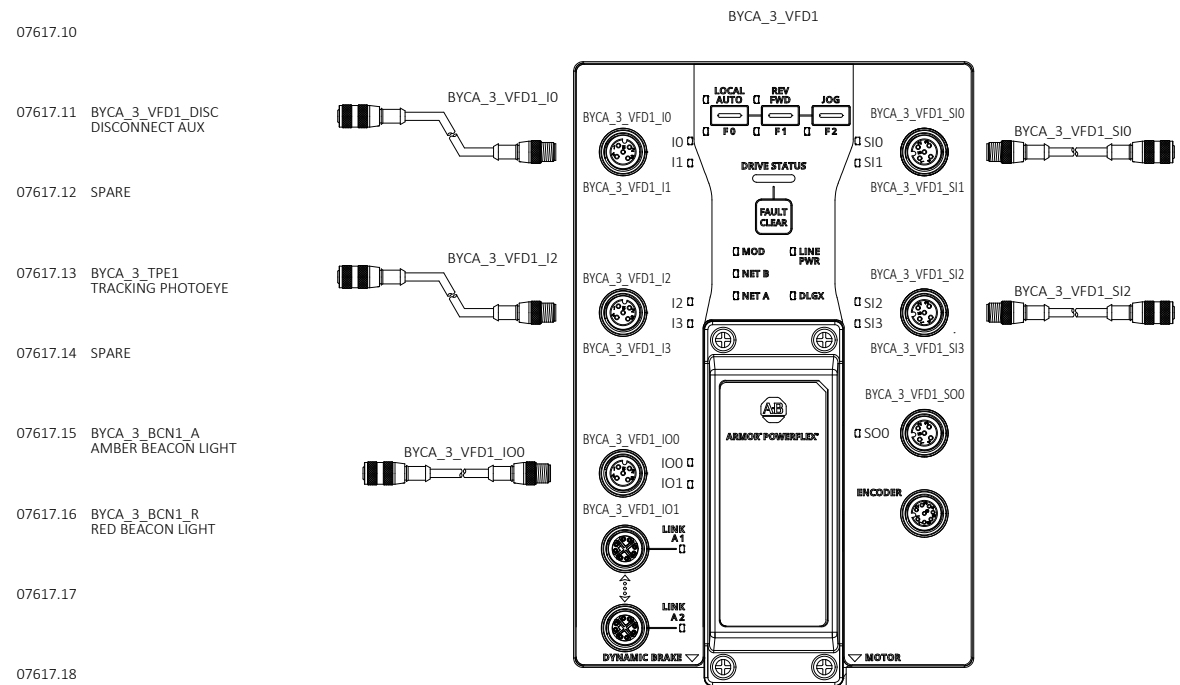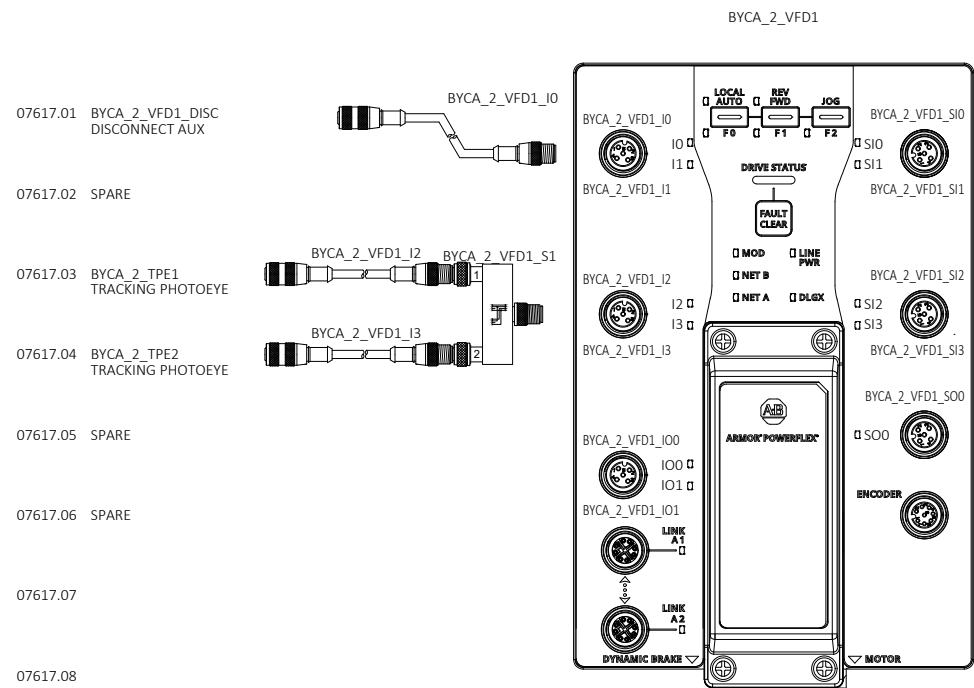

DRAWING REVISIONS			
REV	DESCRIPTION	DATE	BY
00	INITIAL DRAWINGS	04/25/2025	SK
01	ALARM HORN	06/23/2025	SN
A	AS-BUILT	11/13/2025	LB

 





autistand
Automation Standard

CONFIDENTIAL: THE INFORMATION CONTAINED HEREIN IS PROPRIETARY INFORMATION OF AUTOMATION STANDARD LLC AND CONSTITUTES TRADE SECRETS PURSUANT TO THE UNIFORM TRADE SECRETS ACT. THIS INFORMATION SHALL ONLY BE USED IN THE PERFORMANCE OF CONTRACT WITH AUTISTAND. THIS INFORMATION SHALL NOT BE USED, REPRODUCED OR EMPLOYED IN WHOLE PART, EXCEPT WITH AUTISTAND'S PRIOR WRITTEN APPROVAL.

25K Amazon Cross-Belt Sort Center (ACBSC) BYCA_2_VFD1/BYCA_3_VFD1 BYCA_4_VFD1/BYCA_5_VFD1 IO DRAWINGS AMAZON MTN6 SPARROWS POINT, MD	FILENAME 2429-AMZ-MTN6-MCM07-617	
	D-SIZE SCALE	JOB NUMBER:
	NTS	2429
	REVISION	SHEET
	A	69

				BYCA_6_VFD1								BYCA_8_VFD1																																																										
07618.01	BYCA_6_VFD1_DISC DISCONNECT AUX							SPARE	07618.21	BYCA_8_VFD1_DISC DISCONNECT AUX							SPARE																																																					
07618.02	SPARE							SPARE	07618.22	SPARE							SPARE																																																					
07618.03	BYCA_6_TPE1 TRACKING PHOTOEYE							SPARE	07618.23	SPARE							SPARE																																																					
07618.04	SPARE							SPARE	07618.24	SPARE							SPARE																																																					
07618.05	BYCA_9_S2_PB START PUSHBUTTON							SPARE	07618.25	BYCA_8_JR1_PB JAM RESET PUSHBUTTON							BYCA_8_BCN1_A AMBER BEACON LIGHT																																																					
07618.06	BYCA_9_S2_PB_LT START PUSHBUTTON LIGHT							07618.26	BYCA_8_JR1_PB_LT JAM RESET PUSHBUTTON LIGHT																																																													
07618.07								07618.27																																																														
07618.08								07618.28																																																														
07618.09								07618.29																																																														
07618.10				BYCA_7_VFD1				07618.30				BYCA_9_VFD1																																																										
07618.11	BYCA_7_VFD1_DISC DISCONNECT AUX							SPARE	07618.31	BYCA_9_VFD1_DISC DISCONNECT AUX							BYCA_9_EPC1 E-STOP PULLCORD																																																					
07618.12	SPARE							SPARE	07618.32	SPARE							BYCA_9_EPC1_2 E-STOP PULLCORD																																																					
07618.13	BYCA_7_TPE1 TRACKING PHOTOEYE							SPARE	07618.33	BYCA_9_TPE1 TRACKING PHOTOEYE							BYCA_9_EPC2 E-STOP PULLCORD																																																					
07618.14	SPARE							SPARE	07618.34	BYCA_9_TPE2 TRACKING PHOTOEYE							BYCA_9_EPC2_2 E-STOP PULLCORD																																																					
07618.15	BYCA_9_S1_PB START PUSHBUTTON							BYCA_9_BCN2_R RED BEACON LIGHT	07618.35	SPARE							BYCA_9_BCN1_R RED BEACON LIGHT																																																					
07618.16	BYCA_9_S1_PB_LT START PUSHBUTTON LIGHT							07618.36	SPARE																																																													
07618.17								07618.37																																																														
07618.18								07618.38																																																														
07618.19								07618.39																																																														
07618.20								07618.40																																																														
<table><tr><th colspan="4">DRAWING REVISIONS</th></tr><tr><th>REV</th><th>DESCRIPTION</th><th>DATE</th><th>BY</th></tr><tr><td>00</td><td>INITIAL DRAWINGS</td><td>04/25/2025</td><td>SK</td></tr><tr><td>01</td><td>ALARM HORN</td><td>06/23/2025</td><td>SN</td></tr><tr><td>A</td><td>AS-BUILT</td><td>11/13/2025</td><td>LB</td></tr><tr><td> </td><td> </td><td> </td><td> </td></tr><tr><td> </td><td> </td><td> </td><td> </td></tr><tr><td> </td><td> </td><td> </td><td> </td></tr><tr><td> </td><td> </td><td> </td><td> </td></tr></table>				DRAWING REVISIONS				REV				DESCRIPTION	DATE	BY	00	INITIAL DRAWINGS				04/25/2025	SK	01	ALARM HORN	06/23/2025	SN	A	AS-BUILT	11/13/2025	LB																									25K Amazon Cross-Belt Sort Center (ACBSC) BYCA_6_VFD1/BYCA_7_VFD1 BYCA_8_VFD1/BYCA_9_VFD1 IO DRAWINGS				<table><tr><th colspan="2">FILENAME</th></tr><tr><td colspan="2">2429-AMZ-MTN6-MCM07-618</td></tr><tr><th>D-SIZE SCALE</th><th>JOB NUMBER</th></tr><tr><td>NTS</td><td>2429</td></tr><tr><th>REVISION</th><th>SHEET</th></tr><tr><td>A</td><td>70</td></tr></table>				FILENAME		2429-AMZ-MTN6-MCM07-618		D-SIZE SCALE	JOB NUMBER	NTS	2429	REVISION
DRAWING REVISIONS																																																																						
REV	DESCRIPTION	DATE	BY																																																																			
00	INITIAL DRAWINGS	04/25/2025	SK																																																																			
01	ALARM HORN	06/23/2025	SN																																																																			
A	AS-BUILT	11/13/2025	LB																																																																			
FILENAME																																																																						
2429-AMZ-MTN6-MCM07-618																																																																						
D-SIZE SCALE	JOB NUMBER																																																																					
NTS	2429																																																																					
REVISION	SHEET																																																																					
A	70																																																																					
CONFIDENTIAL: THE INFORMATION CONTAINED HEREIN IS PROPRIETARY INFORMATION OF AUTOMATION STANDARD LLC AND CONSTITUTES TRADE SECRETS PURSUANT TO THE UNIFORM TRADE SECRETS ACT. THIS INFORMATION SHALL ONLY BE USED IN THE PERFORMANCE OF CONTRACT WITH AUTISTAND. THIS INFORMATION SHALL NOT BE USED, REPRODUCED OR EMPLOYED IN WHOLE PART, EXCEPT WITH AUTISTAND'S PRIOR WRITTEN APPROVAL.								AMAZON MTN6 SPARROWS POINT, MD																																																														

11/21/2025 6:28 PM

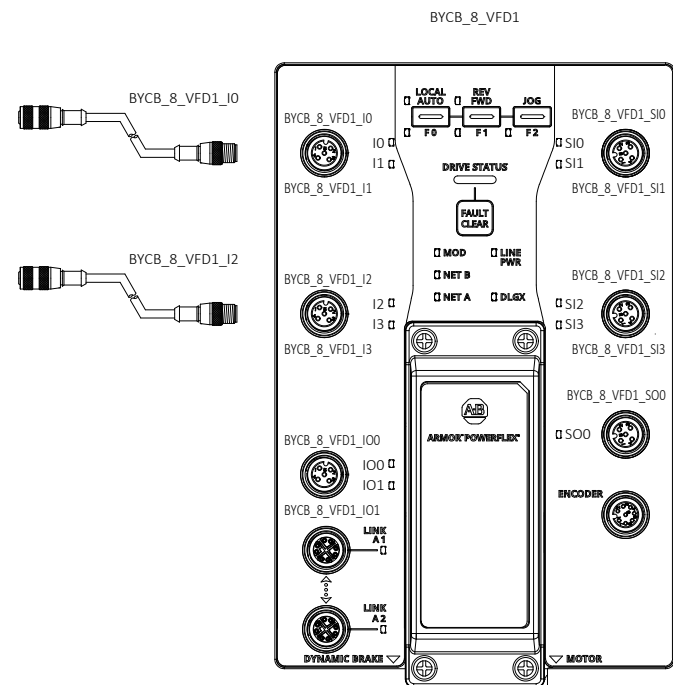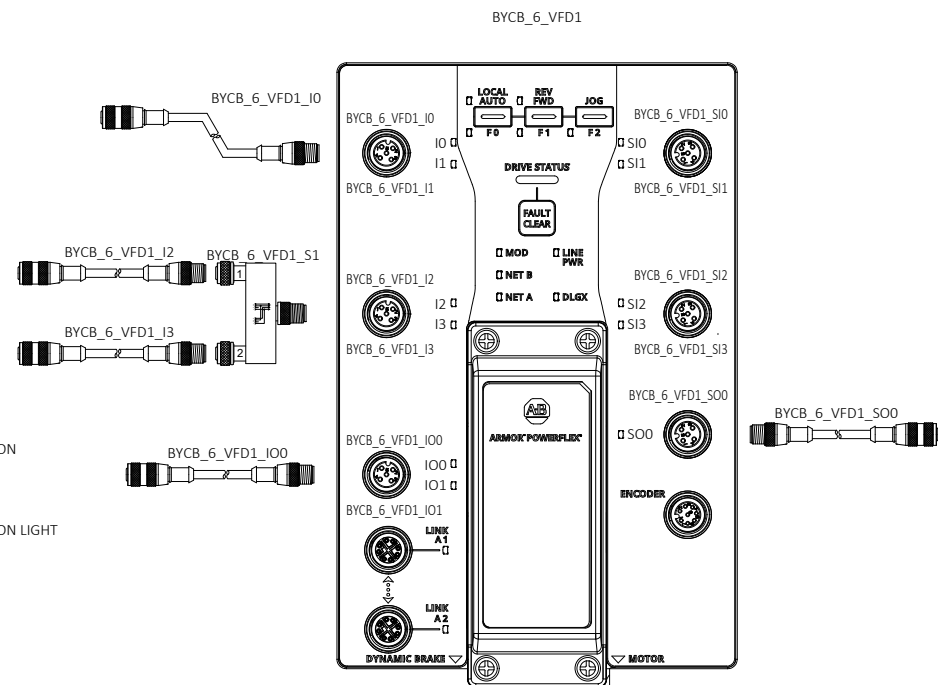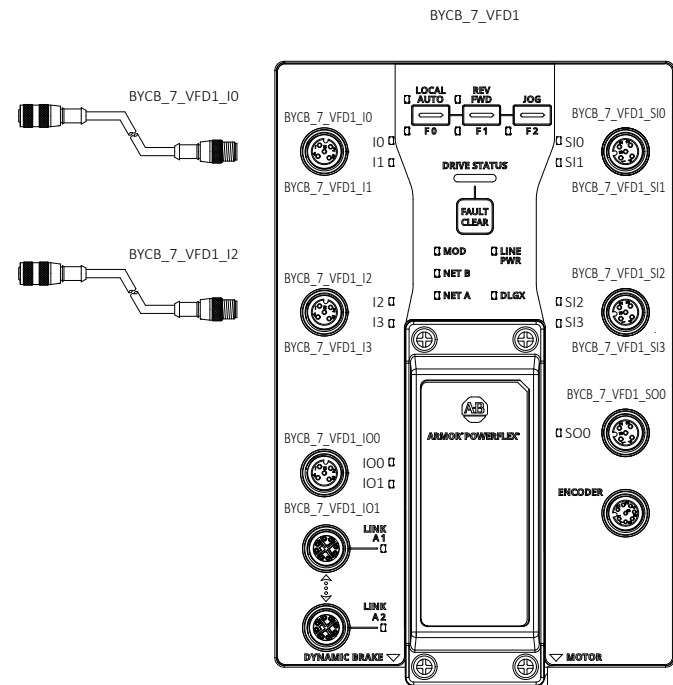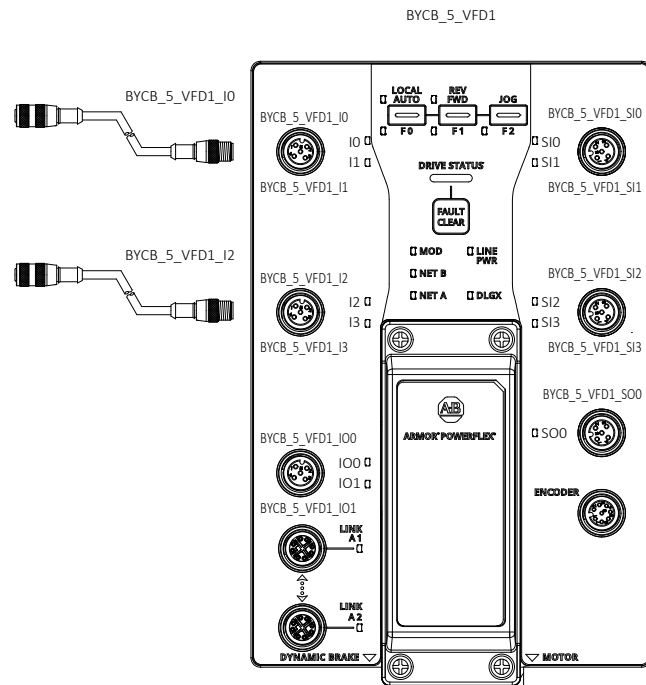









DRAWING REVISIONS			
REV	DESCRIPTION	DATE	BY
00	INITIAL DRAWINGS	04/25/2025	SK
01	ALARM HORN	06/23/2025	SN
A	AS-BUILT	11/13/2025	LB



Autostand
Automation Standard

CONFIDENTIAL: THE INFORMATION CONTAINED HEREIN IS PROPRIETARY INFORMATION OF AUTOMATION STANDARD LLC AND CONSTITUTES TRADE SECRETS PURSUANT TO THE UNIFORM TRADE SECRETS ACT. THIS INFORMATION SHALL ONLY BE USED IN THE PERFORMANCE OF CONTRACT WITH AUTOSTAND. THIS INFORMATION SHALL NOT BE USED, REPRODUCED OR EMPLOYED IN WHOLE PART EXCEPT WITH AUTOSTAND'S PRIOR WRITTEN APPROVAL.

25K Amazon Cross-Belt Sort Center (ACBSC) BYCB_5_VFD1/BYCB_6_VFD1 BYCB_7_VFD1/BYCB_8_VFD1 IO DRAWINGS AMAZON MTN6 SPARROWS POINT, MD	FILENAME 2429-AMZ-MTN6-MCM07-620	
	D-SIZE SCALE NTS	JOB NUMBER: 2429
	REVISION A	SHEET 72

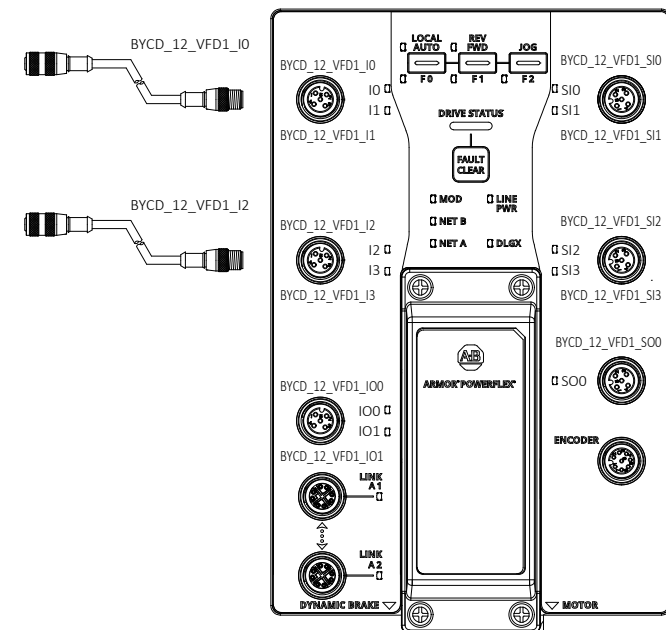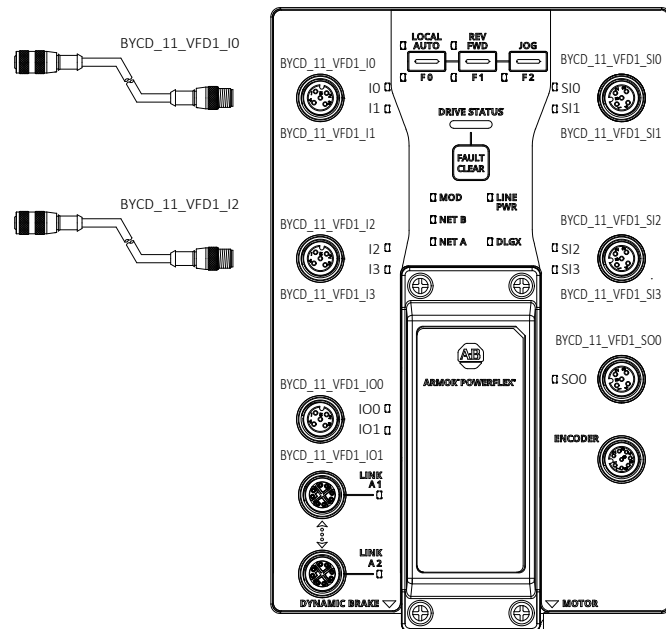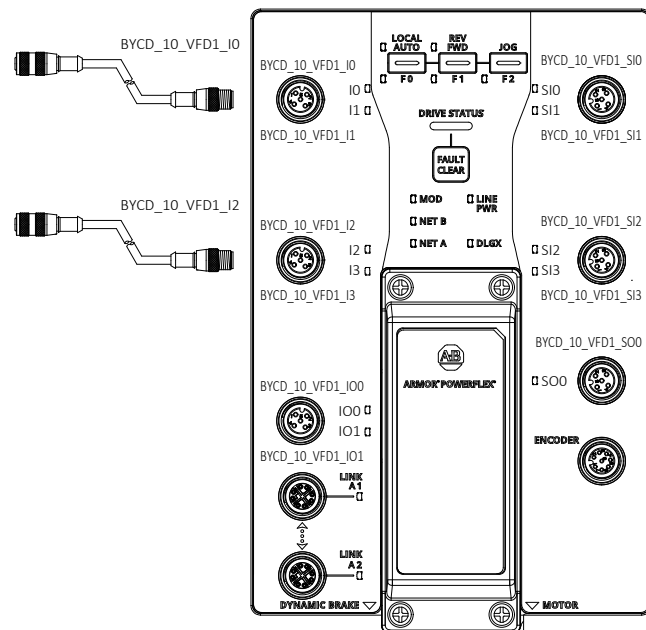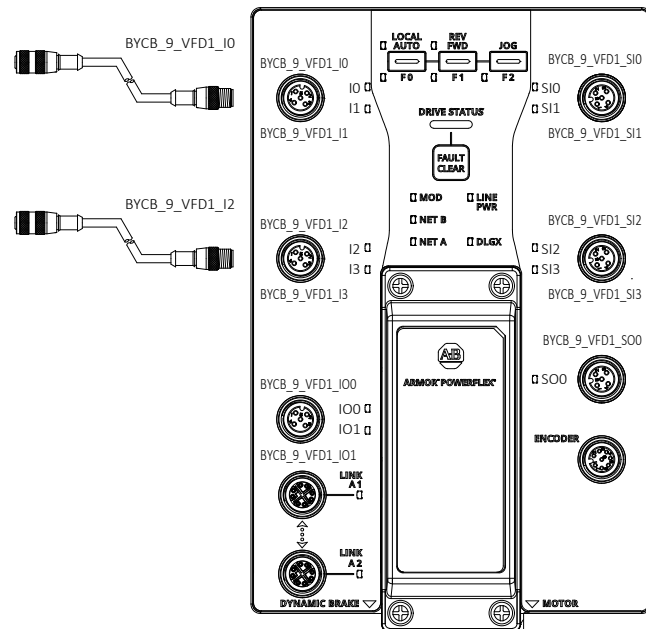    

DRAWING REVISIONS				
REV	DESCRIPTION	DATE	BY	
00	INITIAL DRAWINGS	04/25/2025	SK	
01	ALARM HORN	06/23/2025	SN	
A	AS-BUILT	11/13/2025	LB	







CONFIDENTIAL: THE INFORMATION CONTAINED HEREIN IS PROPRIETARY INFORMATION OF AUTOMATION STANDARD LLC AND CONSTITUTES TRADE SECRETS PURSUANT TO THE UNIFORM TRADE SECRETS ACT. THIS INFORMATION SHALL ONLY BE USED IN THE PERFORMANCE OF CONTRACT WITH AUTISTAND. THIS INFORMATION SHALL NOT BE USED, REPRODUCED OR EMPLOYED IN WHOLE PART EXCEPT WITH AUTSTANDARD'S PRIOR WRITTEN APPROVAL.

25K Amazon Cross-Belt Sort Center (ACBSC)
BYCB_9_VFD1/BYCD_10_VFD1
BYCD_11_VFD1/BYCD_12_VFD1 IO DRAWINGS

AMAZON MTN6
SPARROWS POINT, MD

FILENAME	
2429-AMZ-MTN6-MCM07-621	
D-SIZE SCALE	JOB NUMBER:
NTS	2429
REVISION	SHEET
A	73

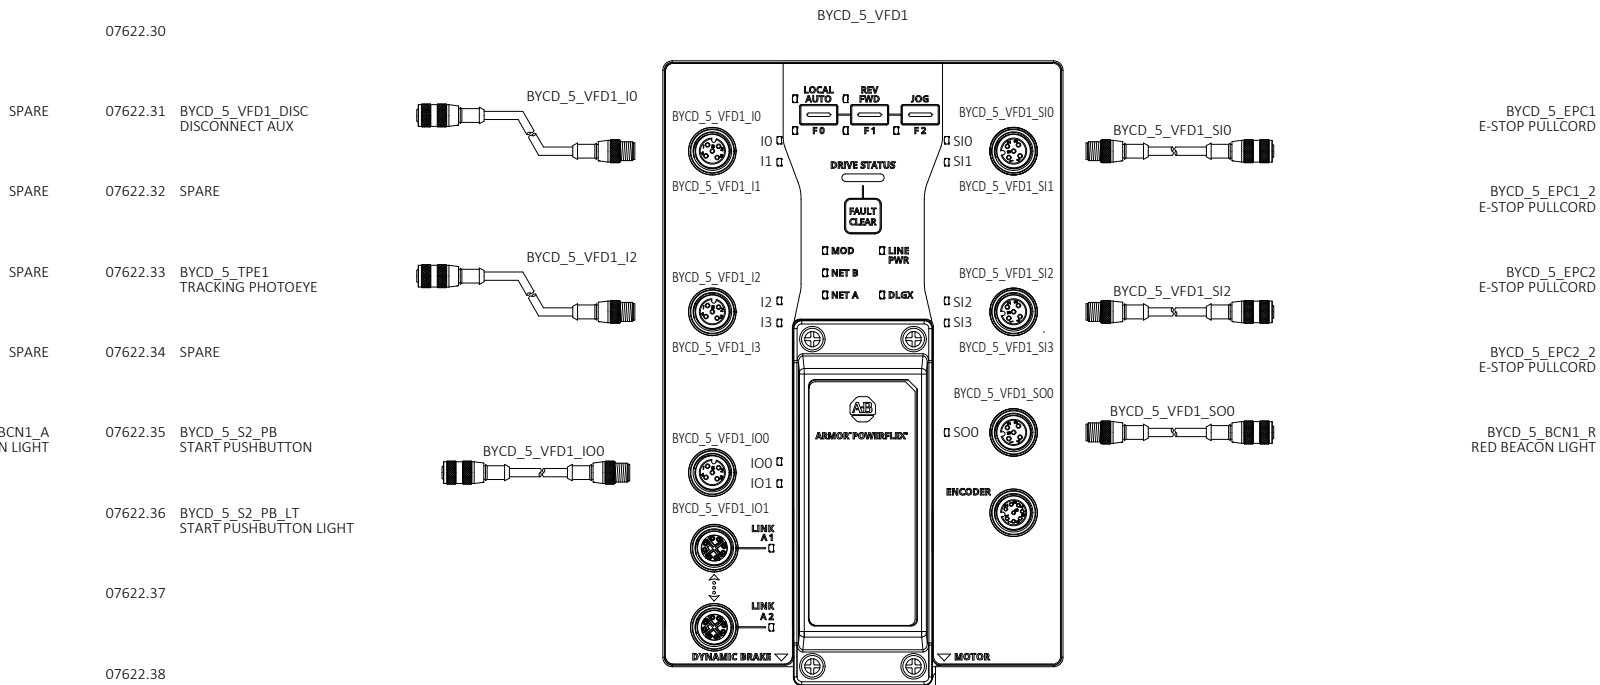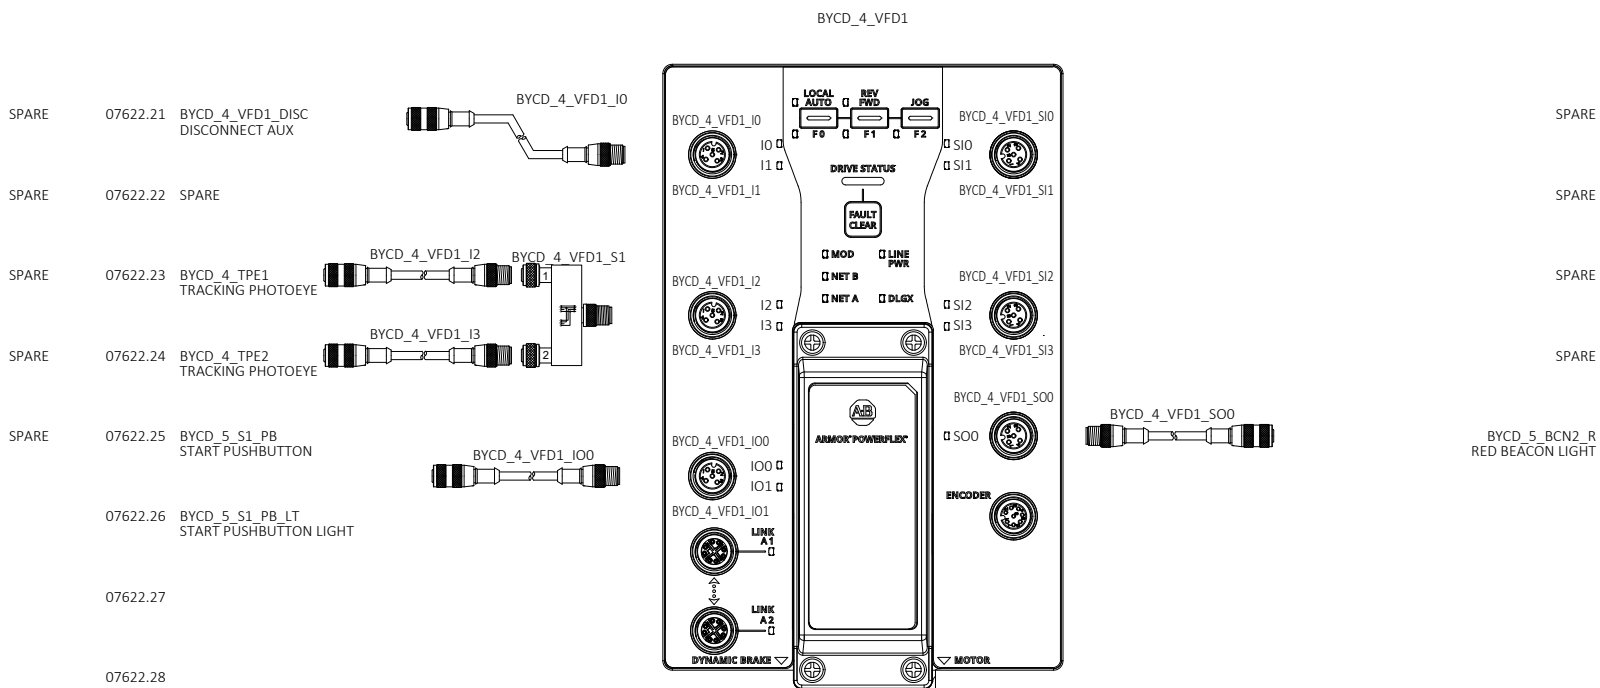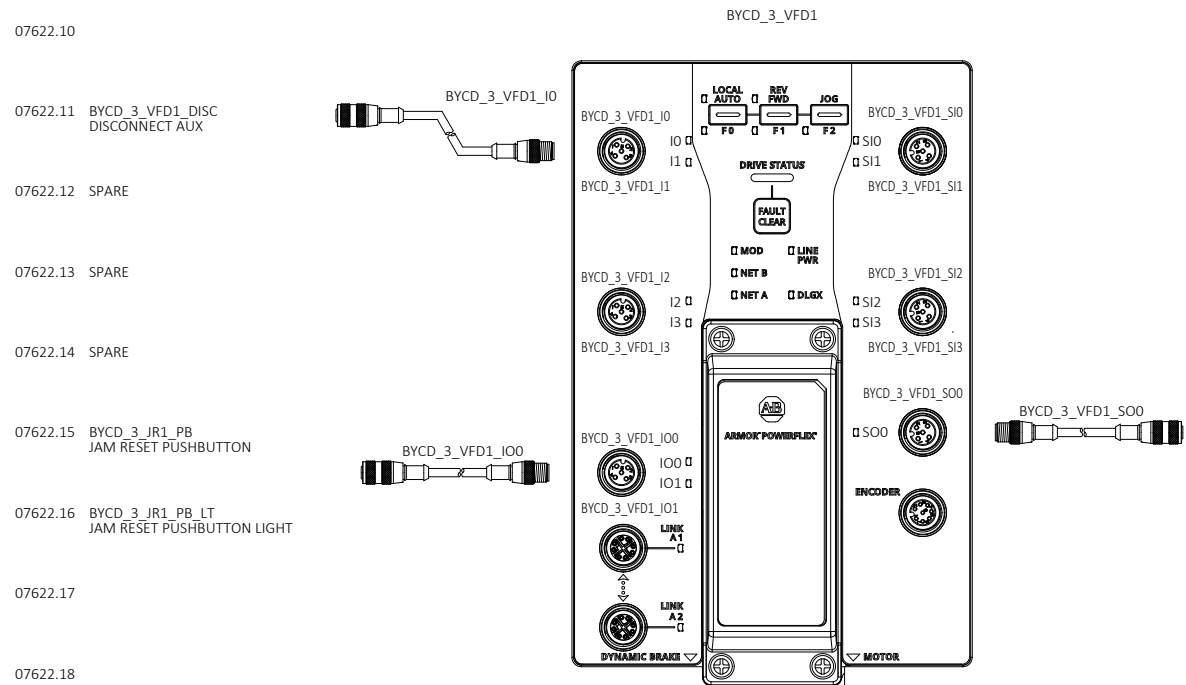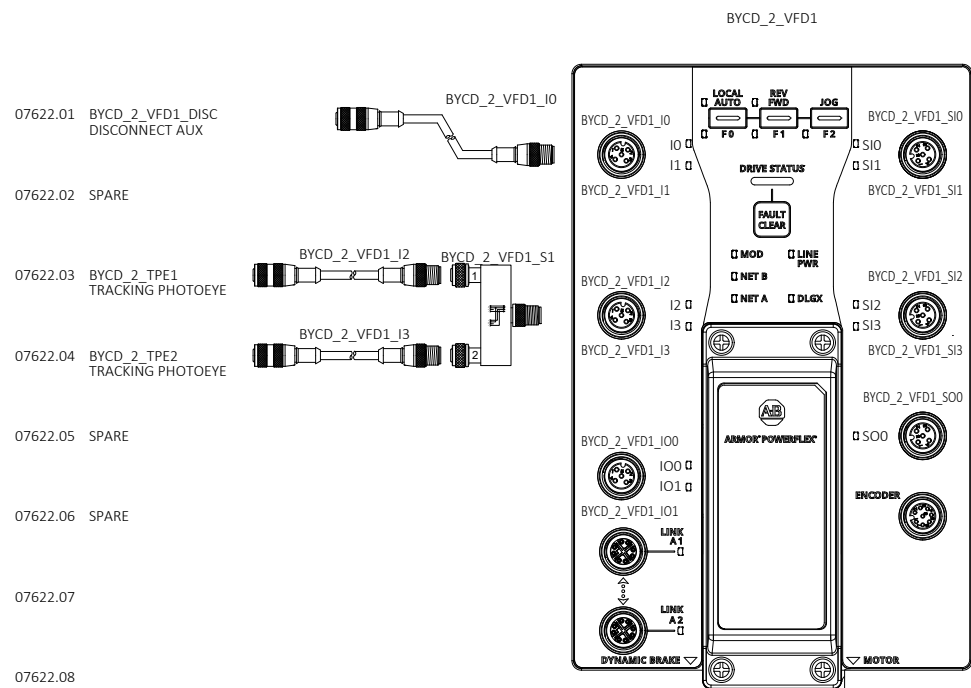


DRAWING REVISIONS			
REV	DESCRIPTION	DATE	BY
00	INITIAL DRAWINGS	04/25/2025	SK
01	ALARM HORN	06/23/2025	SN
A	AS-BUILT	11/13/2025	LB









autStand
Automation Standard

CONFIDENTIAL: THE INFORMATION CONTAINED HEREIN IS PROPRIETARY INFORMATION OF AUTOMATION STANDARD LLC AND CONSTITUTES TRADE SECRETS PURSUANT TO THE UNIFORM TRADE SECRETS ACT. THIS INFORMATION SHALL ONLY BE USED IN THE PERFORMANCE OF CONTRACT WITH AUTOSTAND. THIS INFORMATION SHALL NOT BE USED, REPRODUCED OR EMPLOYED IN WHOLE PART, EXCEPT WITH AUTOSTAND'S PRIOR WRITTEN APPROVAL.

25K Amazon Cross-Belt Sort Center (ACBSC) BYCD_2_VFD1/BYCD_3_VFD1 BYCD_4_VFD1/BYCD_5_VFD1 IO DRAWINGS	FILENAME	
	2429-AMZ-MTN6-MCM07-622	
	D-SIZE SCALE	JOB NUMBER:
	NTS	2429
AMAZON MTN6 SPARROWS POINT, MD	REVISION	SHEET
	A	74

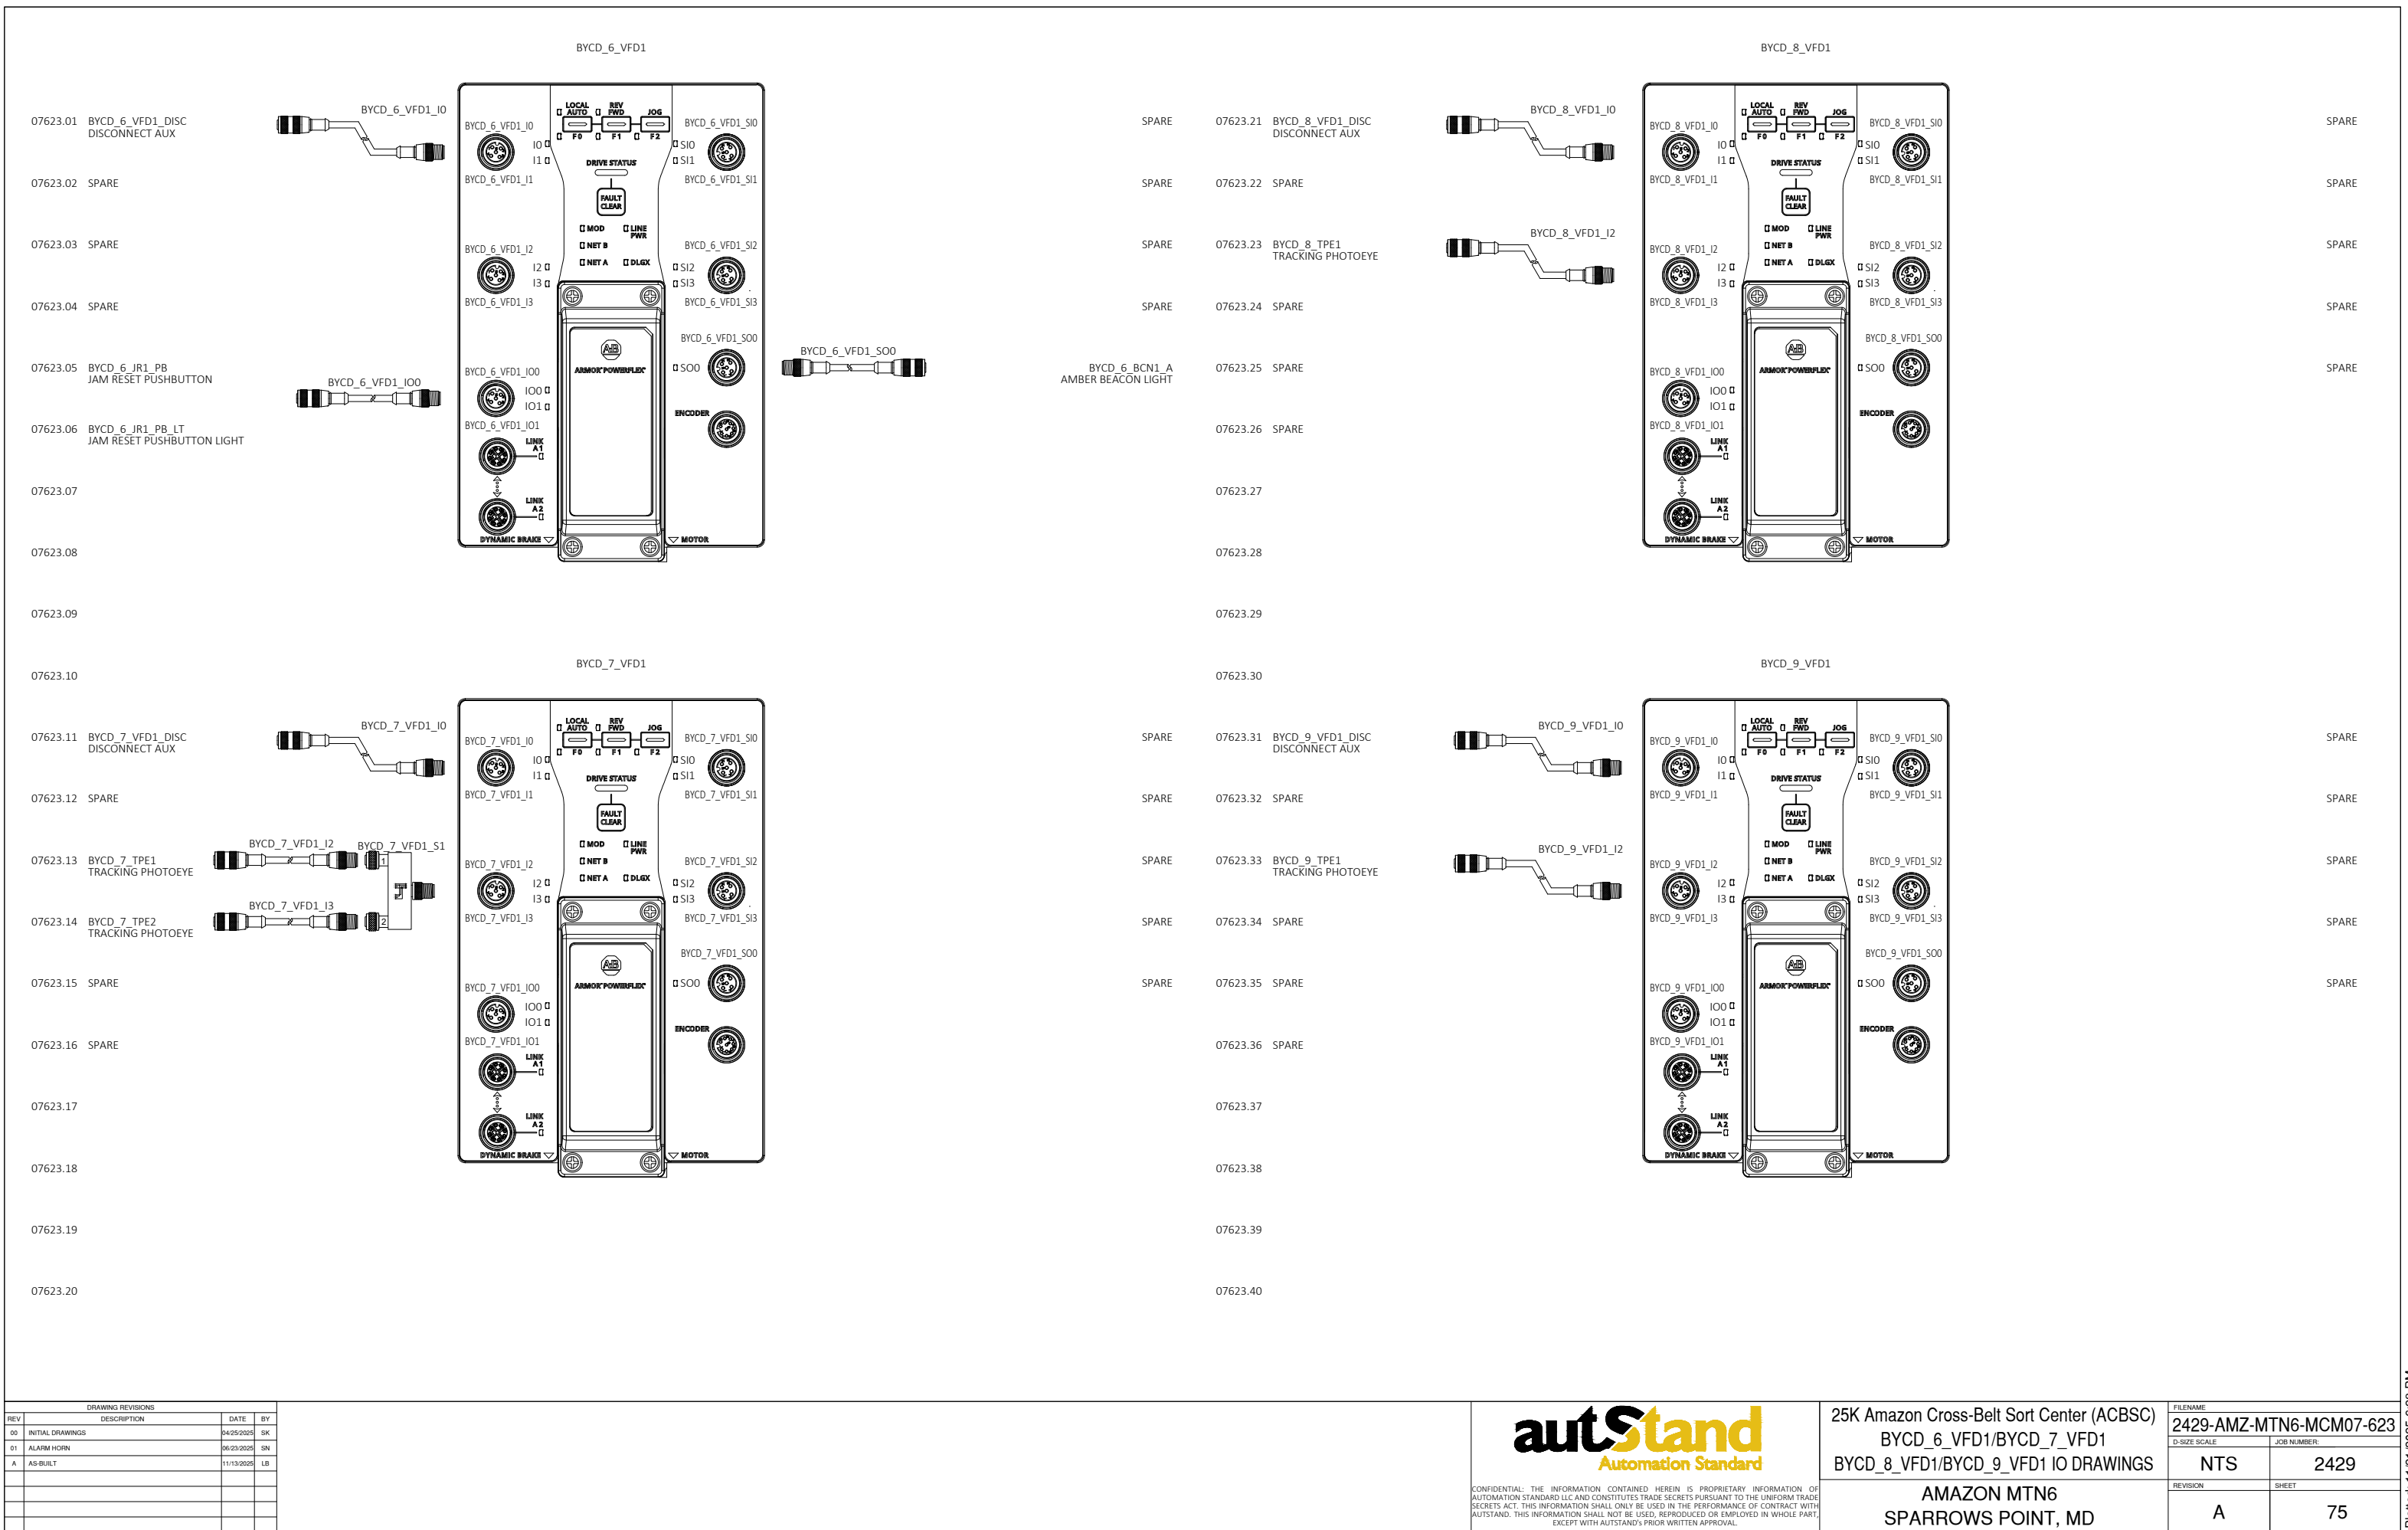

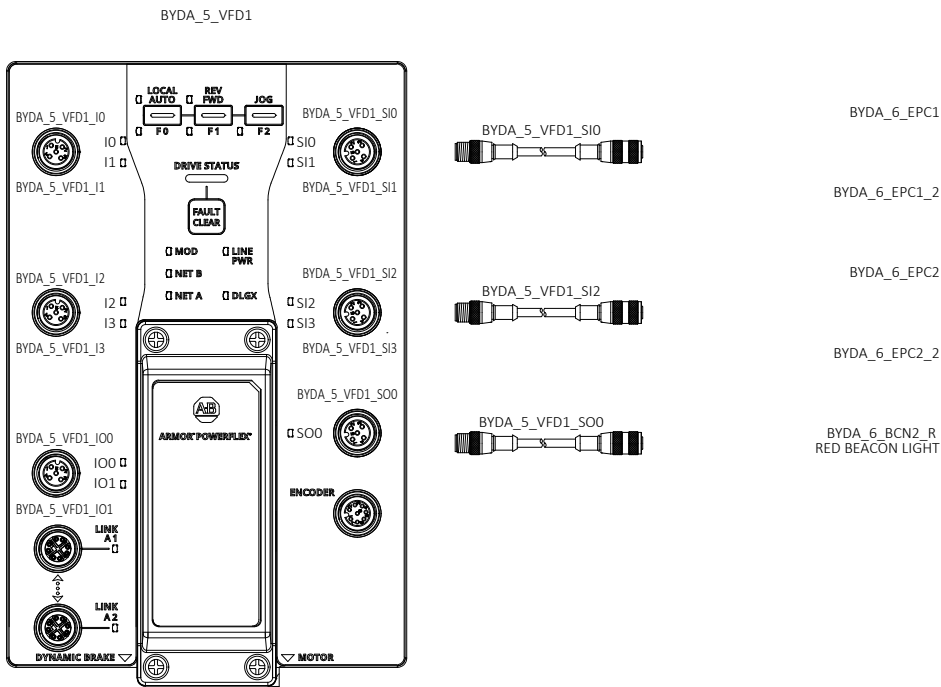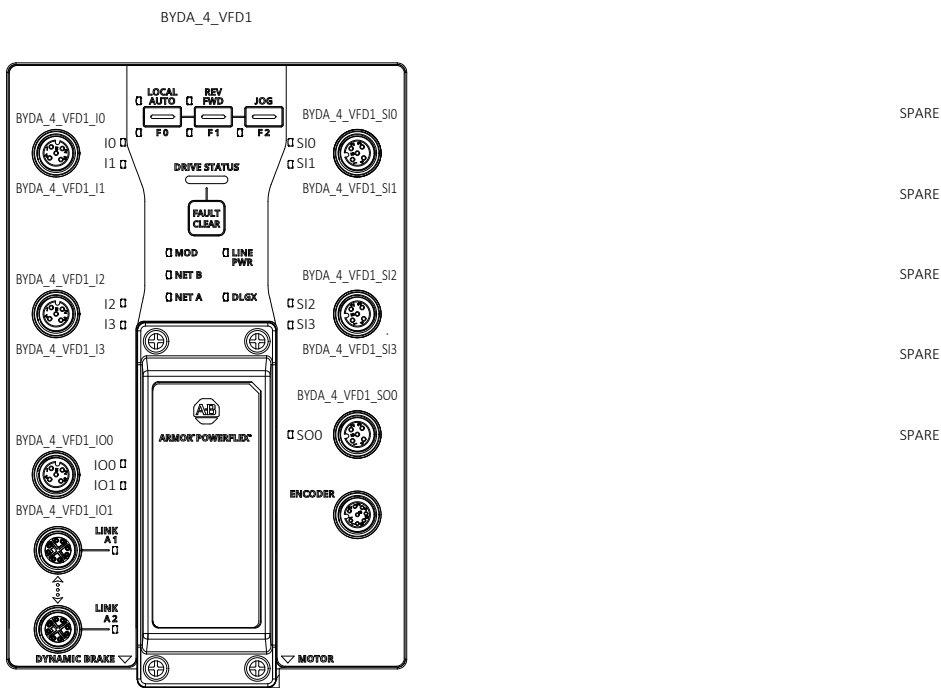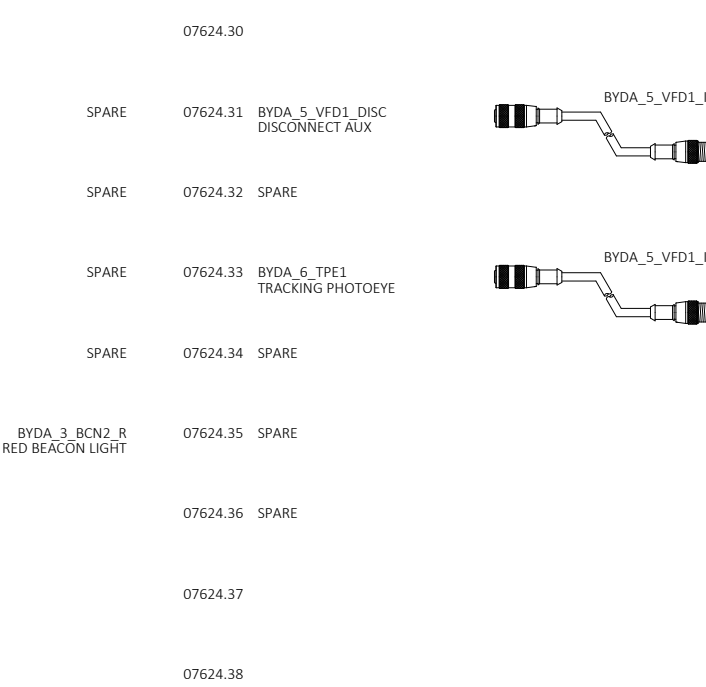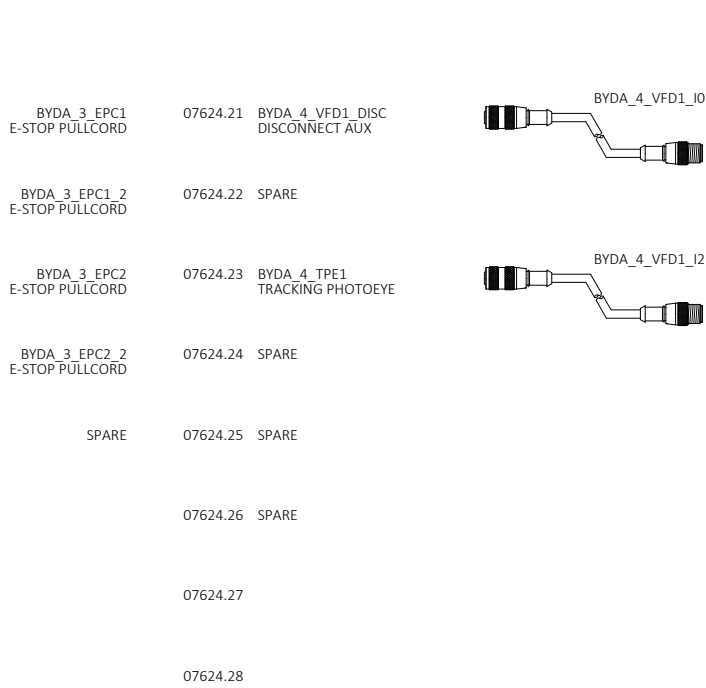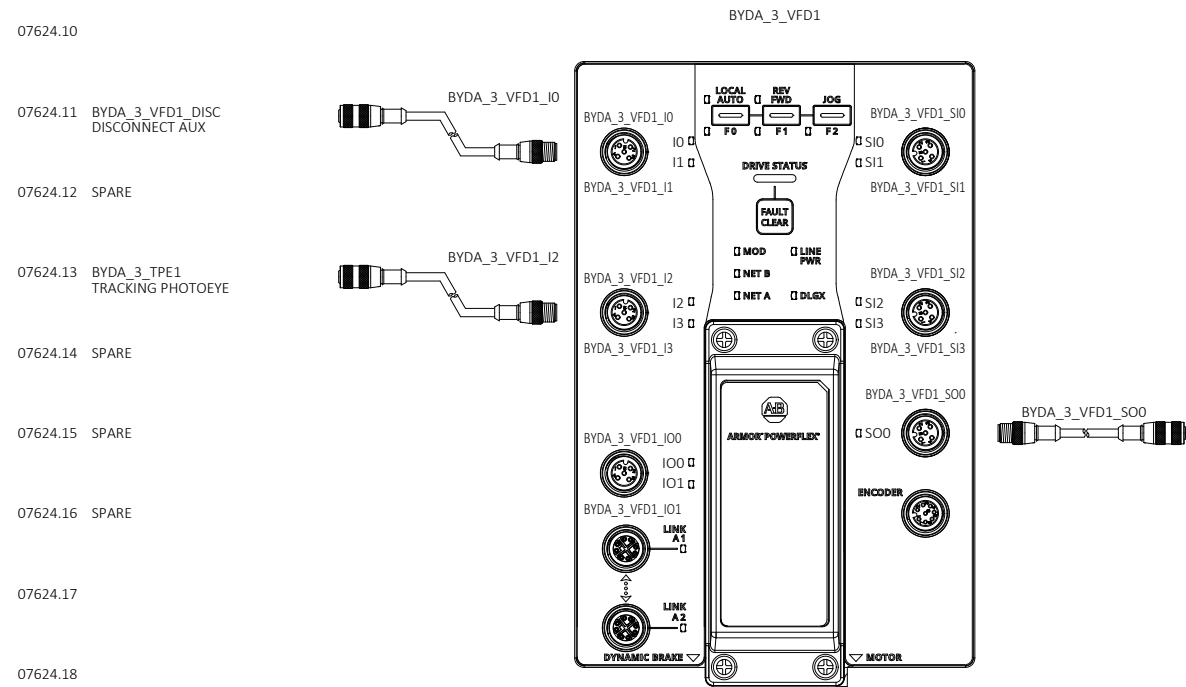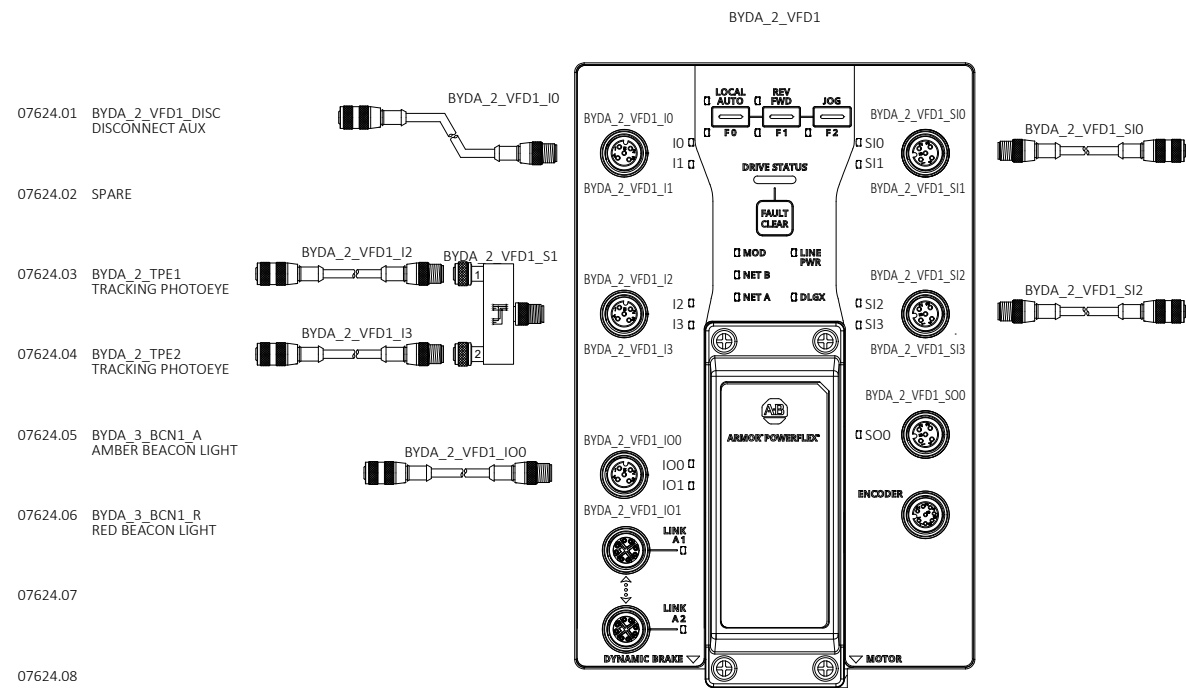





















DRAWING REVISIONS			
REV	DESCRIPTION	DATE	BY
00	INITIAL DRAWINGS	04/25/2025	SK
01	ALARM HORN	06/23/2025	SN
A	AS-BUILT	11/13/2025	LB



autStand
Automation Standard

CONFIDENTIAL: THE INFORMATION CONTAINED HEREIN IS PROPRIETARY INFORMATION OF AUTOMATION STANDARD LLC AND CONSTITUTES TRADE SECRETS PURSUANT TO THE UNIFORM TRADE SECRETS ACT. THIS INFORMATION SHALL ONLY BE USED IN THE PERFORMANCE OF CONTRACT WITH AUTOSTAND. THIS INFORMATION SHALL NOT BE USED, REPRODUCED OR EMPLOYED IN WHOLE PART EXCEPT WITH AUTOSTAND'S PRIOR WRITTEN APPROVAL.

25K Amazon Cross-Belt Sort Center (ACBSC) BYDA_2_VFD1/BYDA_3_VFD1 BYDA_4_VFD1/BYDA_5_VFD1 IO DRAWINGS	FILENAME 2429-AMZ-MTN6-MCM07-624	
	D-SIZE SCALE NTS	JOB NUMBER: 2429
	REVISION A	SHEET 76
	AMAZON MTN6 SPARROWS POINT, MD	

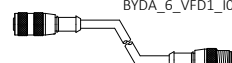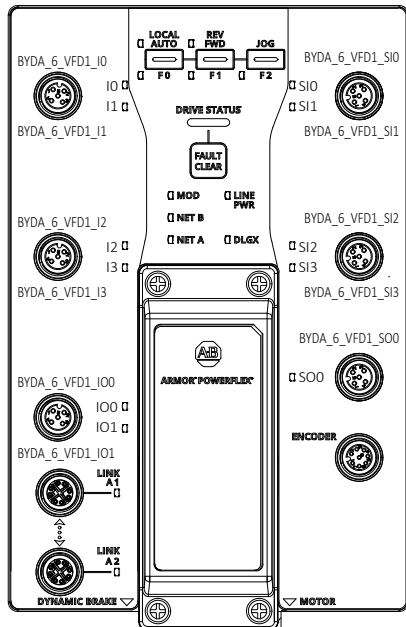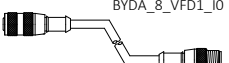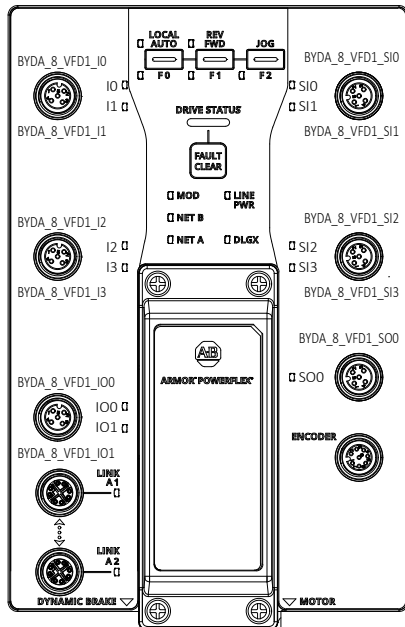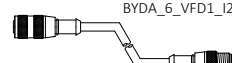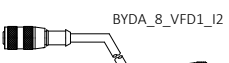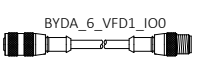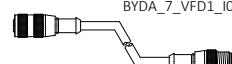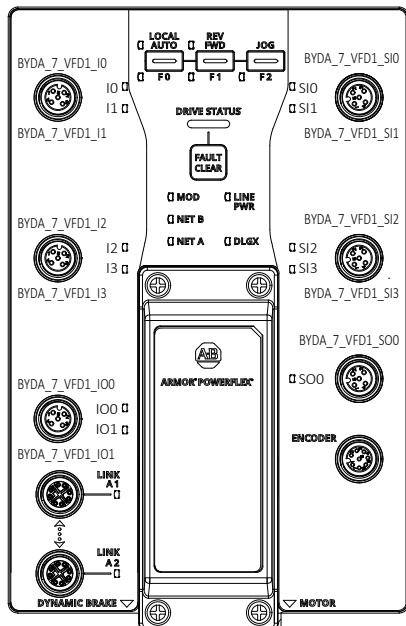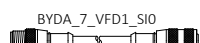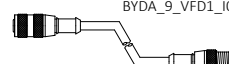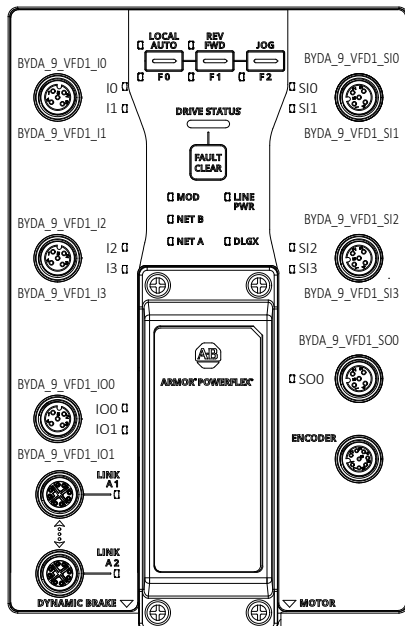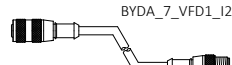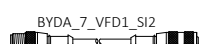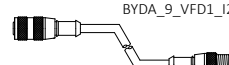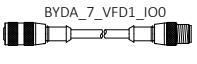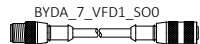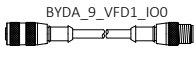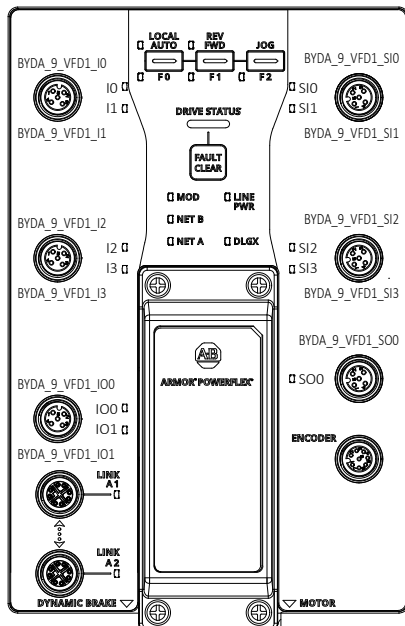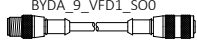07625.01		BYDA_6_VFD1_DISC DISCONNECT AUX				SPARE	07625.21	BYDA_8_VFD1_DISC DISCONNECT AUX				SPARE
07625.02		SPARE				SPARE	07625.22	SPARE				SPARE
07625.03		BYDA_6_TPE2 TRACKING PHOTOEYE				SPARE	07625.23	BYDA_8_TPE2 TRACKING PHOTOEYE				SPARE
07625.04		SPARE				SPARE	07625.24	SPARE				SPARE
07625.05		BYDA_8_S2_PB START PUSHBUTTON				SPARE	07625.25	SPARE				SPARE
07625.06		BYDA_8_S2_PB_LT START PUSHBUTTON LIGHT					07625.26	SPARE				
07625.07							07625.27					
07625.08							07625.28					
07625.09							07625.29					
07625.10							07625.30					
07625.11		BYDA_7_VFD1_DISC DISCONNECT AUX				BYDA_8_EPC1 E-STOP PULLCORD	07625.31	BYDA_9_VFD1_DISC DISCONNECT AUX				SPARE
07625.12		SPARE				BYDA_8_EPC1_2 E-STOP PULLCORD	07625.32	SPARE				SPARE
07625.13		BYDA_8_TPE1 TRACKING PHOTOEYE				BYDA_8_EPC2 E-STOP PULLCORD	07625.33	BYDA_9_TPE1 TRACKING PHOTOEYE				SPARE
07625.14		SPARE				BYDA_8_EPC2_2 E-STOP PULLCORD	07625.34	SPARE				SPARE
07625.15		BYDA_8_S1_PB START PUSHBUTTON				BYDA_8_BCN1_R RED BEACON LIGHT	07625.35	BYDA_9_S2_PB START PUSHBUTTON				BYDA_9_BCN2_R RED BEACON LIGHT
07625.16		BYDA_8_S1_PB_LT START PUSHBUTTON LIGHT					07625.36	BYDA_9_S2_PB_LT START PUSHBUTTON LIGHT				
07625.17							07625.37					
07625.18							07625.38					
07625.19							07625.39					
07625.20							07625.40					

DRAWING REVISIONS				FILENAME			
REV	DESCRIPTION	DATE	BY	2429-AMZ-MTN6-MCM07-625			
00	INITIAL DRAWINGS	04/25/2025	SK	D-SIZE SCALE			
01	ALARM HORN	06/23/2025	SN	JOB NUMBER:			
A	AS-BUILT	11/13/2025	LB	NTS			
				2429			
				REVISION			
				A			
				SHEET			
				77			





autStand

Automation Standard

CONFIDENTIAL: THE INFORMATION CONTAINED HEREIN IS PROPRIETARY INFORMATION OF AUTOMATION STANDARD LLC AND CONSTITUTES TRADE SECRETS PURSUANT TO THE UNIFORM TRADE SECRETS ACT. THIS INFORMATION SHALL ONLY BE USED IN THE PERFORMANCE OF CONTRACT WITH AUTISTAND. THIS INFORMATION SHALL NOT BE USED, REPRODUCED OR EMPLOYED IN WHOLE PART, EXCEPT WITH AUTISTAND'S PRIOR WRITTEN APPROVAL.

25K Amazon Cross-Belt Sort Center (ACBSC) BYDA_6_VFD1/BYDA_7_VFD1 BYDA_8_VFD1/BYDA_9_VFD1 IO DRAWINGS	AMAZON MTN6 SPARROWS POINT, MD
---	-----------------------------------

lotted: 11/21/2025 6:29 PM

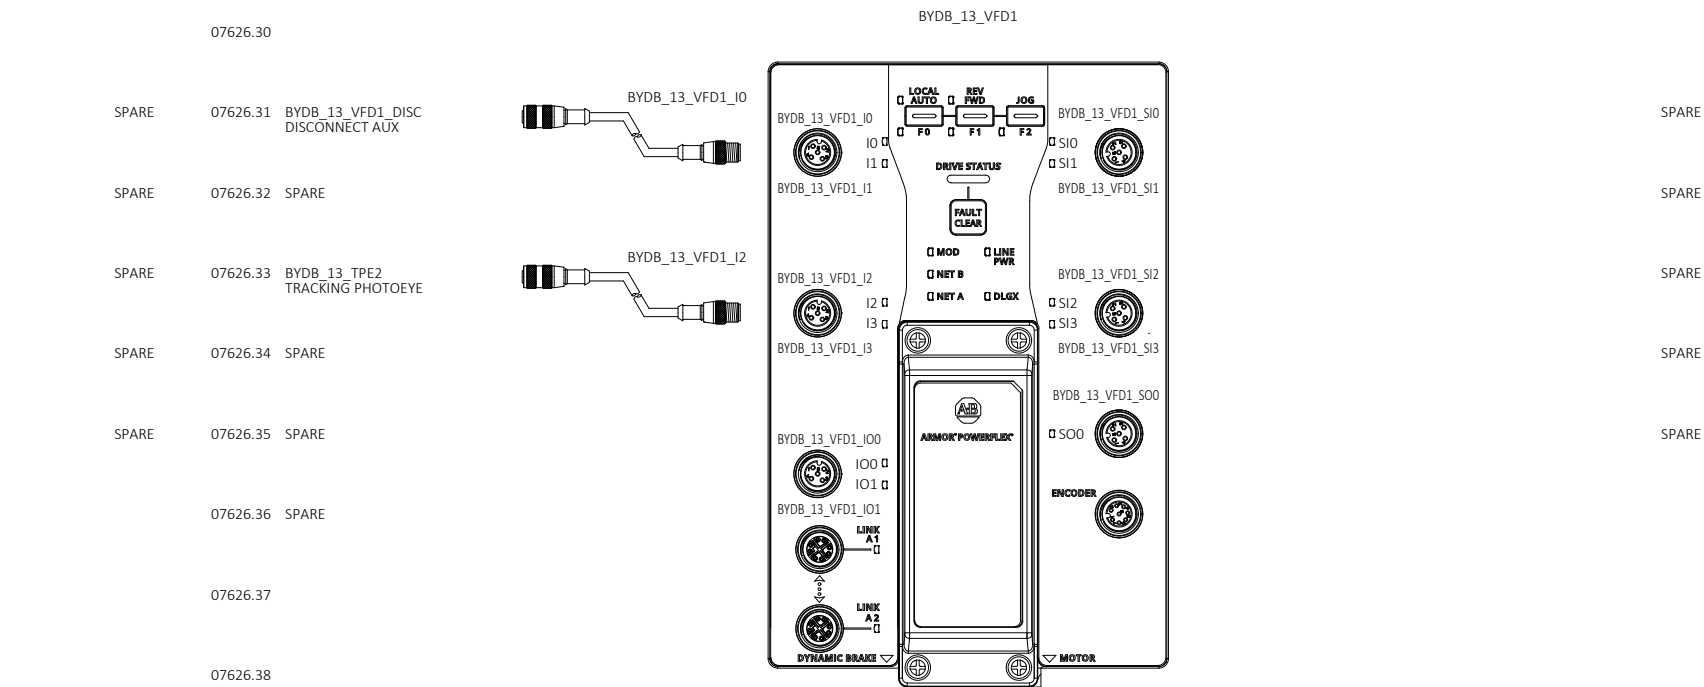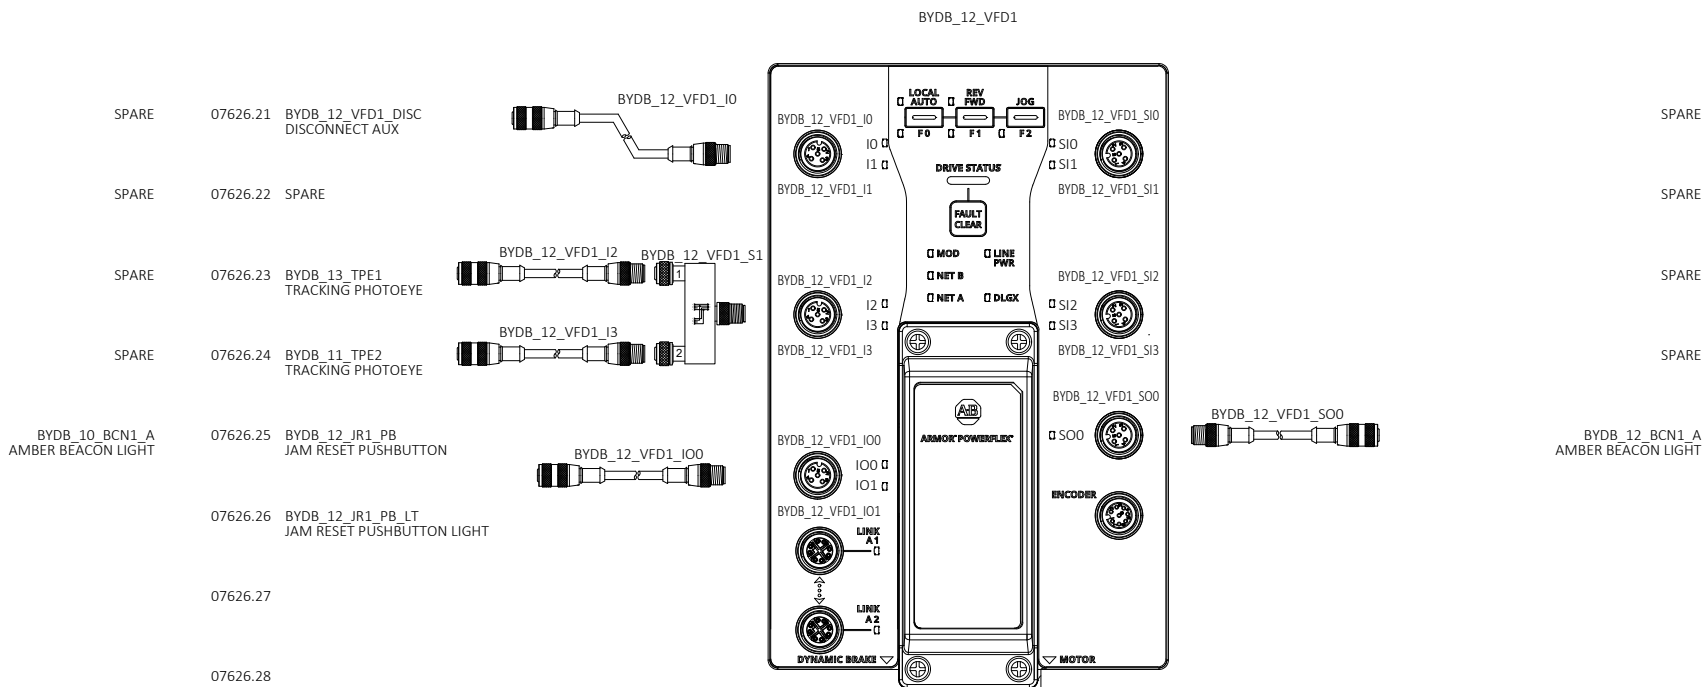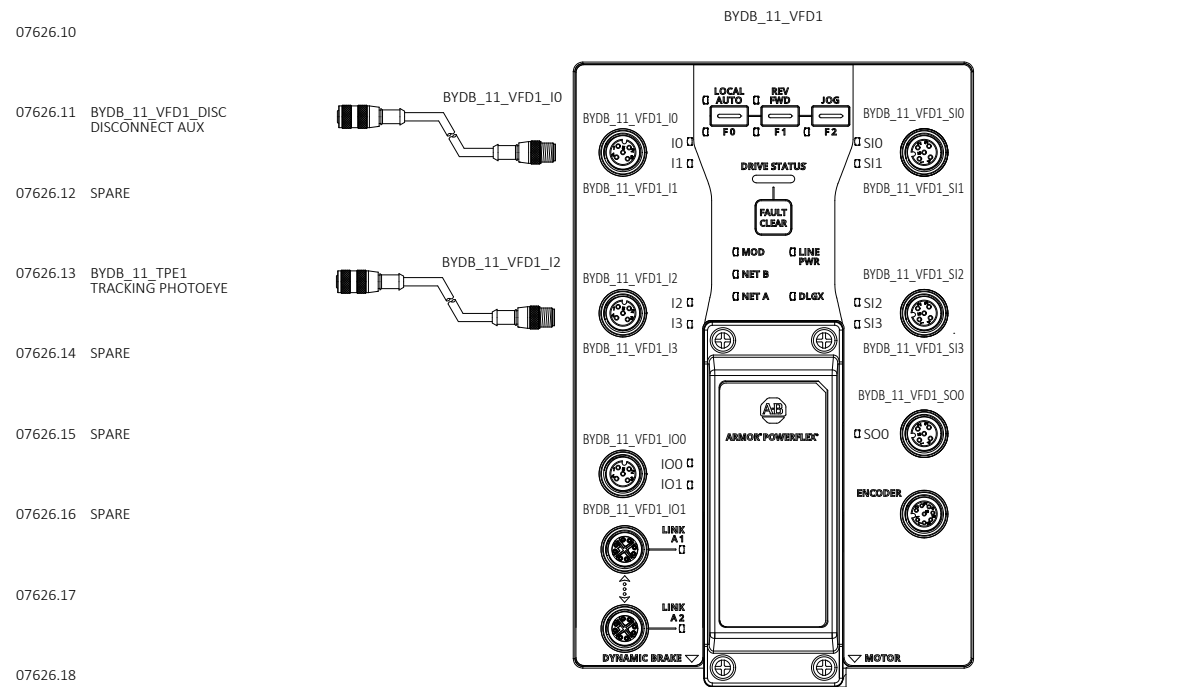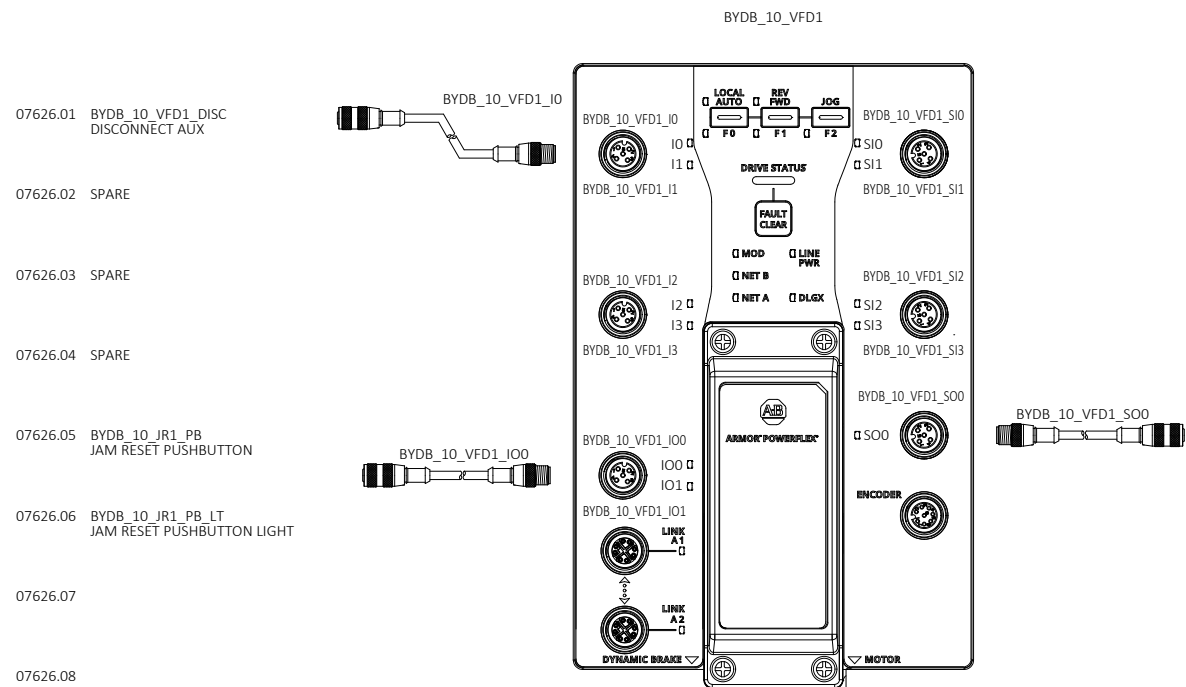









DRAWING REVISIONS			
REV	DESCRIPTION	DATE	BY
00	INITIAL DRAWINGS	04/25/2025	SK
01	ALARM HORN	06/23/2025	SN
A	AS-BUILT	11/13/2025	LB



autistand
Automation Standard

CONFIDENTIAL: THE INFORMATION CONTAINED HEREIN IS PROPRIETARY INFORMATION OF AUTOMATION STANDARD LLC AND CONSTITUTES TRADE SECRETS PURSUANT TO THE UNIFORM TRADE SECRETS ACT. THIS INFORMATION SHALL ONLY BE USED IN THE PERFORMANCE OF CONTRACT WITH AUTISTAND. THIS INFORMATION SHALL NOT BE USED, REPRODUCED OR EMPLOYED IN WHOLE PART, EXCEPT WITH AUTISTAND'S PRIOR WRITTEN APPROVAL.

25K Amazon Cross-Belt Sort Center (ACBSC) BYDB_10_VFD1/BYDB_11_VFD1 BYDB_12_VFD1/BYDB_13_VFD1 IO DRAWINGS	FILENAME	
	2429-AMZ-MTN6-MCM07-626	
	D-SIZE SCALE	JOB NUMBER:
	NTS	2429
AMAZON MTN6 SPARROWS POINT, MD	REVISION	SHEET
	A	78

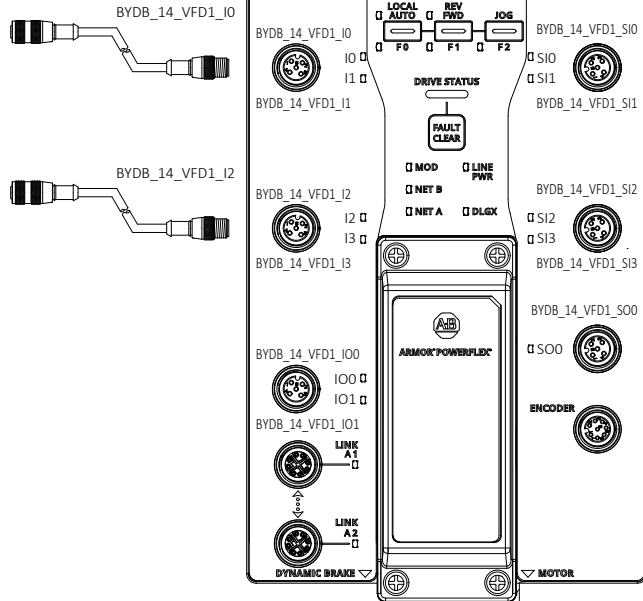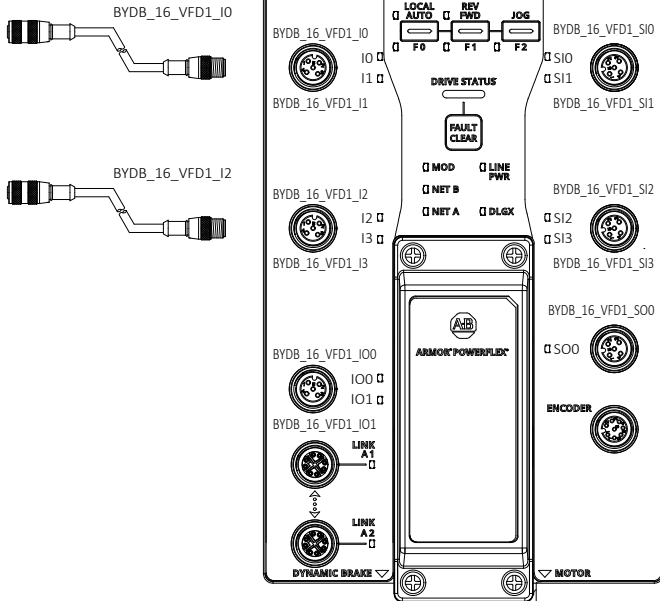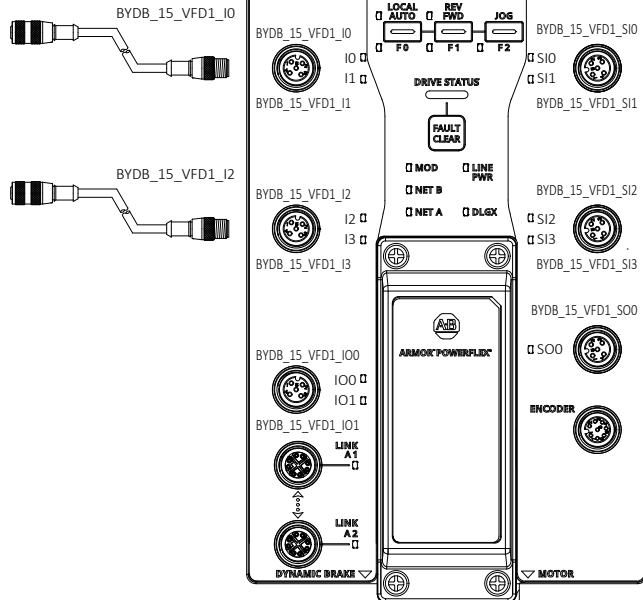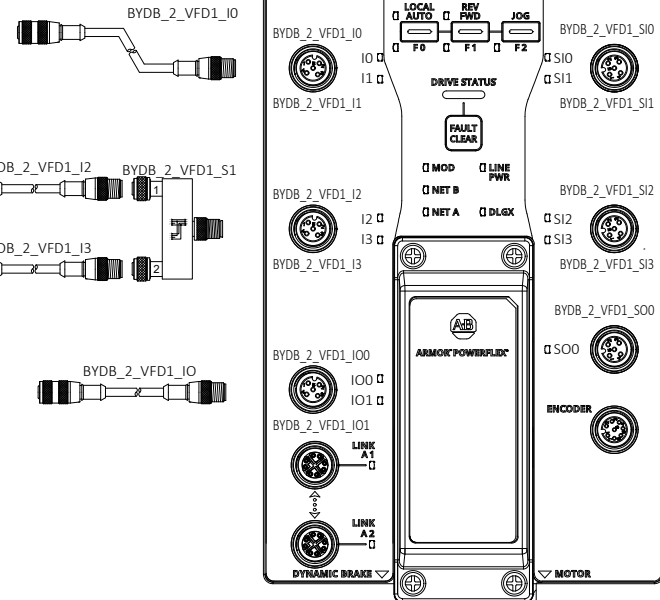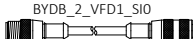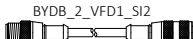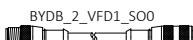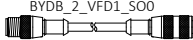				BYDB_14_VFD1								BYDB_16_VFD1																																																						
07627.01	BYDB_14_VFD1_DISC DISCONNECT AUX							SPARE	07627.21	BYDB_16_VFD1_DISC DISCONNECT AUX							SPARE																																																	
07627.02	SPARE							SPARE	07627.22	SPARE							SPARE																																																	
07627.03	BYDB_14_TPE1 TRACKING PHOTOEYE							SPARE	07627.23	BYDB_16_TPE1 TRACKING PHOTOEYE							SPARE																																																	
07627.04	SPARE							SPARE	07627.24	SPARE							SPARE																																																	
07627.05	SPARE							SPARE	07627.25	SPARE							SPARE																																																	
07627.06	SPARE								07627.26	SPARE																																																								
07627.07									07627.27																																																									
07627.08									07627.28																																																									
07627.09									07627.29																																																									
07627.10				BYDB_15_VFD1					07627.30				BYDB_2_VFD1																																																					
07627.11	BYDB_15_VFD1_DISC DISCONNECT AUX							SPARE	07627.31	BYDB_2_VFD1_DISC DISCONNECT AUX							BYDB_3_EPC1 E-STOP PULLCORD																																																	
07627.12	SPARE							SPARE	07627.32	SPARE							BYDB_3_EPC1_2 E-STOP PULLCORD																																																	
07627.13	BYDB_15_TPE1 TRACKING PHOTOEYE							SPARE	07627.33	BYDB_2_TPE1 TRACKING PHOTOEYE							BYDB_3_EPC2 E-STOP PULLCORD																																																	
07627.14	SPARE							SPARE	07627.34	BYDB_2_TPE2 TRACKING PHOTOEYE							BYDB_3_EPC2_2 E-STOP PULLCORD																																																	
07627.15	SPARE							SPARE	07627.35	BYDB_3_BC11_A AMBER BEACON LIGHT							BYDB_3_BC12_R RED BEACON LIGHT																																																	
07627.16	SPARE								07627.36	BYDB_3_BC11_R RED BEACON LIGHT																																																								
07627.17									07627.37																																																									
07627.18									07627.38																																																									
07627.19									07627.39																																																									
07627.20									07627.40																																																									
<table><tr><th colspan="4">DRAWING REVISIONS</th></tr><tr><th>REV</th><th>DESCRIPTION</th><th>DATE</th><th>BY</th></tr><tr><td>00</td><td>INITIAL DRAWINGS</td><td>04/25/2005</td><td>SK</td></tr><tr><td>01</td><td>ALARM HORN</td><td>06/23/2005</td><td>SN</td></tr><tr><td>A</td><td>AS-BUILT</td><td>11/13/2005</td><td>LB</td></tr><tr><td></td><td></td><td></td><td></td></tr><tr><td></td><td></td><td></td><td></td></tr><tr><td></td><td></td><td></td><td></td></tr><tr><td></td><td></td><td></td><td></td></tr></table>				DRAWING REVISIONS				REV	DESCRIPTION	DATE	BY	00	INITIAL DRAWINGS	04/25/2005	SK	01	ALARM HORN	06/23/2005	SN	A	AS-BUILT	11/13/2005	LB																					25K Amazon Cross-Belt Sort Center (ACBSC) BYDB_14_VFD1/BYDB_15_VFD1 BYDB_16_VFD1/BYDB_2_VFD1 IO DRAWINGS				<table><tr><th colspan="2">FILENAME</th></tr><tr><td colspan="2">2429-AMZ-MTN6-MCM07-627</td></tr><tr><th>D-SIZE SCALE</th><th>JOB NUMBER</th></tr><tr><td>NTS</td><td>2429</td></tr><tr><th>REVISION</th><th>SHEET</th></tr><tr><td>A</td><td>79</td></tr></table>				FILENAME		2429-AMZ-MTN6-MCM07-627		D-SIZE SCALE	JOB NUMBER	NTS	2429	REVISION	SHEET	A	79			
DRAWING REVISIONS																																																																		
REV	DESCRIPTION	DATE	BY																																																															
00	INITIAL DRAWINGS	04/25/2005	SK																																																															
01	ALARM HORN	06/23/2005	SN																																																															
A	AS-BUILT	11/13/2005	LB																																																															
FILENAME																																																																		
2429-AMZ-MTN6-MCM07-627																																																																		
D-SIZE SCALE	JOB NUMBER																																																																	
NTS	2429																																																																	
REVISION	SHEET																																																																	
A	79																																																																	
CONFIDENTIAL: THE INFORMATION CONTAINED HEREIN IS PROPRIETARY INFORMATION OF AUTOMATION STANDARD LLC AND CONSTITUTES TRADE SECRETS PURSUANT TO THE UNIFORM TRADE SECRETS ACT. THIS INFORMATION SHALL ONLY BE USED IN THE PERFORMANCE OF CONTRACT WITH AUTSTAND. THIS INFORMATION SHALL NOT BE USED, REPRODUCED OR EMPLOYED IN WHOLE PART, EXCEPT WITH AUTSTAND'S PRIOR WRITTEN APPROVAL.				AMAZON MTN6 SPARROWS POINT, MD																																																														

		BYDB_7_VFD1				BYDB_9_VFD1																																																			
07629.01	BYDB_7_VFD1_DISC DISCONNECT AUX			SPARE	07629.21	BYDB_9_VFD1_DISC DISCONNECT AUX		SPARE																																																	
07629.02	SPARE			SPARE	07629.22	SPARE		SPARE																																																	
07629.03	BYDB_7_TPE1 TRACKING PHOTOEYE			SPARE	07629.23	BYDB_9_TPE1 TRACKING PHOTOEYE		SPARE																																																	
07629.04	SPARE			SPARE	07629.24	SPARE		SPARE																																																	
07629.05	SPARE			SPARE	07629.25	SPARE		SPARE																																																	
07629.06	SPARE				07629.26	SPARE																																																			
07629.07					07629.27																																																				
07629.08					07629.28																																																				
07629.09					07629.29																																																				
07629.10					07629.30																																																				
07629.11	BYDB_8_VFD1_DISC DISCONNECT AUX			SPARE	07629.31	BYDC_10_VFD1_DISC DISCONNECT AUX		SPARE																																																	
07629.12	SPARE			SPARE	07629.32	SPARE		SPARE																																																	
07629.13	BYDB_8_TPE1 TRACKING PHOTOEYE			SPARE	07629.33	BYDC_10_TPE1 TRACKING PHOTOEYE		SPARE																																																	
07629.14	SPARE			SPARE	07629.34	SPARE		SPARE																																																	
07629.15	SPARE			SPARE	07629.35	SPARE		SPARE																																																	
07629.16	SPARE				07629.36	SPARE																																																			
07629.17					07629.37																																																				
07629.18					07629.38																																																				
07629.19					07629.39																																																				
07629.20					07629.40																																																				
<table><tr><th colspan="4">DRAWING REVISIONS</th></tr><tr><th>REV</th><th>DESCRIPTION</th><th>DATE</th><th>BY</th></tr><tr><td>00</td><td>INITIAL DRAWINGS</td><td>04/25/2025</td><td>SK</td></tr><tr><td>01</td><td>ALARM HORN</td><td>06/23/2025</td><td>SN</td></tr><tr><td>A</td><td>AS-BUILT</td><td>11/13/2025</td><td>LB</td></tr><tr><td> </td><td> </td><td> </td><td> </td></tr><tr><td> </td><td> </td><td> </td><td> </td></tr><tr><td> </td><td> </td><td> </td><td> </td></tr><tr><td> </td><td> </td><td> </td><td> </td></tr></table>				DRAWING REVISIONS				REV	DESCRIPTION	DATE	BY	00	INITIAL DRAWINGS	04/25/2025	SK	01	ALARM HORN	06/23/2025	SN	A	AS-BUILT	11/13/2025	LB																			25K Amazon Cross-Belt Sort Center (ACBSC) BYDB_7_VFD1/BYDB_8_VFD1 BYDB_9_VFD1/BYDC_10_VFD1 IO DRAWINGS		<table><tr><th colspan="2">FILENAME</th></tr><tr><td colspan="2">2429-AMZ-MTN6-MCM07-629</td></tr><tr><th>D-SIZE SCALE</th><th>JOB NUMBER</th></tr><tr><td>NTS</td><td>2429</td></tr><tr><th>REVISION</th><th>SHEET</th></tr><tr><td>A</td><td>81</td></tr></table>		FILENAME		2429-AMZ-MTN6-MCM07-629		D-SIZE SCALE	JOB NUMBER	NTS	2429	REVISION	SHEET	A	81
DRAWING REVISIONS																																																									
REV	DESCRIPTION	DATE	BY																																																						
00	INITIAL DRAWINGS	04/25/2025	SK																																																						
01	ALARM HORN	06/23/2025	SN																																																						
A	AS-BUILT	11/13/2025	LB																																																						
FILENAME																																																									
2429-AMZ-MTN6-MCM07-629																																																									
D-SIZE SCALE	JOB NUMBER																																																								
NTS	2429																																																								
REVISION	SHEET																																																								
A	81																																																								









DRAWING REVISIONS			
REV	DESCRIPTION	DATE	BY
00	INITIAL DRAWINGS	04/25/2025	SK
01	ALARM HORN	06/23/2025	SN
A	AS-BUILT	11/13/2025	LB



25K Amazon Cross-Belt Sort Center (ACBSC)
BYDC_3_VFD1/BYDC_4_VFD1
BYDC_5_VFD1/BYDC_6_VFD1 IO DRAWINGS

AMAZON MTN6
SPARROWS POINT, MD

FILENAME	
2429-AMZ-MTN6-MCM07-631	
D-SIZE SCALE	JOB NUMBER:
NTS	2429
REVISION	SHEET
A	83

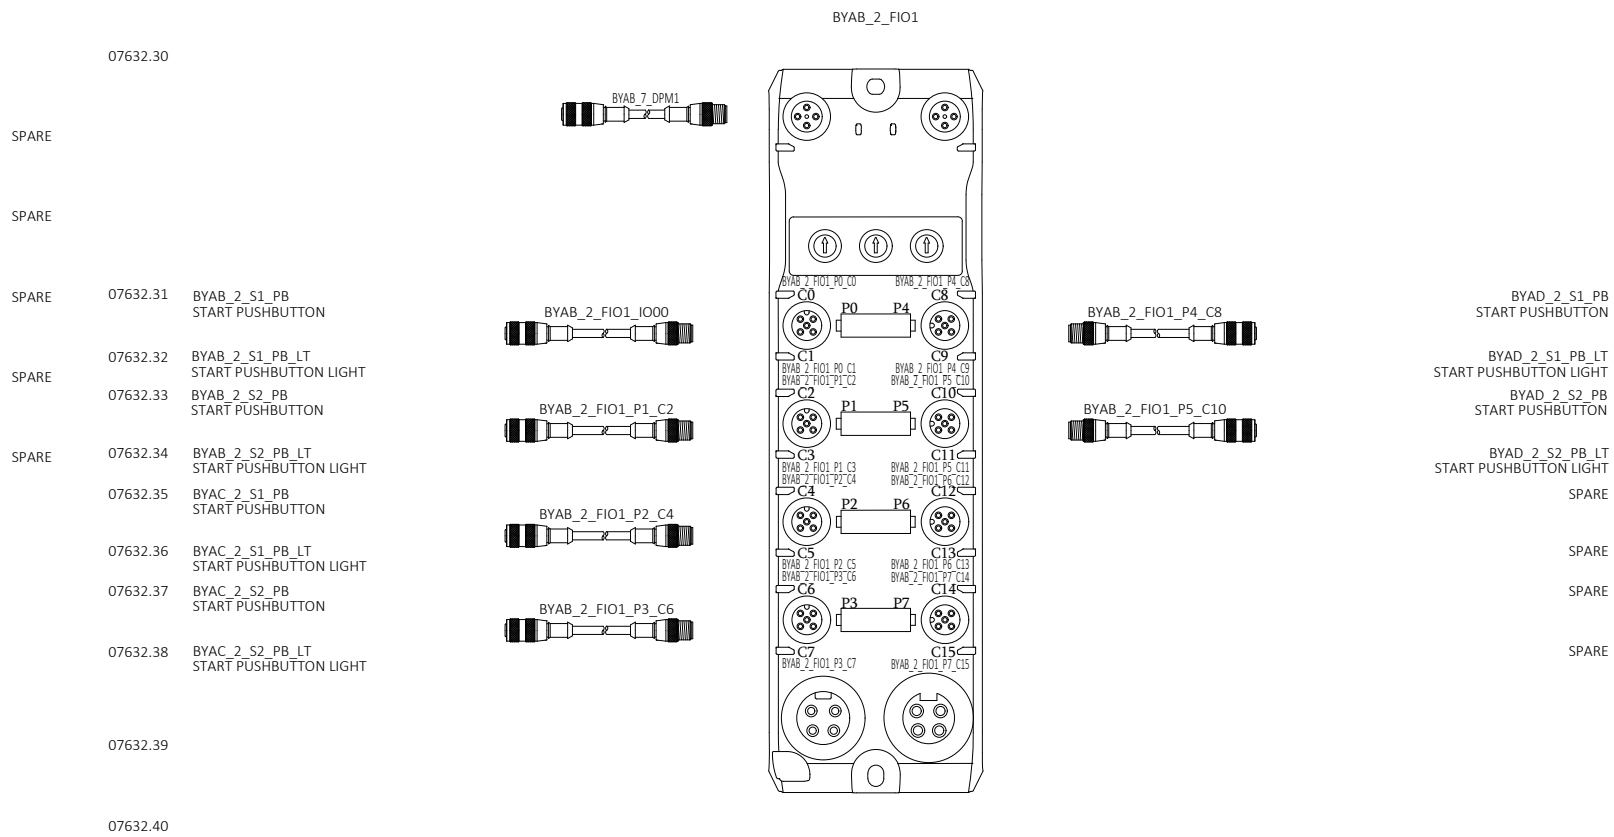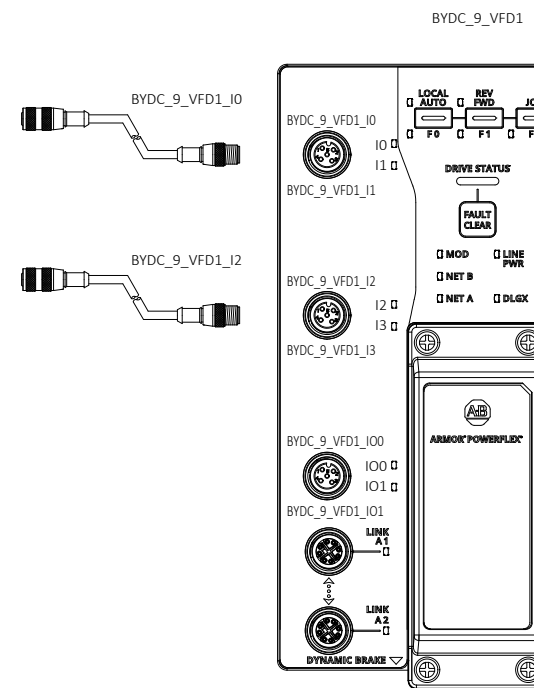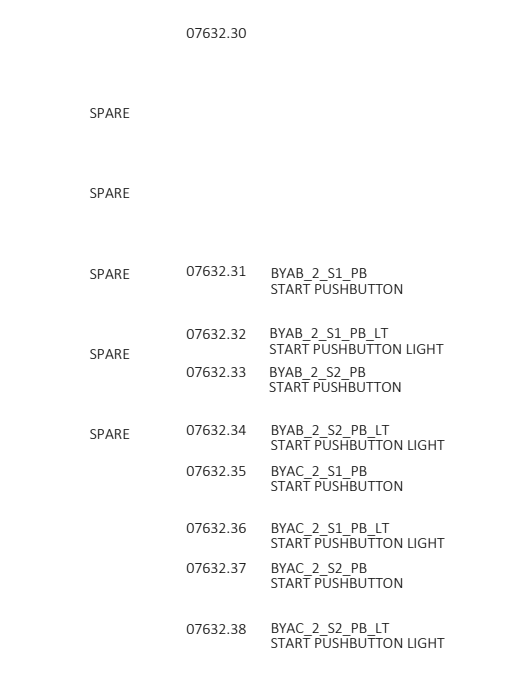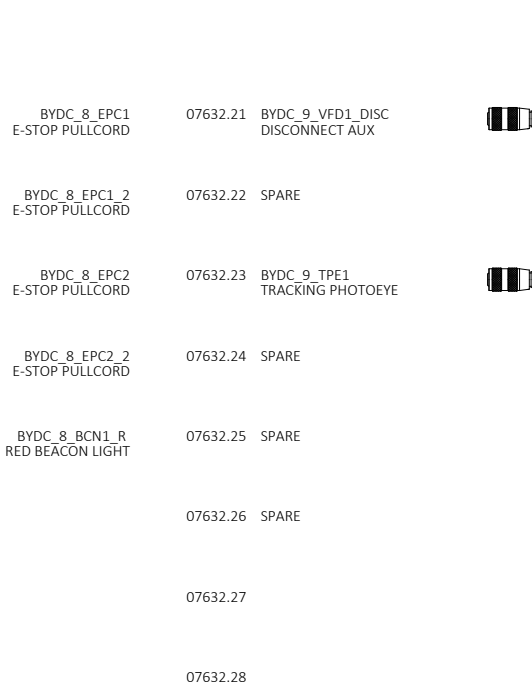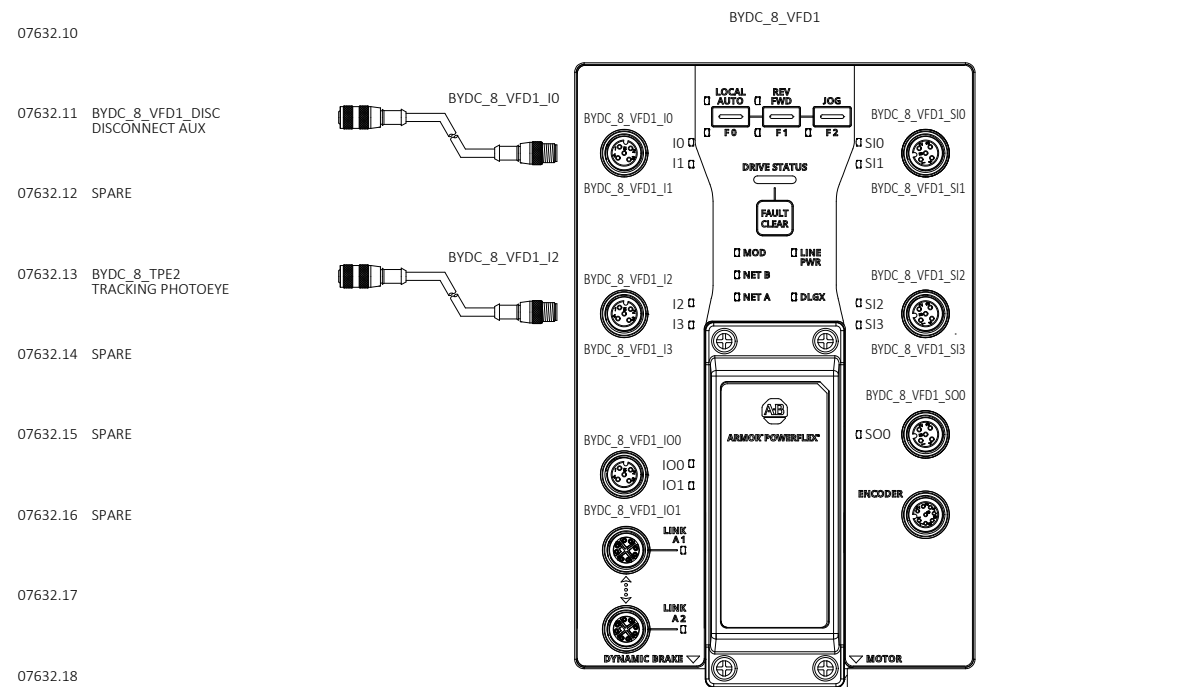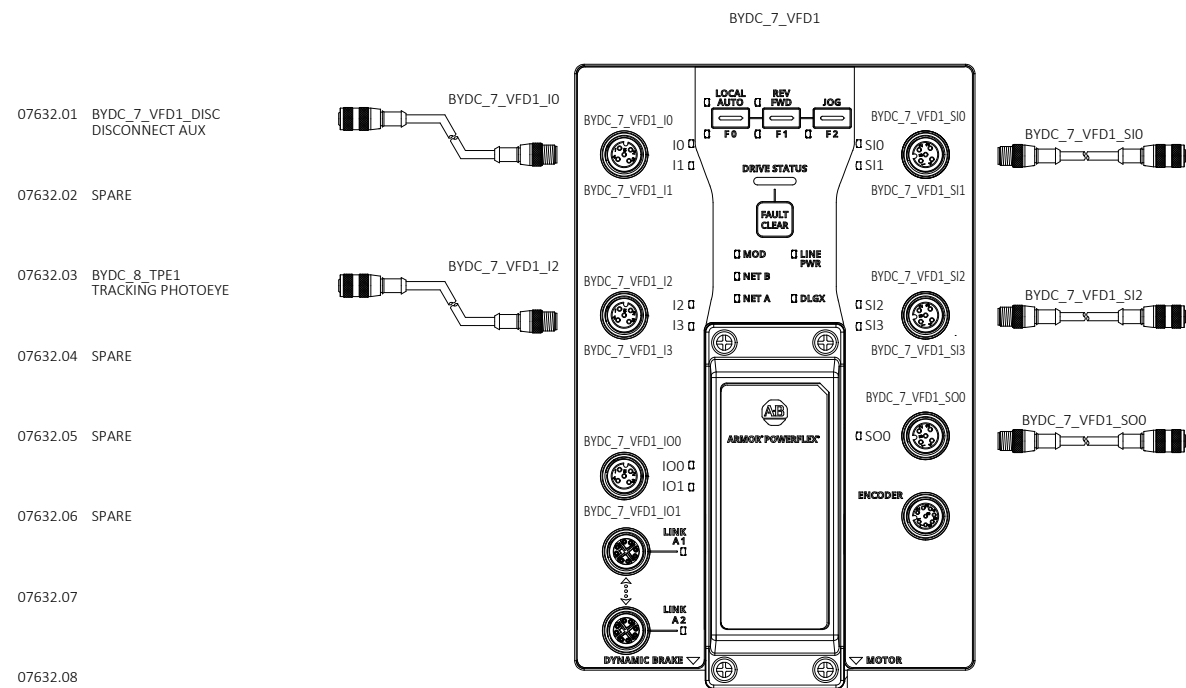

DRAWING REVISIONS			
REV	DESCRIPTION	DATE	BY
00	INITIAL DRAWINGS	04/25/2025	SK
01	ALARM HORN	06/23/2025	SN
A	AS-BUILT	11/13/2025	LB




















autStand
Automation Standard

CONFIDENTIAL: THE INFORMATION CONTAINED HEREIN IS PROPRIETARY INFORMATION OF AUTOMATION STANDARD LLC AND CONSTITUTES TRADE SECRETS PURSUANT TO THE UNIFORM TRADE SECRETS ACT. THIS INFORMATION SHALL ONLY BE USED IN THE PERFORMANCE OF CONTRACT WITH AUTOSTAND. THIS INFORMATION SHALL NOT BE USED, REPRODUCED OR EMPLOYED IN WHOLE PART EXCEPT WITH AUTOSTAND'S PRIOR WRITTEN APPROVAL.

25K Amazon Cross-Belt Sort Center (ACBSC) BYDC_7_VFD1/BYDC_8_VFD1 BYDC_9_VFD1/BYAB_2_FIO1 IO DRAWINGS AMAZON MTN6 SPARROWS POINT, MD	FILENAME 2429-AMZ-MTN6-MCM07-632	
	D-SIZE SCALE NTS	JOB NUMBER: 2429
	REVISION A	SHEET 84





				BYAC_11_FIO1								BYCA_2_FIO1						
07633.01	BYAC_11_BCN1_R RED BEACON LIGHT																	
07633.02	SPARE																	
07633.03	BYAC_11_BCN2_A AMBER BEACON LIGHT																	
07633.04	BYAC_11_BCN2_R RED BEACON LIGHT																	
07633.05	BYAC_11_S1_PB START PUSHBUTTON																	
07633.06	BYAC_11_S1_PB_LT START PUSHBUTTON LIGHT																	
07633.07	BYAC_11_S2_PB START PUSHBUTTON																	
07633.08	BYAC_11_S2_PB_LT START PUSHBUTTON LIGHT																	
07633.09																		
07633.10																		
				BYBA_2_FIO1														
07633.11	BYBA_3_BCN2_R RED BEACON LIGHT																	
07633.12	SPARE																	
07633.13	BYBA_3_S1_PB START PUSHBUTTON																	
07633.14	BYBA_3_S1_PB_LT START PUSHBUTTON LIGHT																	
07633.15	BYBA_3_S2_PB START PUSHBUTTON																	
07633.16	BYBA_3_S2_PB_LT START PUSHBUTTON LIGHT																	
07633.17	BYBC_3_S1_PB START PUSHBUTTON																	
07633.18	BYBC_3_S1_PB_LT START PUSHBUTTON LIGHT																	
07633.19																		
07633.20																		

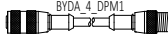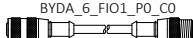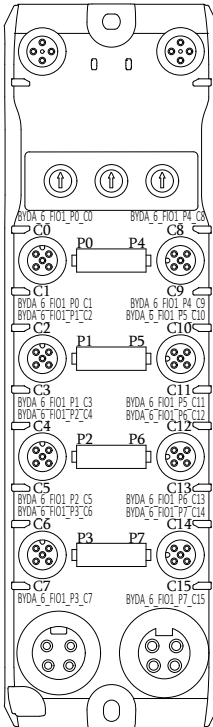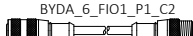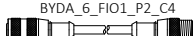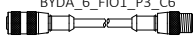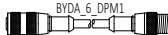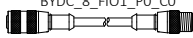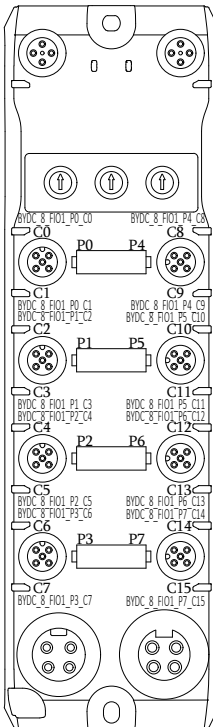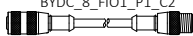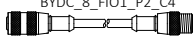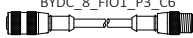				BYDA_6_FIO1													
																	
07634.01	BYDA_6_S2_PB											SPARE					
07634.02	BYDA_6_S2_PB_LT											SPARE					
07634.03	BYDA_6_S1_PB											SPARE					
07634.04	BYDA_6_S1_PB_LT											SPARE					
07634.05	BYDA_6_BCN1_A											SPARE					
07634.06	BYDA_6_BCN1_R											SPARE					
07634.07	BYDC_6_BCN1_A											SPARE					
07634.08	BYDC_6_BCN1_R											SPARE					
07634.09																	
07634.10																	
				BYDC_8_FIO1													
																	
07634.11	BYDC_8_S1_PB											SPARE					
07634.12	BYDC_8_S1_PB_LT											SPARE					
07634.13	BYDC_8_S2_PB											SPARE					
07634.14	BYDC_8_S2_PB_LT											SPARE					
07634.15	BYDC_8_BCN2_A											SPARE					
07634.16	BYDC_8_BCN2_R											SPARE					
07634.17	BYDA_8_BCN2_A											SPARE					
07634.18	BYDA_8_BCN2_R											SPARE					
07634.19																	
07634.20																	
DRAWING REVISIONS																	
REV	DESCRIPTION		DATE	BY													
00	INITIAL DRAWINGS		04/25/2025	SK													
01	ALARM HORN		06/23/2025	SN													
A	AS-BUILT		11/13/2025	LB													
	</																

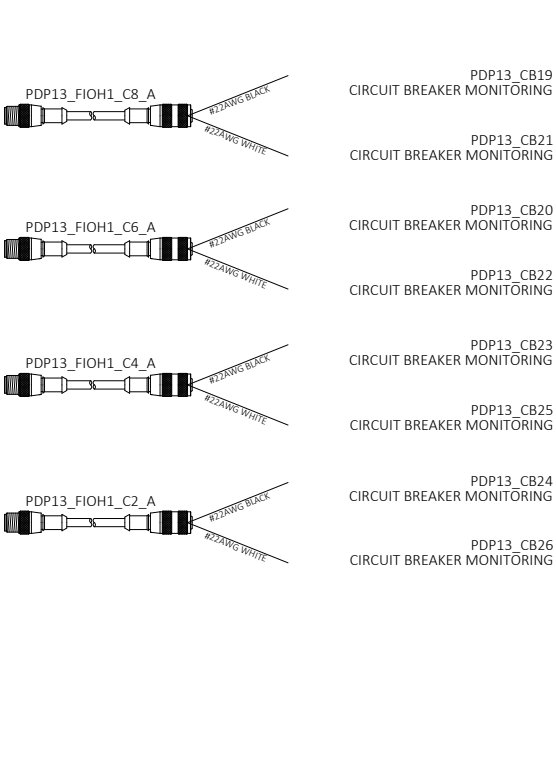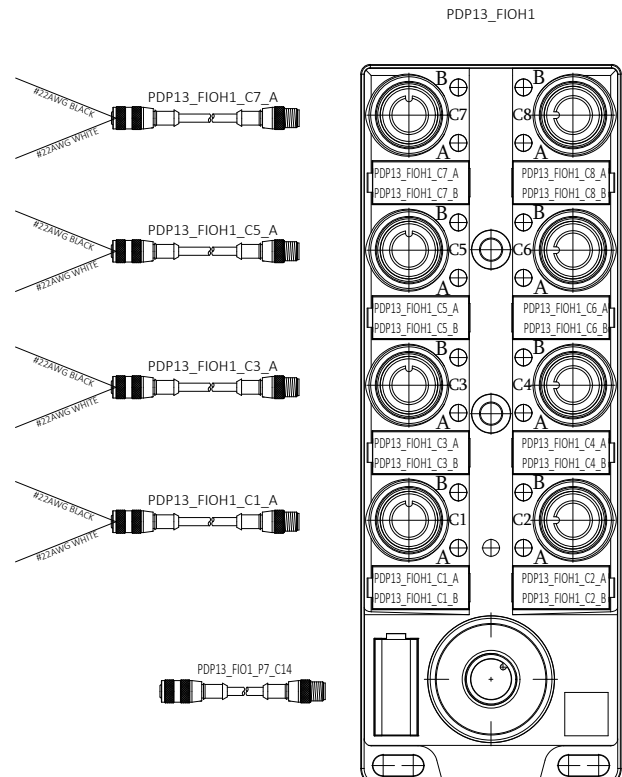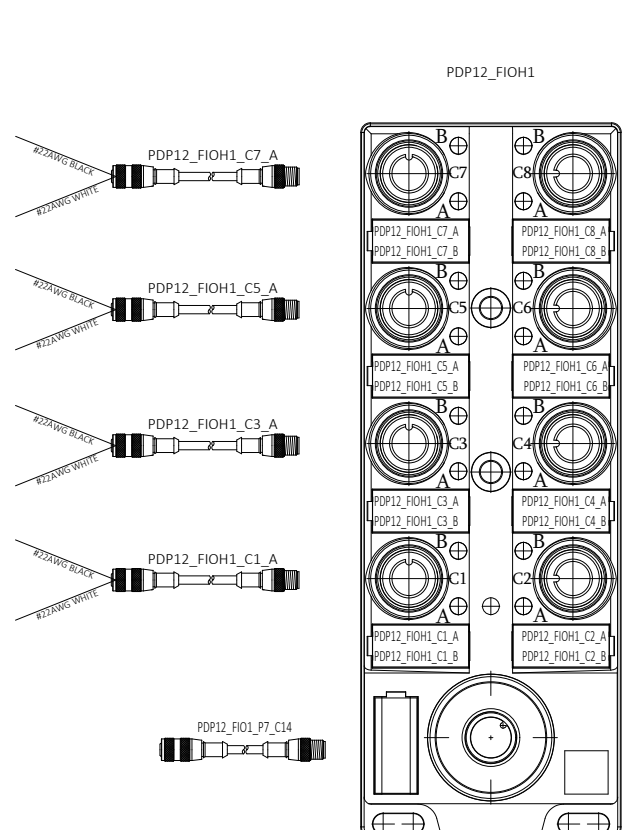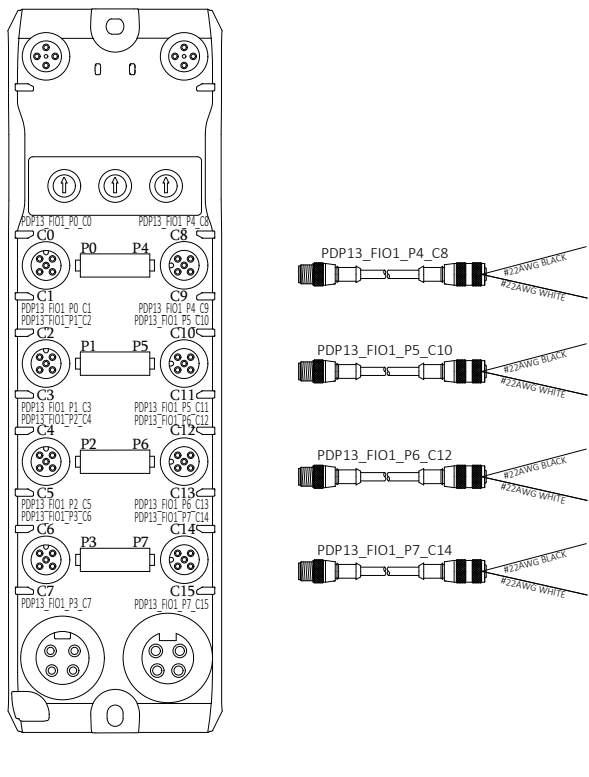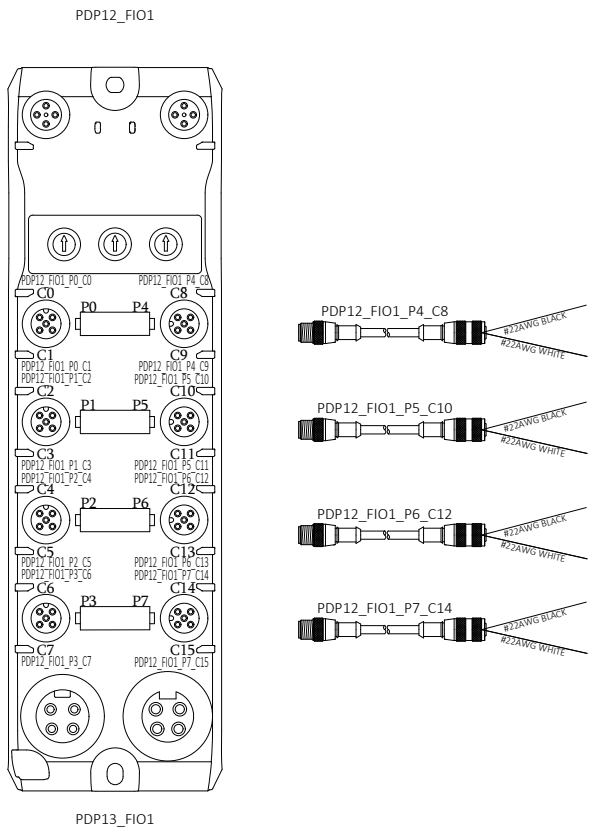

autStand
Automation Standard

FILENAME	
2429-AMZ-MTN6-MCM07-635	
D-SIZE SCALE	JOB NUMBER:
NTS	2429
REVISION	SHEET
A	87

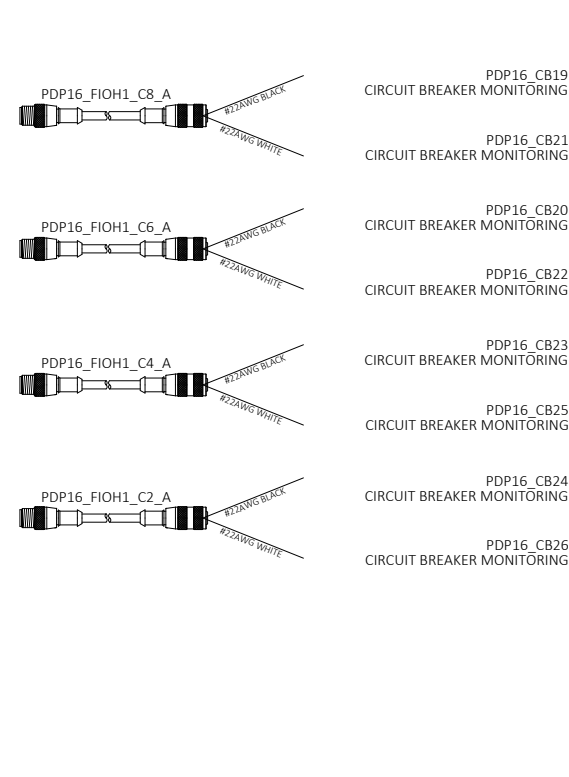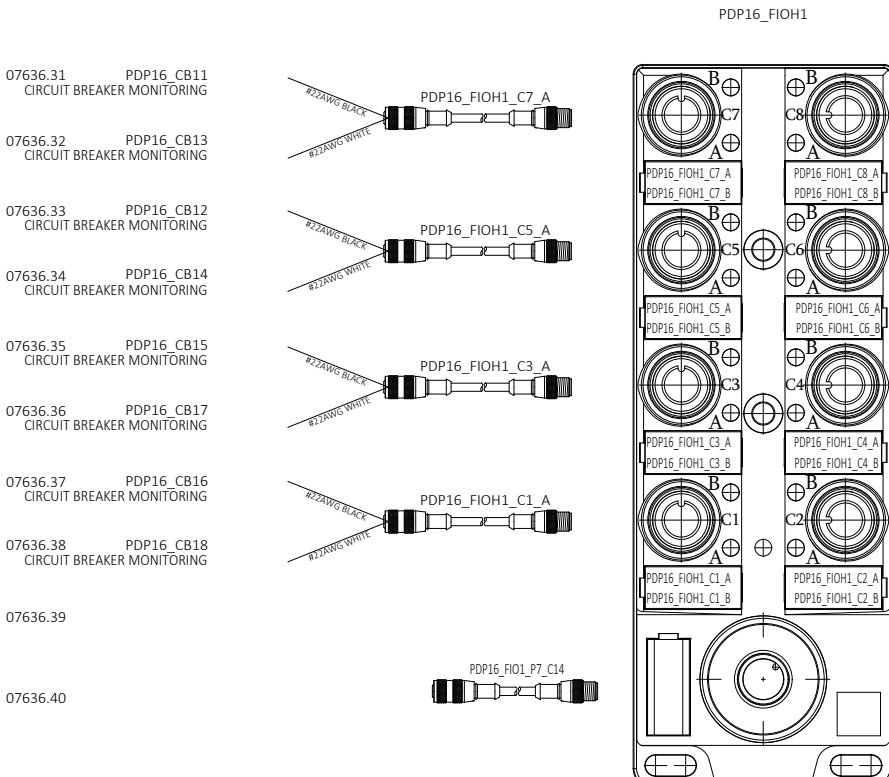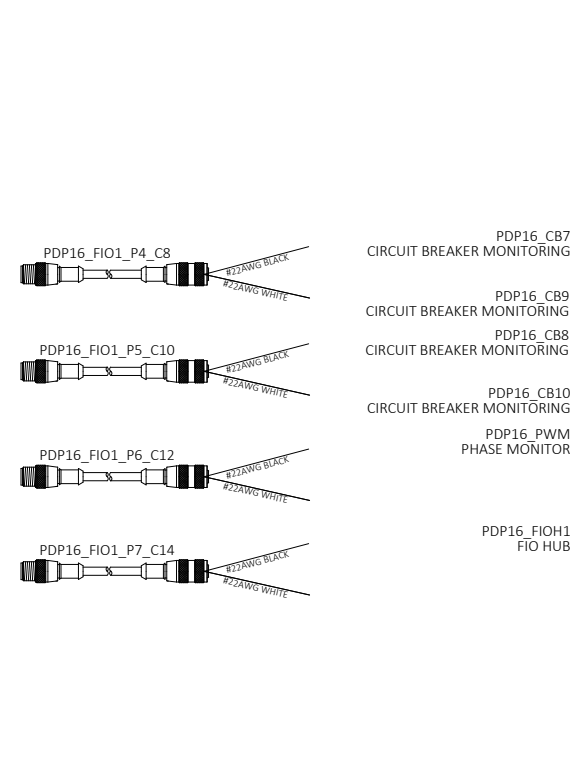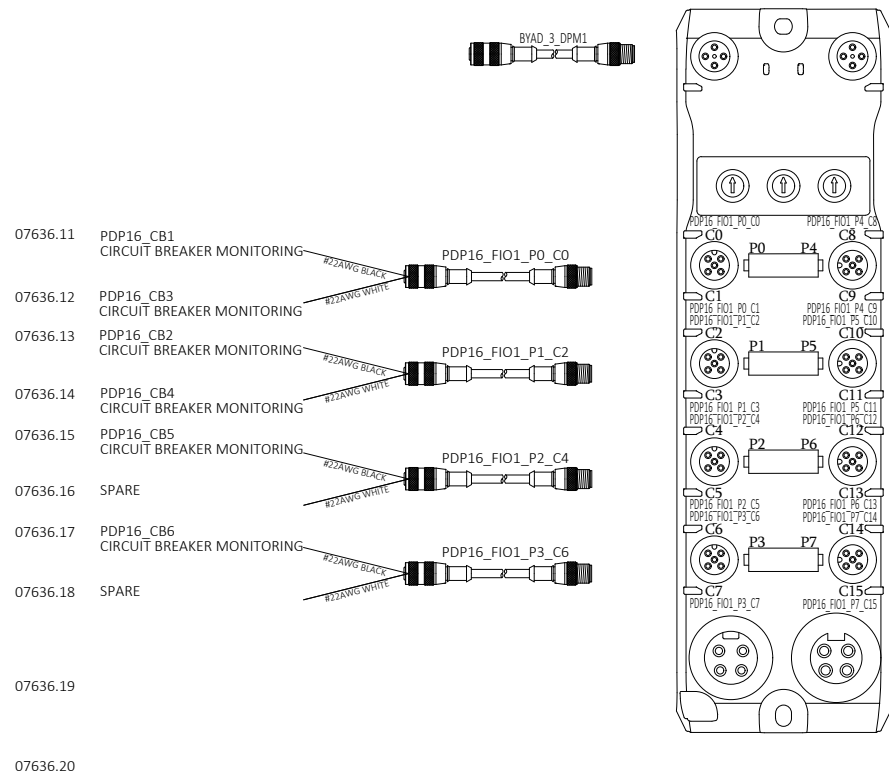

autStand
Automation Standard

25K Amazon Cross-Belt Sort Center (ACBSC) PDP15_FIO1/PDP15_FIOH1 PDP16_FIO1/PDP16_FIOH1 IO DRAWINGS AMAZON MTN6 SPARROWS POINT, MD
--